

REV.	DESCRIPTION	DATE
1	PLAN CHECK COMMENTS, 1ST PC	01/14/2018
2	CLIENT REV. INCREASE 1ST FL HT.	04/12/2019

STAMP:

PROJECT

DESIGN REVIEW

CROSSWAY FARMHOUSE


834 CROSSWAY ROAD
BURLINGAME, CALIFORNIA 94010

NOTES:
THE PURPOSE OF THE DRAWINGS PROVIDED IS TO SHOW GENERAL ARRANGEMENT OF REMODELING & ADDITIONS TO AN EXISTING STRUCTURE. ASSUMPTIONS HAVE BEEN MADE REGARDING THE STRUCTURAL & ARCHITECTURAL CONDITIONS OF EXISTING WALLS, FLOORS & CEILINGS WHICH WILL NEED TO BE VERIFIED & PERHAPS MODIFIED AS THESE CONDITIONS ARE REVEALED DURING CONSTRUCTION. THE DESIGNER DOES NOT ASSUME ANY RESPONSIBILITY FOR THE EXISTING STRUCTURE.


SHEET TITLE:
FRONT ELEVATION

JOB NUMBER: 2018.0912
SCALE: 1/8" = 1'-0"
DRAWN BY: JN
DATE: 11/02/2018
SHEET:

A3.1

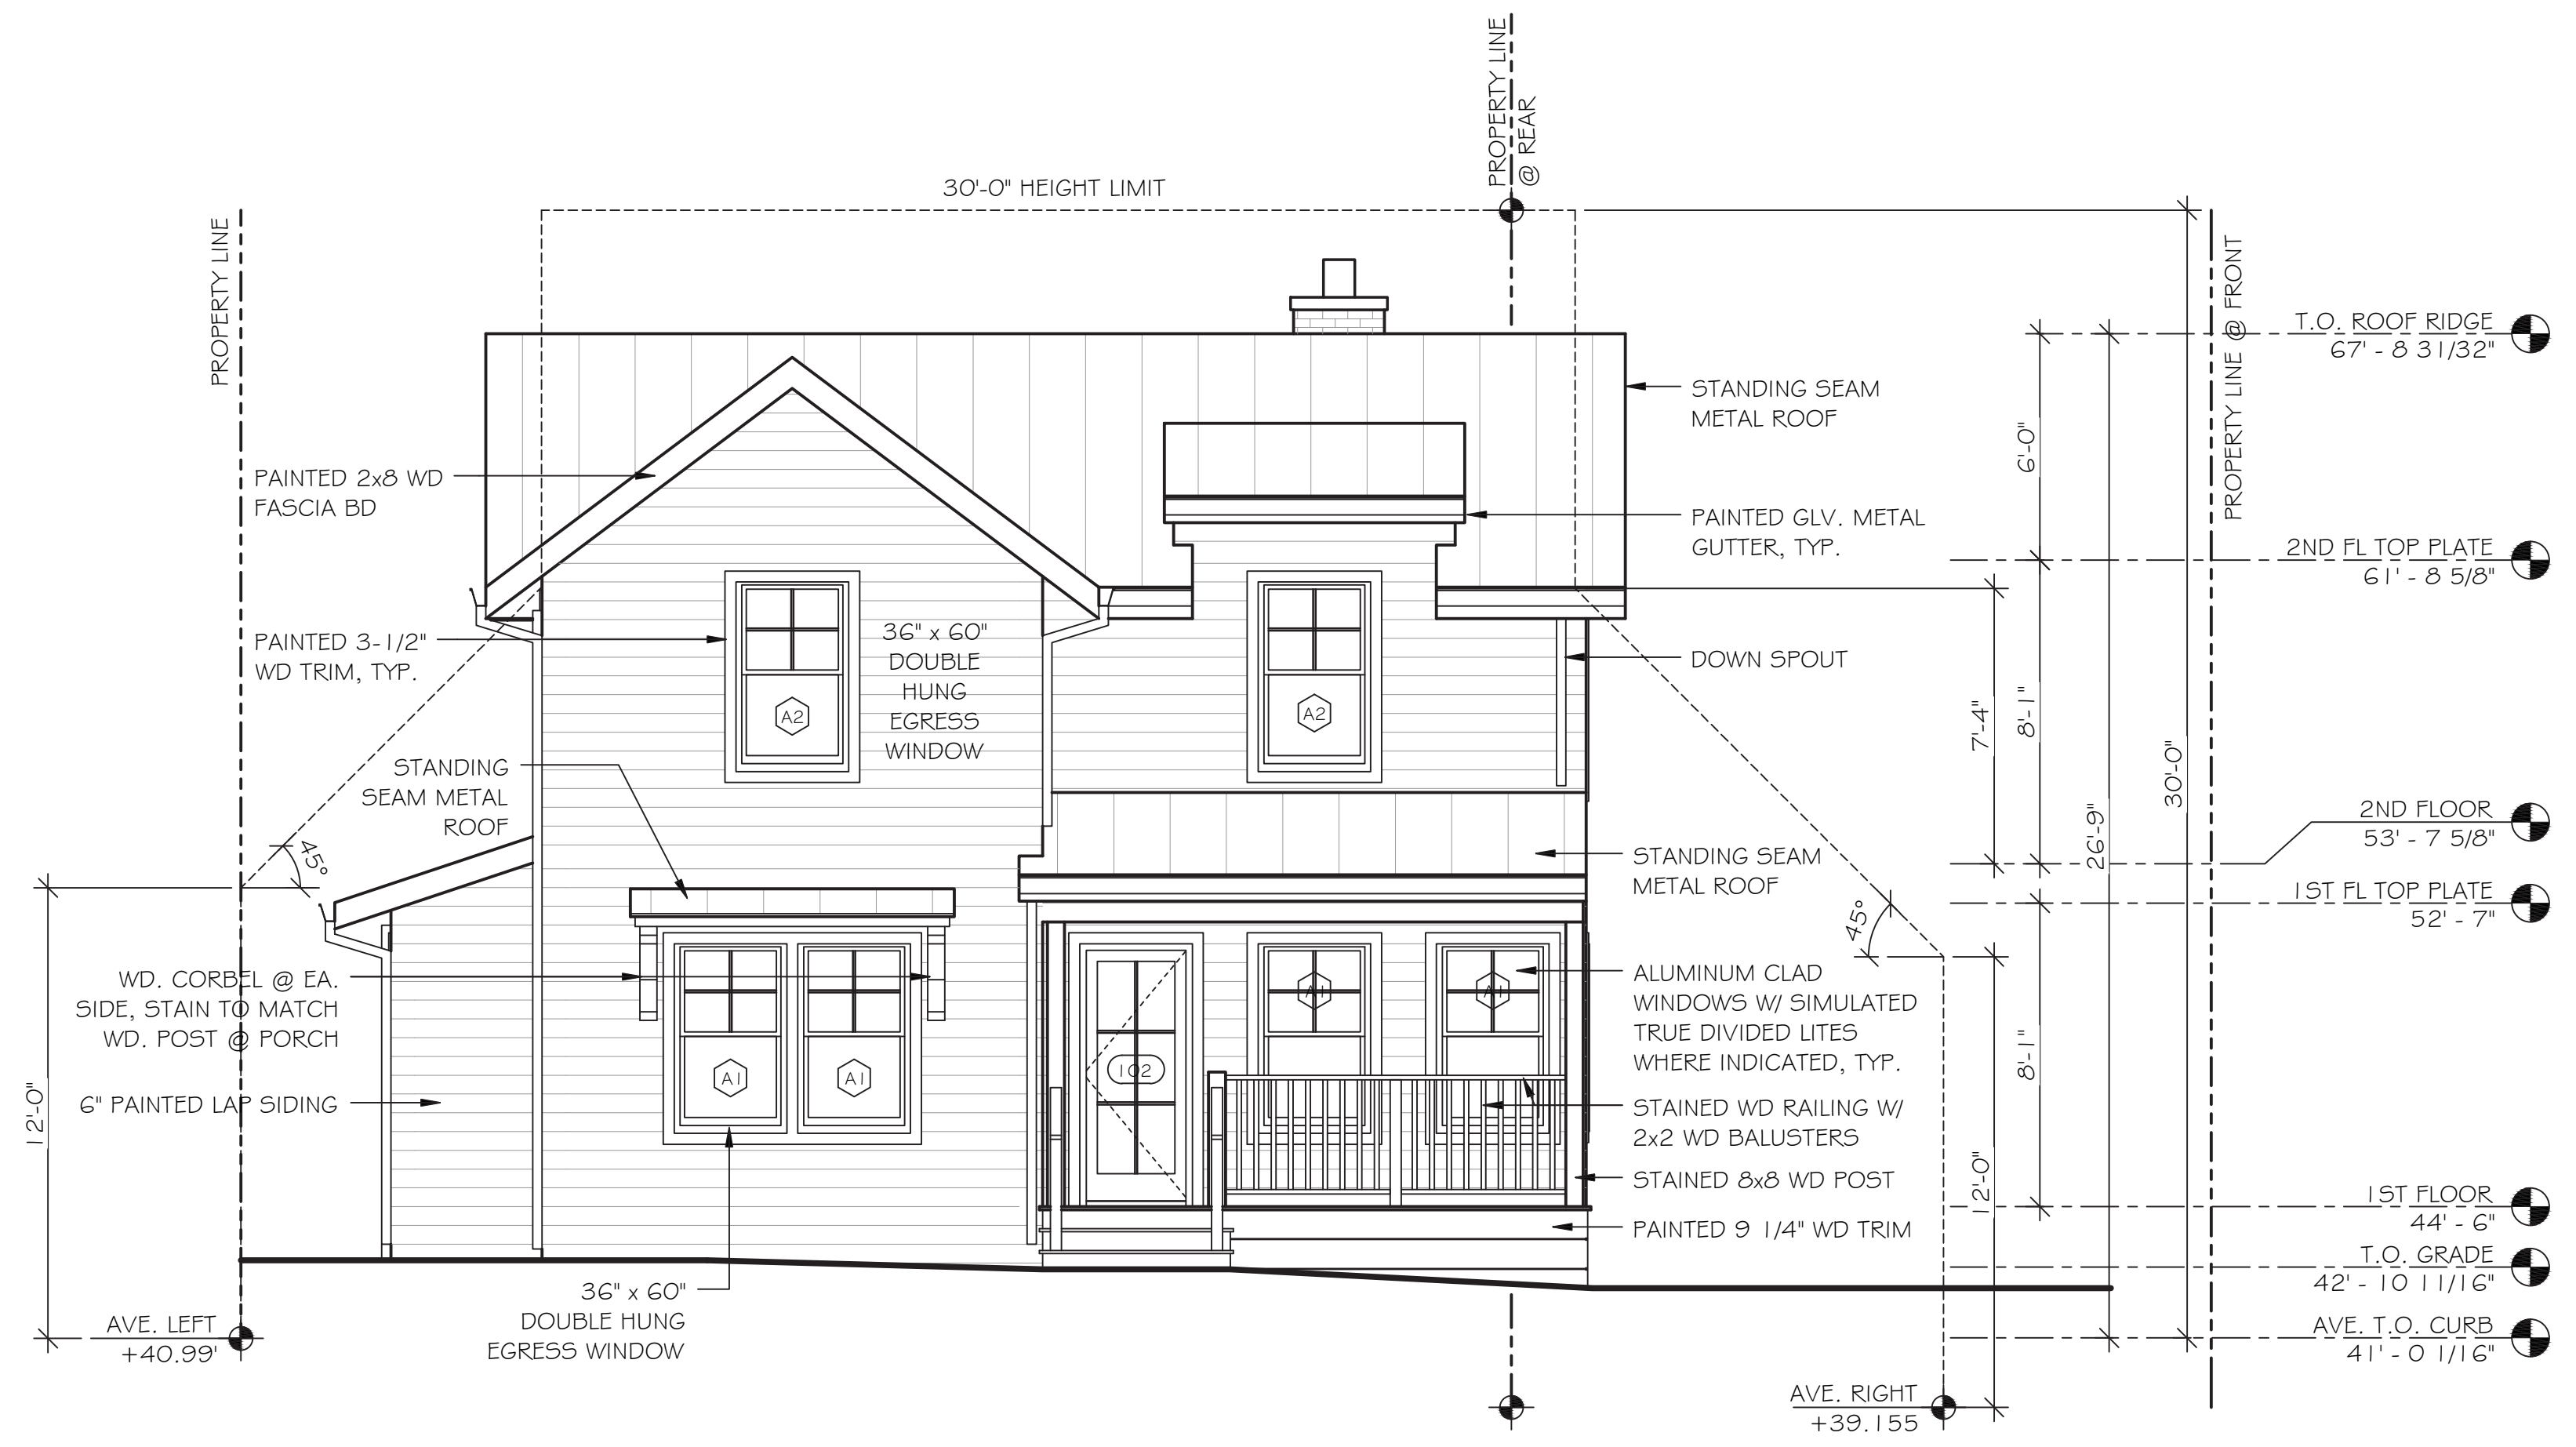

1 APPROVED FRONT ELEV.
1/4" = 1'-0"

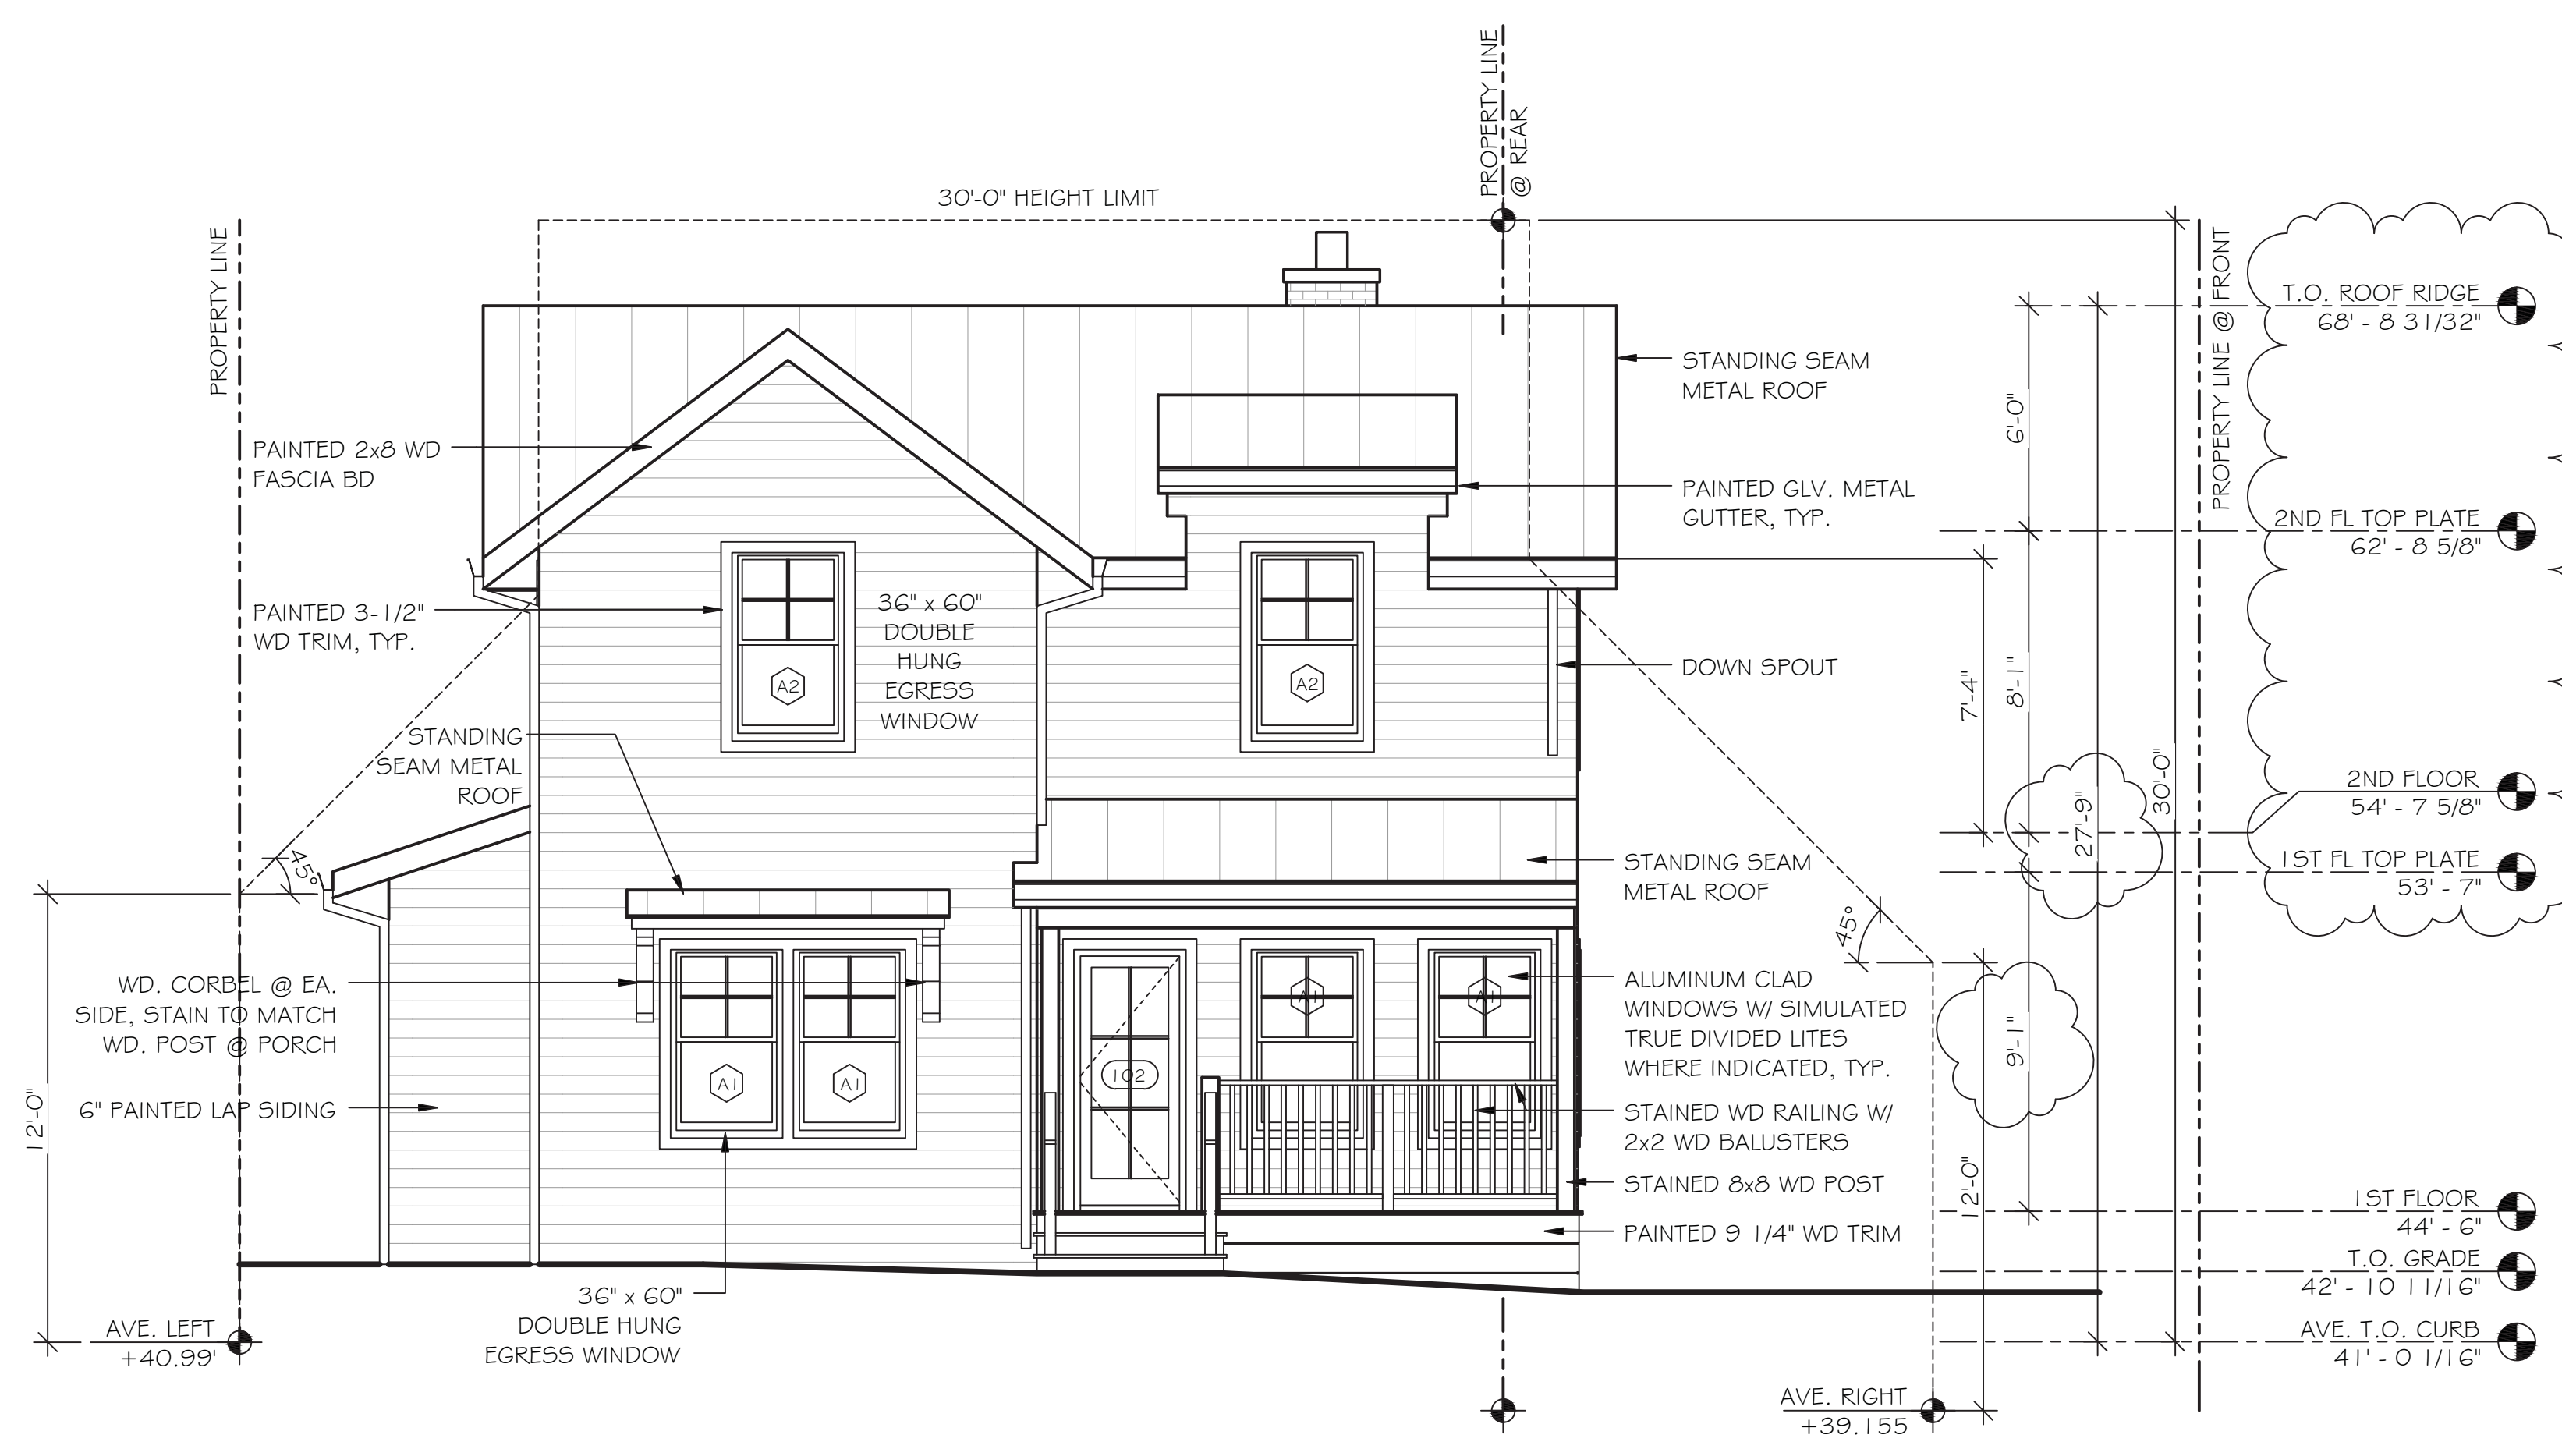

2 PROPOSED FRONT ELEV.
1/4" = 1'-0"

REV.	DESCRIPTION	DATE
1	PLAN CHECK COMMENTS, 1ST PC	01/14/2018
2	CLIENT REV. INCREASE 1ST FL HT.	04/12/2019

STAMP:

PROJECT

DESIGN REVIEW

CROSSWAY FARMHOUSE

834 CROSSWAY ROAD
BURLINGAME, CALIFORNIA 94010

NOTES:
THE PURPOSE OF THE DRAWINGS PROVIDED IS TO SHOW GENERAL ARRANGEMENT OF REMODELING & ADDITIONS TO AN EXISTING STRUCTURE. ASSUMPTIONS HAVE BEEN MADE REGARDING THE STRUCTURAL & ARCHITECTURAL CONDITIONS OF EXISTING WALLS, FLOORS & CEILINGS WHICH WILL NEED TO BE VERIFIED & PERHAPS MODIFIED AS THESE CONDITIONS ARE REVEALED DURING CONSTRUCTION. THE DESIGNER DOES NOT ASSUME ANY RESPONSIBILITY FOR THE EXISTING STRUCTURE.

SHEET TITLE:
RIGHT ELEVATION

JOB NUMBER: 2018.0912
SCALE: 1/8" = 1'-0"
DRAWN BY: JN
DATE: 11/02/2018
SHEET:


A3.2



1 APPROVED RIGHT ELEV.
1/4" = 1'-0"



2 PROPOSED RIGHT ELEV.
1/4" = 1'-0"

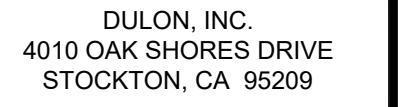[illegible]

AMP:

PROJECT

CROSSWAY FARMHOUSE

834 CROSSWAY ROAD
BURLINGAME, CALIFORNIA 94010

NOTES:
THE PURPOSE OF THE DRAWINGS
PROVIDED IS TO SHOW GENERAL
ARRANGEMENT OF REMODELING &
ADDITIONS TO AN EXISTING STRUCTURE.
NO ASSUMPTIONS HAVE BEEN MADE
REGARDING THE STRUCTURAL &
ARCHITECTURAL CONDITIONS OF
EXISTING WALLS, FLOORS & CEILINGS
WHICH WILL NEED TO BE VERIFIED &
REPAIRS MODIFIED AS THESE
CONDITIONS ARE REVEALED DURING
CONSTRUCTION. THE DESIGNER DOES
NOT ASSUME ANY RESPONSIBILITY FOR
AN EXISTING STRUCTURE.

SHEET TITLE:

REAR ELEVATION

OB NUMBER:	2018.0912
------------	-----------


SCALE: $1/8" = 1'-0"$

DRAWN BY: JN


DATE: 11/02/2018

MEET:

A3.3

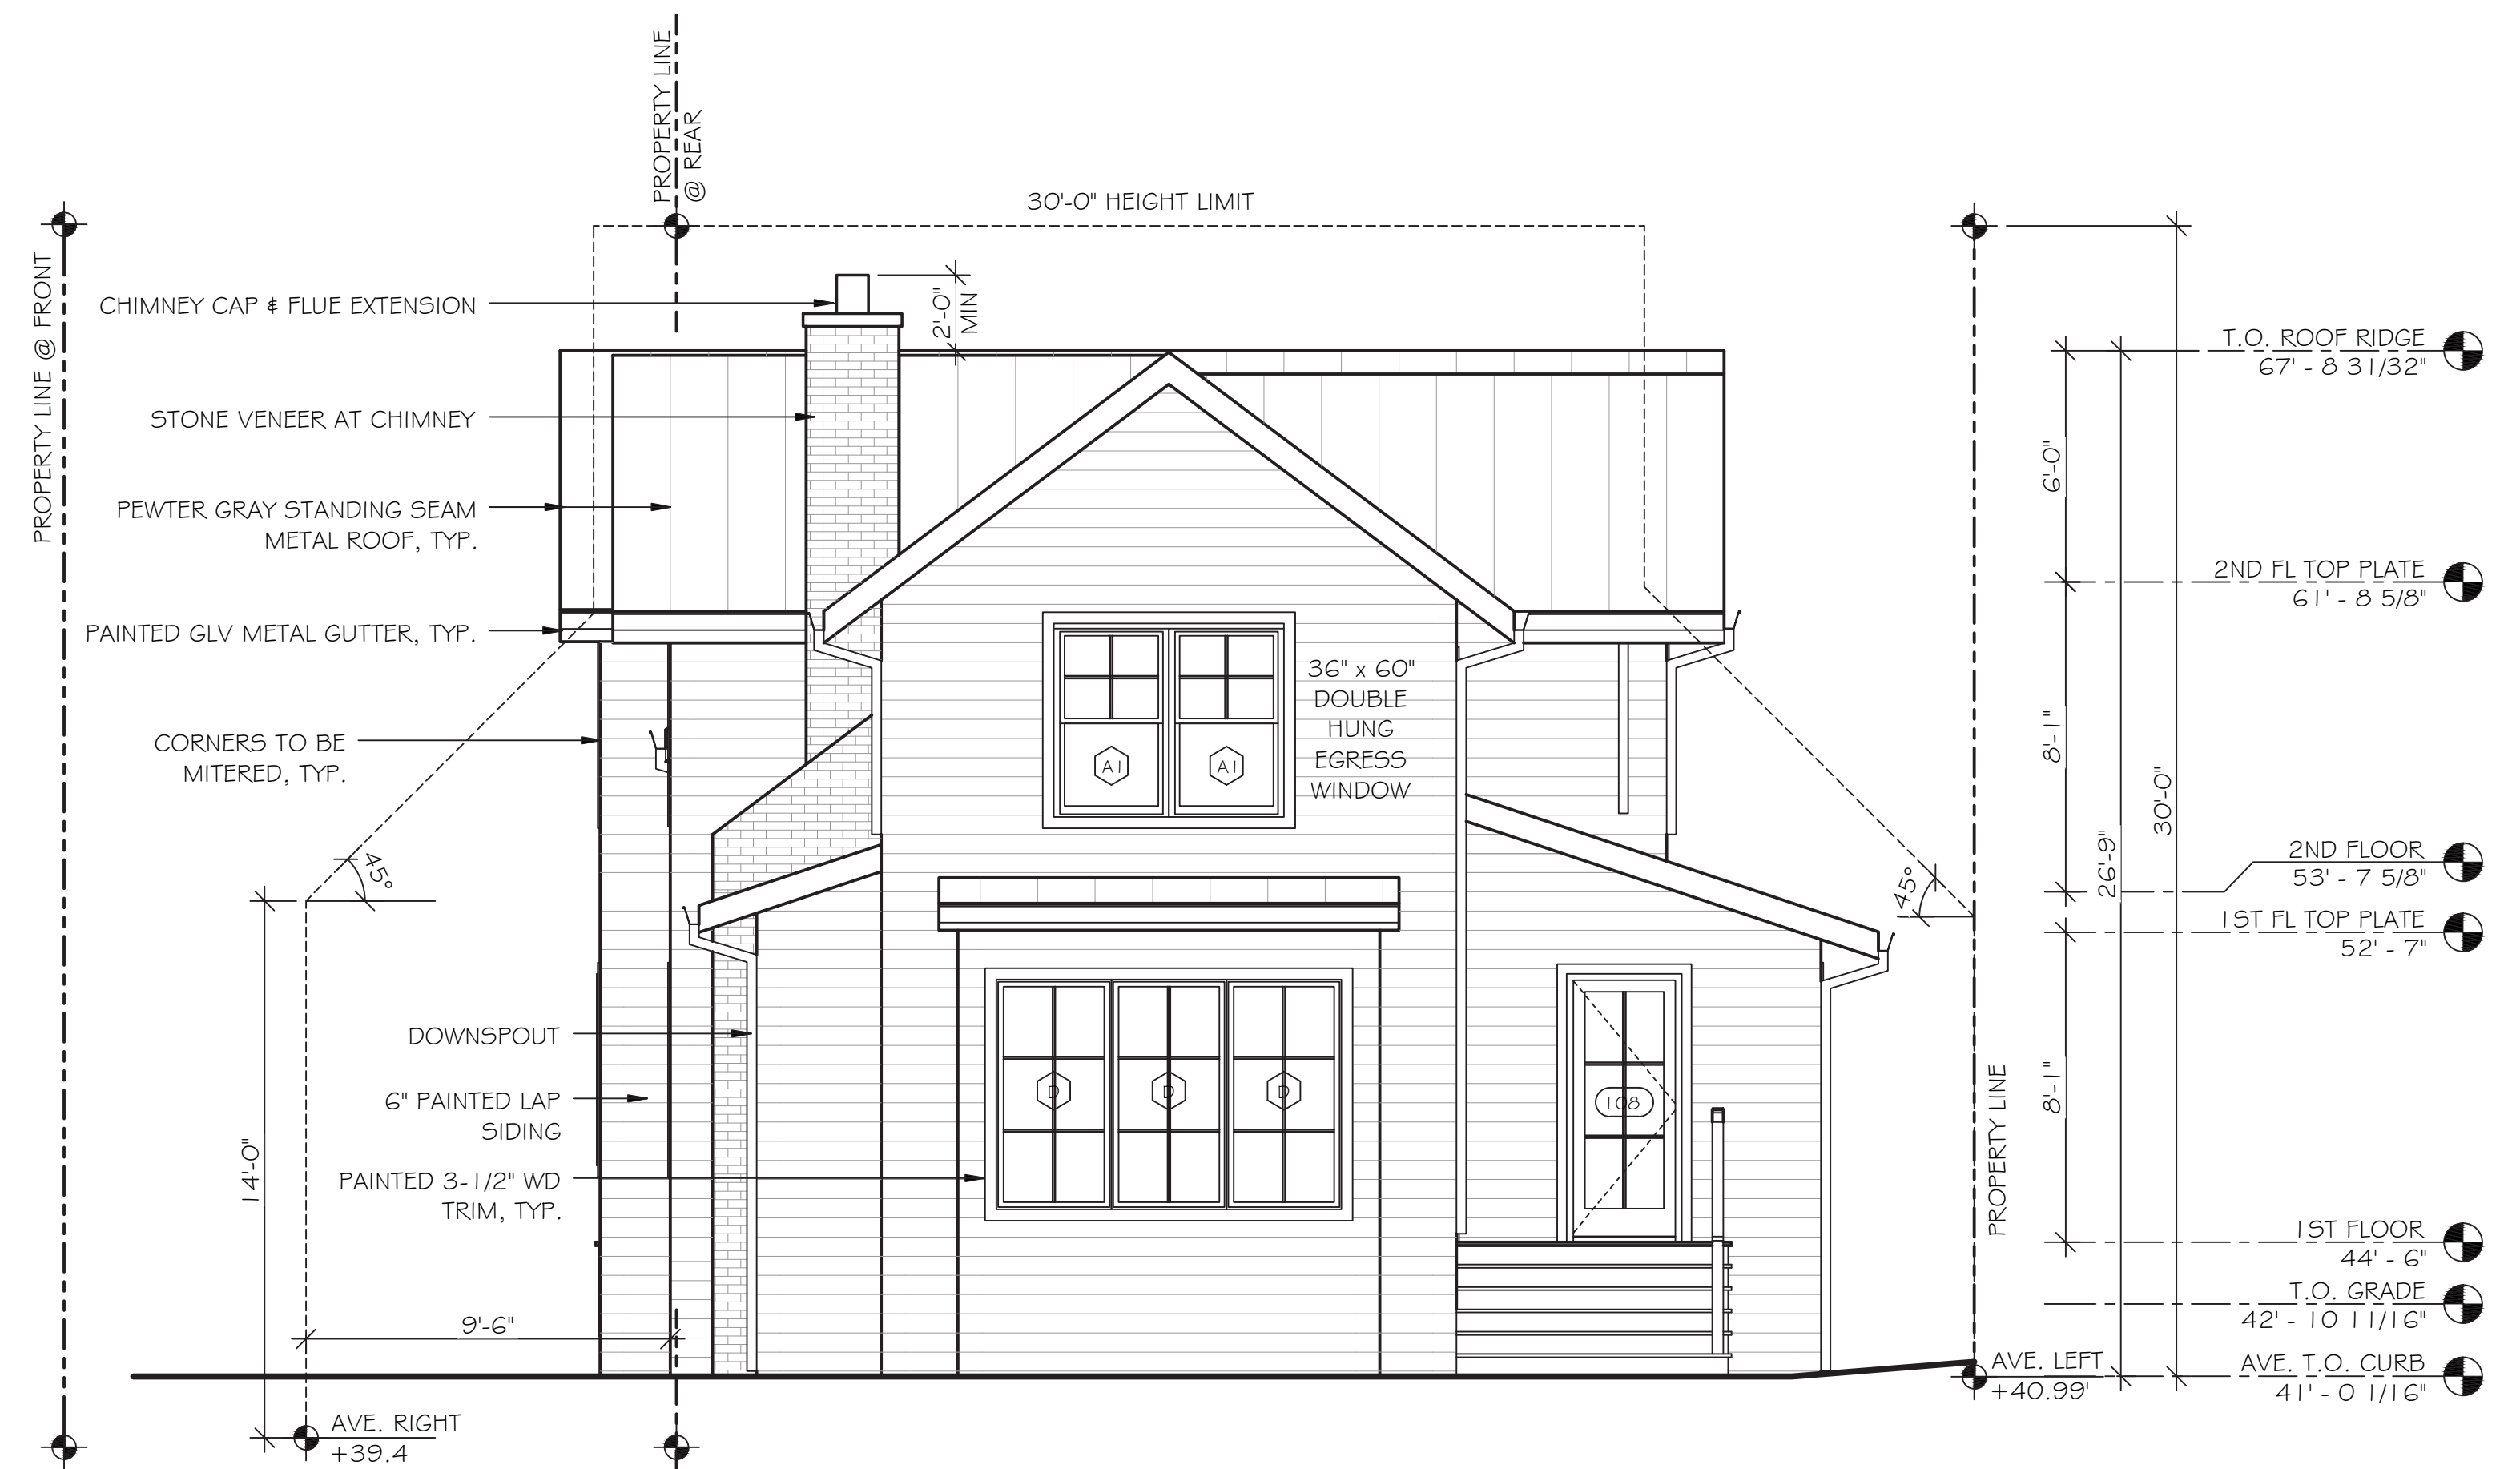

1 APPROVED REAR ELEV. 1/4" = 1'-0"

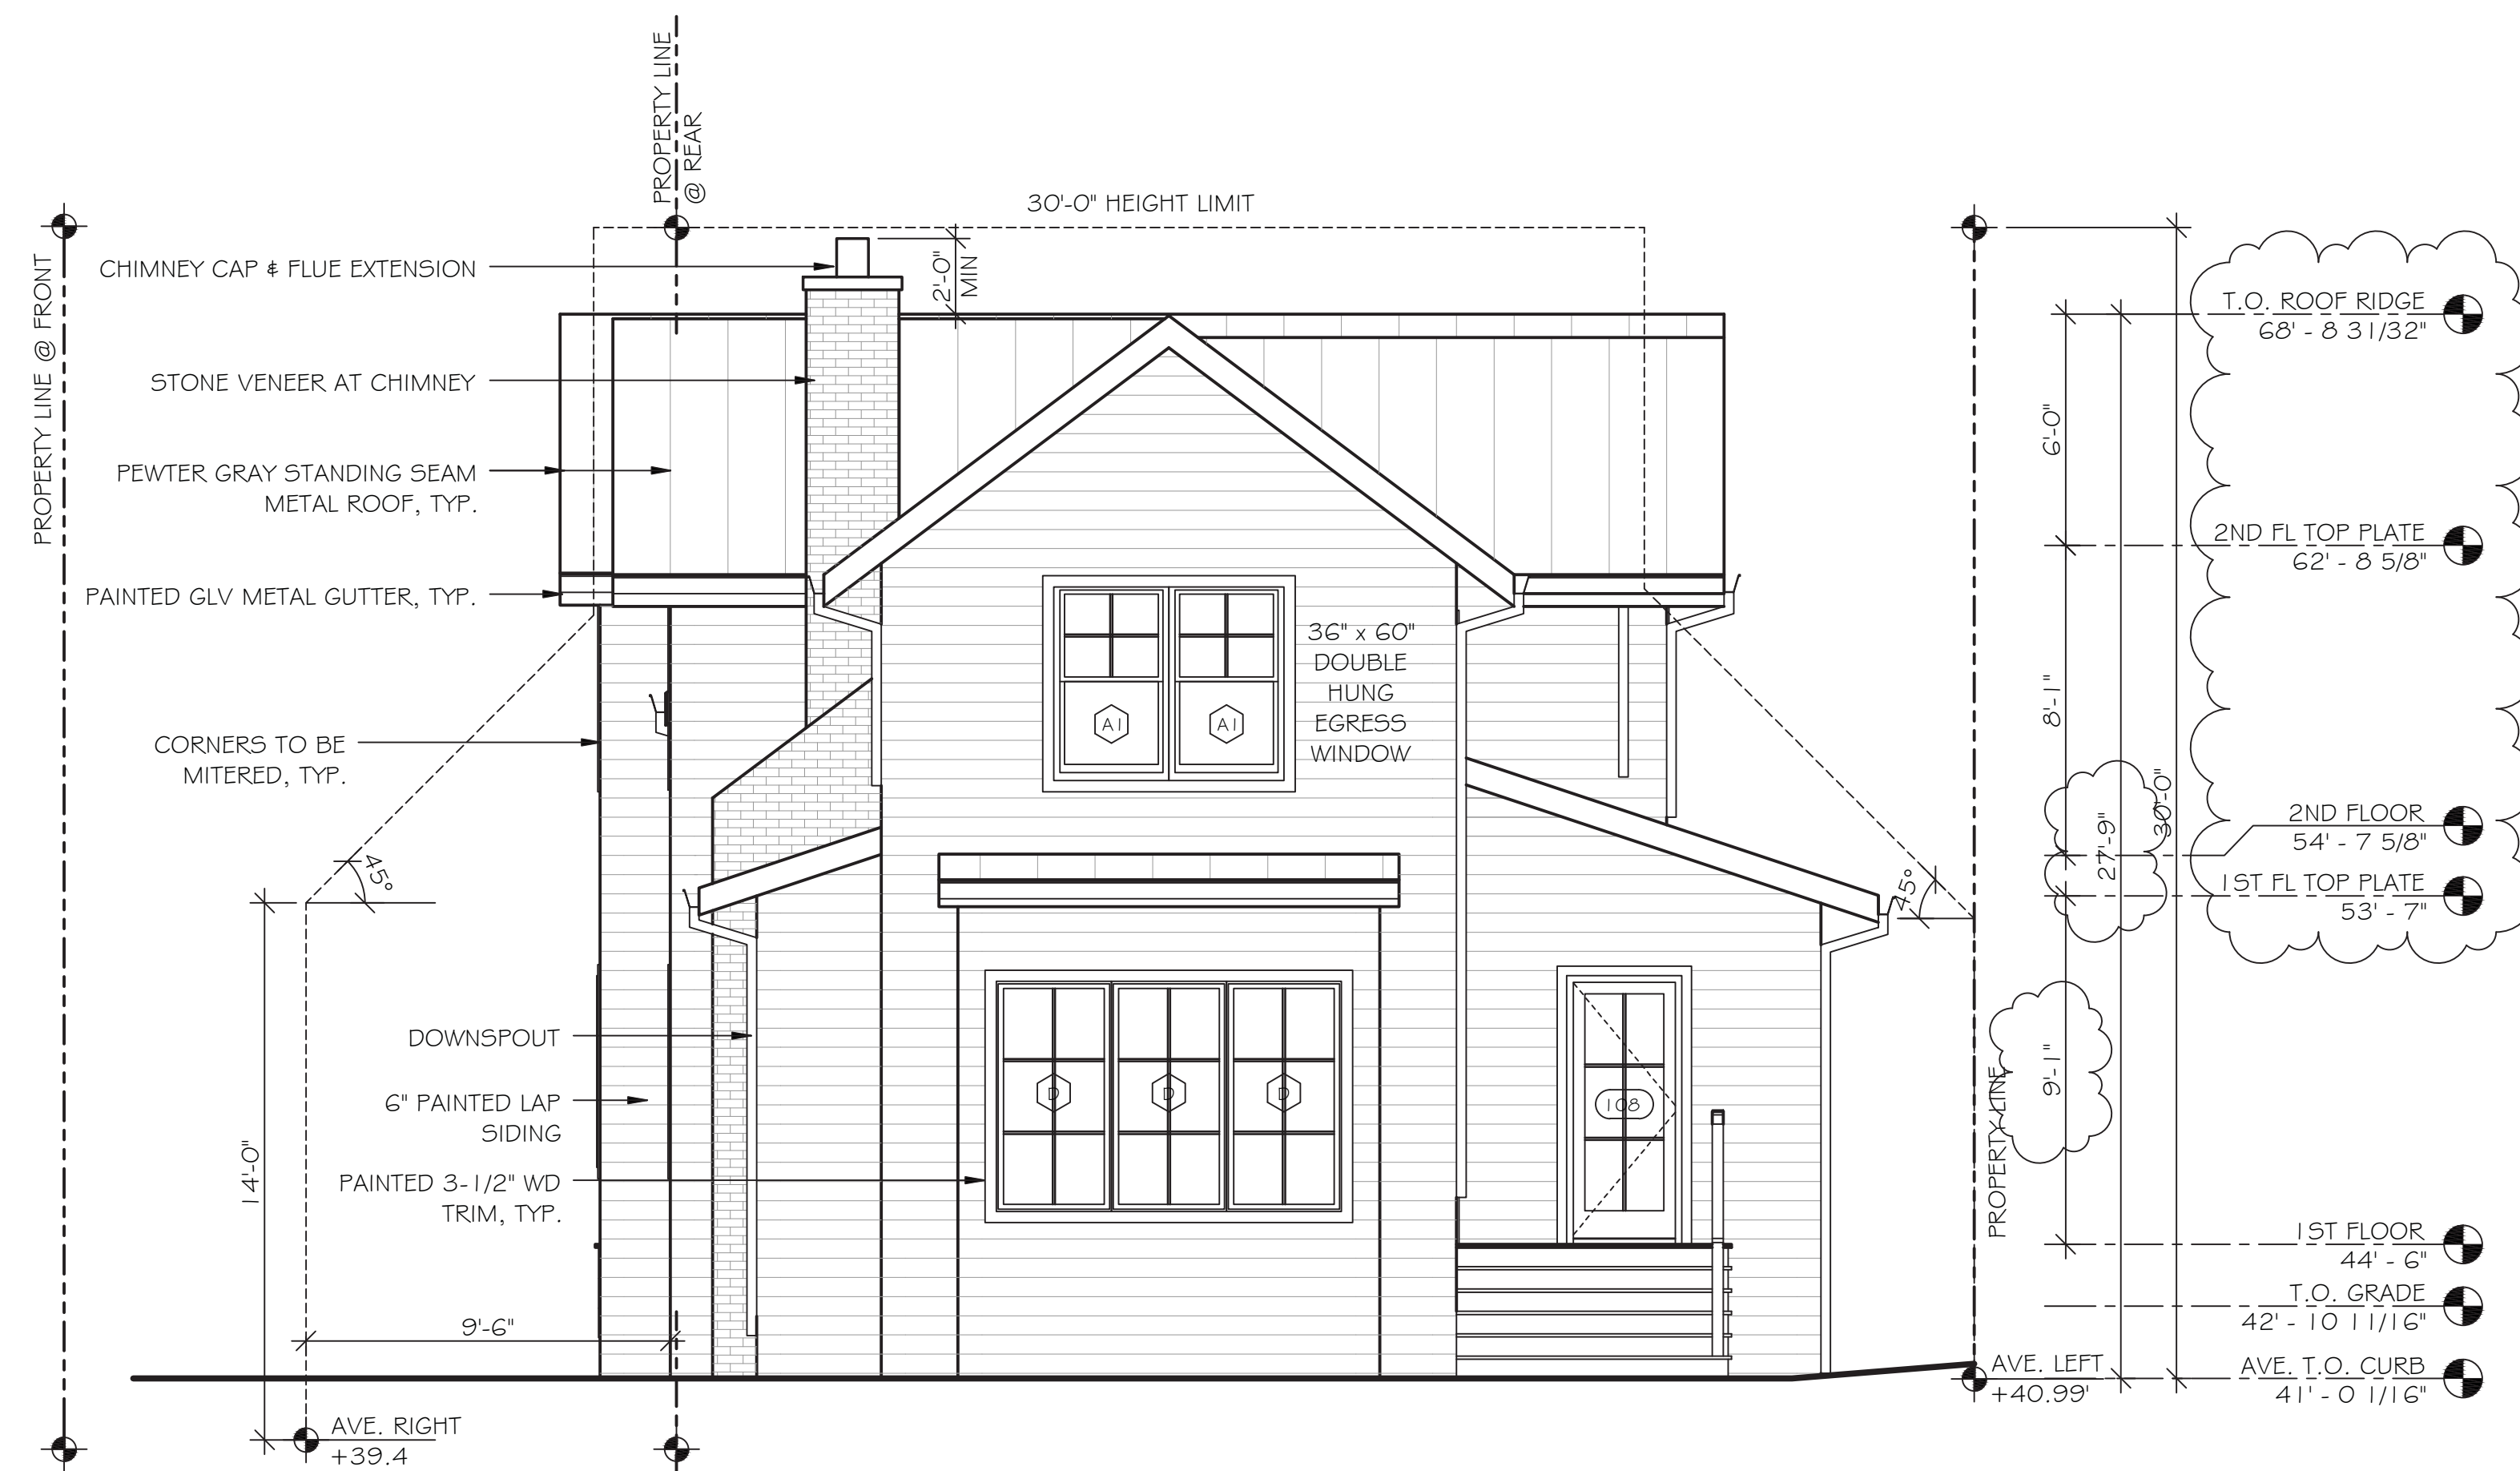

2 PROPOSED REAR ELEV. $1/4" = 1'-0"$

REV.	DESCRIPTION	DATE
1	PLAN CHECK COMMENTS, 1ST PC	01/14/2018
2	CLIENT REV., INCREASE 1ST FL HT.	04/12/2019

STAMP:

PROJECT

DESIGN REVIEW

CROSSWAY FARMHOUSE

834 CROSSWAY ROAD
BURLINGAME, CALIFORNIA 94010

NOTES:
THE PURPOSE OF THE DRAWINGS PROVIDED IS TO SHOW GENERAL ARRANGEMENT OF REMODELING & ADDITIONS TO AN EXISTING STRUCTURE. ASSUMPTIONS HAVE BEEN MADE REGARDING THE STRUCTURAL & ARCHITECTURAL CONDITIONS OF EXISTING WALLS, FLOORS & CEILINGS WHICH WILL NEED TO BE VERIFIED & PERHAPS MODIFIED AS THESE CONDITIONS ARE REVEALED DURING CONSTRUCTION. THE DESIGNER DOES NOT ASSUME ANY RESPONSIBILITY FOR THE EXISTING STRUCTURE.

SHEET TITLE:
LEFT ELEVATION

JOB NUMBER: 2018.0912
SCALE: 1/8" = 1'-0"
DRAWN BY: JN
DATE: 11/02/2018
SHEET:

A3.4



1 APPROVED RIGHT ELEV.
1/4" = 1'-0"



2 PROPOSED RIGHT ELEV.
1/4" = 1'-0"