


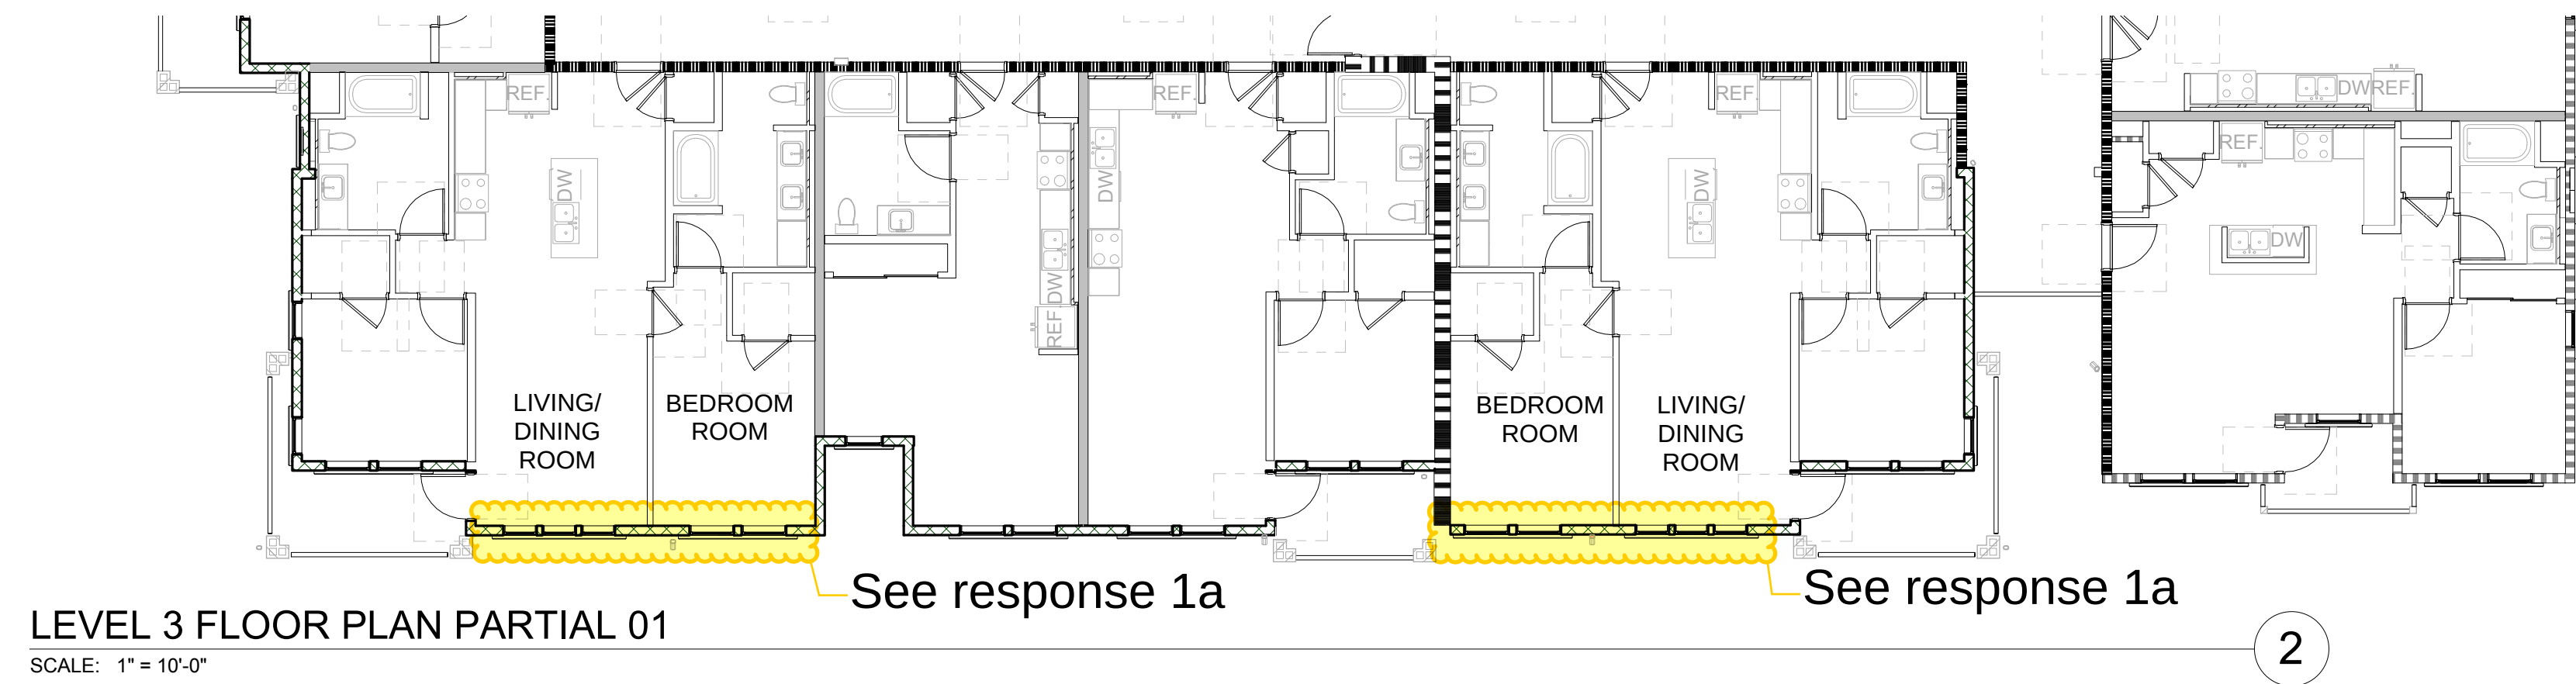


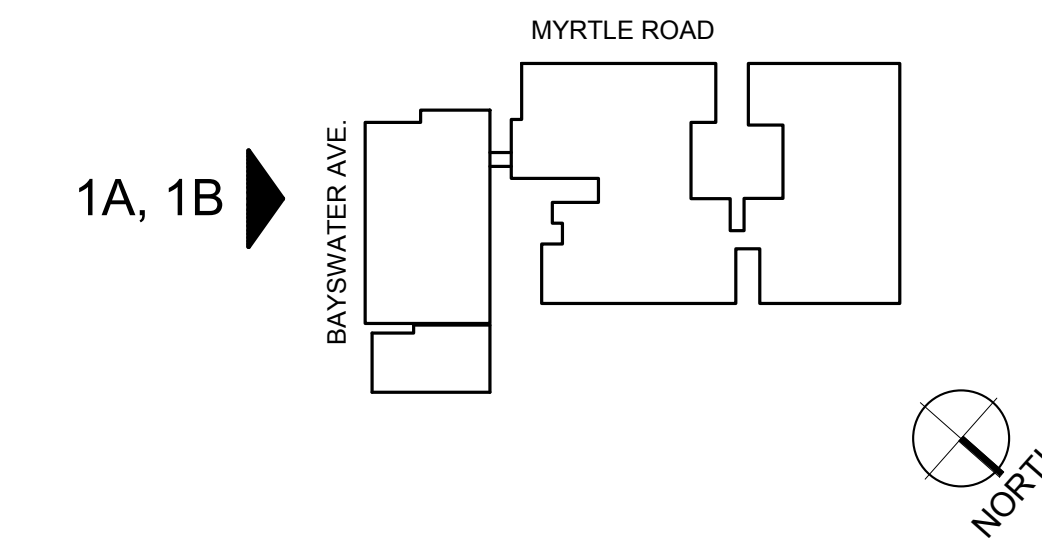


920 BAYSWATER AVENUE
BURLINGAME, CALIFORNIA

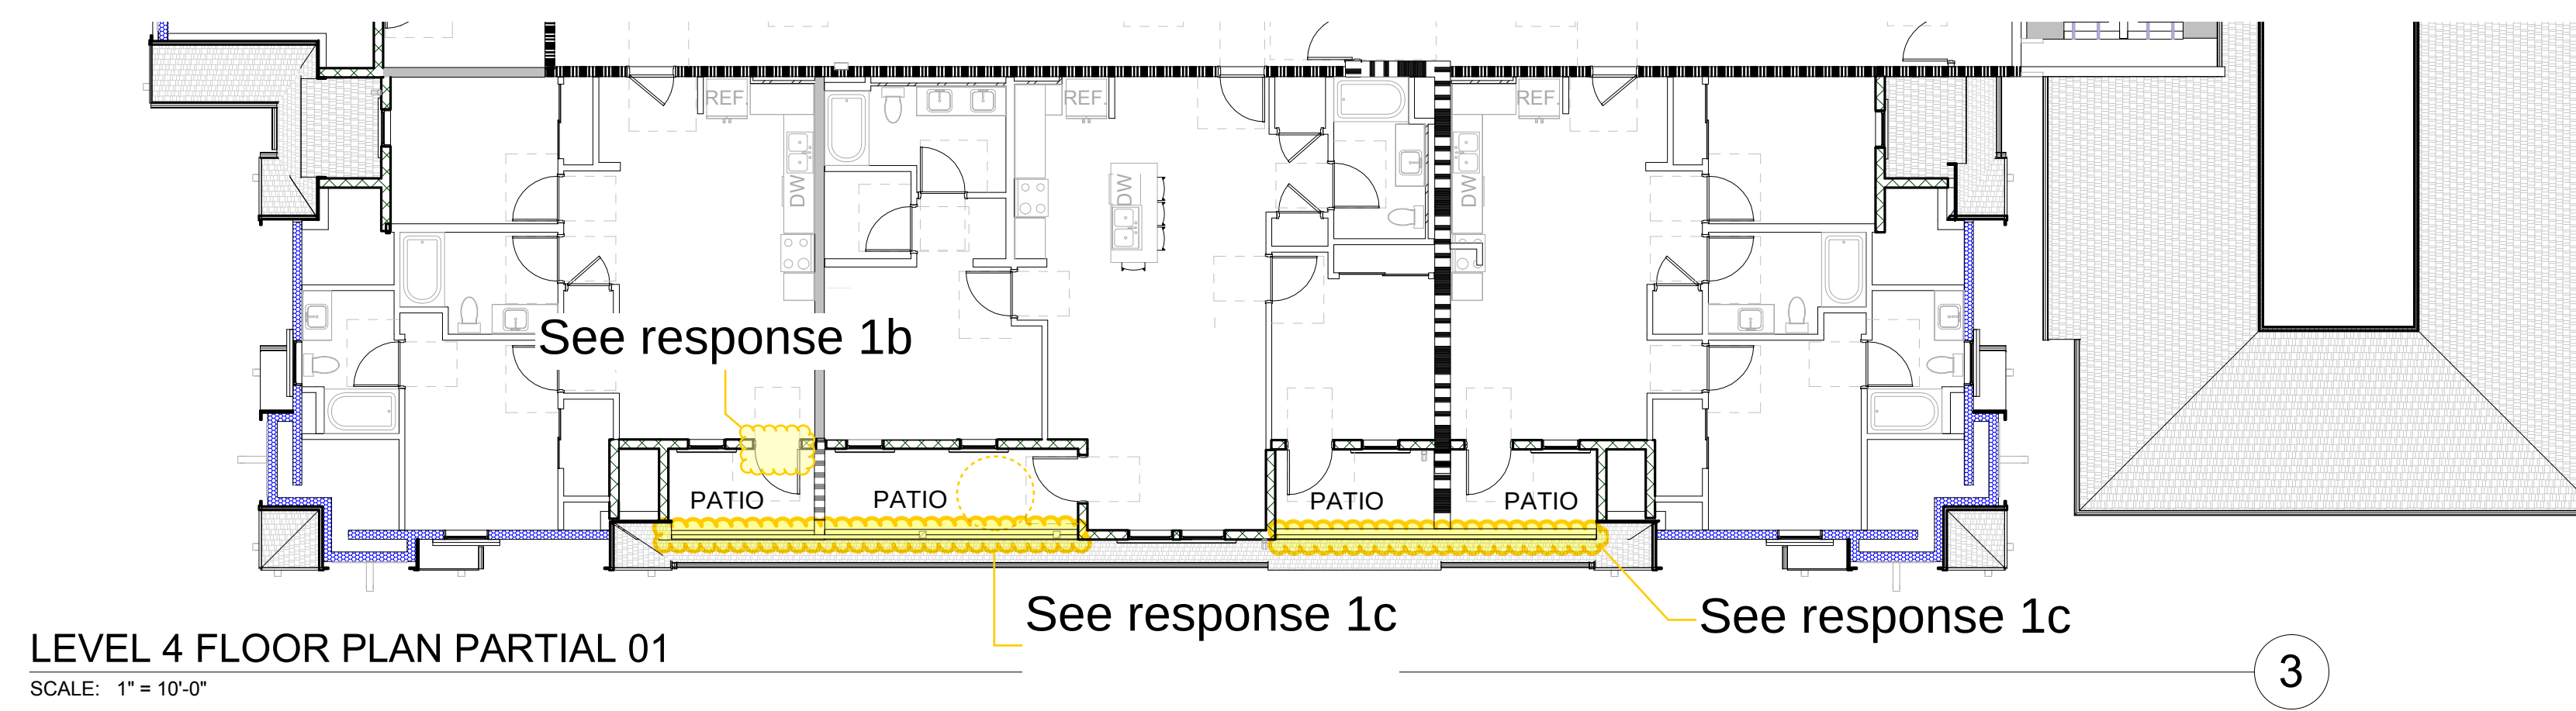

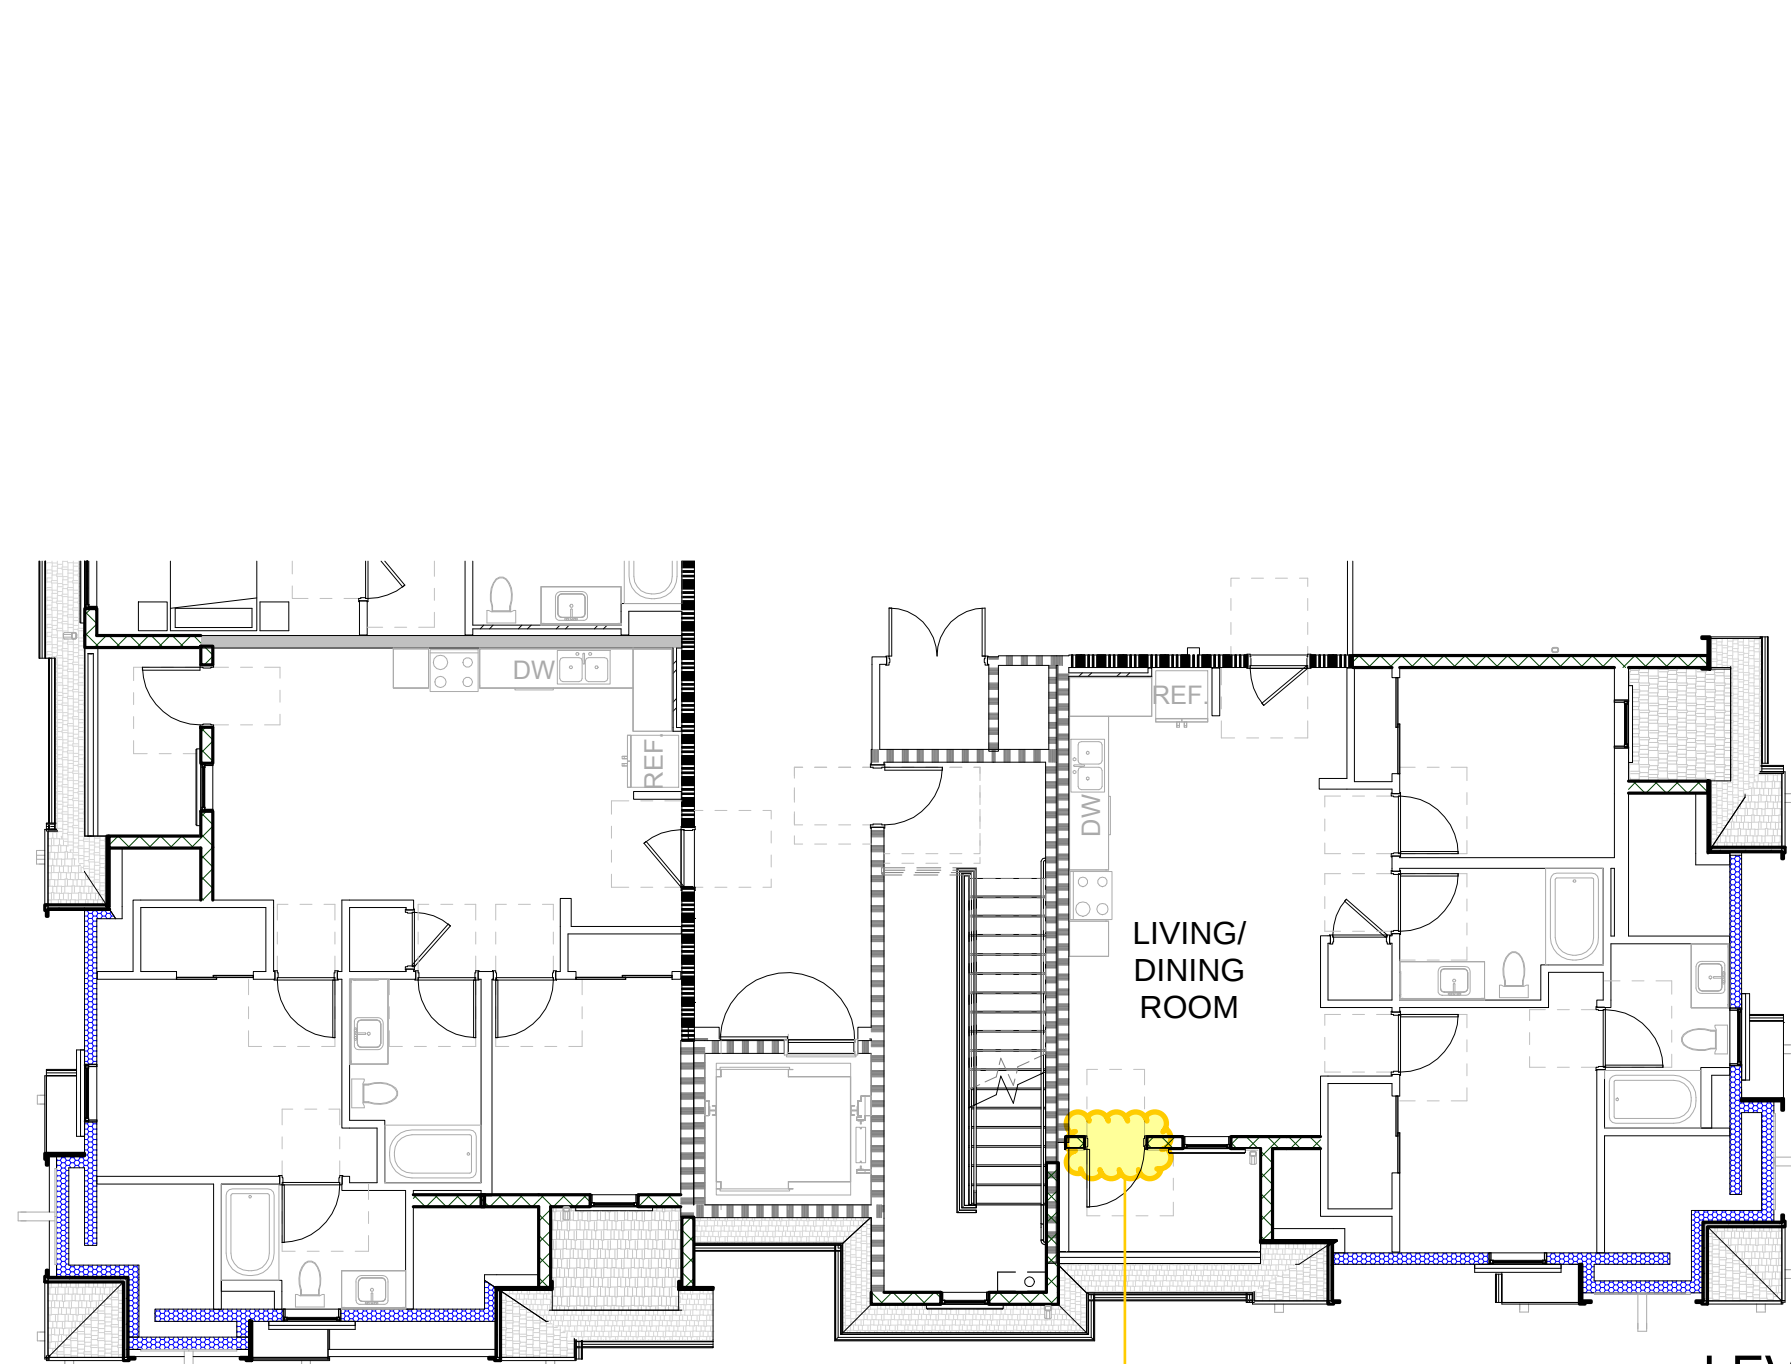


See response 2c



LEVEL 4 FLOOR PLAN PARTIAL 02
SCALE: 1" = 10'-0"

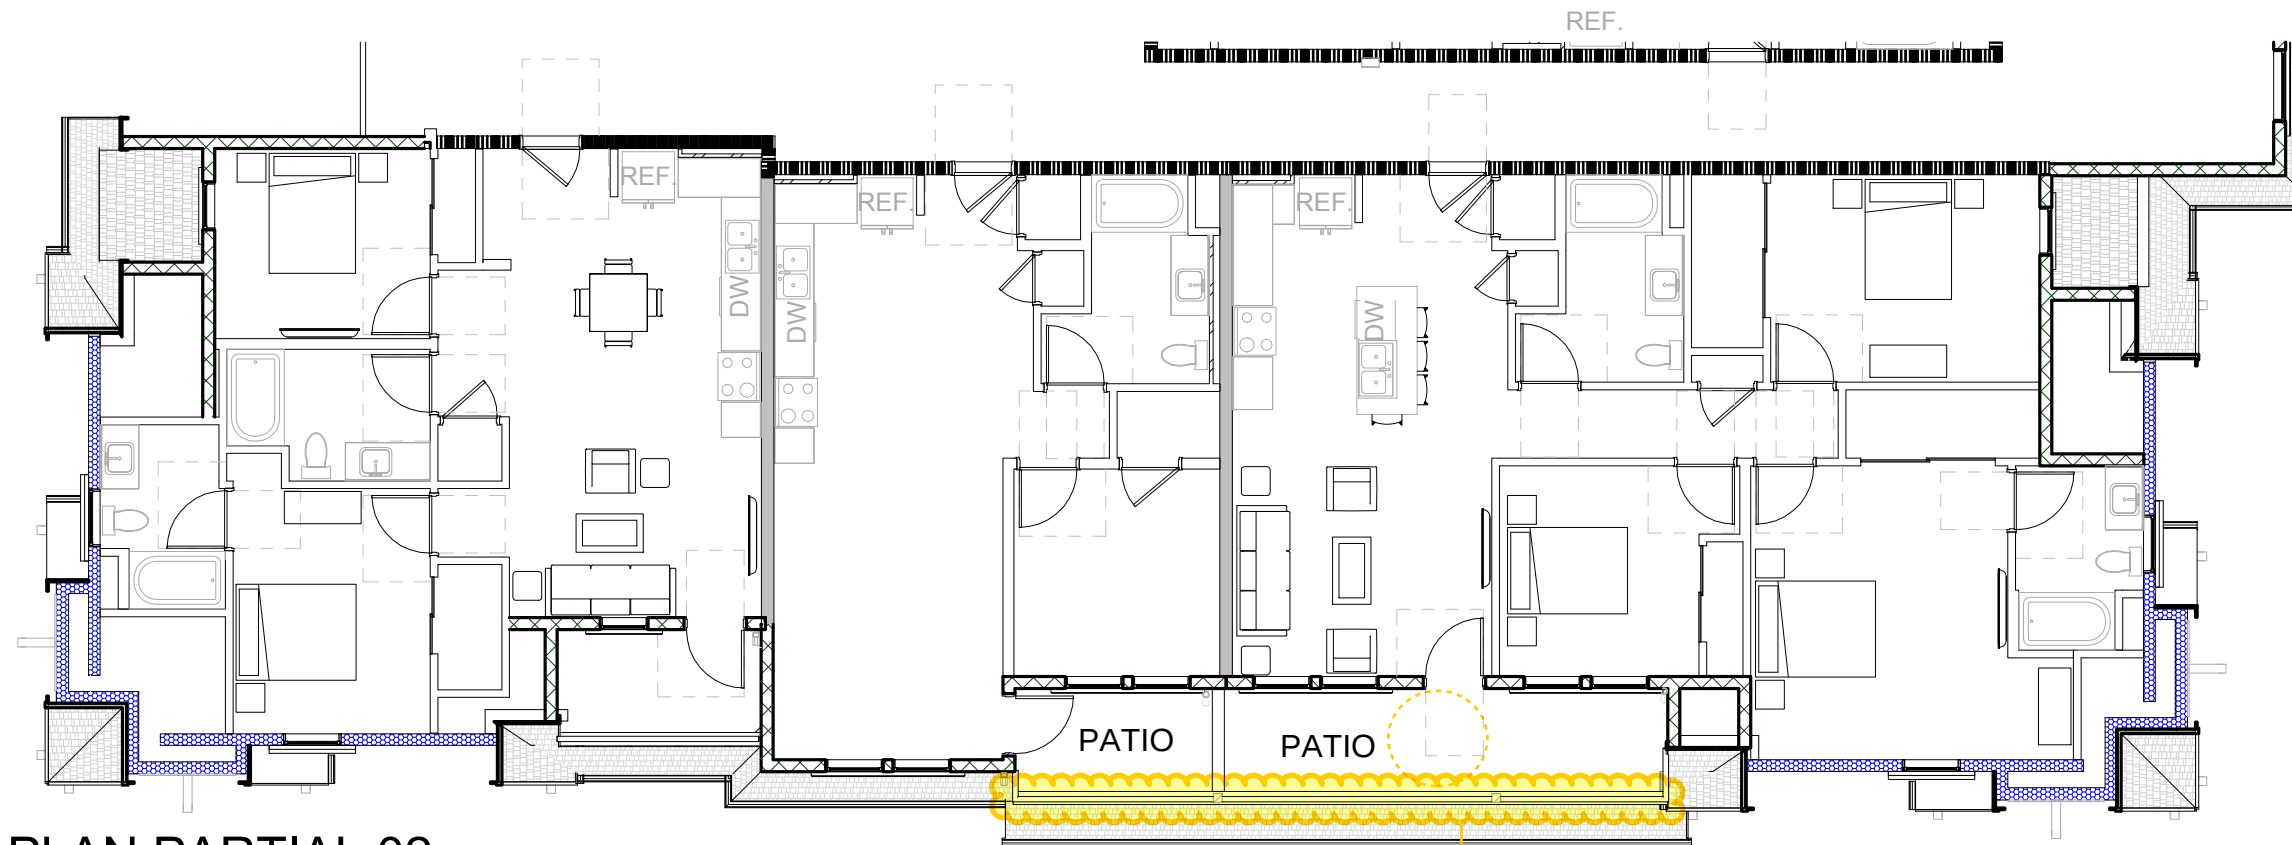

See response 2f

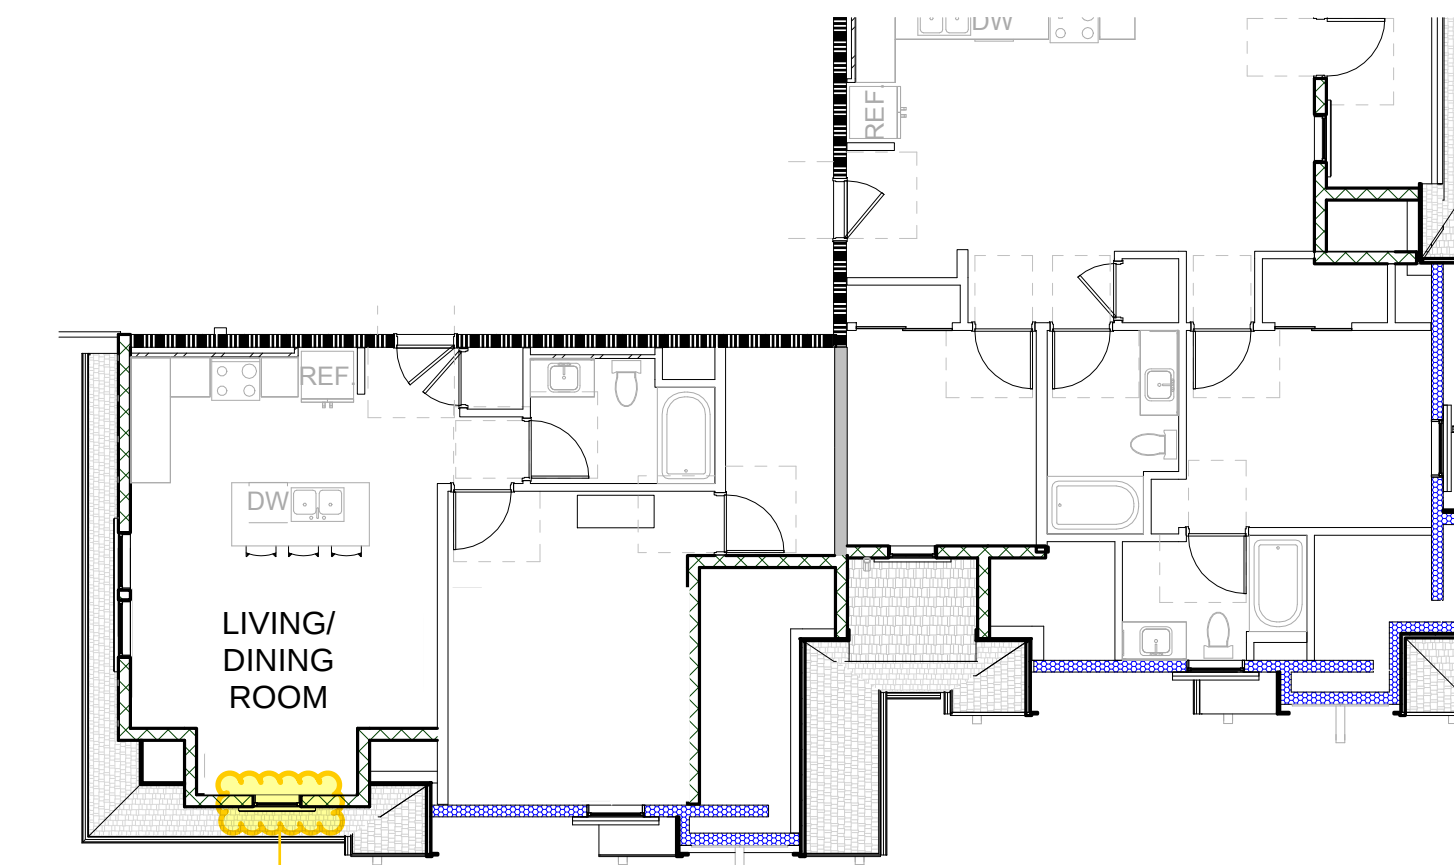


See response 2h

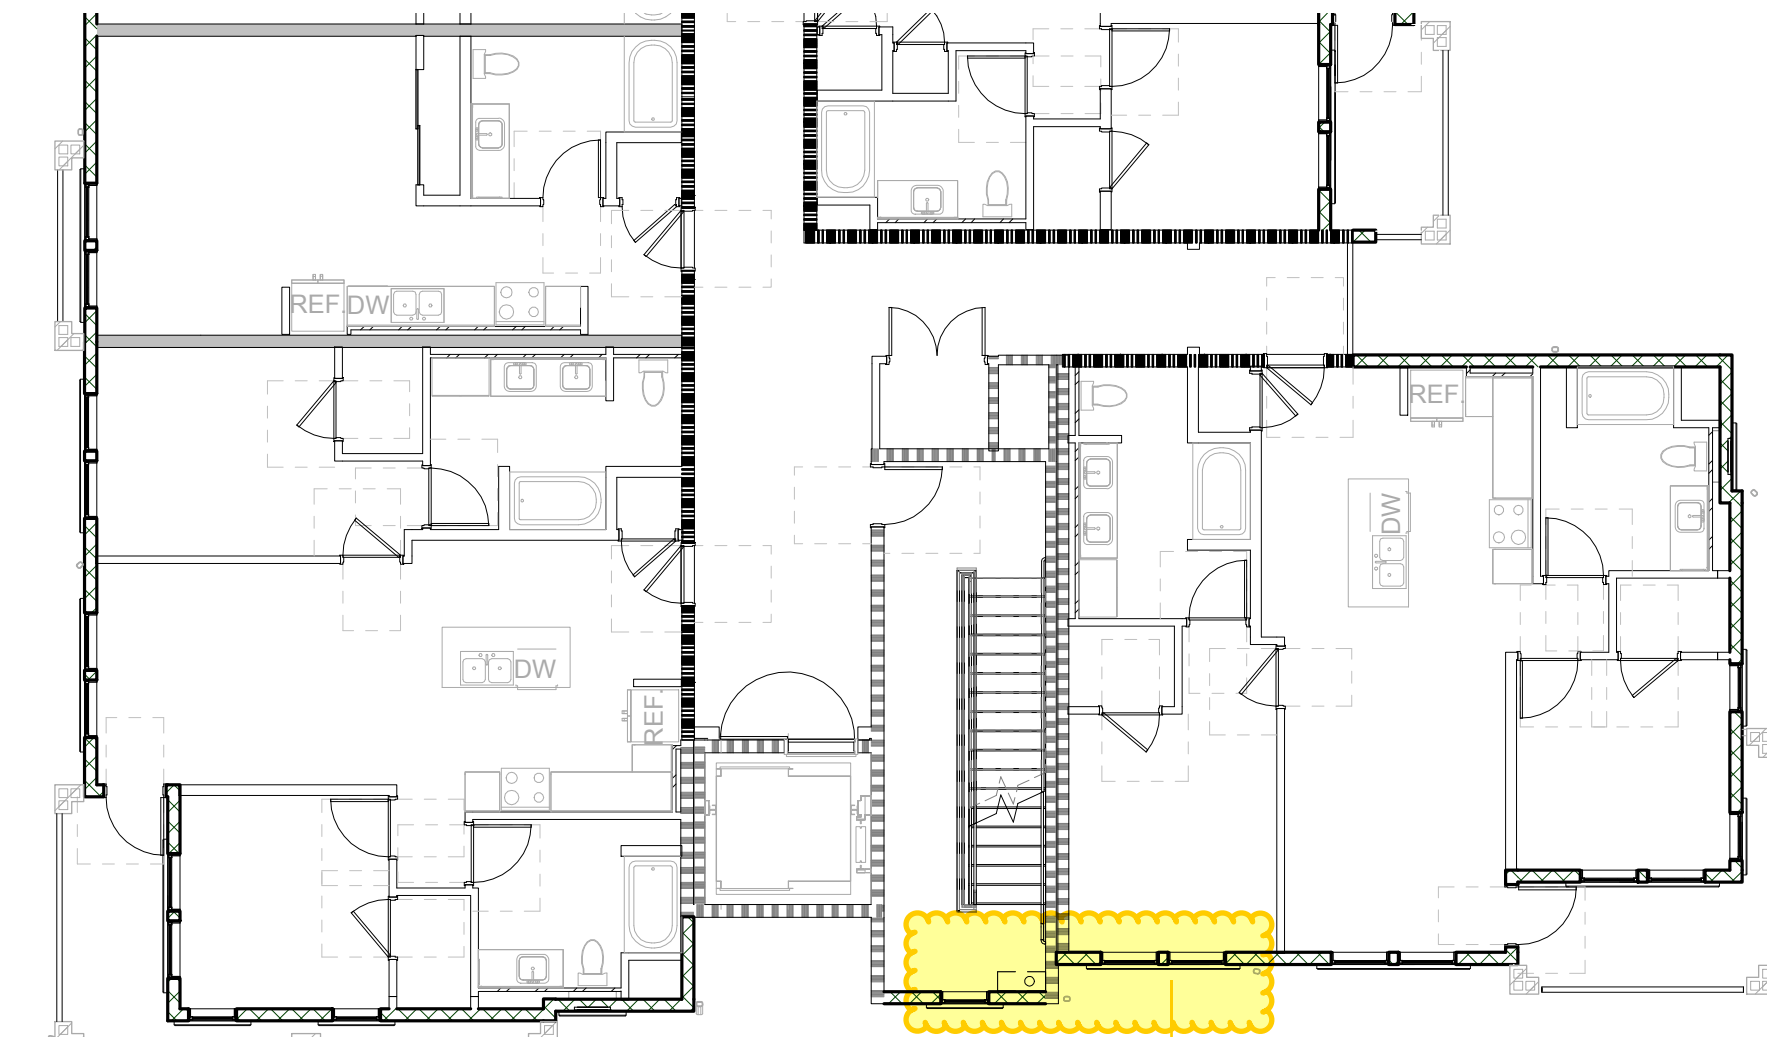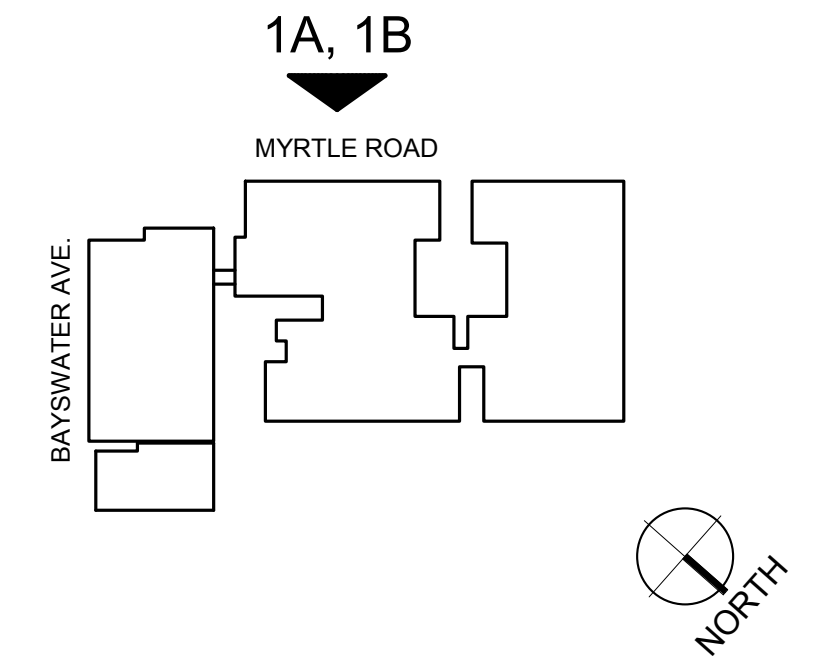


See response 2d


LEVEL 3 FLOOR PLAN PARTIAL 02
SCALE: 1" = 10'-0"

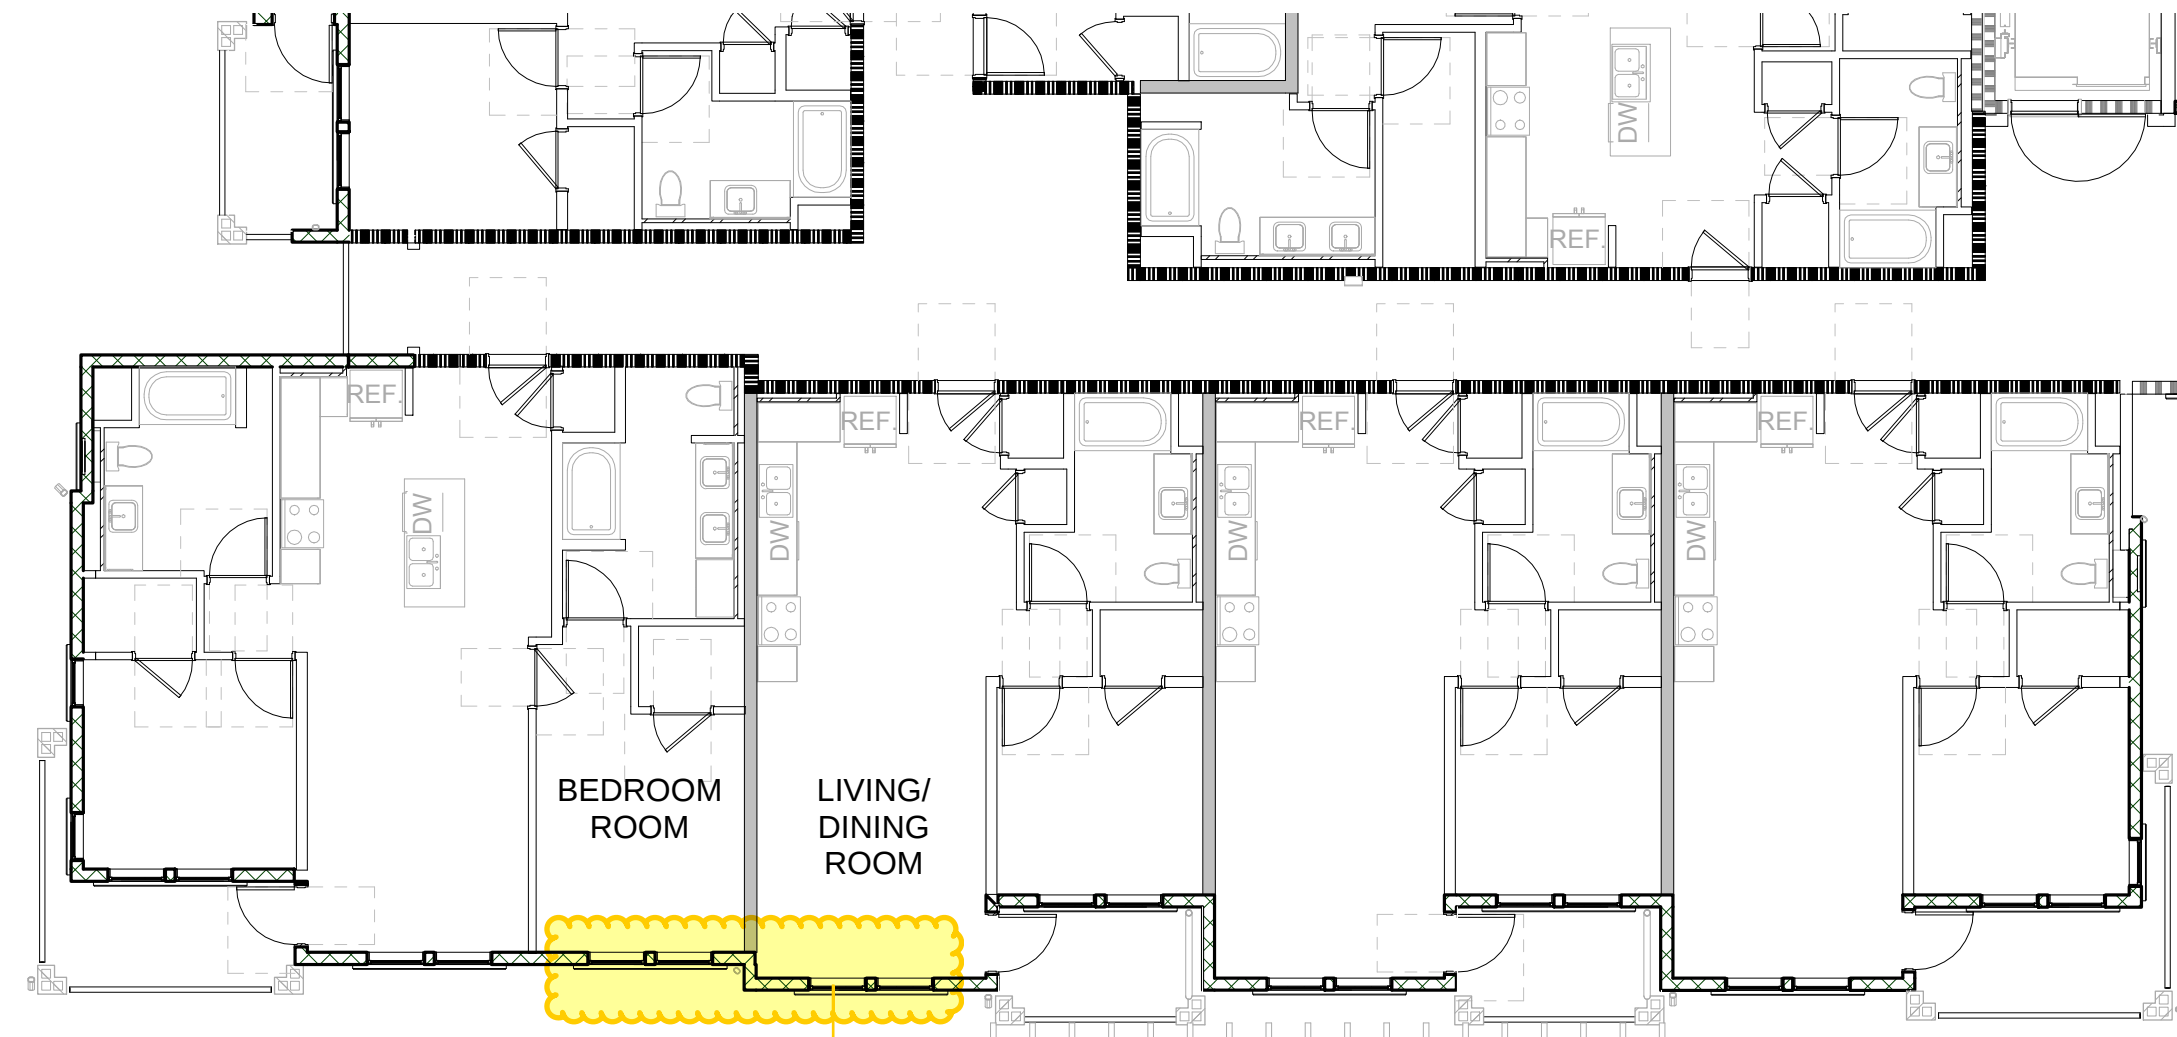

See response 2e

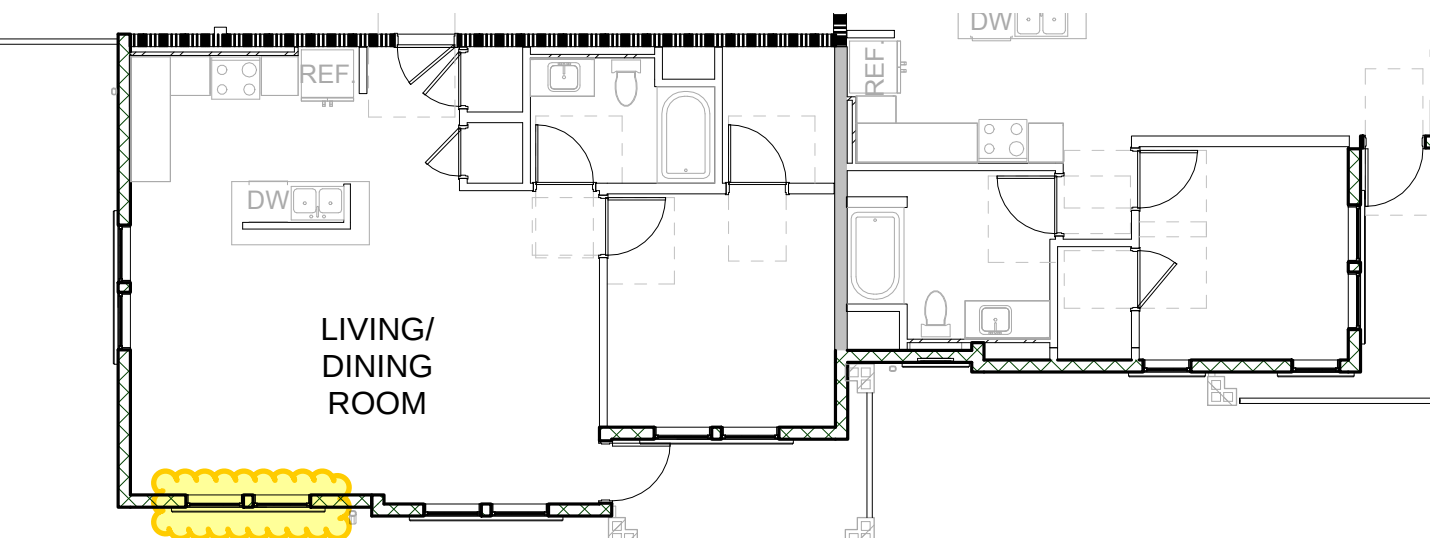

See response 2i

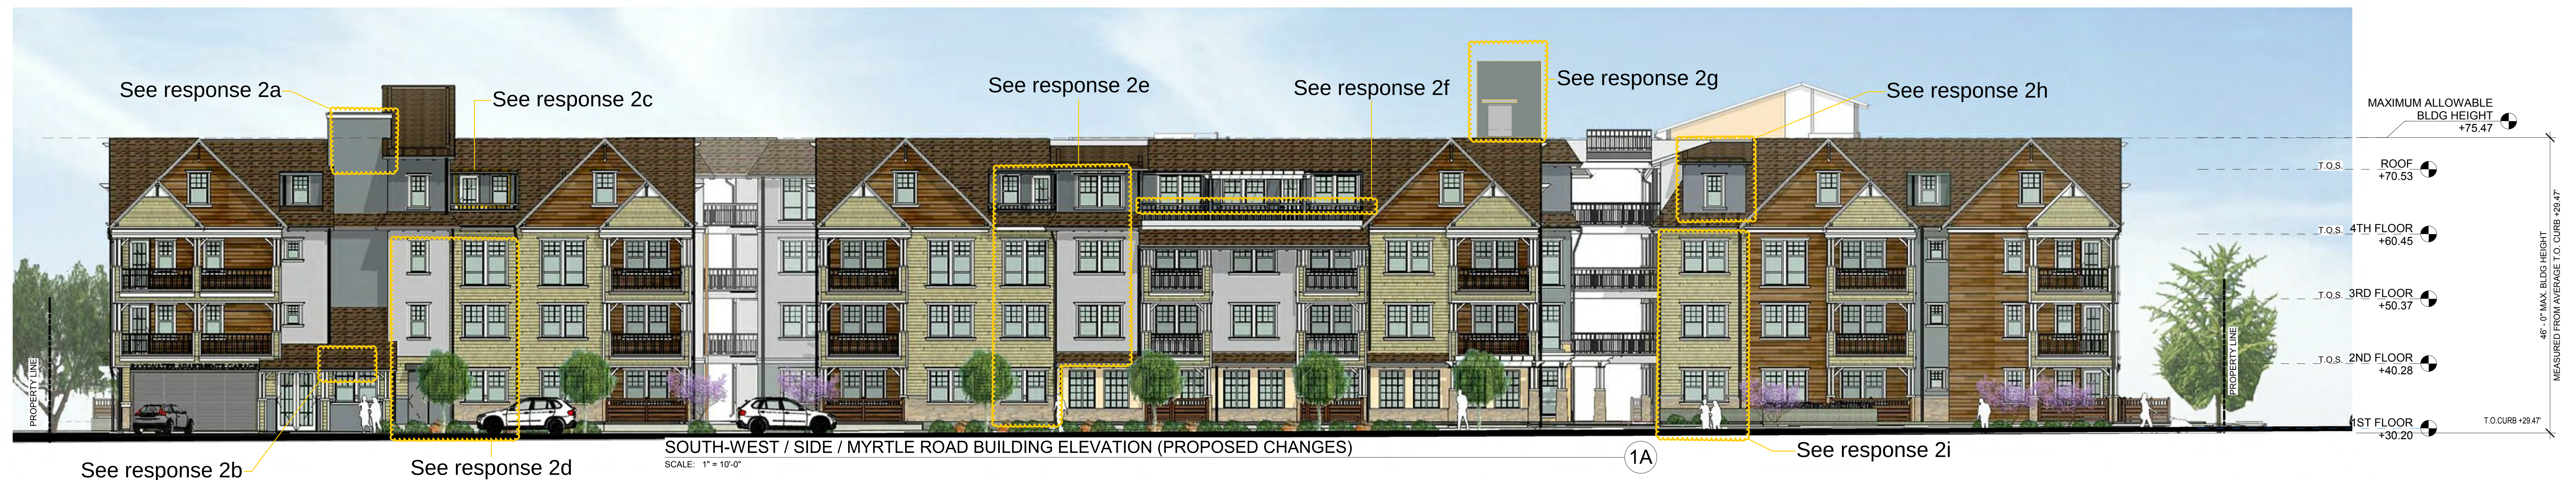






SOUTH-WEST / SIDE / MYRTLE ROAD BUILDING ELEVATION (PROPOSED CHANGES)
SCALE: 1" = 10'-0"





SOUTH-WEST / SIDE / MYRTLE ROAD BUILDING ELEVATION (ENTITLEMENT)
SCALE: 1" = 10'-0"

920 BAYSWATER AVE., BURLINGAME, CA 94010
FORE PROPERTY COMPANY

A300b

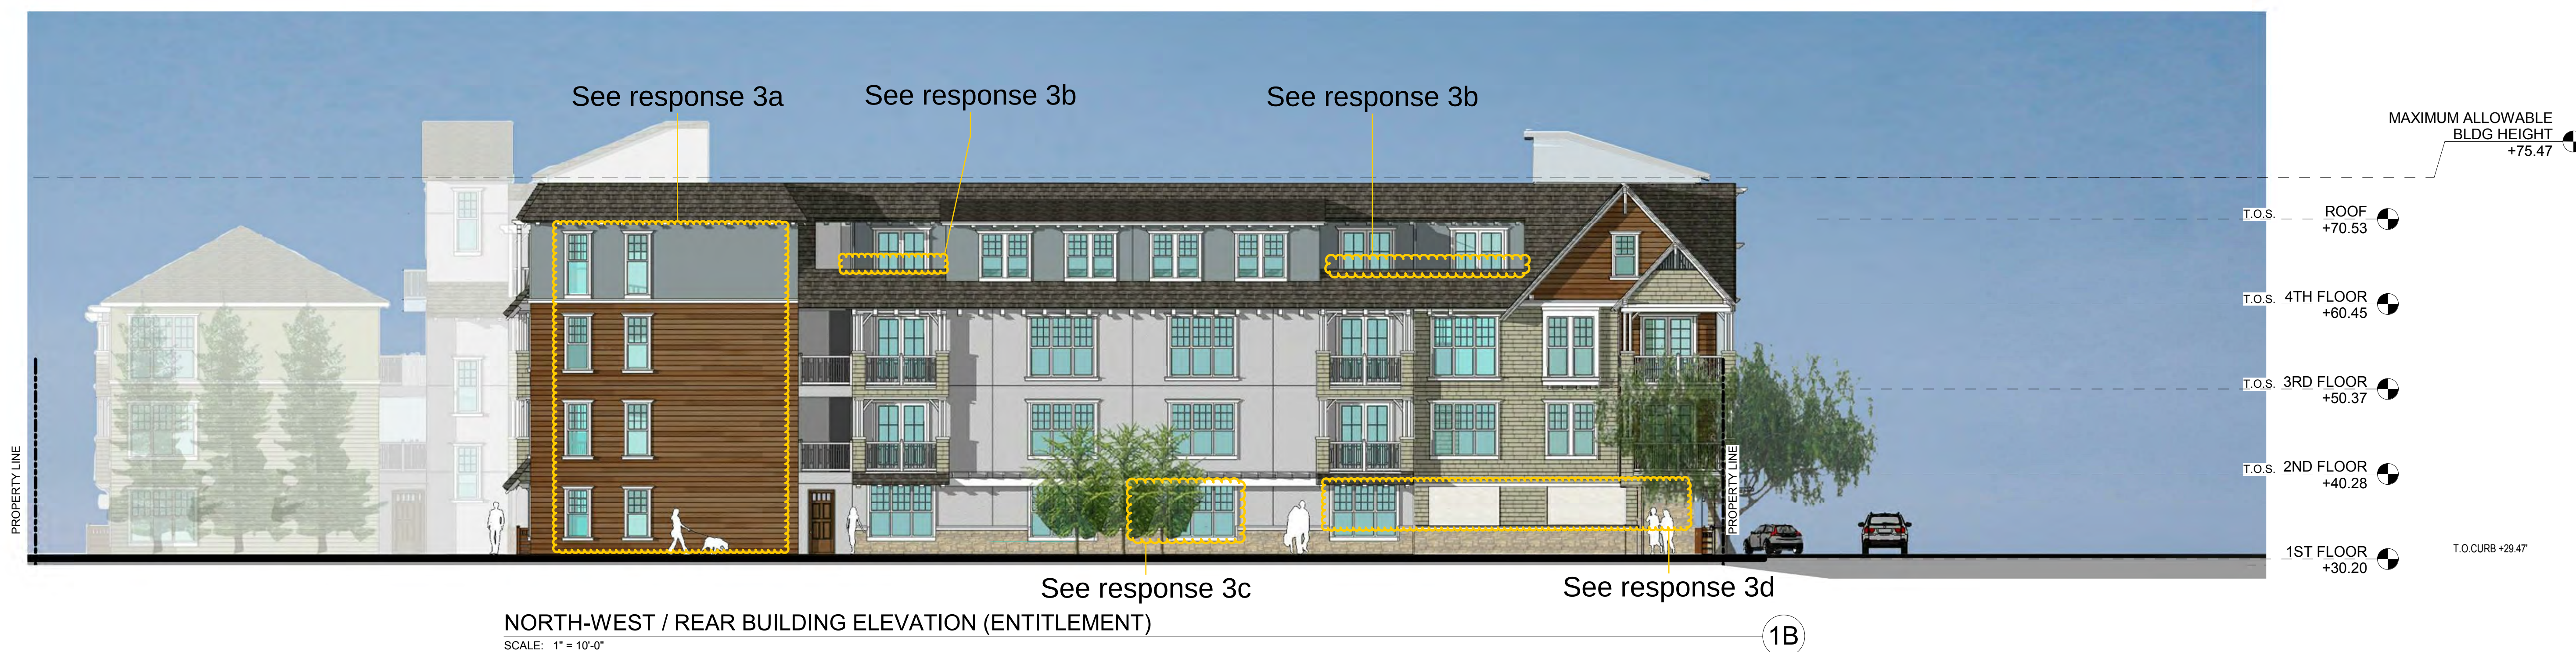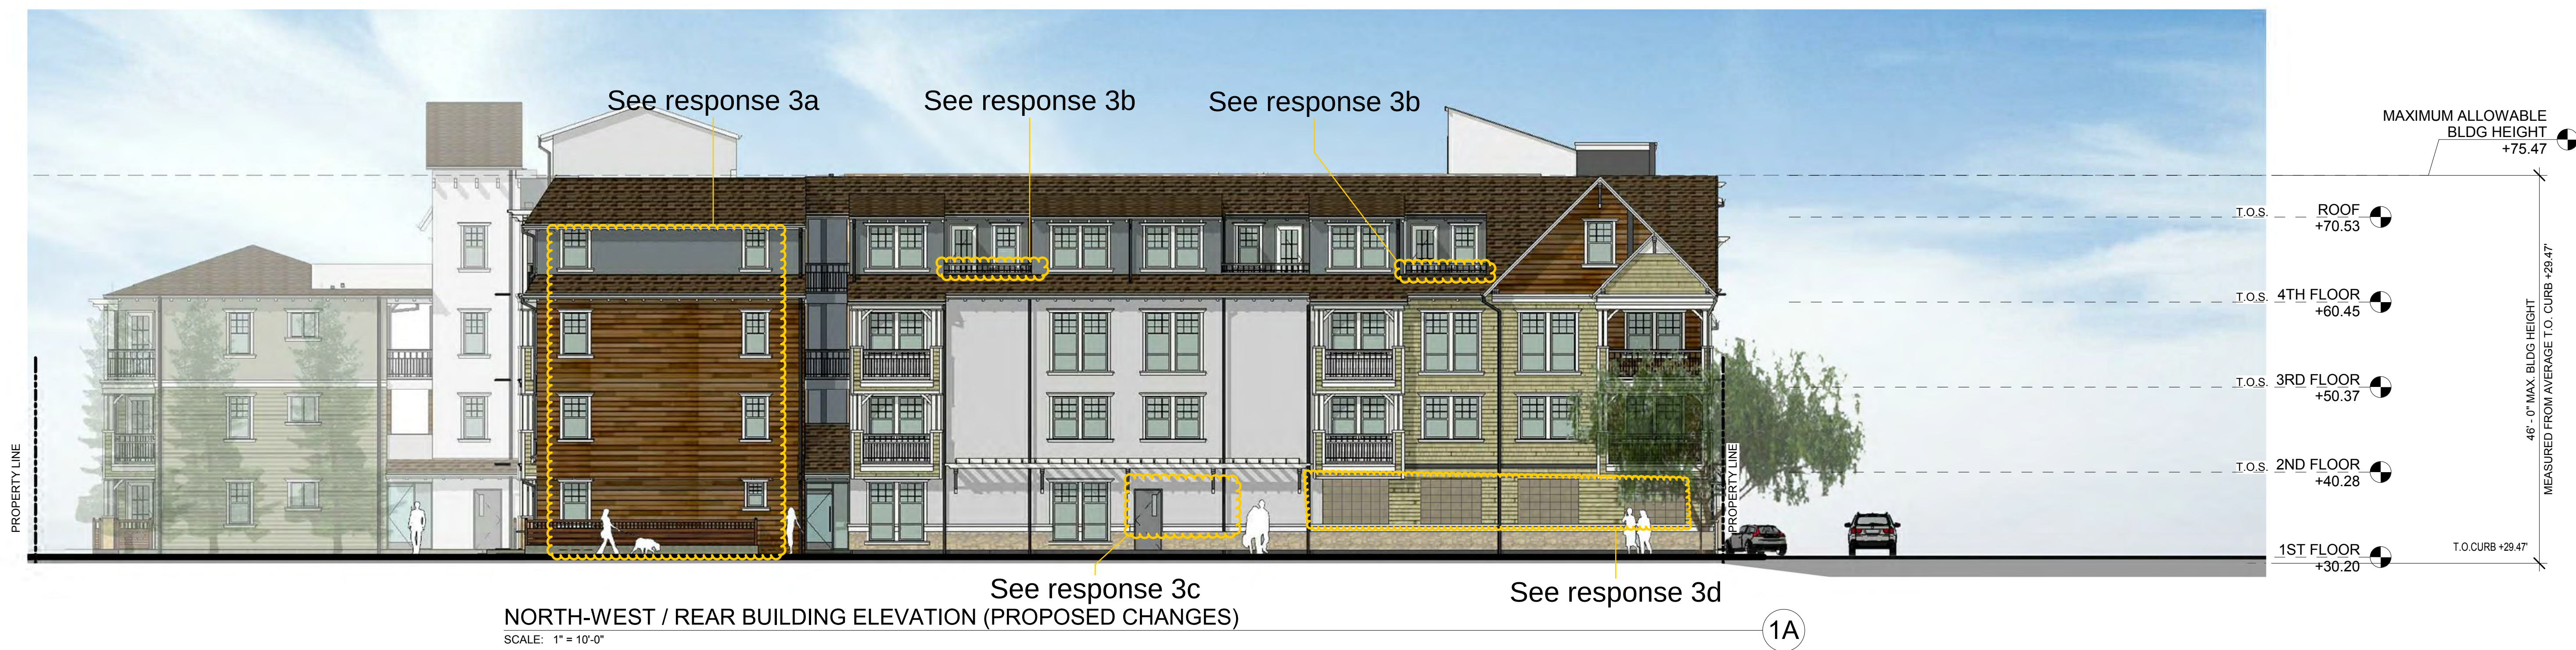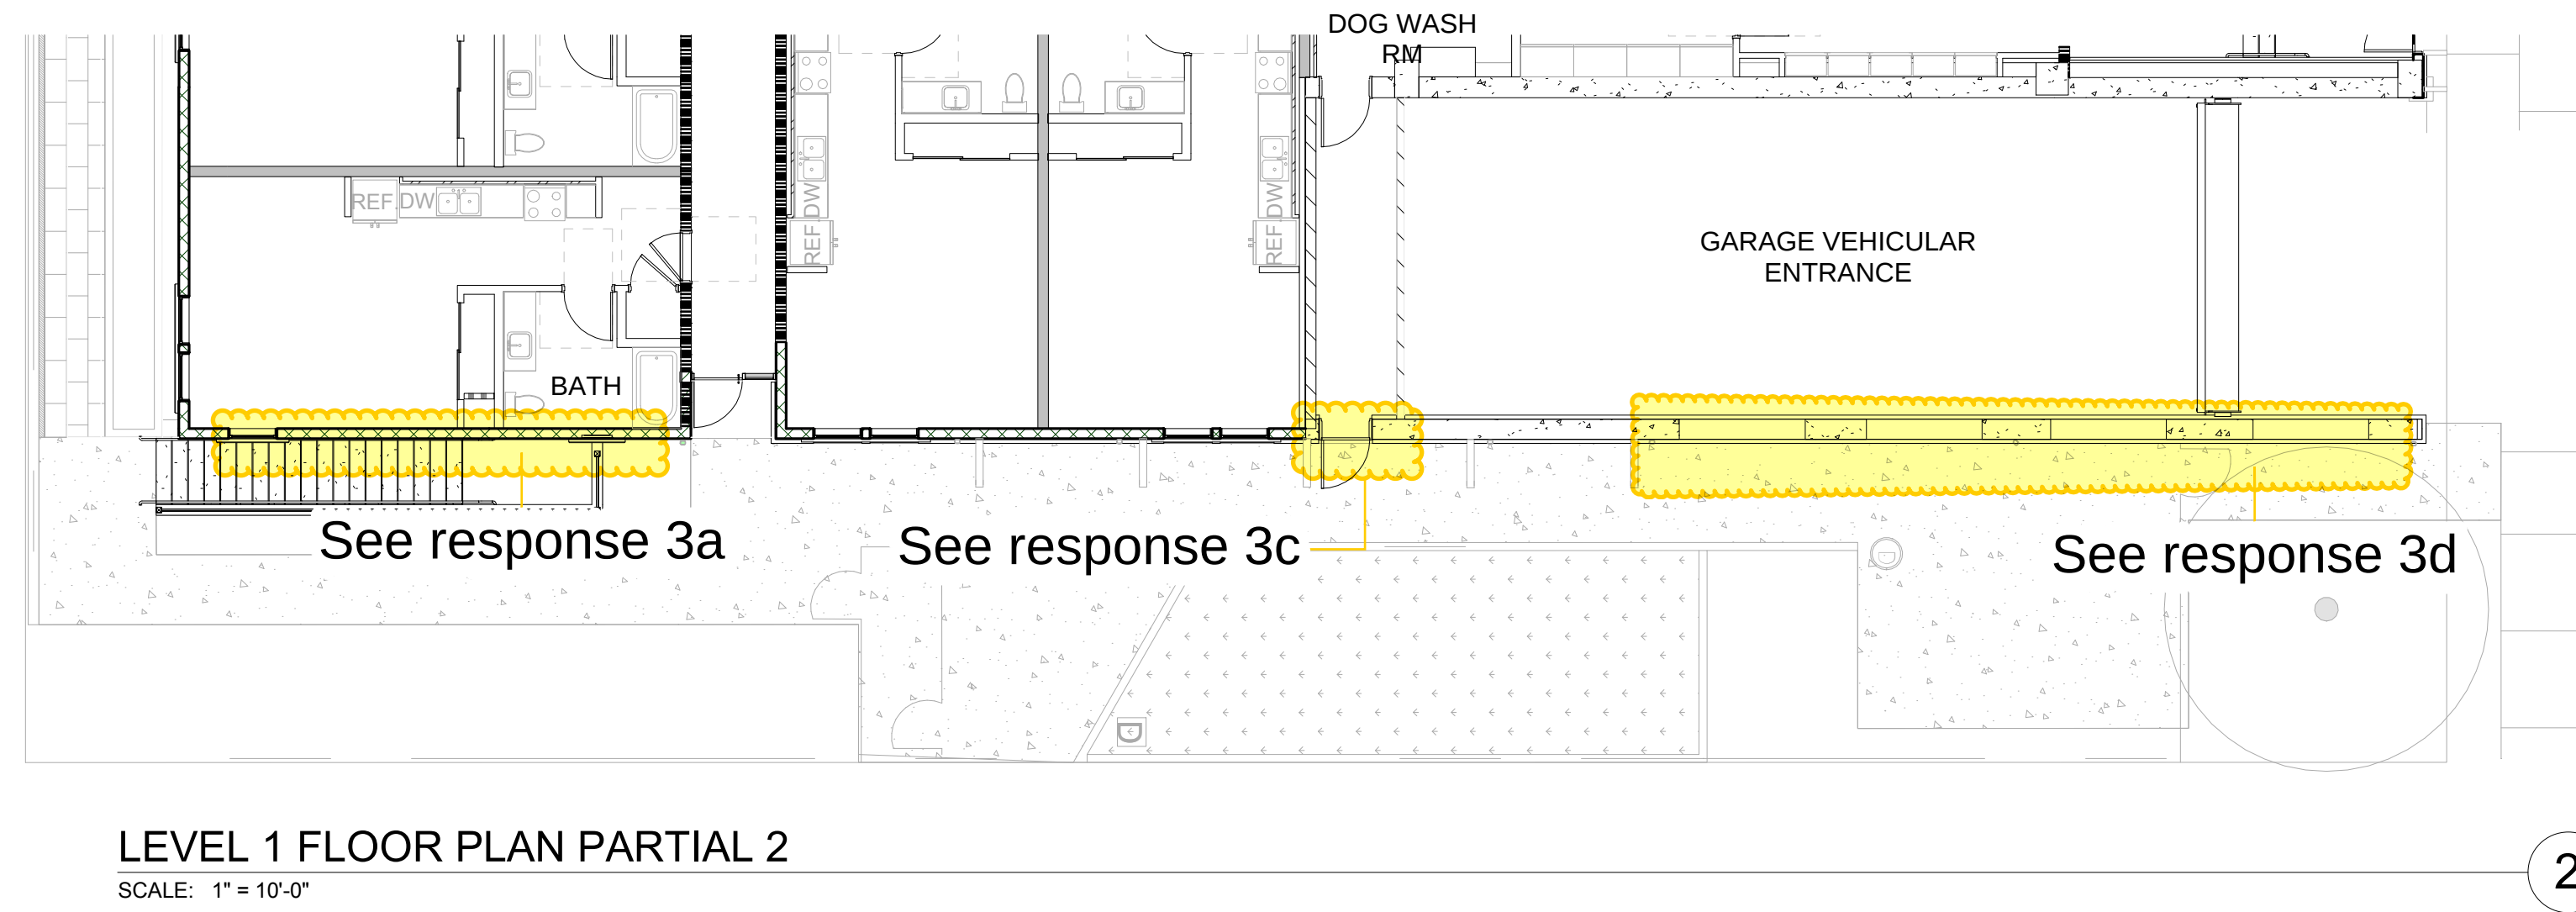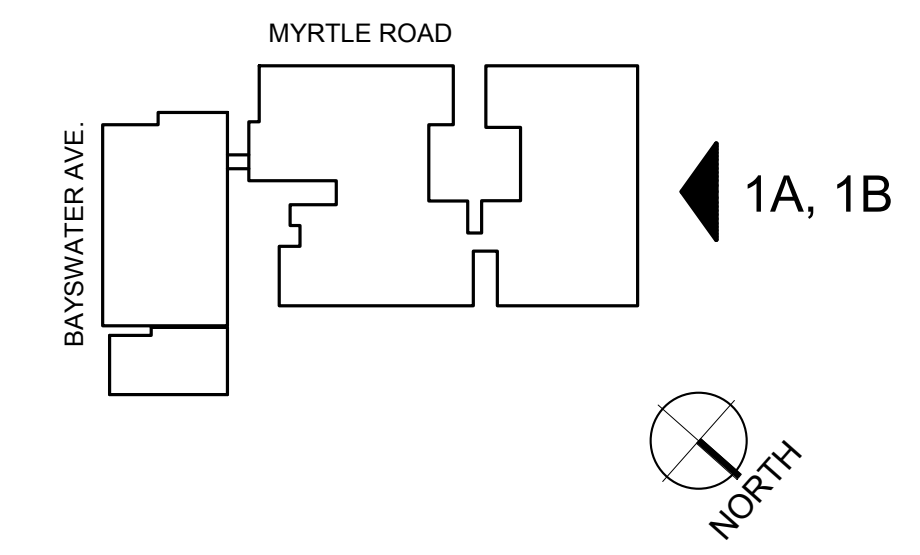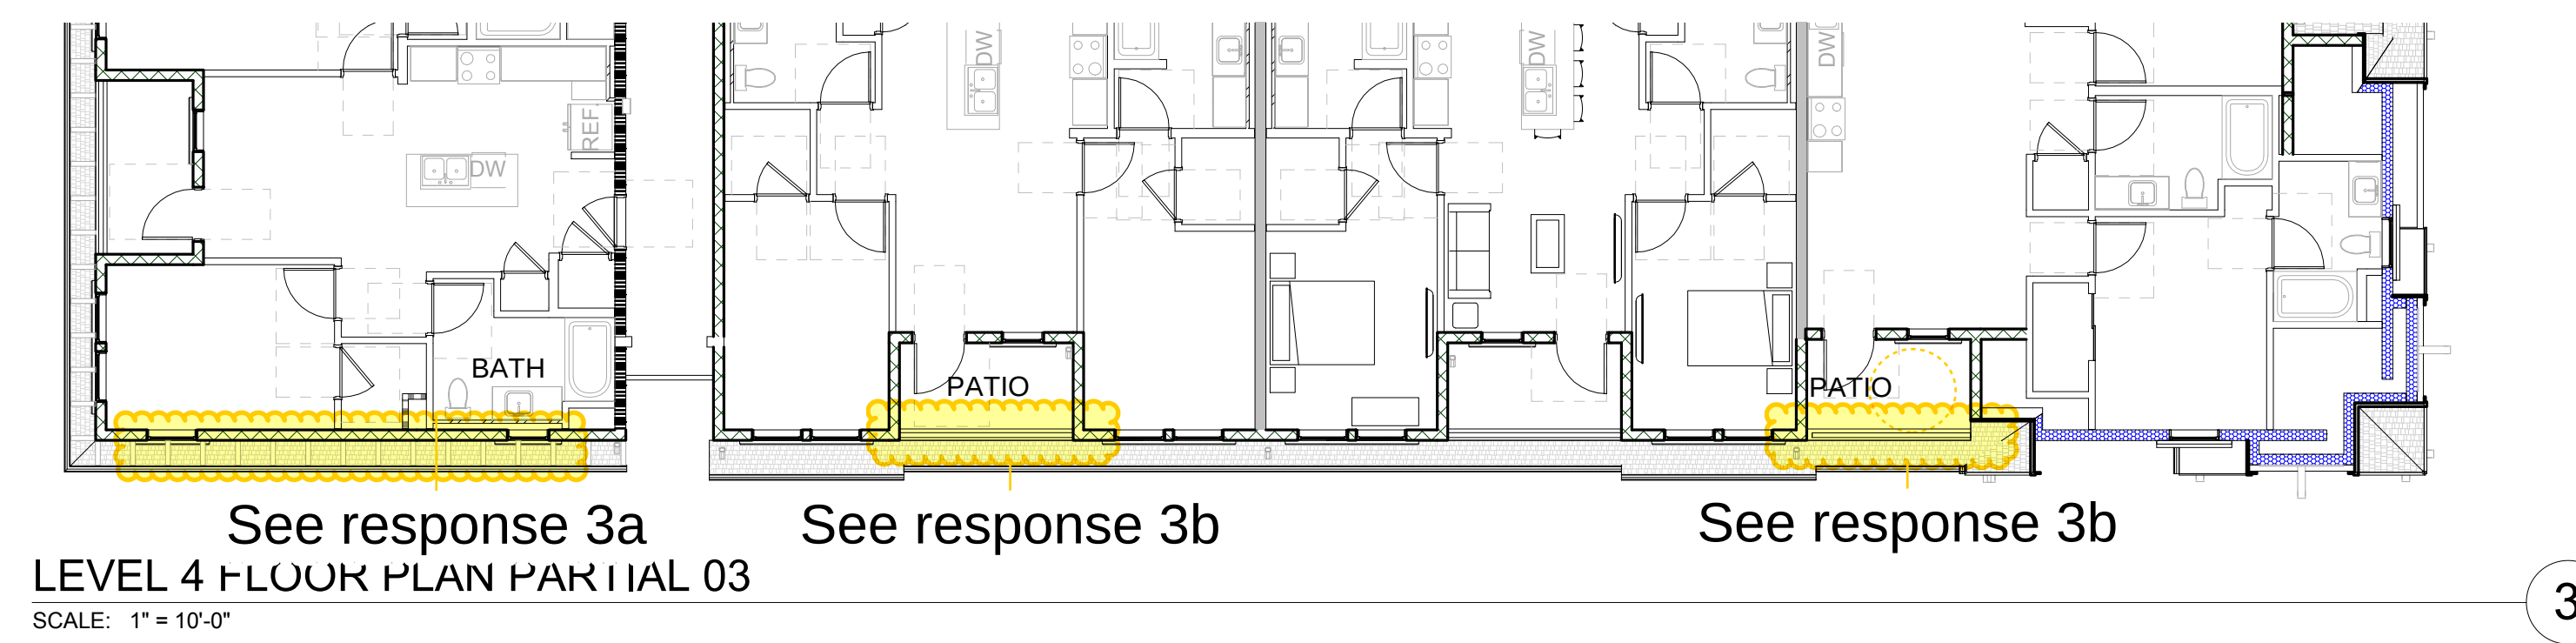

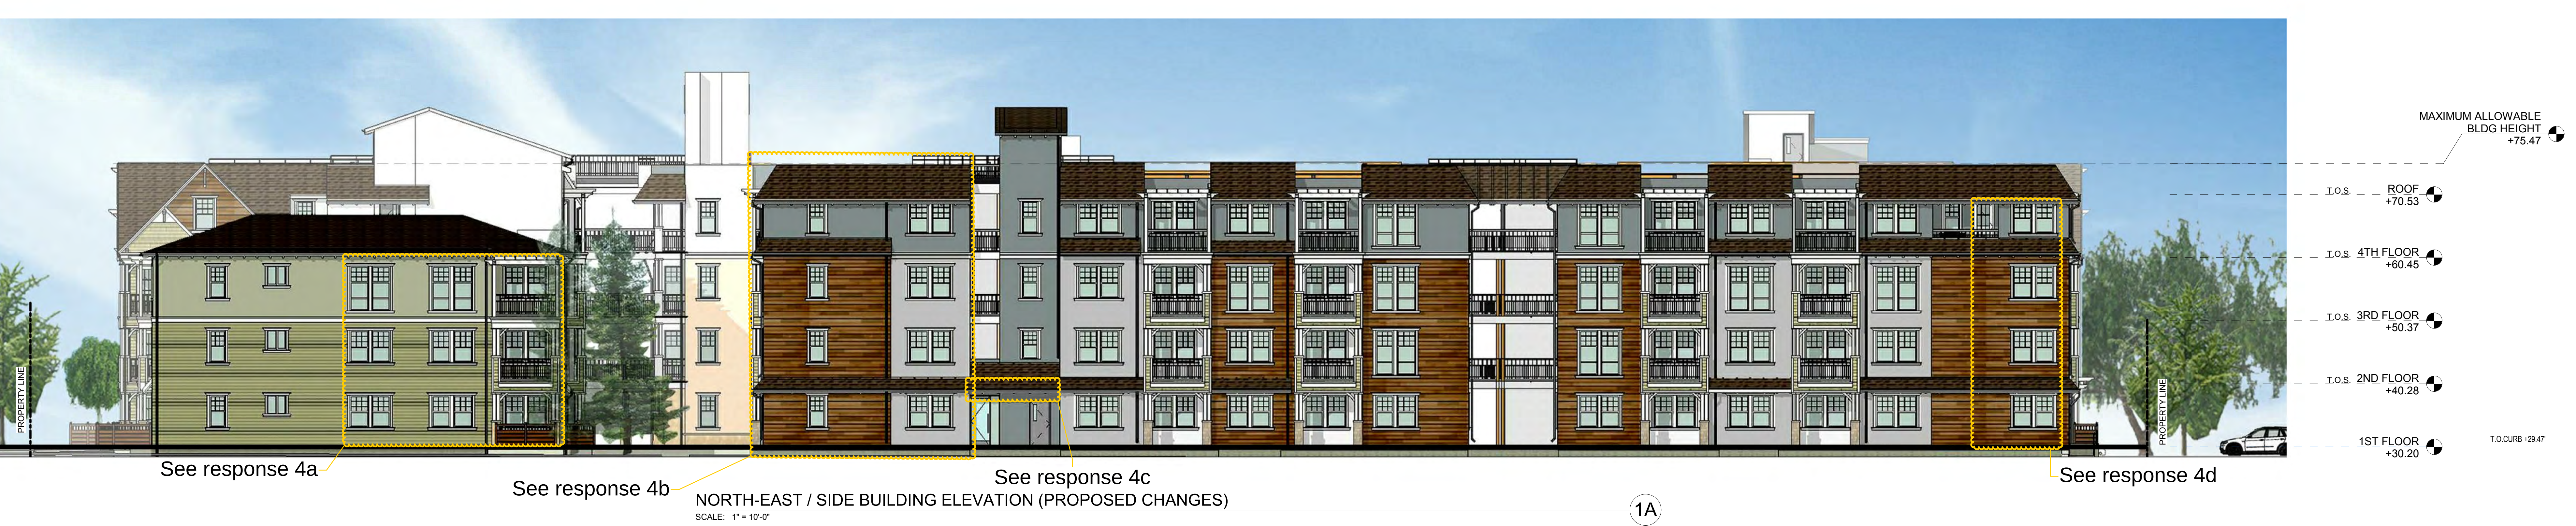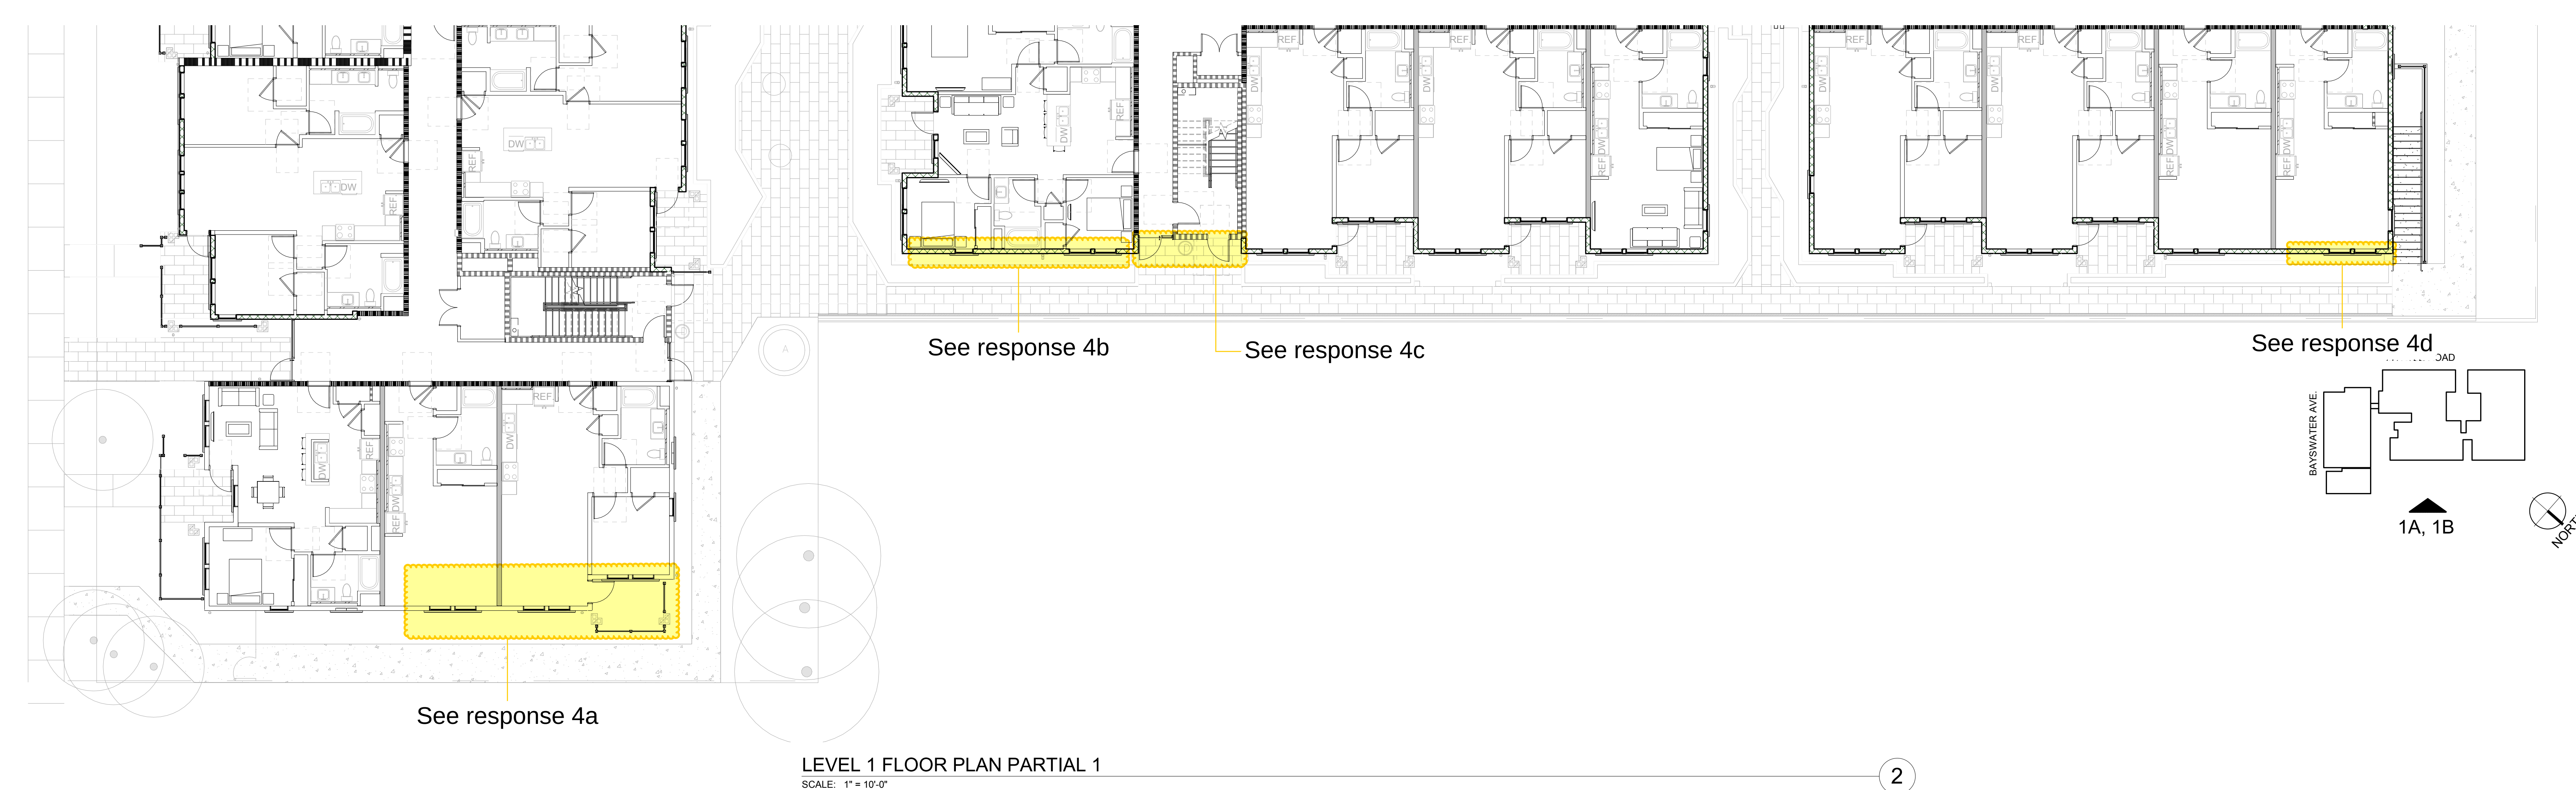









1



WITHEE MALCOLM
ARCHITECTS, LLP



2251 West 190th Street
Torrance, Ca 90504
t. 310.217.8885
f.310.217.0425

ROOF PLAN HEIGHT EXHIBIT

SHEET TITLE

SHEET No.

A026

3RD P.C. SUBMITTAL
06/07/2019

g. job no. B6079

drawn

submitta

1st Plan Check Submittal	02/05/2019
--------------------------	------------

2nd Plan Check Submittal	04/12/2019
--------------------------	------------

3rd Plan Check Submittal 06/07/2019

revision

date

consultant

owner

BAYSWATER
920 Bayswater Avenue
Burlingame, CA 94010

FORE PROPERTY COMPANY
18 Park Avenue, Los Gatos, CA 95030