
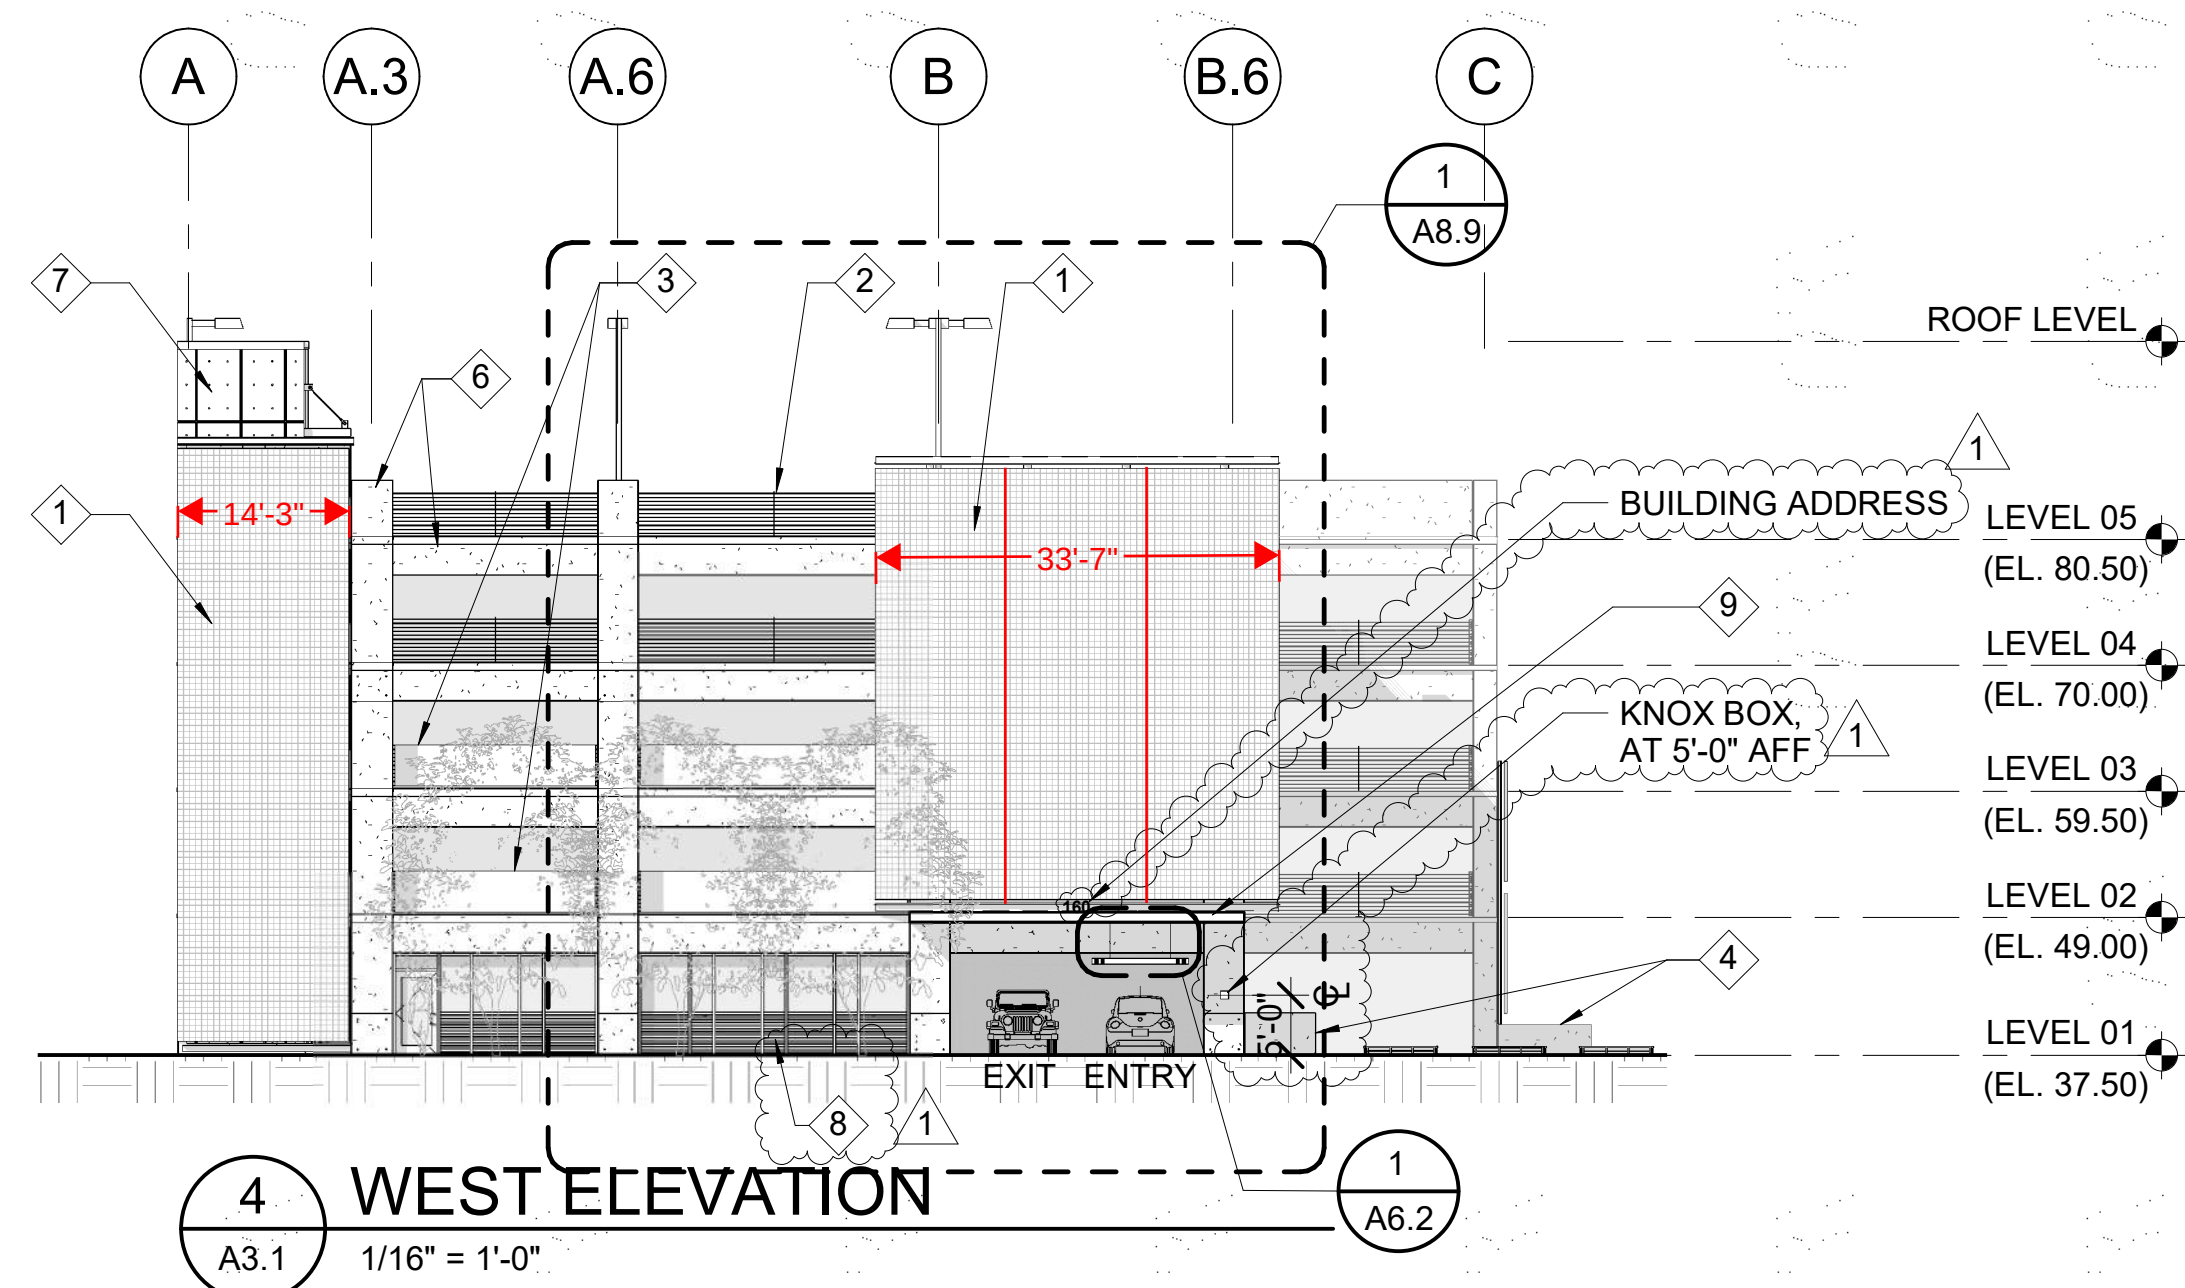
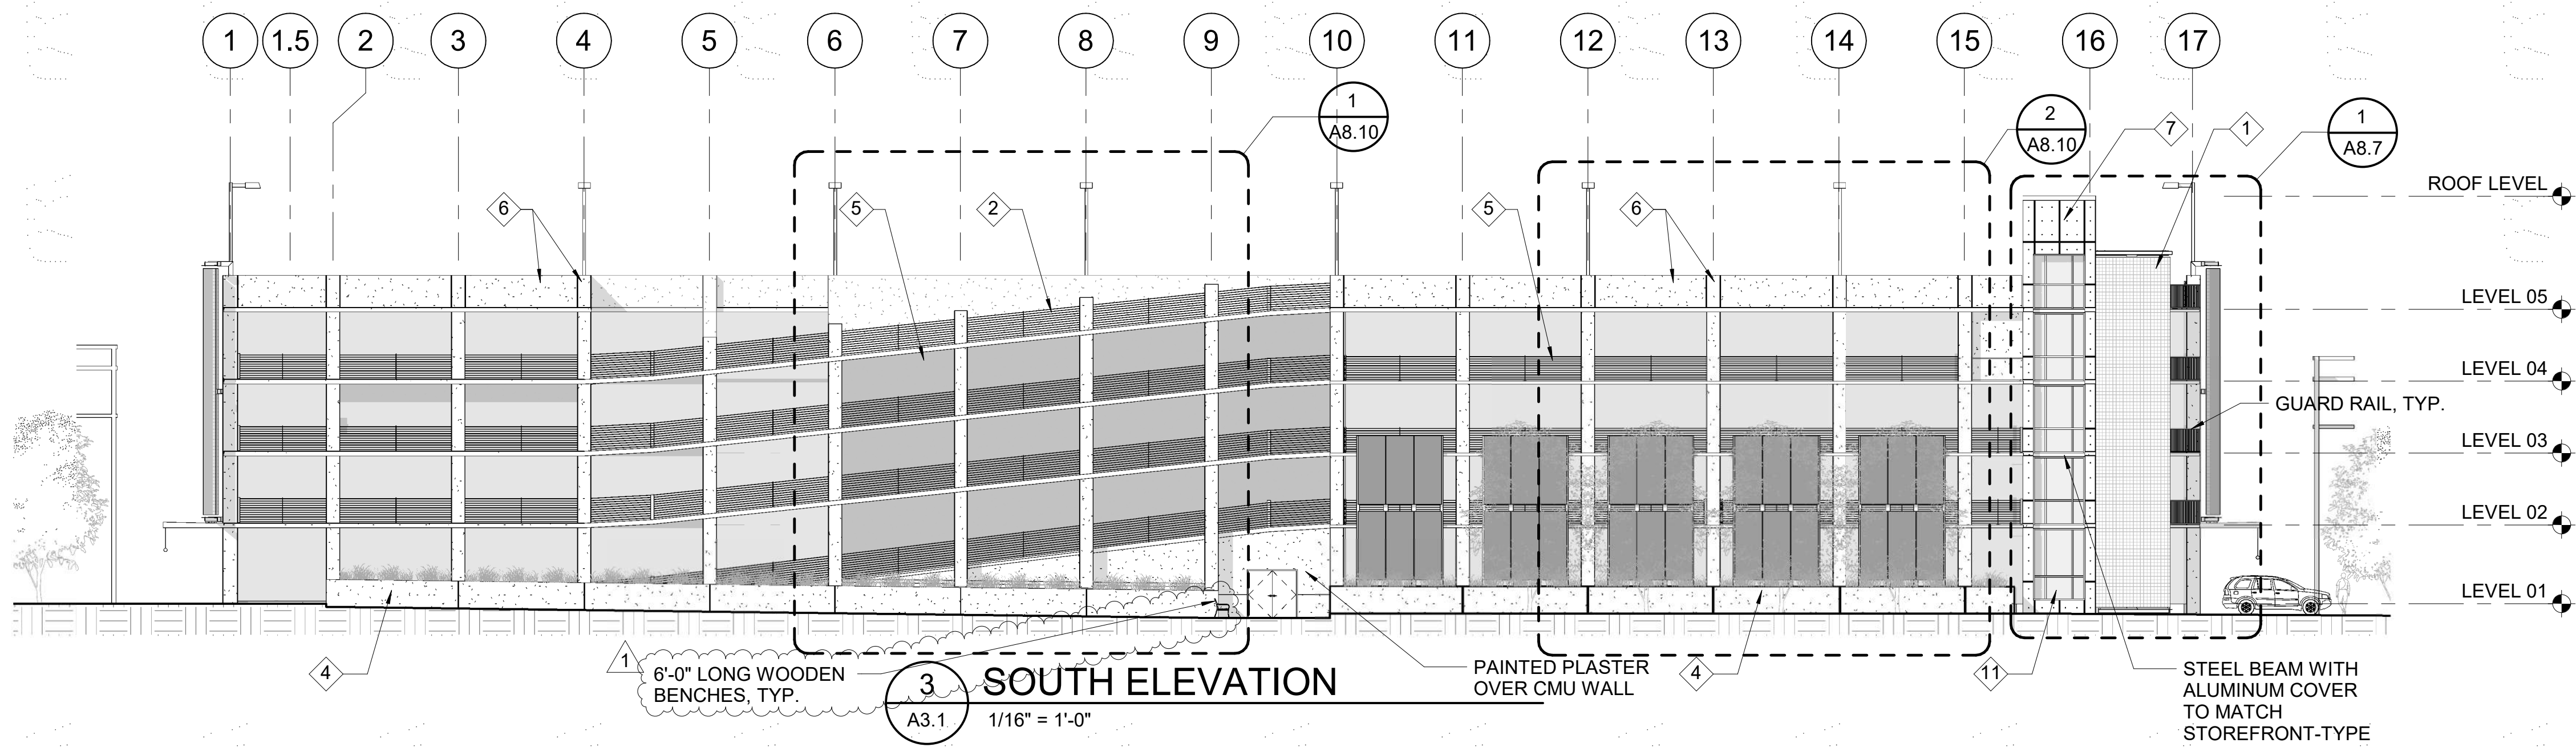
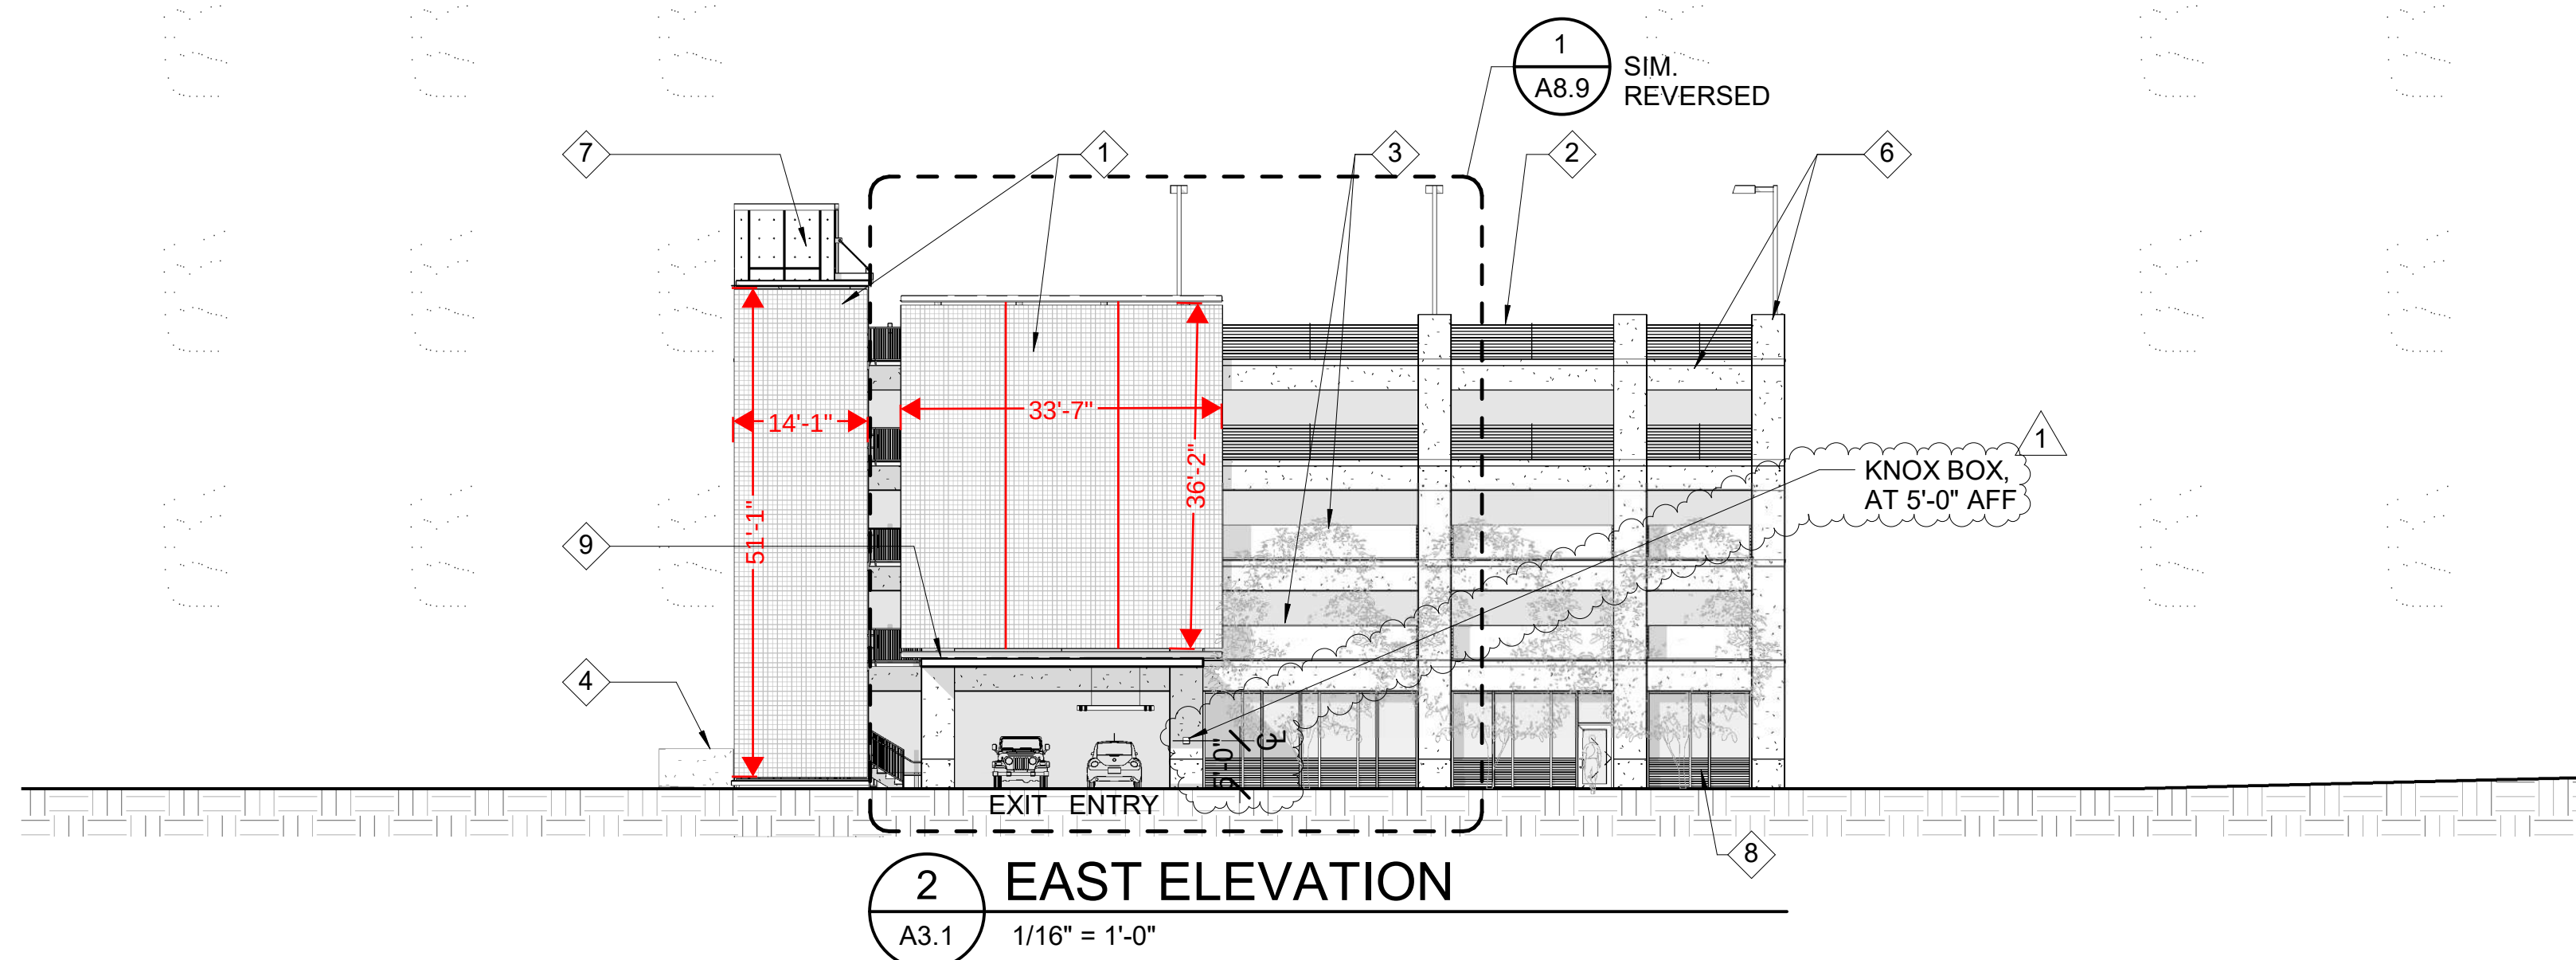


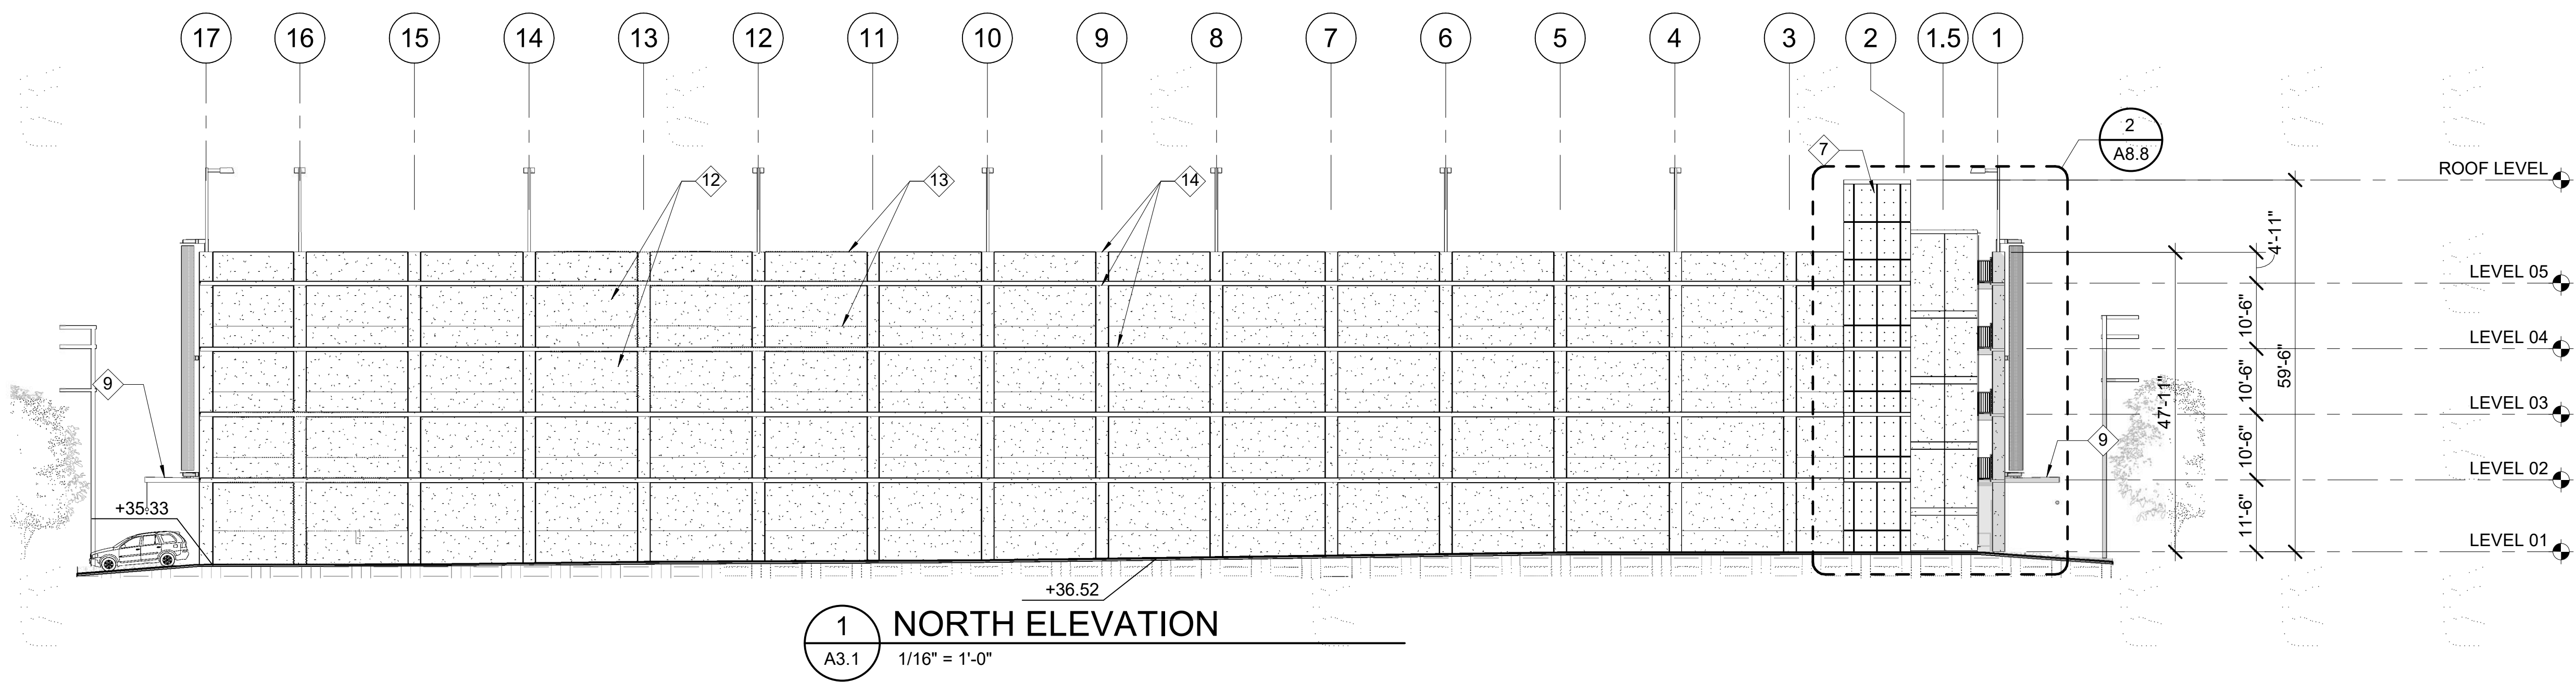


FINISHES SCHEDULE		
	TYPE	DESCRIPTION
1	ARCHITECTURAL SCREENS	
2	CABLE RAIL	
3	STEEL PLATE PANELS OVER CABLE RAIL	
4	RAISED STORM WATER FILTER	
5	GREEN SCREEN	
6	UNFINISHED CONCRETE	
7	UNFINISHED CONCRETE, EXPOSED FORMS	
8	STOREFRONT WINDOW	W/ MATCHING LOUVER AT BOTTOM SECTION
9	CONCRETE ENTRY CANOPY	
10	6'-0" METAL FENCE	
11	STOREFRONT WINDOW	CLEAR SAFETY GLASS
12	PAINTED CEMENT PLASTER OVER METAL STUD	
13	PAINTED CEMENT PLASTER OVER CMU WALL	
14	PAINTED CEMENT PLASTER OVER CONCRETE	


NOTE:
ALL GLAZING IN HAZARDOUS LOCATIONS SHALL COMPLY WITH CBC 2406

REVISIONS		
NO.	DATE	BY
1	07/17/2019	

PLAN CHECK RESPONSE #1	
JOB NO.:	17-030
DATE :	07/17/2019
DESIGN:	MORALES
DRAWN:	OSEGUERA
CHK. BY:	MORALES
SCALE :	As indicated
SHEET:	

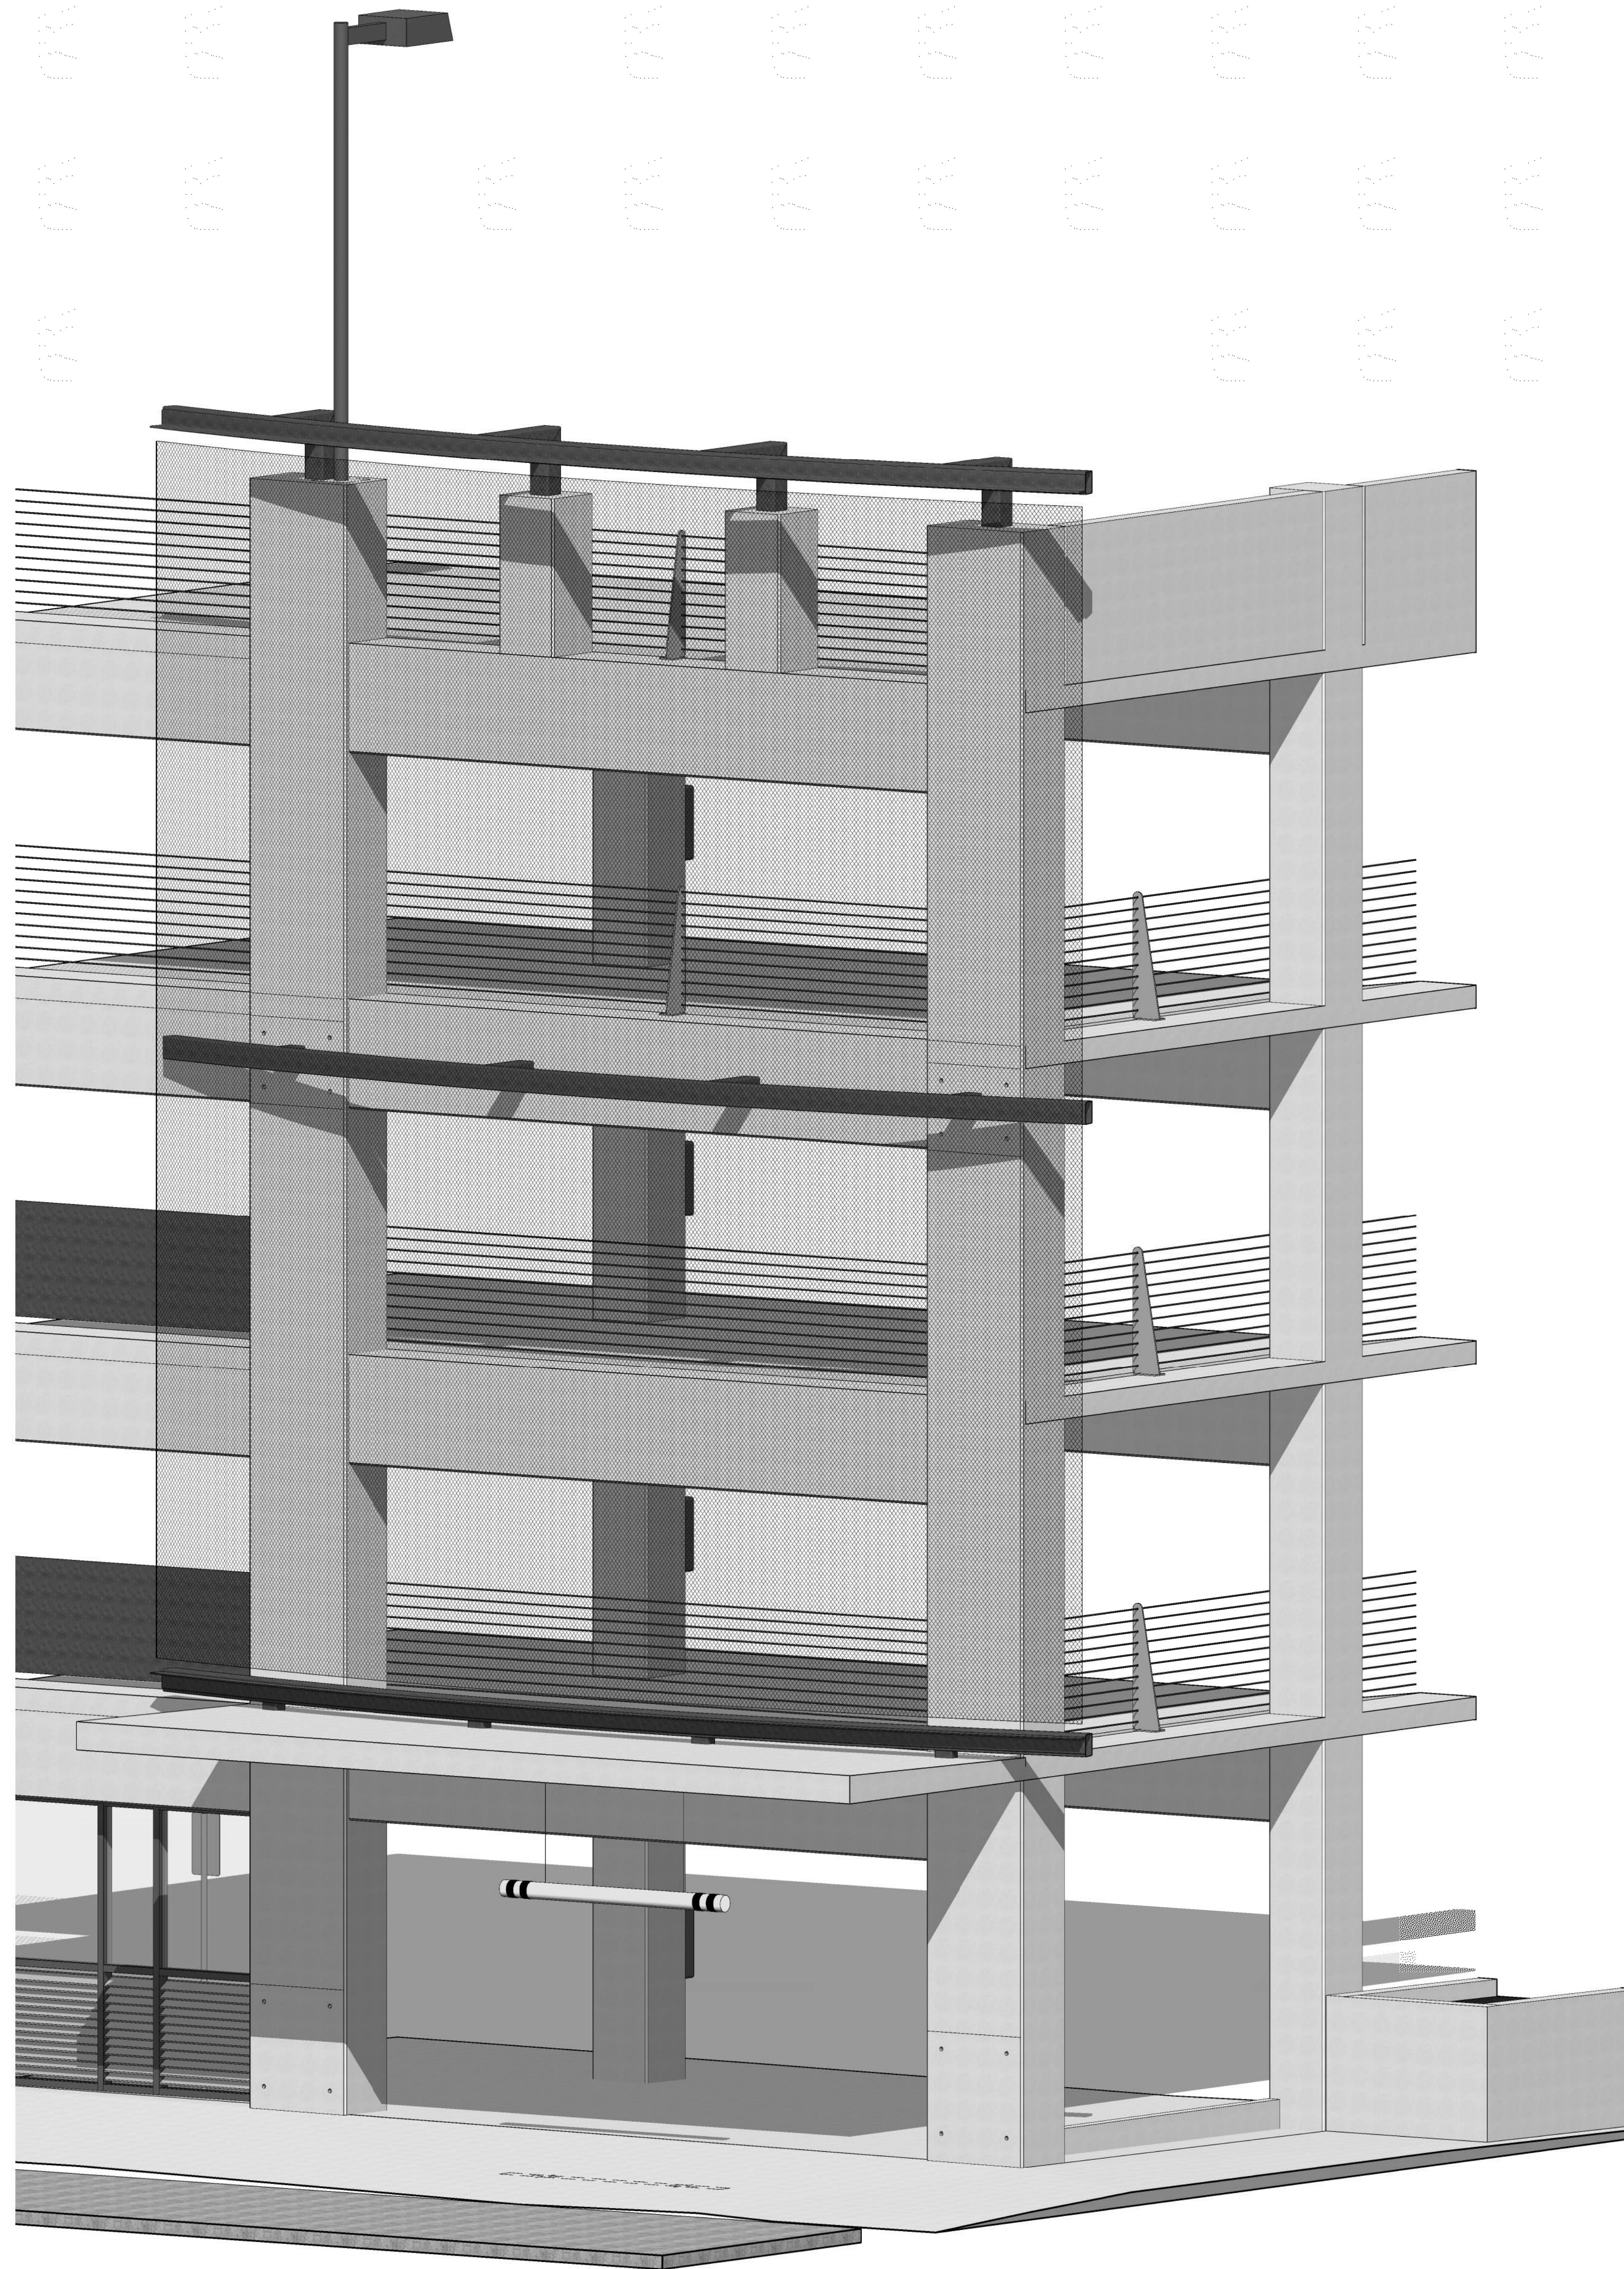

WEST ENTRY

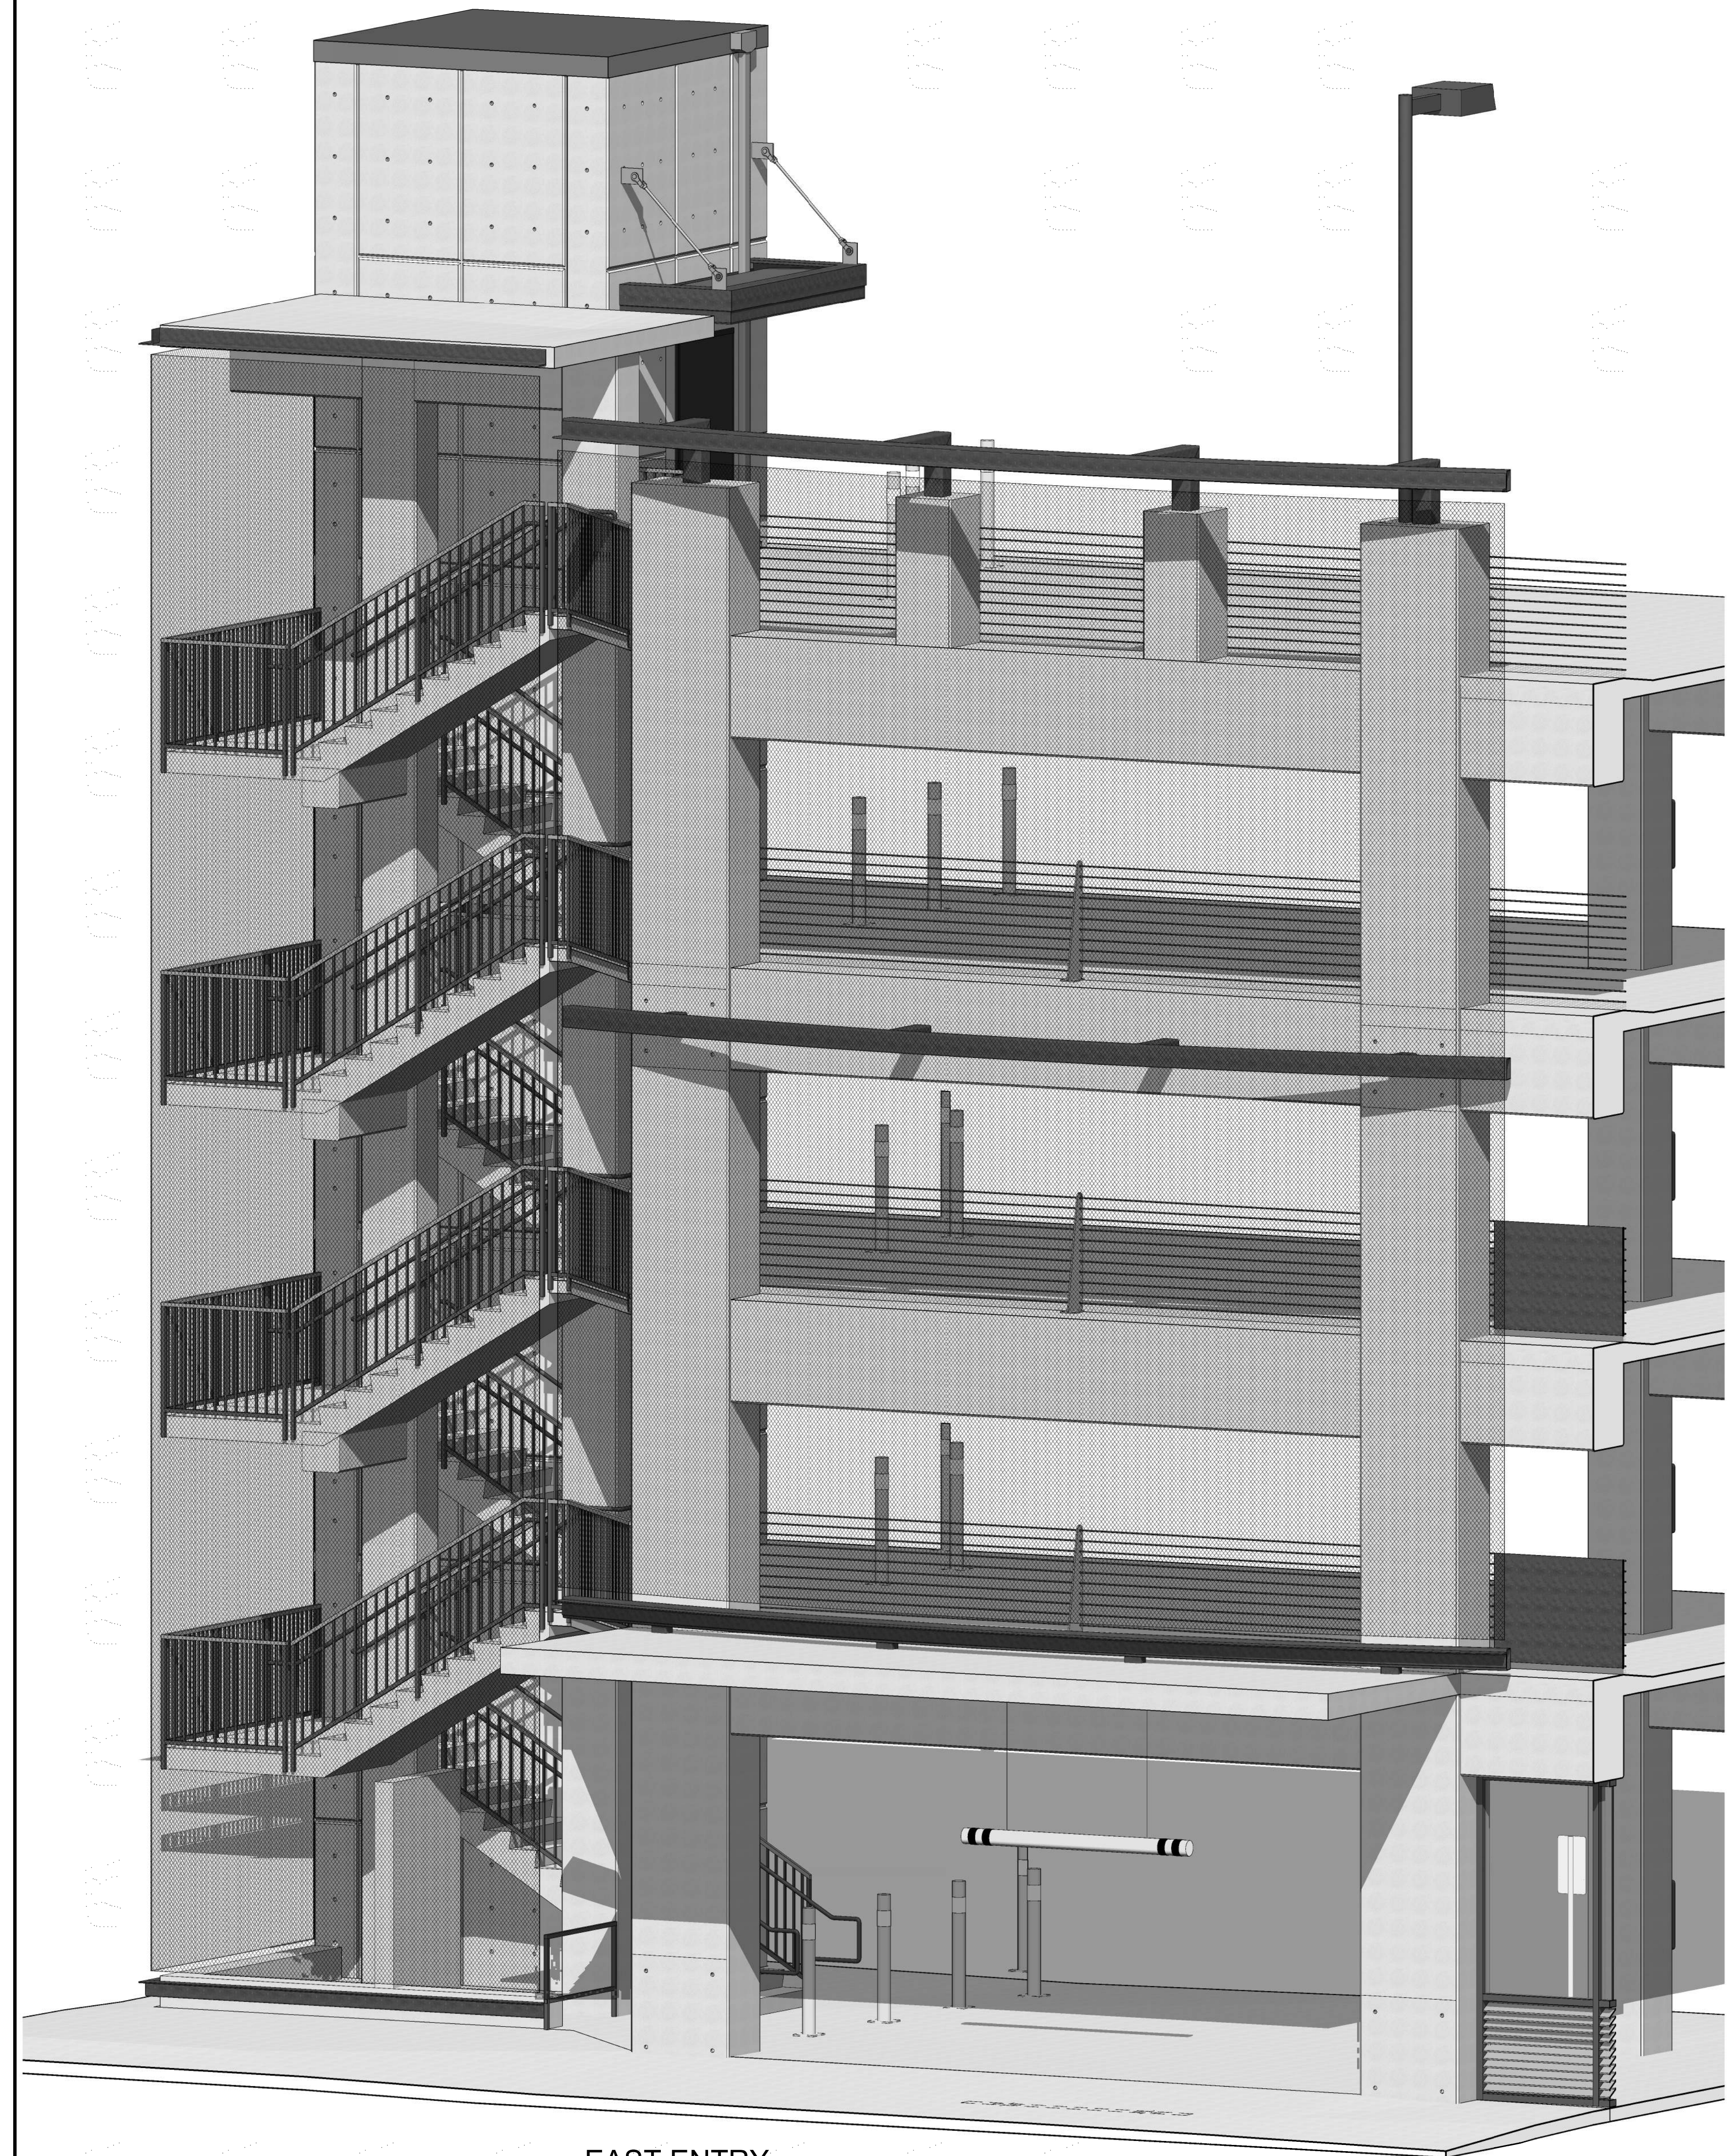

EAST ENTRY

