


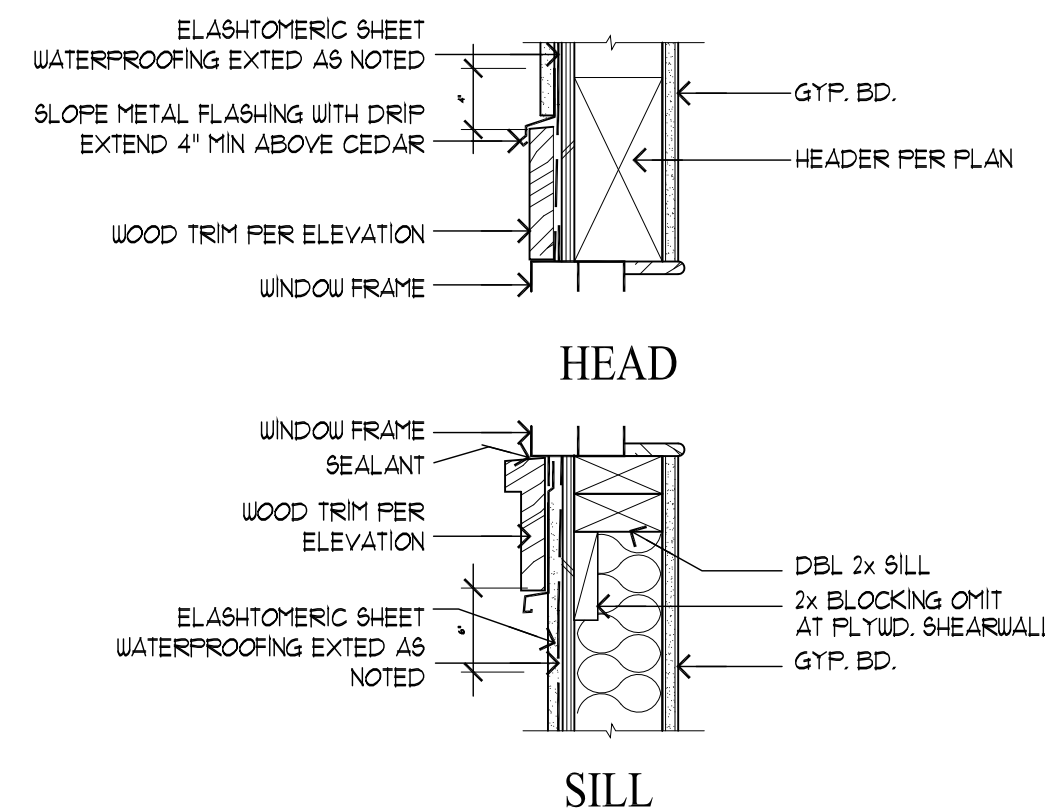

**CHU** DESIGN ASSOCIATES INC.  
 55 W. 43rd AVENUE  
 SAN MATEO, CALIFORNIA 94403  
 TEL: (650) 345-9286  
 FAX: (650) 345-9287


NEW RESIDENCE  
1509 BERNAL AVE.  
BURLINGAME CA  
A.P.N.: 026-034-100

|           |           |
|-----------|-----------|
| DATE:     | OCT. 2018 |
| SCALE:    | AS NOTED  |
| DRAWN:    | PU        |
| JOB:      |           |
| SHEET NO. |           |
| A.4       |           |
| OF SHEETS |           |

EE = EMERGENCY EGRESS

1 TYP. HEAD + SILL DETAIL  
SCALE: 1"=1'-0"

LEGEND  
EE : EMERGENCY EGRESS

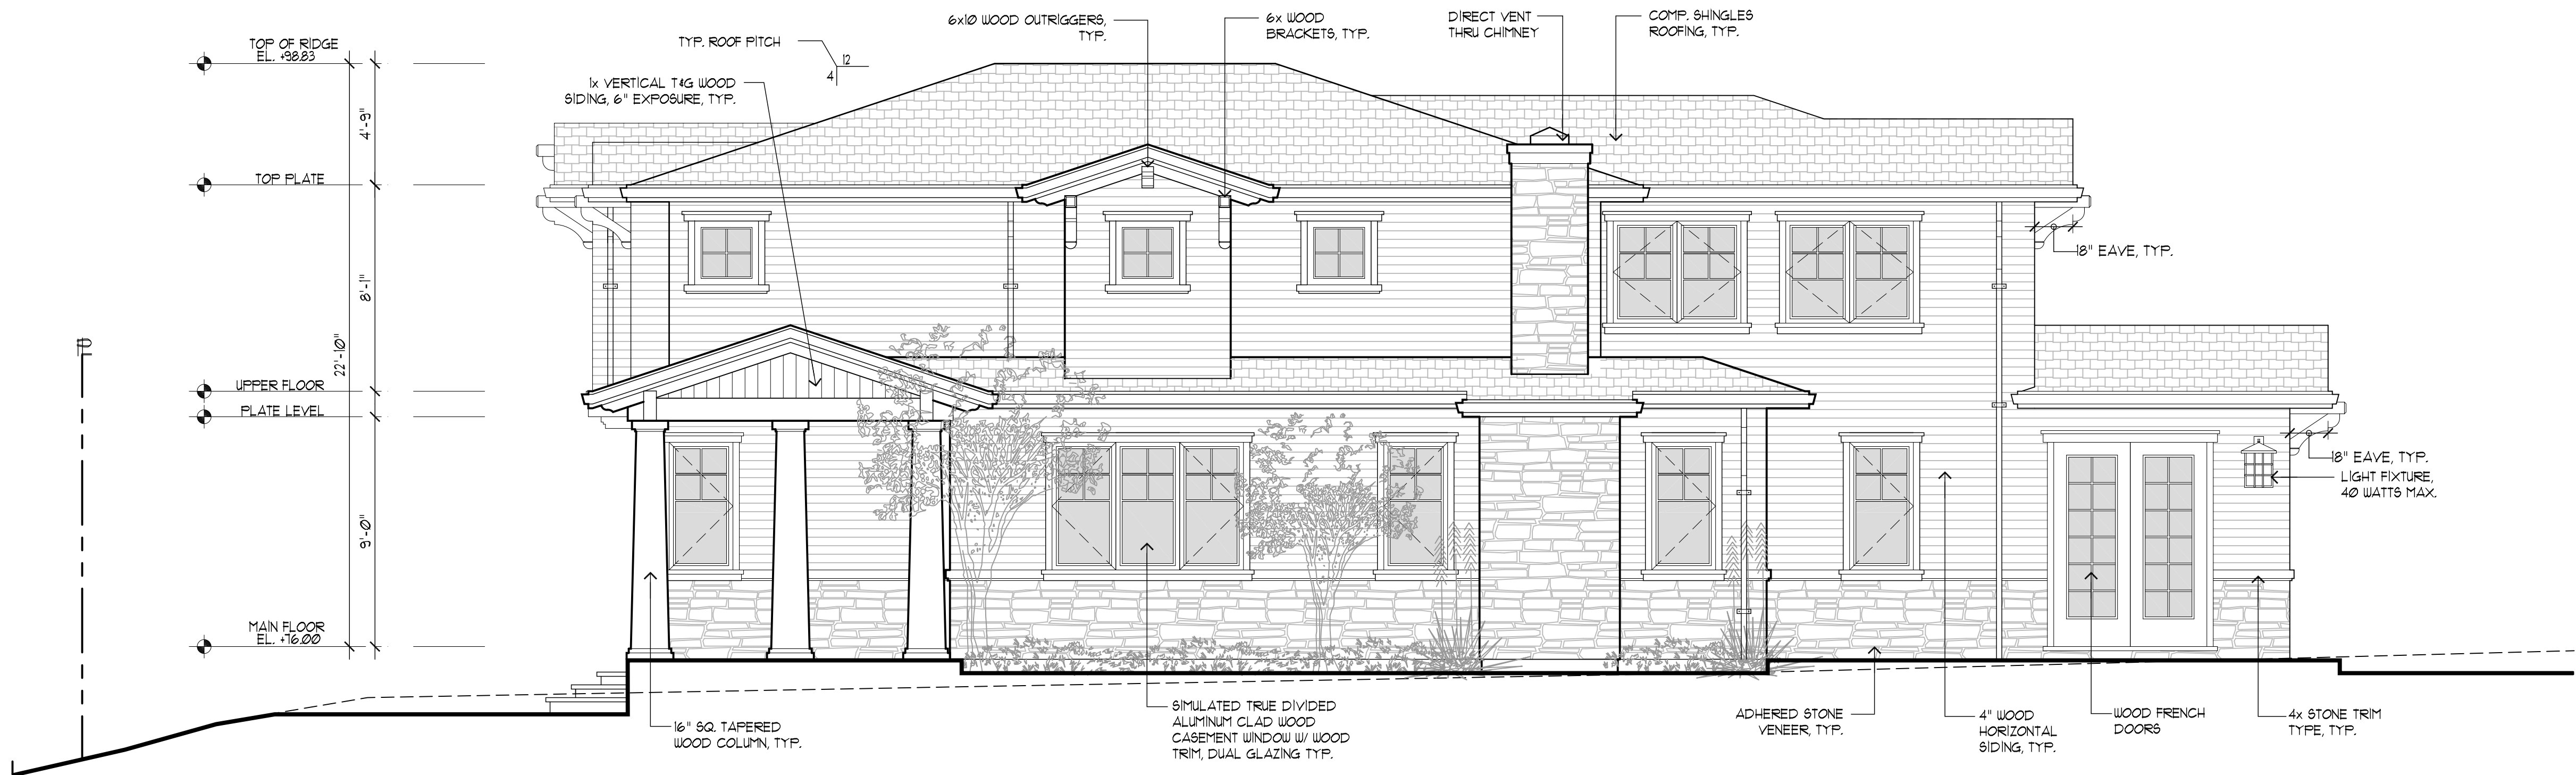


APPROVED RIGHT ELEVATION  
SCALE: 1/4"=1'-0"



PROPOSED RIGHT ELEVATION  
SCALE: 1/4"=1'-0"

| REVISIONS   |           | BY |
|-------------|-----------|----|
| PLAN CHECK  | 7/16/19   | PU |
| PLAN CHECK  | 8/26/19   | PU |
| BLDG CHECK  | 11/15/19  | PU |
| BLDG CHECK  | 2/4/2020  | PU |
| PLANNING FR | 6/30/2020 | PU |

CHU DESIGN ASSOCIATES INC.  
55 W. 43rd AVENUE  
SAN MATEO, CALIFORNIA 94403  
TEL: (650) 345-9286  
FAX: (650) 345-9287

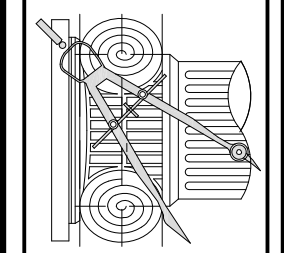


The drawing on this sheet, specification ideas, designs, and arrangements represented thereby are and shall remain the property of CHU DESIGN ASSOCIATES INC., and in no part thereof shall be copied, disclosed to others or used in connection with any work or project other than the specified project for which they have been prepared and developed without the written consent of CHU DESIGN ASSOCIATES INC. Visual contact with these plans or specifications shall constitute conclusive evidence of acceptance to these restrictions.


NEW RESIDENCE  
1509 BERNAL AVE.  
BURLINGAME CA  
A.P.N.: 026-034-100

|           |           |
|-----------|-----------|
| DATE:     | OCT. 2018 |
| SCALE:    | AS NOTED  |
| DRAWN:    | PU        |
| CHK:      |           |
| SHEET NO. |           |

A.4.1  
OF SHEETS

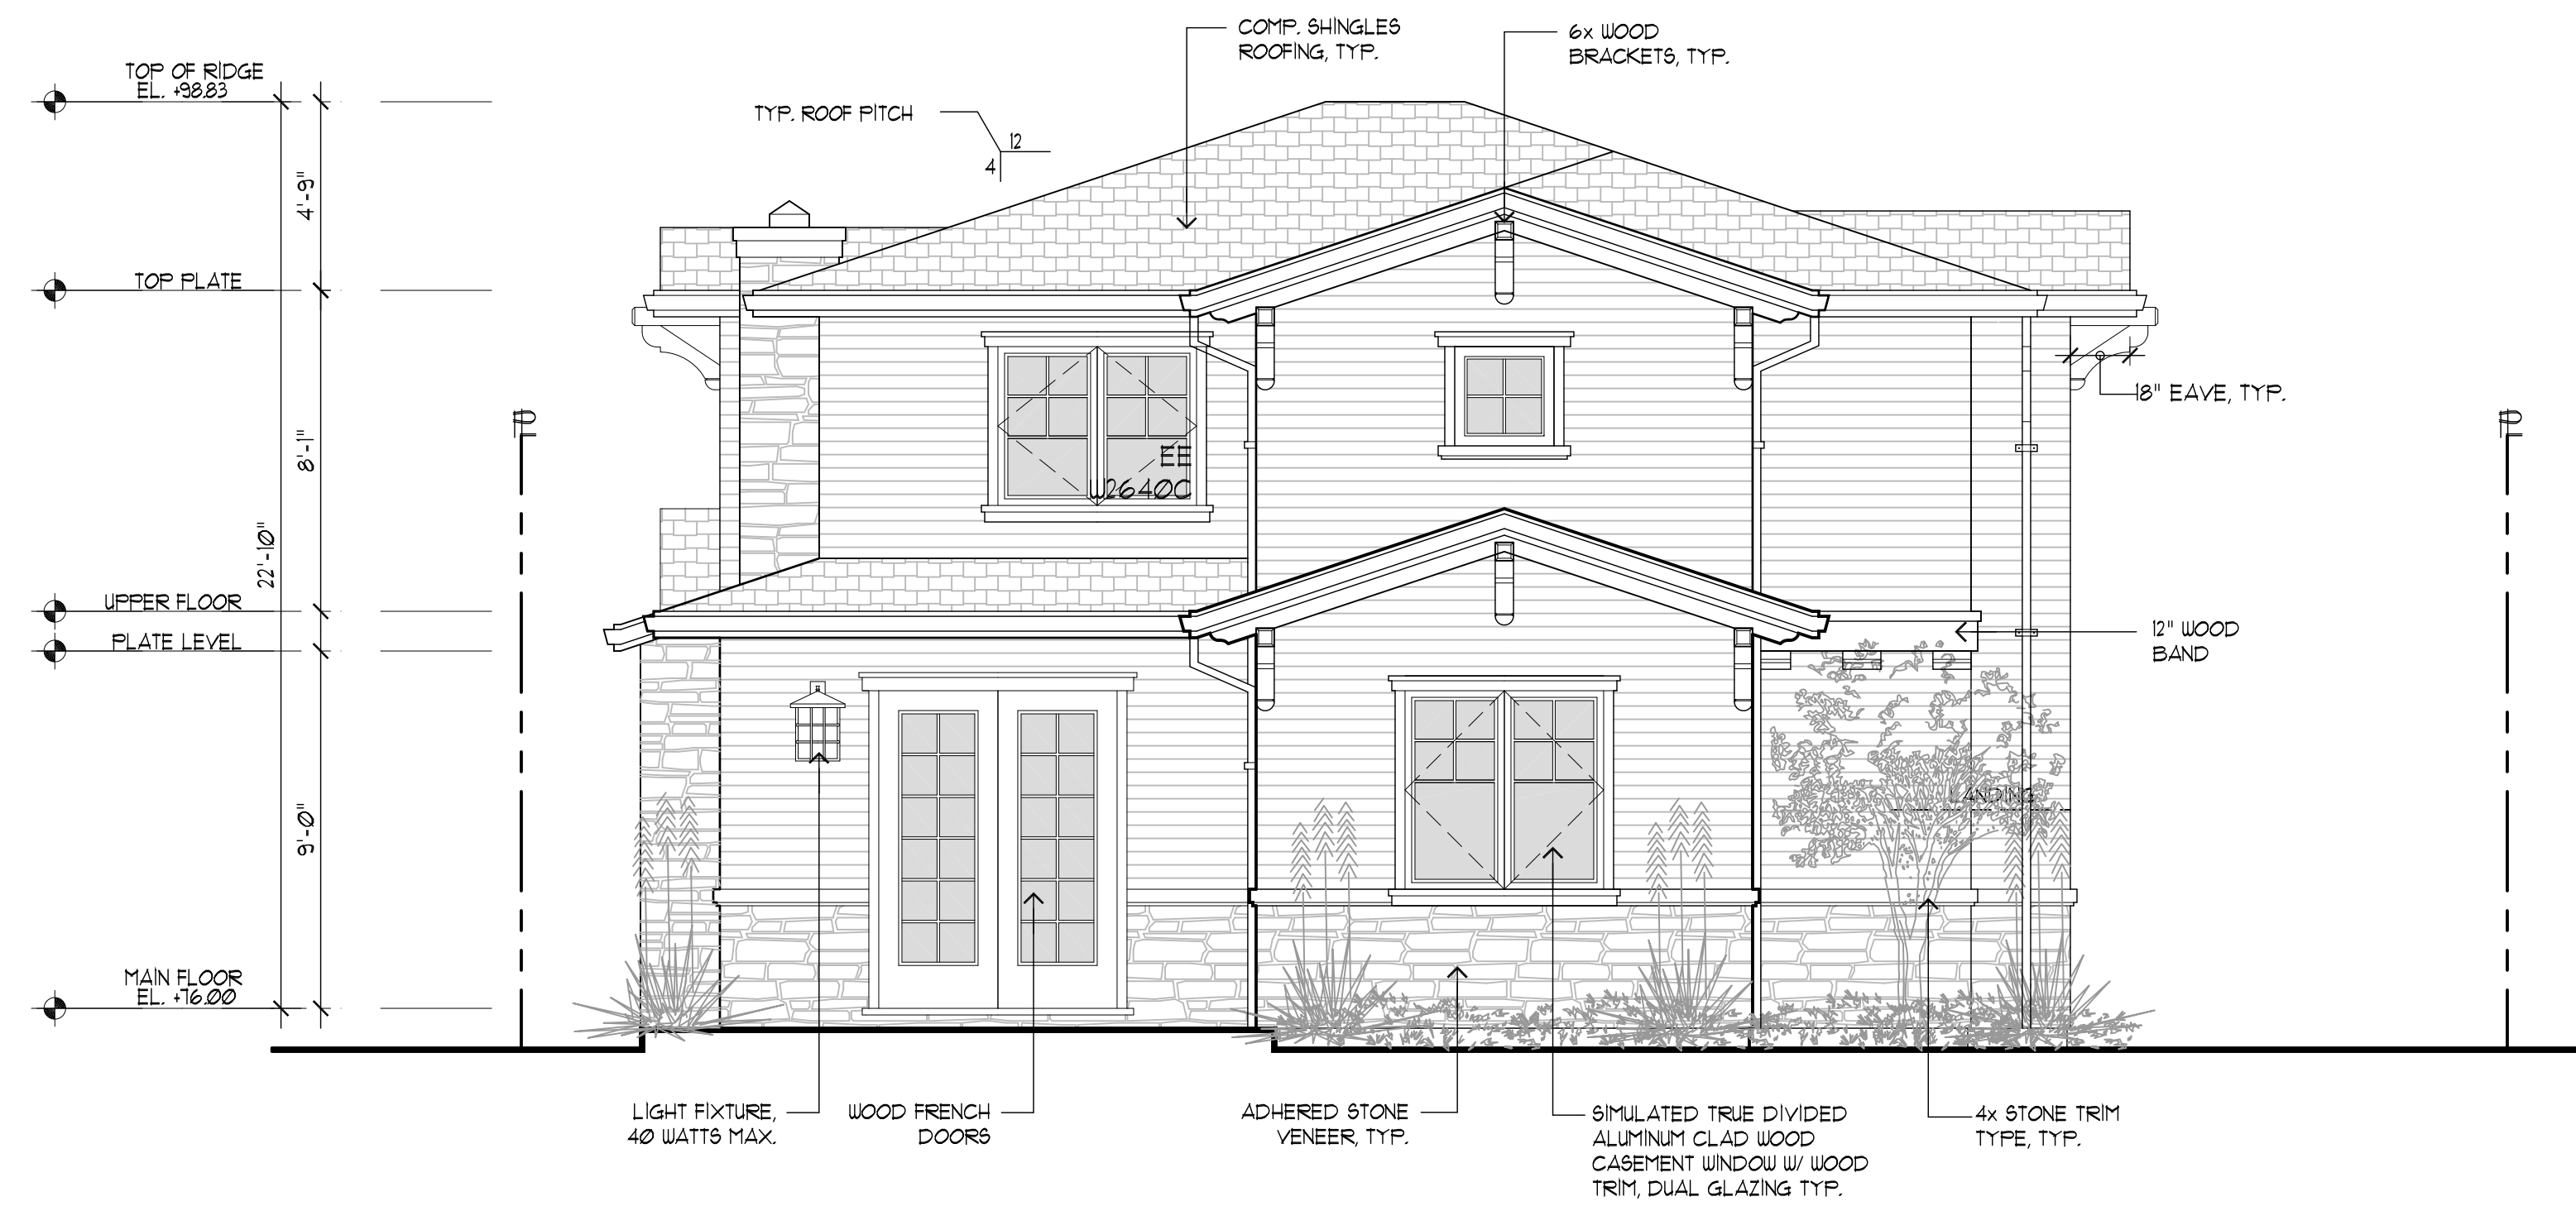


APPROVED REAR ELEVATION  
SCALE : 1/4"=1'-0"

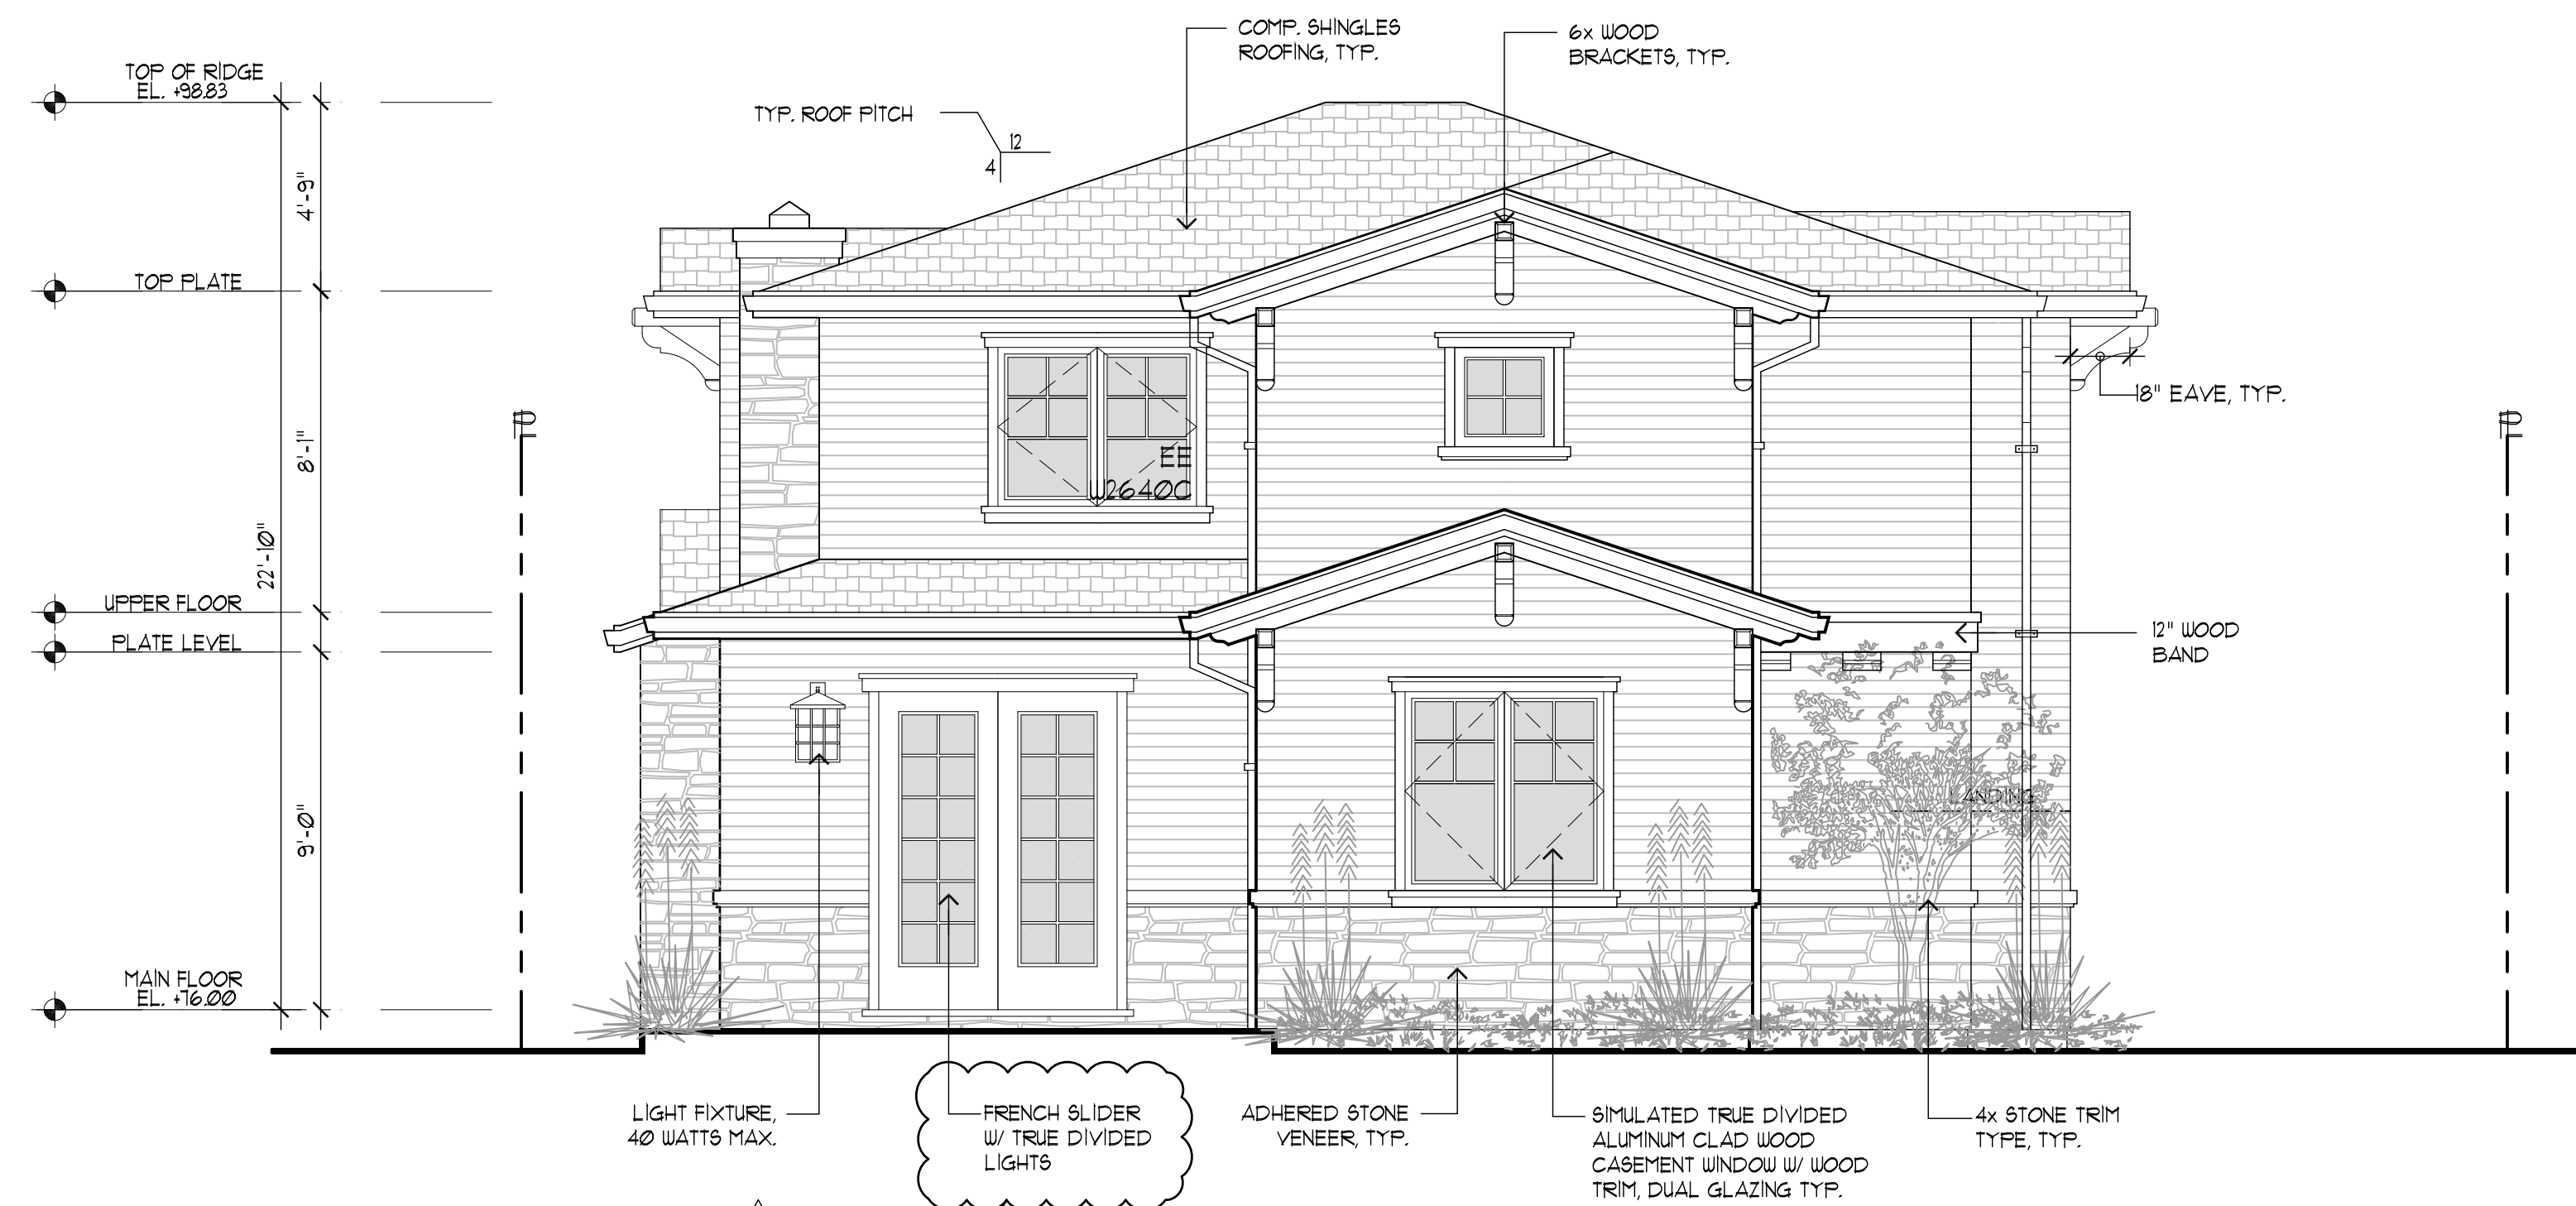

PROPOSED REAR ELEVATION  
SCALE : 1/4"=1'-0"

| REVISIONS   |           | BY |
|-------------|-----------|----|
| PLAN CHECK  | 7/16/19   | PU |
| PLAN CHECK  | 8/26/19   | PU |
| BLDG. CHECK | 11/15/19  | PU |
| BLDG. CHECK | 2/4/2020  | PU |
| PLANNING FR | 6/30/2020 | PU |

CHU DESIGN ASSOCIATES INC.  
55 W. 43rd AVENUE  
SAN MATEO, CALIFORNIA 94403  
TEL.: (650) 345-9286  
FAX: (650) 345-9287

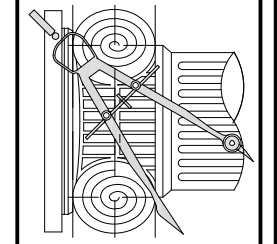

The drawing on this sheet, specification ideas, designs, and arrangements represented hereby are and shall remain the property of CHU DESIGN ASSOCIATES INC., and in no part thereof shall be copied, disclosed to others or used in connection with any work or project other than the specified project for which they have been prepared and developed without the written consent of CHU DESIGN ASSOCIATES INC. Visual contact with these plans or specifications shall constitute conclusive evidence of acceptance to these restrictions.

NEW RESIDENCE  
1509 BERNAL AVE.  
BURLINGAME CA  
A.P.N.: 026-034-100

|           |           |
|-----------|-----------|
| DATE:     | OCT. 2018 |
| SCALE:    | AS NOTED  |
| DRAWN:    | PU        |
| CHK:      |           |
| SHEET NO. |           |

A.5  
OF SHEETS