

NEW RESIDENCE

1385 HILLSIDE CIRCLE, (LOT 3) BURLINGAME, CA
A.P.N.: 000-000-000

| DESIGN DATA | PROJECT DATA | SHEET INDEX | PROJECT DIRECTORY |
|---|---|--|---|
| <p>2022 CALIFORNIA BUILDING CODE 2022 CALIFORNIA MECHANICAL CODE 2022 CALIFORNIA PLUMBING CODE 2022 CALIFORNIA ELECTRICAL CODE 2022 CALIFORNIA ENERGY CODE 2022 CALIFORNIA RESIDENTIAL CODE</p> <p>ALL OTHER STATE AND LOCAL ORDINANCES AND REGULATIONS ALL STRUCTURAL DESIGN DATA AS PER CBC SECTION 1603 ALL CONSTRUCTION AS PER CBC TABLE 601, TYPE V.</p> <p>ADOPTION OF THE 2022 EDITION OF THE CALIFORNIA STATE BUILDING CODES, TITLE 24, CALIFORNIA CODE OF REGULATIONS WAS MANDATED BY AB 4616 AND SB 2871, EFFECTIVE JANUARY 1, 2017. THE FOLLOWING LOCAL AMENDMENTS TO THE CALIFORNIA STATE BUILDING CODES WERE FILED WITH THE OFFICE OF HOUSING AND COMMUNITY DEVELOPMENT.</p> <p>ENTIRE RESIDENCE, CRAWL SPACE AND ATTIC SHALL BE PROTECTED BY AUTOMATIC FIRE-EXTINGUISHING SYSTEM NFPA 13-D STANDARD.</p> <p>GENERAL NOTES: 1. ALL DETAILS, MATERIALS, FINISHES AND ASSEMBLIES ARE NOT NECESSARILY SHOWN. THESE FINAL FINISH DETAILS INCLUDING CASEWORK AND MATERIAL SELECTIONS WILL BE COORDINATED BY THE OWNER.</p> <p>2. ALL CONSTRUCTION SHALL BE IN ACCORDANCE WITH THE UNIFORM BUILDING CODE, APPLICABLE EDITION, AND ALL OTHER PERTINENT CODES, LAWS AND REQUIREMENTS OF THE LOCAL BUILDING OFFICIALS, WHETHER OR NOT SPECIFICALLY SHOWN ON THESE DOCUMENTS. THESE DOCUMENTS ARE NOT INTENDED TO SHOW EVERY DETAIL OR CONDITION. MANY DETAILS IN RESIDENTIAL CONSTRUCTION ARE BUILT ACCORDING TO PROFESSIONAL CONSTRUCTION PRACTICES, AND ARE THEREFORE NOT DETAILED IN THESE DOCUMENTS. CONTACT CHU DESIGN ASSOCIATES INC. IF CONDITIONS OR OTHER CIRCUMSTANCES REQUIRE CHANGES IN THE WORK SHOWN, OR REQUIRE CLARIFICATION. ALL WORK SHALL BE DONE IN A HIGH QUALITY MANNER, ACCORDING TO THE PREVAILING STANDARDS OF THE INDUSTRY FOR EACH TRADE.</p> <p>3. THE CONTRACTOR SHALL PROVIDE ALL LABOR, MATERIALS, EQUIPMENT, SUPERVISION AND CLEAN-UP TO ACCOMPLISH ALL OF THE WORK SHOWN, INCLUDING ALL WARRANTIES AND INSTRUCTIONS, TO PROVIDE A COMPLETE WORKING INSTALLATION, AND TO LEAVE THE OWNER WITH AN APPROVED PRODUCT.</p> <p>4. CONTRACTOR SHALL ASSUME COMPLETE AND SOLE RESPONSIBILITY FOR MEANS AND METHODS OF CONSTRUCTION, AND FOR ALL SAFETY MEASURES TO PROTECT ALL PROPERTY, PERSONNEL AND THIRD PARTIES FROM DAMAGE OR INJURY. THIS RESPONSIBILITY SHALL BE CONTINUOUS AND NOT SOLELY DURING WORKING HOURS. CONTRACTOR SHALL DEFEND, INDEMNIFY AND HOLD HARMLESS CHU DESIGN ASSOCIATES INC. AND RELATED ENGINEERS FROM ANY CLAIMS OF LIABILITY, REAL OR ALLEGED, IN CONNECTION WITH THE PERFORMANCE OF HIS WORK ON THIS PROJECT, EXCEPTING FOR LIABILITY ARISING FROM THE SOLE NEGLIGENCE OF CHU DESIGN ASSOCIATES INC. AND RELATED ENGINEERS.</p> <p>5. THESE DOCUMENTS DO NOT CONTAIN PROVISIONS FOR THE HANDLING OR REMOVAL OF ANY HAZARDOUS MATERIALS. SHOULD ANY SUCH MATERIALS BE SUSPECTED OR ENCOUNTERED, SPECIALISTS SHALL BE CALLED IN TO MAKE RECOMMENDATIONS.</p> <p>6. PROVIDE ALL MANDATORY FEATURES REQUIRED BY THE T-24 ENERGY CODE, INCLUDING WEATHER-STRIPPING, BUILDING INSULATION, PIPE INSULATION, LIGHTING AND APPLIANCE MEASURES, AND OTHER FEATURES REQUIRED BY TITLE 24 OR OTHER STATE, FEDERAL OR LOCAL CODES.</p> <p>7. NO PERSON SHALL ERECT (INCLUDING EXCAVATION AND GRADING) DEMOLISH, ALTER OR REPAIR ANY BUILDING OR STRUCTURE OTHER THAN BETWEEN THE HOURS PERMITTED BY THE LOCAL JURISDICTION.</p> <p>8. ANY HIDDEN CONDITIONS THAT REQUIRE WORK TO BE PERFORMED BEYOND THE SCOPE OF THE BUILDING PERMIT ISSUED FOR THESE PLANS MAY REQUIRE FURTHER CITY APPROVALS INCLUDING REVIEW BY THE PLANNING COMMISSION.</p> <p>9. PLUMBING CONTRACTOR WILL PROVIDE A SINGLE LINE DIAGRAM ON TIME OF INSPECTION AND ANY INSTALLATION PRIOR TO PLAN CHECK AND APPROVAL IS AT CONTRACTOR'S RISK.</p> <p>10. FIRE SPRINKLERS SHALL BE INSTALLED AND SHOP DRAWINGS SHALL BE APPROVED BY THE FIRE DEPARTMENT PRIOR TO INSTALLATION.</p> <p>11. IF GRADING PERMIT IS REQUIRED, IT SHOULD BE OBTAINED FROM DEPARTMENT OF PUBLIC WORKS.</p> <p>12. IF PUBLIC WORKS REQUIRES SIDEWALK REPLACEMENT, POLICY FOR EXPANDING WIDTH OF PLANTER STRIP NEED TO BE IMPLEMENTED AND TREES NEED TO BE ADDED.</p> | <p>1. SITE ADDRESS: 1385 HILLSIDE CIRCLE BURLINGAME, CA 94010</p> <p>2. APN: 000-000-000</p> <p>3. TYPE OF CONSTRUCTION FOR: DWELLING AND GARAGE: OCCUPANCY GROUP FOR DWELLING: OCCUPANCY GROUP FOR GARAGE:</p> <p>TYPE V-N R-3 U</p> <p>4. SITE AREA: 13,226.00 SF</p> <p>5. MAX. COVERED FLOOR AREA ALLOWED: 5,332.32 SF (32% + 1100 SF)</p> <p>6. MAX. LOT COVERAGE ALLOWED (40%): 5,290.40 SF</p> <p>7. EXISTING FLOOR AREA (E) BASEMENT 4,794.00 SF (E) MAIN FLOOR 3,961.00 SF (E) UPPER FLOOR 2,548.00 SF (E) MAIN GARAGE 1,856.00 SF (E) DETACHED GARAGE 661.00 SF</p> <p>(E) TOTAL FLOOR AREA 13,820 SF</p> <p>8. PROPOSED FLOOR AREA (N) PROPOSED LOWER FLOOR 1,708.00 SF (N) PROPOSED MAIN FLOOR 1,802.50 SF (N) GARAGE 441.00 SF (N) FRONT PORCH 78.50 SF - 200 SF 0.00 SF</p> <p>(N) TOTAL FLOOR AREA 3,950.50 SF < 5,332.32 SF (N) FLOOR AREA RATIO: 29.86 %</p> <p>9. LOT COVERED AREA (N) MAIN FLOOR 1,802.50 SF (N) GARAGE 441.00 SF (N) FRONT PORCH 78.50 SF (N) BALCONY / DECK 765.25 SF</p> <p>(N) TOTAL FLOOR AREA 3,087.25 SF < 5,290.40 SF (N) FLOOR AREA RATIO: 23.34 %</p> <p>10. LOT SLOPE PERCENTAGE 19.79 %</p> | <p>ARCHITECTURAL</p> <p>A0 PERSPECTIVE A1a LOT 1, 2, & 3 FRONT AERIAL RENDERING A1b LOT 1, 2, & 3 REAR AERIAL RENDERING A1c LOT 1, 2, & 3 FRONT AERIAL RENDERING A1 COVER SHEET A1.1 ARBORIST REPORT A1.2 ARBORIST REPORT A2 SITE DEMOLITION PLAN A2.1 SITE DEVELOPMENT PLAN PLAN A3 PROPOSED MAIN FLOOR PLAN A3.1 PROPOSED LOWER FLOOR PLAN A3.2 PROPOSED ROOF PLAN A4 ELEVATIONS A5 ELEVATIONS A6 ELEVATIONS A7 ELEVATIONS A8 BUILDING SECTIONS A9 BUILDING SECTIONS N1 CONSTRUCTION BMP AC.1 MAIN FLOOR AREA CALCULATIONS (PLANNER SET ONLY) AC.2 LOWER FLOOR AREA CALCULATIONS (PLANNER SET ONLY)</p> <p>LANDSCAPE</p> <p>L1 PRELIMINARY LANDSCAPE PLAN L2 PRELIMINARY LANDSCAPE PLAN L3 PRELIMINARY LANDSCAPE PLAN L6 PLANT IMAGERY L7 HYDROZONE / PRELIMINARY TYPICAL IRRIGATION L8 PRELIMINARY IMPERVIOUS CALCULATIONS</p> <p>CIVIL</p> <p>C0 TITLE SHEET C1 NOTES SHEET C2 GRADING AND UTILITY PLAN C3 EROSION AND SEDIMENT CONTROL PLAN C3.1 BEST MANAGEMENT PRACTICES (BMPs) C4 DETAIL SHEET C4.1 DETAIL SHEET C4.2 DETAIL SHEET SUI BOUNDARY & TOPOGRAPHIC SURVEY TENTATIVE MAP</p> <p>AS-BUILT PLANS (FOR REFERENCE ONLY)</p> <p>AX.101. EXISTING ROOF PLAN AX.102. EXISTING BASEMENT LEVEL FLOOR PLAN AX.103. EXISTING MAIN FLOOR PLAN AX.104. EXISTING UPPER FLOOR PLAN AX.105. EXISTING GARAGE FLOOR PLAN AX.201. EXISTING NORTH ELEVATION AX.202. EXISTING WEST ELEVATION AX.203. EXISTING SOUTH ELEVATION AX.204. EXISTING EAST ELEVATION AX.301. SECTION AX.302. SECTION</p> | <p>PROPERTY OWNER: SHERMAN CHIU 3314 CESAR CHAVEZ ST., SAN FRANCISCO, CA 94110 TEL: (415) 219-1290</p> <p>LANDSCAPE ARCHITECT: RIPLEY DESIGN GROUP 1615 BONANZA STREET SUITE 314 WALNUT CREEK, CA 94596 TEL: (925) 938-1311</p> <p>ARCHITECTURAL: JAMES CHU CHU DESIGN ASSOCIATES INC. 210 INDUSTRIAL RD, SUITE 205 SAN CARLOS, CA 94070 TEL: (650) 345-9286, EXT. 1001 FAX: (650) 345-9287 EMAIL: James@chudesign.com</p> <p>CIVIL GRADING: PRECISION ENGINEERING & CONSTRUCTION, INC. 901 WALTERMIRE ST. BELMONT, CA 94002 TEL: (650) 631-1590</p> <p>CIVIL SURVEY: QUIET RIVER LAND SERVICES INC. 6747 SIERRA COURT, SUITE K DUBLIN, CA 94568 TEL: (925) 734-6788</p> |
| | <h2>NOTES</h2> <p>ILLUMINATED STREET ADDRESS 1. PROVIDE AN ILLUMINATED STREET ADDRESS AT THE ENTRY DOOR PER CITY ORDINANCE. APPROVED NUMBERS OR ADDRESSES SHALL BE PLACED IN SUCH A POSITION AS TO BE PLAINLY VISIBLE AND LEGIBLE FROM THE STREET OR ROAD FRONTING THE PROPERTY SAID NUMBERS SHALL CONTRAST WITH THEIR BACKGROUND, AND SHALL BE A MINIMUM OF 1/2 INCH STROKE BY 2-1/2 INCHES HIGH, SHALL BE EITHER INTERNALLY OR EXTERNALLY ILLUMINATED. THE POWER OF SUCH ILLUMINATION SHALL NOT BE NORMALLY SWITCHABLE. 2. EXTERIOR LIGHTING ON ALL RESIDENTIAL PROPERTIES SHALL BE DESIGNED AND LOCATED SO THAT THE CONE OF LIGHT AND/ OR GLARE FROM THE LIGHTING ELEMENT IS KEPT ENTIRELY ON THE PROPERTY OR BELOW THE TOP OF ANY FENCE, EDGE OR WALL. CITY OF BURLINGAME MUNICIPAL CODE 18.16.030. 3. ON ALL RESIDENTIAL PROPERTIES EXTERIOR LIGHTING OUTLETS AND FIXTURES SHALL NOT BE LOCATED MORE THAN NINE (9) FEET ABOVE ADJACENT GRADE OR REQUIRED LANDING & WALLS OR PORTIONS OF WALLS SHALL NOT BE FLOOD-LIT & ONLY SHIELDED LIGHT FIXTURES WHICH FOCUS LIGHT DOWNWARD SHALL BE ALLOWED, EXCEPT FOR ILLUMINATED STREET NUMBER REQUIRED BY THE FIRE DEPARTMENT. CITY OF BURLINGAME MUNICIPAL CODE 18.16.030. ** CONSTRUCTION, DEMOLITION, RECYCLING & WASTE REDUCTION FORMS WILL NEED TO BE SUBMITTED & APPROVED PRIOR TO ISSUANCE OF BUILDING PERMIT PER CITY OF BURLINGAME. CONTACT JOE MCCLUSKY OER RECYCLING SPECIALIST @ (650) 558-1213.</p> | | <h2>CONSTRUCTION SCHEDULE</h2> <p>1. NO PERSON SHALL ERECT (INCLUDING EXCAVATION AND GRADING), DEMOLISH, ALTER OR REPAIR ANY BUILDING OR STRUCTURE OTHER THAN BETWEEN THE FOLLOWING HOURS EXCEPT IN THE CASE OF URGENT NECESSITY IN THE INTEREST OF PUBLIC HEALTH AND SAFETY, AND THEN ONLY WITH PRIOR WRITTEN APPROVAL FROM THE BUILDING OFFICIAL, WHICH APPROVAL SHALL BE GRANTED FOR A PERIOD NOT TO EXCEED THREE DAYS. HOLIDAYS ARE THE FIRST DAY OF JANUARY, THE THIRD MONDAY OF FEBRUARY, THE LAST MONDAY OF MAY, THE FOURTH DAY OF JULY, THE FIRST MONDAY OF SEPTEMBER, THE ELEVENTH DAY OF NOVEMBER, THE FOURTH THURSDAY IN NOVEMBER AND THE TWENTY FIFTH DAY OF DECEMBER. IF THE FIRST DAY OF JANUARY, THE FOURTH DAY OF JULY, THE ELEVENTH DAY OF NOVEMBER AND THE TWENTY-FIFTH DAY OF DECEMBER FALLS UPON A SUNDAY THE FOLLOWING MONDAY IS A HOLIDAY. PROVIDE THE FOLLOWING CONSTRUCTION HOURS ON THE PLANS PER CITY OF BURLINGAME MUNICIPAL CODE 18.07.110. i. MONDAY THROUGH FRIDAY: 8AM TO 7PM ii. SATURDAYS: 9AM TO 6PM iii. SUNDAY AND HOLIDAYS: NO WORK</p> <p>2. CONSTRUCTION HOURS IN THE CITY PUBLIC RIGHT-OF-WAY ARE LIMITED TO WEEKDAYS AND NON-CITY HOLIDAYS BETWEEN 8:00AM TO 5:00PM.</p> |

The drawing on this sheet, specification ideas, designs and arrangements represented thereby are and shall remain the property of CHU DESIGN ASSOCIATES, INC.; and in no part thereof shall be copied, disclosed to others or used in connection with any work or project other than the specified project for which they have been prepared and developed without the written consent of CHU DESIGN ASSOCIATES, INC. Visual contact with these plans or specifications shall constitute conclusive evidence of acceptance to these restrictions.

NEW RESIDENCE
1385 HILLSIDE CIRCLE LOT 3
BURLINGAME, C.A.
A.P.N.: 000-000-000

| Tree# | | Species | DBH | CON | HT/SP | Comments |
|-------|--|---|-------|-----|-------|--|
| 1P | | Coast live oak (<i>Quercus agrifolia</i>) | 19.1 | 60 | 35/35 | Good vigor, poor form, leans south over drive. |
| 2P | | Valley oak (<i>Quercus lobata</i>) | 26.4 | 60 | 40/45 | Good vigor, fair form, ivy on trunk. |
| 3P | | Coast live oak (<i>Quercus agrifolia</i>) | 18.8 | 45 | 25/30 | Fair vigor, poor form, leans south. |
| 4R | | Black acacia (<i>Acacia melanoxylon</i>) | 8.0 | 40 | 30/25 | Good vigor, poor form, ivy on trunk. topped |
| 5*P | | African fern pine (<i>Afrocarpus falcatus</i>) | 24est | 50 | 35/30 | Good vigor, poor form, topped for utilities. |


The image contains two topographic maps of the Lake Umbagog area. The top map shows the lake and surrounding land with red numbers 1, 2, 3, and 4 marking specific locations. The bottom map is a more detailed view of the same area, also with red numbers 1, 2, and 3 marking locations. Both maps include a north arrow and a scale bar.

1385 Hillside (3)
Summary:
 5 trees were surveyed. 3 native oak trees were observed as well as one invasive acacia tree and a neighboring African fern pine tree. All of the trees except acacia tree #4 are of a protected size in the city of Burlingame. Non-protected Black Acacia tree #4 is proposed for removal due to the tree's location near the proposed driveway/grading.



Impacts/Recommendations:
Oak tree #1 is to be retained. The tree is adjacent to an existing driveway. It is recommended to temporarily retain the existing driveway near this tree when underneath the dripline of the tree during the building phase of the project. Temporarily retaining the driveway will act as a tree protection measure and will help to increase staging and access to the site, as removing the driveway at the beginning of the project would make for a larger tree protection zone needed with the fencing being located at the tree's drip line. The existing grade within the tree's dripline is recommended to be retained as is where possible. No grading or excavation is recommended to take place within 10' from this tree (6x diameter) except for the removal of the driveway. At the end of the project, when it is time to demolish the existing driveway near this tree, the Project Arborist is

recommended to be on-site to document and witness the removal of the driveway. A jackhammer is recommended to be used when working within the tree's drip line to break the concrete material into hand manageable-sized pieces. Once broken down the driveway material is recommended to be removed by hand. Exposed roots during the process are recommended to be wrapped in layers of wetted-down burlap to avoid root desiccation. The existing driveway area is recommended to be filled back in once the driveway has been removed so that no roots are exposed to the elements. When backfilling the soil in this area, the area is also to be irrigated. The proposed driveway is further from the tree than the existing driveway and outside of the 10' range and is not expected to have impacts on the tree. The tree is recommended to be deep water fertilized with Nutriroot once the work near the tree has taken place as a mitigation measure for any minor impacts that may take place.

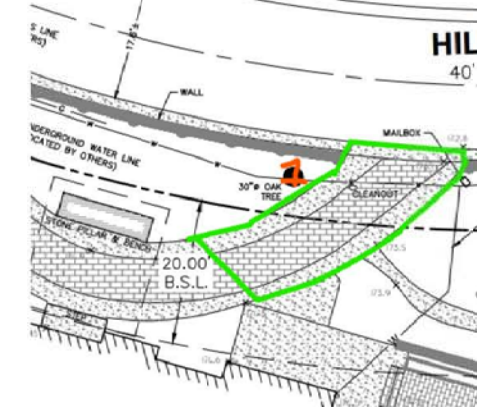

Showing portion of driveway recommended to be retained until the landscape phase of the project.

Kiely Arborist Services LLC
 Certified Arborist WE#10724A TRAQ Qualified
 P.O. Box 6187
 San Mateo, CA 94403
 650-532-4418

February 16th, 2024

Alpha Bay Builders
Attn: Jenny Ngo
3314 Cesar Chavez St.
San Francisco, CA 94110

Site: 1385 Hillside Circle, Burlingame, CA

Dear Ms. Ngo,

As requested on December 4th, 2023, Kieilty Arborist Services visited the above site to provide a Tree Inventory Report/Tree Protection Plan for the proposed construction. 3 new homes are proposed for this site, and your concern as to the future health and safety of the tree has prompted this visit. Preliminary landscape plans L1 through L7 dated January 2024, lot 1 site plans A.1 through A.6 dated 10/26/22, lot 2 site plans A.1 through A.6 dated 10/26/21, and lot 3 plans A.1 through A.8 dated 10/26/21 were also reviewed for writing this report. This Tree Inventory Report is not a Tree Risk Assessment. As such, no trees were assessed for risk in accordance with industry standards, nor are there any tree risk ratings or risk mitigation recommendations provided within this preservation plan.

Method:

All inspections were made from the ground; the trees were not climbed for this inspection. The trees in question were located on an existing topography map provided by you. The trees were then measured for diameter at 54 inches above ground level (DBH or diameter at breast height). A condition rating (CON) is provided using 50 percent vitality and 50 percent form, using the following scale.

| | |
|----------|-----------|
| 1 - 29 | Very Poor |
| 30 - 49 | Poor |
| 50 - 69 | Fair |
| 70 - 89 | Good |
| 90 - 100 | Excellent |

The height of the trees was measured using a Nikon Forestry 550 Hypsometer. The spread was paced off (HT/SP). Comments and recommendations for future maintenance are provided.

Survey Key:

DBH-Diameter at breast height (54" above grade) **CON**- Condition rating (1-100)

HT/SP- Tree height/ canopy spread *indicates neighbor's trees


P-Indicates protected tree by city ordinance

R-Indicates proposed tree removal

ARBORIST REPORT

1385 Hillside

(4)

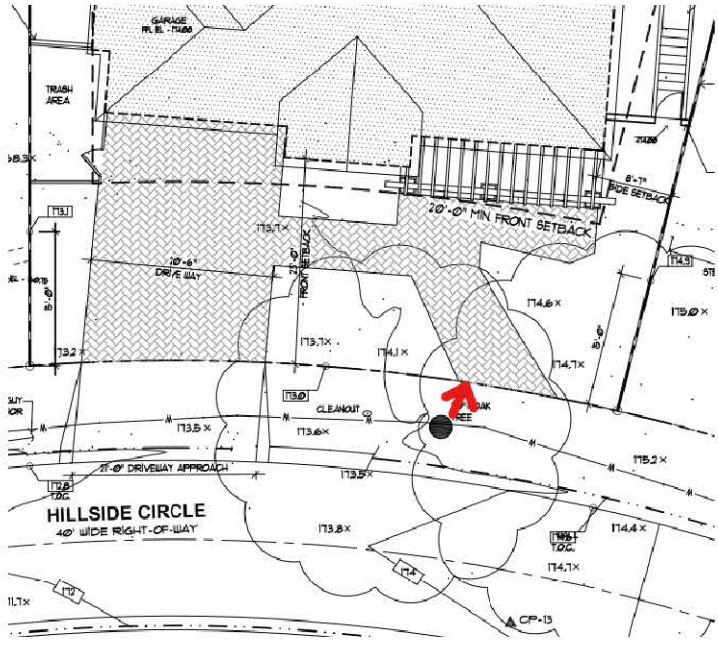

Plan change needed:
A new pathway is proposed at 4' from oak tree #10. This is too close to the tree and impacts would be expected. It is recommended to maintain a minimal clearance of 10' from the tree to the pathway to keep impacts on the tree low. With this plan change implemented, impacts are expected to be minor and will be mitigated by the recommended deep water fertilizing with Nutriroot.

Showing the walkway at 4' from the tree

A new pathway is shown adjacent to valley oak tree #2. It is recommended to have the pathway no closer to the tree than the existing pathway next to the tree. This may result in a plan change. All landscaping work below the dripline of the tree is recommended to be done by hand under the direct supervision of the project arborist. Excavation is recommended not to exceed 6" for any landscaping when underneath the tree's dripline. No roots measuring larger than 1.5" in diameter shall be cut for landscaping purposes. No grading shall also take place underneath the tree's dripline.

Many existing landscape features exist at the back of the property near the retained trees. Any existing hardscapes to be removed are recommended to be carefully removed under the Project Arborist supervision. No excavation beyond hardscape removal is recommended when within 6x the diameter of a retained tree on site. The following Tree Protection Plan will reduce the impacts to the retained trees during the construction process.

Tree Protection Plan:

Tree Protection Zones

Tree protection zones should be installed and maintained throughout the entire length of the project. Fencing for tree protection zones on this site will consist of the existing property line fences as the only trees protected are the neighboring trees. For any non-protected trees desired to be protected from construction activity, the following recommendations should be followed: Tree protection fencing should be 6' tall, metal chain link material supported by metal 2" diameter poles, pounded into the ground to a depth of no less than 2'. No equipment or materials shall be stored or cleaned inside the protection zones. Areas where tree protection fencing needs to be reduced for access or any other reason, should be mulched with 6" of coarse wood chips with ½ inch plywood on top. The plywood boards should be attached together in order to minimize movement. The spreading of chips will help to reduce compaction and improve soil structure. All tree protection measures must be installed prior to any demolition or construction activity at the site. Whenever tree protection fencing needs to be moved or reduced for work to

1385 Hillside

(5)

take place, the Project Arborist shall be called out to the site to witness the moving of the fencing and to provide any other necessary protection measures as seen fit.

Avoid the following conditions:

DO NOT:

- Allow run off of spillage of damaging materials into the area below any tree canopy.
- Store materials, stockpile soil, or park or drive vehicles within the TPZ.
- Cut, break, skin, or bruise roots, branches, or trunks without first obtaining authorization from the Arborist.
- Allow fires under and adjacent to trees.
- Discharge exhaust into foliage.
- Secure cable, chain, or rope to trees or shrubs.
- Trench, dig, or otherwise excavate within the dripline or TPZ of the tree(s) without first obtaining authorization from the Arborist.
- Apply soil sterilant under pavement near existing trees.



Landscape Barrier

Where tree protection does not cover the entire root zone of the trees, or when a smaller tree protection zone is needed for access, a landscape barrier consisting of wood chips spread to a depth of four to six inches with plywood or steel plates placed on top will be placed where foot traffic is expected to be heavy. The landscape buffer will help to reduce compaction to the unprotected root zone. If plywood is to be used, the plywood pieces shall be attached together to minimize movement.

Landscape barrier example

Root Cutting and Grading

Any roots to be cut shall be monitored and documented. Large roots (over 2" diameter) or large masses of roots to be cut must be inspected by the site arborist. The Project Arborist, at this time, may recommend irrigation or fertilization of the root zone. All roots needing to be cut should be cut clean with a saw or loppers. Roots to be left exposed for a period should be covered with layers of burlap and kept moist to avoid root desiccation. Immediate irrigation is recommended within the tree protection zones whenever roots are impacted.

1385 Hillside

(6)

Trenching and Excavation

Trenching for irrigation, drainage, electrical or any other reason shall be done by hand when inside the dripline of a protected tree. Hand digging and the careful placement of pipes below or besides protected roots will significantly reduce root loss, thus reducing trauma to the tree. All trenches shall be backfilled with native materials and compacted to near its original level, as soon as possible. Trenches to be left open for a period of time, will require the covering of all exposed roots with burlap. The exposed roots will need to be kept moist by spraying down the burlap multiple times a day with clean water. The trenches will also need to be covered with plywood to help protect the exposed roots.

Irrigation

Normal irrigation shall be maintained on this site for the retained imported trees. Every two weeks during the dry season the trees shall receive supplemental irrigation. No irrigation to the native oak trees is needed unless roots are to be tramitized.

Inspections

It is the contractor's responsibility to contact the Project Arborist as directed in this report. Kielty Arborist Services LLC can be reached best through email at david@kieltyarborist.com or by phone at (650) 532-4418.

The information included in this report is believed to be true and based on sound arboricultural principles and practices.

Sincerely,
David Beckham
Certified Arborist WE#10724A
TRAQ Qualified

Kielty Arborists Services


P.O. Box 6187
San Mateo, CA 94403
650-532-4418

ASSUMPTIONS AND LIMITING CONDITIONS

- Any legal description provided to the consultant/appraiser is assumed to be correct. Any titles and ownerships to any property are assumed to be good and marketable. No responsibility is assumed for matters legal in character. Any and all property is appraised or evaluated as though free and clear, under responsible ownership and competent management.
- It is assumed that any property is not in violation of any applicable codes, ordinances, statutes, or other government regulations.

| REVISIONS | BY |
|-----------|----|
| | |
| | |
CHU DESIGN ASSOCIATES INC.
210 INDUSTRIAL RD, SUITE 205
SAN CARLOS, CALIFORNIA 94070
TEL: (650) 345-9286 EXT. 1001

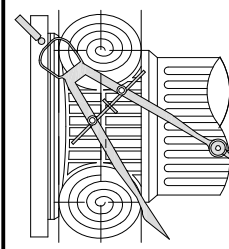


The drawing on this sheet, specification ideas, designs, and arrangements represented thereby are and shall remain the property of CHU DESIGN ASSOCIATES, INC.; and in no part thereof shall be copied, disclosed to others or used in connection with any work or project other than the specified project for which they have been prepared and developed without the written consent of CHU DESIGN ASSOCIATES, INC. Visual contact with these plans or specifications shall constitute conclusive evidence of acceptance to these restrictions.

NEW RESIDENCE
1385 HILLSIDE CIRCLE LOT 3
BURLINGAME, C.A.
A.P.N.: 000-000-000

| | |
|-----------|----------|
| DATE: | 10/26/21 |
| SCALE: | AS NOTED |
| DRAWN: | MC |
| FOR: | |
| SHEET NO. | |

A.1.2

LEGEND:

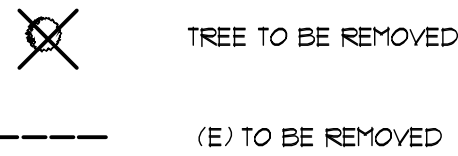

PARKS DIVISION NOTES:

ENSURE THAT TREE PROTECTION SPECIFICATIONS ARE SHOWN GRAPHICALLY ON SITE PLANS FOR CONTRACTOR TO FOLLOW, AS FOLLOWS:

LOCATION OF ALL TREE PROTECTION MEASURES INCLUDING BUT NOT LIMITED TO FENCING, TRUNK WRAP, ROOT BUFFER, ARE TO BE GRAPHICALLY SHOWN ON DEMO PLAN A2 SO THAT CONTRACTOR CAN EASILY INSTALL AND EXECUTE THE TREE PROTECTION MEASURES.

LOCATIONS OF HAND DIGGING AND LOCATIONS OF WORK TO BE UNDER PROJECT ARBORIST SUPERVISION ARE TO BE GRAPHICALLY SHOWN ON THE RELEVANT SITE PLAN SO THAT CONTRACTOR(S) CAN EASILY UNDERSTAND AND EXECUTE THE SPECIFICATIONS. WORK WITH THE PROJECT ARBORIST TO PRODUCE ACCURATE INFORMATION ON THE RELEVANT SITE PLAN. SOME OF THE INFORMATION WILL BE ON THE A SHEETS AND SOME ON THE L SHEETS.

ARBORIST REPORT RECOMMENDS:
RETAINING SOME OF THE DRIVEWAY NEAR TREE 1 AND BREAKING IT DOWN BY HAND LATER IN THE PROJECT. PUT THIS ON DEMO PLAN A2 SO CONTRACTOR CAN FOLLOW IT.
CHANGING THE PATHWAY NEAR TREE 10 TO AVOID ROOT LOSS/DAMAGE. WHERE IS TREE 10? HAS THE PATHWAY BEEN CHANGED?


ARBORIST REPORT IS BASED ON REVIEWING L PLANS DATED JAN 2024, LOT 1 A PLANS DATED 10-26-22, LOT 2 A PLANS DATED 10-26-21 AND LOT 3 A PLANS DATED 10-26-21. NO CIVIL PLANS REVIEWED. NOTE THAT THE CONTENT OF CIVIL PLANS MAY NECESSITATE A CHANGE IN THE ARBORIST RECOMMENDATIONS.

INDICATE THAT AT LEAST 3 SINGLE-TRUNKED LANDSCAPE TREES WILL BE PRESENT ON EACH LOT, AS NOTED BELOW.
PER CHAPTER 11.06, THIS PROJECT REQUIRES 3 SINGLE-TRUNKED LANDSCAPE TREES FOR LOT 3.
TREES MAY BE EXISTING OR NEW.
REQUIRED TREES MAY NOT BE FRUIT OR NUT TREES, PALMS, ITALIAN CYPRESS OR JAPANESE MAPLE.
REQUIRED TREES MUST HAVE A MATURE HEIGHT OF OVER 15 FEET.
ALL REQUIRED TREES MUST BE IN GOOD CONDITION AT THE FINAL ARBORIST INSPECTION.
STREET TREES DO NOT COUNT TOWARDS THE REQUIRED TOTAL.

PROVIDE THE BOTANICAL NAME (GENUS AND SPECIES) AND LOCATION OF THE REQUIRED LANDSCAPE TREES, AND WHETHER THEY ARE EXISTING OR NEW, FOR EACH LOT.

INFORMATIONAL COMMENTS:
NO EXISTING TREE OVER 48 INCHES IN CIRCUMFERENCE MEASURED AT 54 INCHES FROM NATURAL GRADE MAY BE REMOVED WITHOUT A PROTECTED TREE REMOVAL PERMIT FROM THE PARKS DIVISION. CONTACT PARKS DIVISION (558-1330) FOR LINK TO APPLICATION. ONE APPLICATION IS ACCEPTABLE FOR ALL TREES PROPOSED FOR REMOVAL.


EXISTING CITY STREET TREE MAY NOT BE CUT, TRIMMED OR REMOVED WITHOUT PERMIT FROM PARKS DIVISION (558-1330).

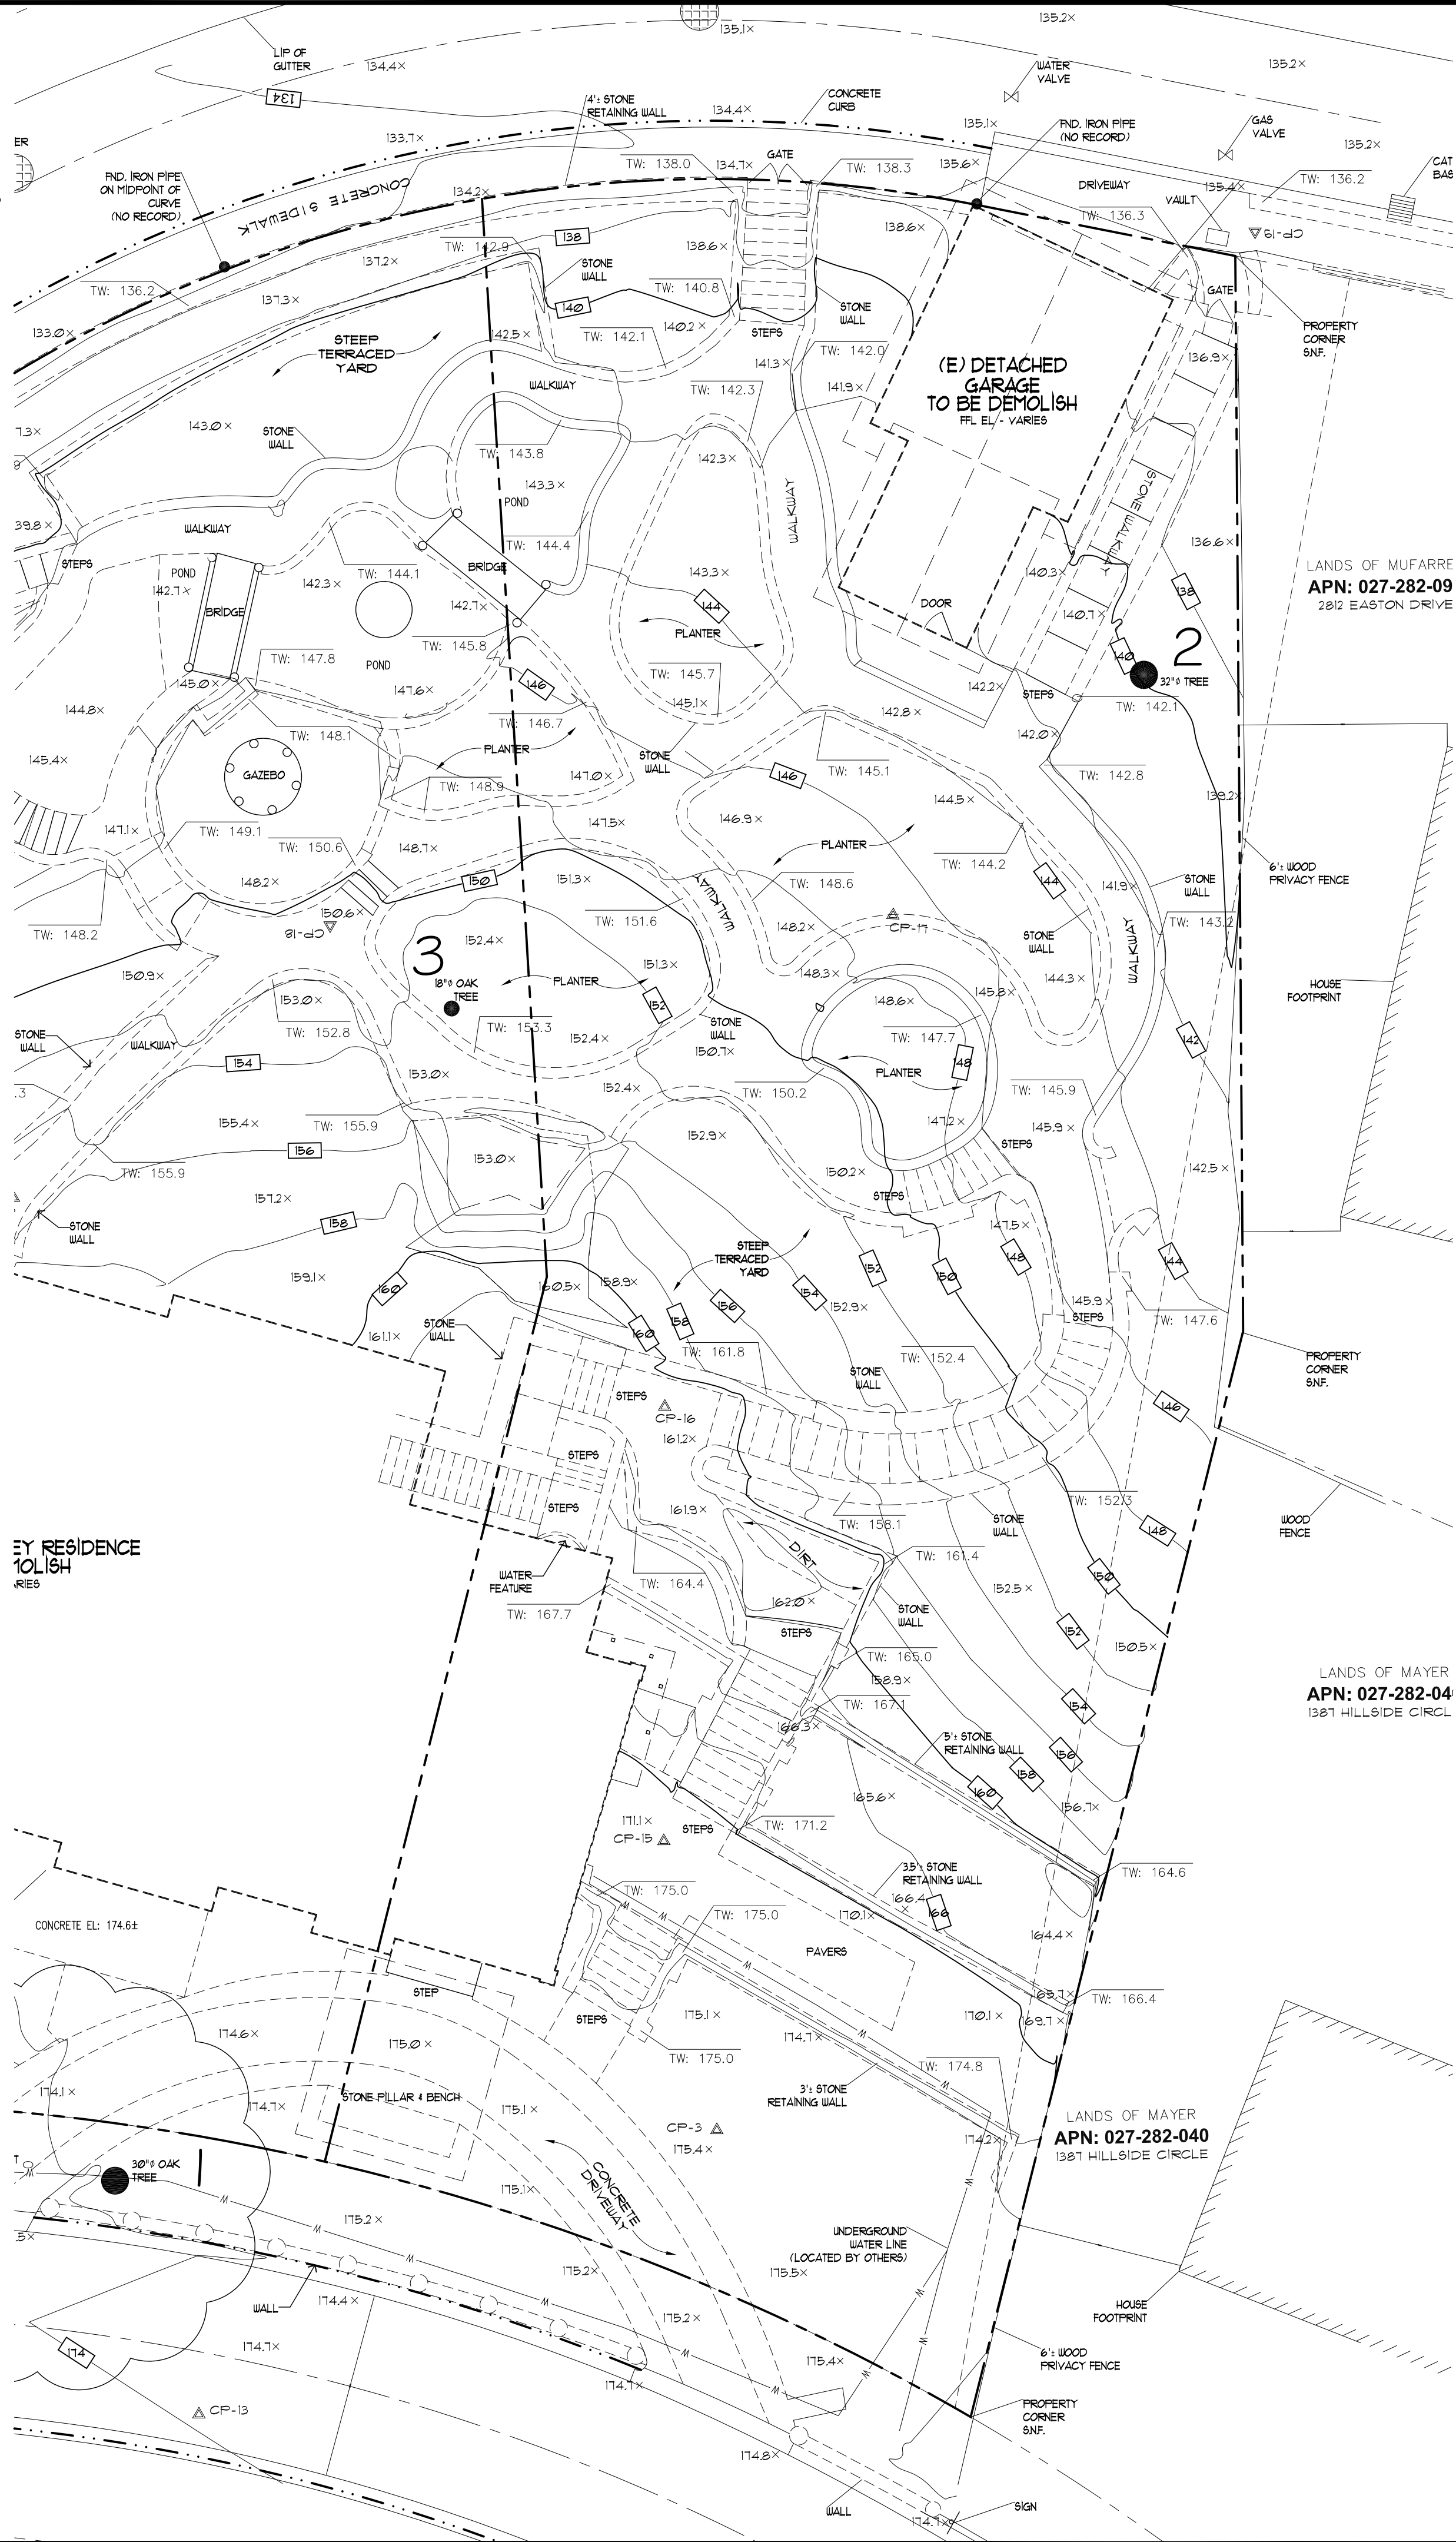

SITE DEMOLITION PLAN
SCALE: 3/32"=1'-0"

| REVISIONS | BY |
|-----------|----|
| | |
| | |
| | |
| | |

CHU DESIGN ASSOCIATES INC.
210 INDUSTRIAL RD. SUITE 205
SAN CARLOS, CALIFORNIA 94070
TEL.: (650) 345-9286 EXT. 1001

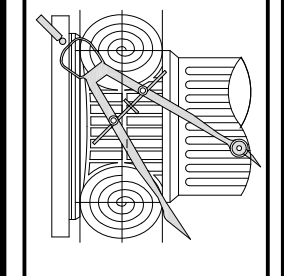


The drawing on this sheet, specification ideas, designs, and arrangements represented hereby are and shall remain the property of CHU DESIGN ASSOCIATES, INC., and in no part thereof shall be copied, disclosed to others or used in connection with any work or project other than the specified project for which they have been prepared and developed without the written consent of CHU DESIGN ASSOCIATES, INC. Visual contact with these plans or specifications shall constitute conclusive evidence of acceptance to these restrictions.

NEW RESIDENCE
1385 HILLSIDE CIRCLE LOT 3
BURLINGAME, C.A.
A.P.N.: 000-000-000

| | |
|-----------|----------|
| DATE: | 10/26/21 |
| SCALE: | AS NOTED |
| DRAWN: | MC |
| CHK: | |
| SHEET NO. | |

A.2
OF SHEETS

1. SEE LANDSCAPE PLAN FOR DETAILED INFORMATION
2. MAXIMUM DRIVEWAY SLOPES SHALL NOT EXCEED FIFTEEN (15) PERCENT AT ANY POINT. SPECIAL APPROVAL OF THE DEPARTMENT OF PUBLIC WORKS' SLOPES IN EXCESS OF TWENTY (20) PERCENT SHALL REQUIRE APPROVAL OF THE PLANNING COMMISSION. TRANSITIONAL SLOPES ARE REQUIRED FOR DRIVEWAYS WHICH EXCEED TEN (10) PERCENT MAXIMUM SLOPE. NO TRANSITIONAL SLOPE SHALL EXTEND INTO A REQUIRED PARKING SPACE.
3. TOPOGRAPHY IS PREPARED BY:
QUIET RIVER LAND SERVICES INC.
6141 SIERRA COURT, SUITE K
DUBLIN, CA 94568
TEL: (925) 134-6788
4. A DEMOLITION PERMIT IS REQUIRED FOR SIDEWALK, SEWER AND WATER REPLACEMENT
5. REQUIRED PROTECTIVE FENCES MUST BE INSTALLED AND INSPECTED PRIOR TO DEMO PERMIT ISSUE.
6. SEWER BACKFLOW PROTECTION CERTIFICATE IS REQUIRED PER ORDINANCE NO. 110. A DRAFT CERTIFICATION SHALL BE SUBMITTED PRIOR TO THE ISSUANCE OF A BUILDING PERMIT.

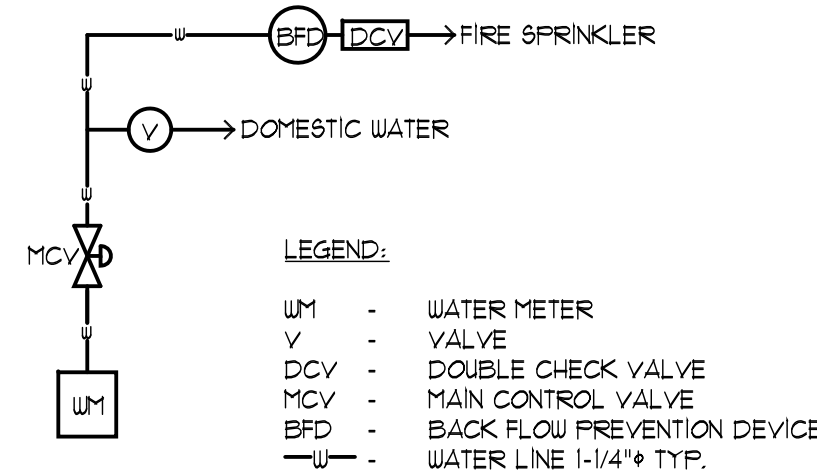

1. PROVIDE A BACKFLOW PREVENTION DEVICE - USC APPROVED DOUBLE CHECK VALVE ASSEMBLY.
2. CONTRACTOR SHALL ENSURE THE DOUBLE CHECK VALVE ASSEMBLY FOR THE FIRE PROTECTION SHALL BE TESTED AND APPROVED BY A SAN MATEO COUNTY ENVIRONMENTAL HEALTH APPROVED CONTRACTOR PRIOR TO SCHEDULING WATER DEPARTMENT FINAL.
3. PROVIDE ADEQUATE FIRE FLOW BASED UPON CONSTRUCTION AND SIZE OF BUILDING. SEE UFC APPENDIX IIIA.

1 SCHEMATIC WATER LATERAL LINE
NOT TO SCALE

RAINWATER COLLECTION
ALL NEW ROOF RAINWATER SHALL BE COLLECTED BY MEANS OF GALVANIZED METAL GUTTERS UNLESS NOTED OTHERWISE. LOCATED AT THE EAVES. PAINT TO MATCH COLOR. SOURCE OF DOWNSPOUTS. GUTTER SHALL LEAD TO 2" X 4" REST-GALVANIZED METAL PIPES. DOWNSPOUTS OR DOWNPIPES TO MATCH EXISTING AND/OR COPPER RAINWATER LEADER. DOWNSPOUTS SHALL TERMINATE BELOW GRADE TO A PERIMETER 4" DIAMETER ABS SOLID DRAINPIPE. RUN 4" DIAMETER (OR SIZE AS NOTED ON SITE PLAN) SOLID PIPE THROUGH FACE OF CURB SO THAT WATER WILL ENURE INTO THE STREET GUTTER SYSTEM. SLOPE ALL PIPES FOR ADEQUATE DRAINAGE. INSURE THAT THE LOCATION CHOSEN FOR THE PIPE TO GO THROUGH THE CURB OR CURB IS ADEQUATE TO CARRY THE WATER FROM THE SITE TO THE STREET. THE NEW RAINWATER COLLECTION IN A SINGLE DOWNSPOUT SHALL NOT ALLOW WATER TO FLOW TO THE STREET BY GRAVITY METHOD PROVIDED THERE IS SUFFICIENT GRADE TO INSURE FLOW TO THE STREET GUTTER SYSTEM AND DOES NOT FLOW ONTO ADJOINING PROPERTIES.

SUMP PUMP MAY BE REQUIRED (SEE SITE PLAN)
IF THE GRAVITY METHOD OF DRAINAGE CANNOT BE USED, PROVIDE A SUMP PUMP OF ADEQUATE SIZE TO CARRY ALL WATER THROUGH A 2" DIA/ETER ABS PIPE THROUGH THE FACE OF THE CURB SO THAT THE WATER WILL EMPTY INTO THE GUTTER SYSTEM. INSURE THAT THE LOCATION CHOSEN FOR THE PIPE TO GO THROUGH THE FACE OF CURB IS ADEQUATE TO CARRY THE WATER FROM THE SITE TO A CITY MAINTAINED WATER COLLECTION SYSTEM.

PROVIDE A BACKFLOW PREVENTER/DEVICE AT A LOCATION NEAR THE TERMINATION OF THE SOLID PIPE THROUGH THE FACE OF CURB AS REQUIRED TO PREVENT RAINWATER FROM THE GUTTER SYSTEM ENTERING THE SUMP PUMP SYSTEM.

SUMP PUMP AT A MINIMUM SHALL BE A 1/4 HP AUTOMATIC SUBMERSIBLE SUMP PUMP WITH PERFORMANCES AS LISTED BELOW (MINIMUM). INSTALL AS PER MANUFACTURERS SPECIFICATIONS AND RECOMMENDATIONS.

| | | | |
|--------------------------------|------|------|-----|
| DISCHARGE FEET OF HEAD | 5 | 10 | 15 |
| PERFORMANCE (GALLONS PER HOUR) | 2280 | 1620 | 660 |

SUMP PIT- INSTALL PUMP IN SUMP PIT (CATCH BASIN) WITH THE MINIMUM CLEARANCES AND DEPTHS AS PER MANUFACTURER SPECIFICATIONS AND RECOMMENDATIONS.

CONTRACTOR SHALL OBTAIN SEPARATE FIRE SPRINKLER PERMIT FOR THE INSTALLATION OF THE FIRE SPRINKLER SYSTEM IN ACCORDANCE WITH SECTION 1704.030 OF THE BURLINGAME MUNICIPAL CODE. THE MINIMUM SIZE SERVICE FOR FIRE SPRINKLER SYSTEM SHALL CONFORM TO NFPA 13 OR 13R IS 2". FOR NFPA 13D SYSTEMS THE MINIMUM SIZE IS 1".


FIRE SPRINKLER SHOP DRAWINGS ARE TO BE SUBMITTED DIRECTLY TO THE BURLINGAME FIRE DEPARTMENT AT 1399 ROLLING ROAD, BURLINGAME ONLY AFTER FIRE SPRINKLER UNDERGROUNDS HAVE BEEN SUBMITTED TO THE BURLINGAME BUILDING DEPARTMENT.

1. CONTRACTOR SHALL PROVIDE ADEQUATE MEASURES TO AVOID EROSION OR SEDIMENT FROM LEAVING THE SITE AND FLOWING INTO THE STREET, CURB OR GUTTER. (USE STRAW WADDLES).
2. REPLACE DAMAGED OR DISPLACED CURB, GUTTER AND/OR SIDEWALK ALONG THE PROPERTY FRONTAGE. A CITY ENCROACHMENT PERMIT IS REQUIRED.
3. THE SANITARY SEWER LATERAL (BUILDING SEWER) SHALL BE TESTED PER ORDINANCE CODE CHAPTER 15.02. TESTING INFORMATION IS AVAILABLE AT THE BUILDING DEPARTMENT COUNTER. AN ENCROACHMENT PERMIT IS REQUIRED FROM THE PUBLIC WORKS DEPARTMENT WHENEVER THE CITY'S PORTION OF THE SEWER LATERAL OR CITY CLEANOUT IS TO BE LAID AND/OR CONNECTED TO THE SEWER MAIN. A PASSED SEWER LATERAL TEST CERTIFICATE MUST BE IN PLACE PRIOR TO FINAL OF THE BUILDING PERMIT.
4. NEW DRIVEWAY OR DRIVEWAY WIDENING MUST BE APPROVED BY THE CITY ENGINEER. SHOW DISTANCE BETWEEN THE PROPOSED DRIVEWAY OPENING TO THE CLOSEST ADJACENT DRIVEWAY ON SITE PLAN.
5. A PROPERTY SURVEY IS REQUIRED IF ANY PART OF PERMANENT STRUCTURE INCLUDING FOOTING IS WITHIN 12' OF PROPERTY LINE.
6. A SURVEY OF THE PROPERTY LINES FOR ANY STRUCTURE WITHIN ONE FOOT OF THE PROPERTY LINE WILL BE PROVIDED AT THE TIME OF THE FOUNDATION AND STEEL INSPECTION (PUE LETTER DATED 8-11-88).
7. PLUMBING CONTRACTOR SHALL PROVIDE A SINGLE LINE DIAGRAM AT TIME OF INSPECTION AND ANY INSTALLATION PRIOR TO PLAN CHECK AND APPROVAL IS AT CONTRACTOR'S RISK.

1. PROJECTS THAT DISTURB LESS THAN ONE ACRE SHALL DEVELOP AND IMPLEMENT A PLAN TO MANAGE STORY WATER DRAINAGE DURING CONSTRUCTION. A BMP PAGE IS SUFFICIENT.
2. PLANS SHALL INDICATE HOW GRADING AND PAVING WILL PREVENT SURFACE WATER FLOWS FROM ENTERING BUILDINGS. EXCEPTION: PROJECTS THAT DO NOT ALTER DRAINAGE PATH.
3. ELECTRIC VEHICLE (EV) CHARGING PARKING SPACES: COMPLY WITH ALL RELEVANT SECTIONS.

| FIRE AREA (square feet) | | | | | FIRE FLOW (GPM) | FIRE DURATION (hours) |
|-------------------------|---------------|---------------|-------------|--------------|--------------------|-----------------------|
| X 0.0029 to get 2 | | | | | | |
| Type I-F R | Type I One-R | Type I-V.H.T. | Type I-B-N | Type I-V.N.I | x 3.785 for L/min. | |
| I-F R 1 | One-R 1 | V.H.T. 1 | B-N 1 | V.N.I 1 | | |
| 0-72.00 | 0-12.70 | 0-8.20 | 0-5.00 | 0-3.60 | 1.50 | |
| 22.01-30.20 | 12.71-17.00 | 8.21-10.80 | 5.00-5.90 | 3.60-4.80 | 1.75 | |
| 30.21-38.40 | 17.01-21.30 | 10.81-13.40 | 5.90-6.80 | 4.80-6.30 | 2.00 | |
| 38.41-46.60 | 21.31-25.60 | 13.41-16.00 | 6.80-7.60 | 6.30-7.70 | 2.25 | |
| 46.61-54.80 | 25.61-29.90 | 16.01-18.60 | 7.60-8.40 | 7.70-9.10 | 2.50 | |
| 54.81-63.00 | 29.91-34.20 | 18.61-21.20 | 8.40-9.20 | 9.10-10.50 | 2.75 | |
| 292.61-300.80 | 154.61-158.90 | 94.01-96.60 | 31.60-32.40 | 49.70-51.10 | 10.00 | |
| 300.81-309.00 | 158.91-163.20 | 96.61-99.20 | 32.40-33.20 | 5 | | |

| | | | |
|-----------------------|-----------------------------|----------------|---------------|
| FIRE FLOW CALCULATION | AUTOMATIC SPRINKLER SYTEM | MIN. FIRE FLOW | FLOW DURATION |
| 3,950 SQ. FT. | NO AUTOMATIC SPRINKLER SYS. | 1,750 | 2 HOURS |

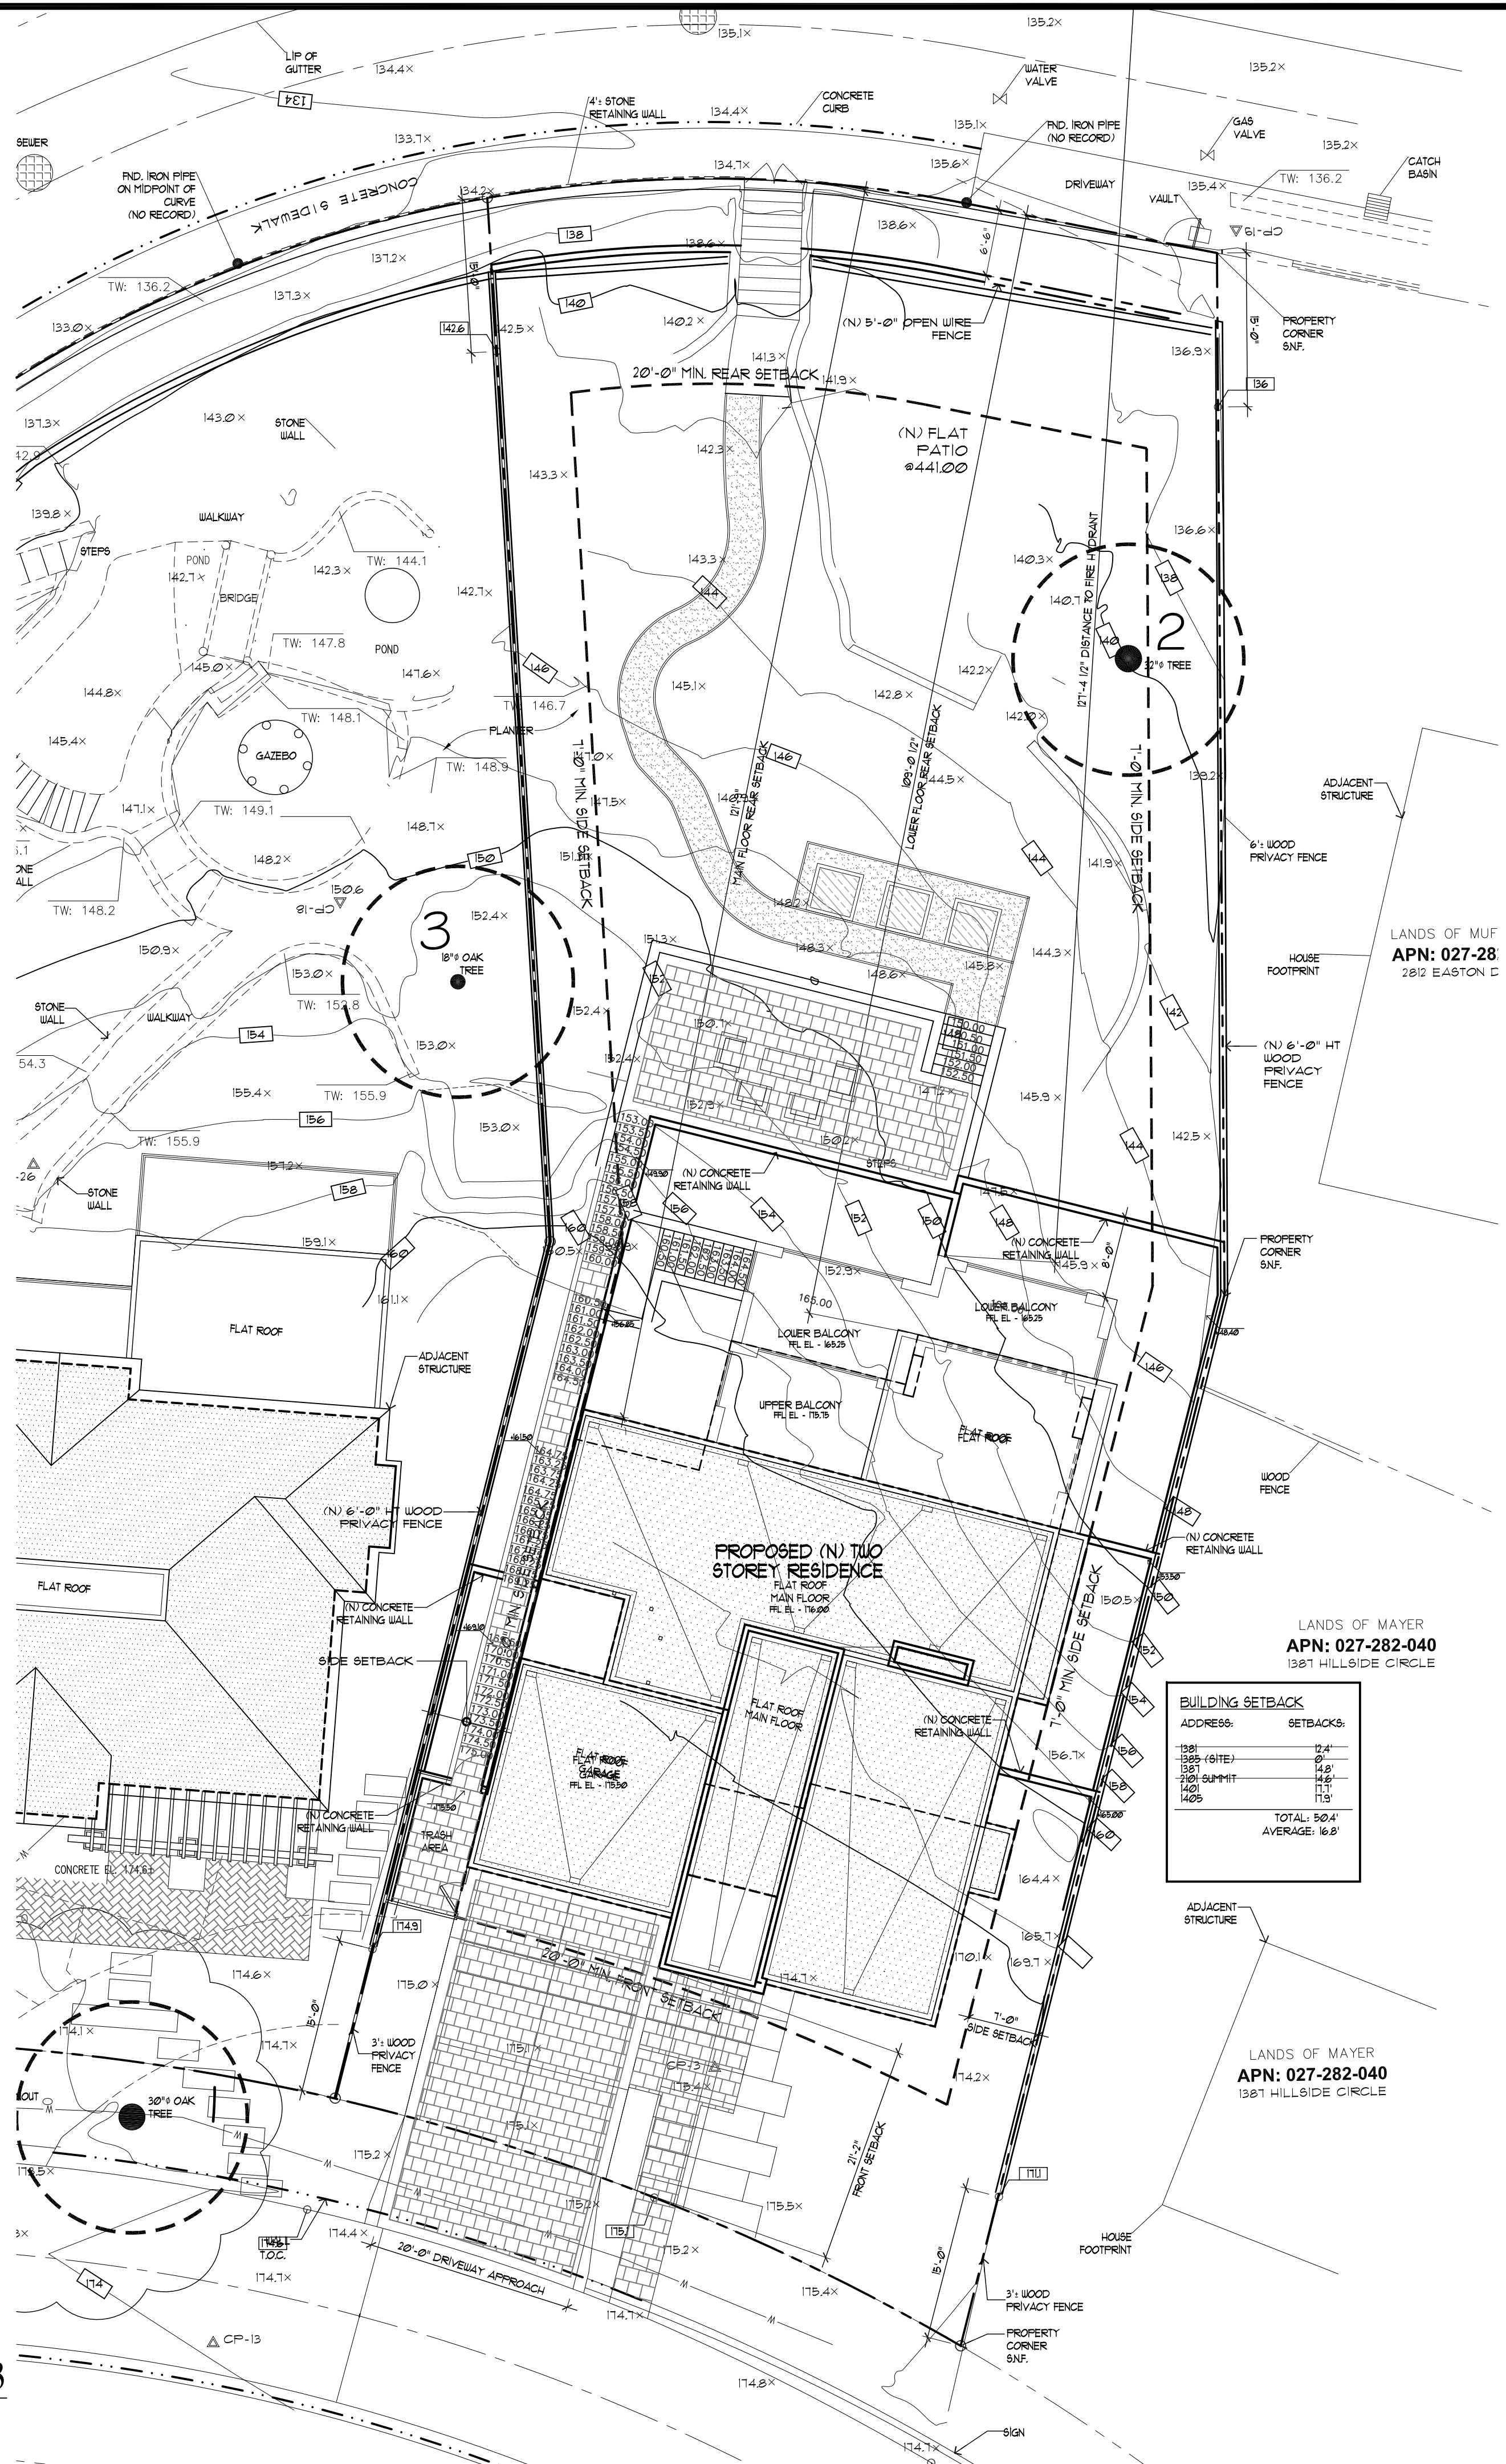[illegible]


CHU DESIGN ASSOCIATES INC.
21210 INDUSTRIAL RD. SUITE 205
SAN CARLOS, CALIFORNIA 94070
TEL: (650) 345-9286 EXT. 1001

The drawing on this sheet, specification ideas, designs, and arrangements represented thereby are and shall remain the property of CHU DESIGN ASSOCIATES, INC., and in no part thereof shall be copied, disclosed to others or used in connection with any work or project other than the specified project for which they have been prepared and developed without the written consent of CHU DESIGN ASSOCIATES, INC. Visual contact with these plans or specifications shall constitute conclusive evidence of acceptance by these restrictions.

NEW RESIDENCE
1385 HILLSIDE CIRCLE LOT 3
BURLINGAME, C.A.
A.P.N.: 000-000-000


| | |
|-----------|----------|
| DATE: | 10/26/21 |
| SCALE: | AS NOTED |
| DRAWN: | MC |
| JOB: | |
| SHEET NO. | |

A.2.1

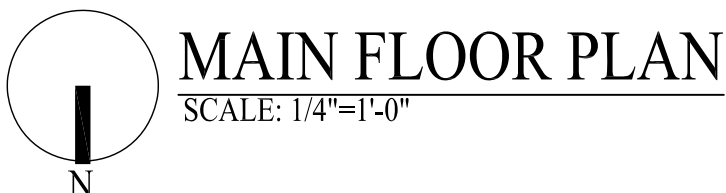

A.3

OF SHEETS

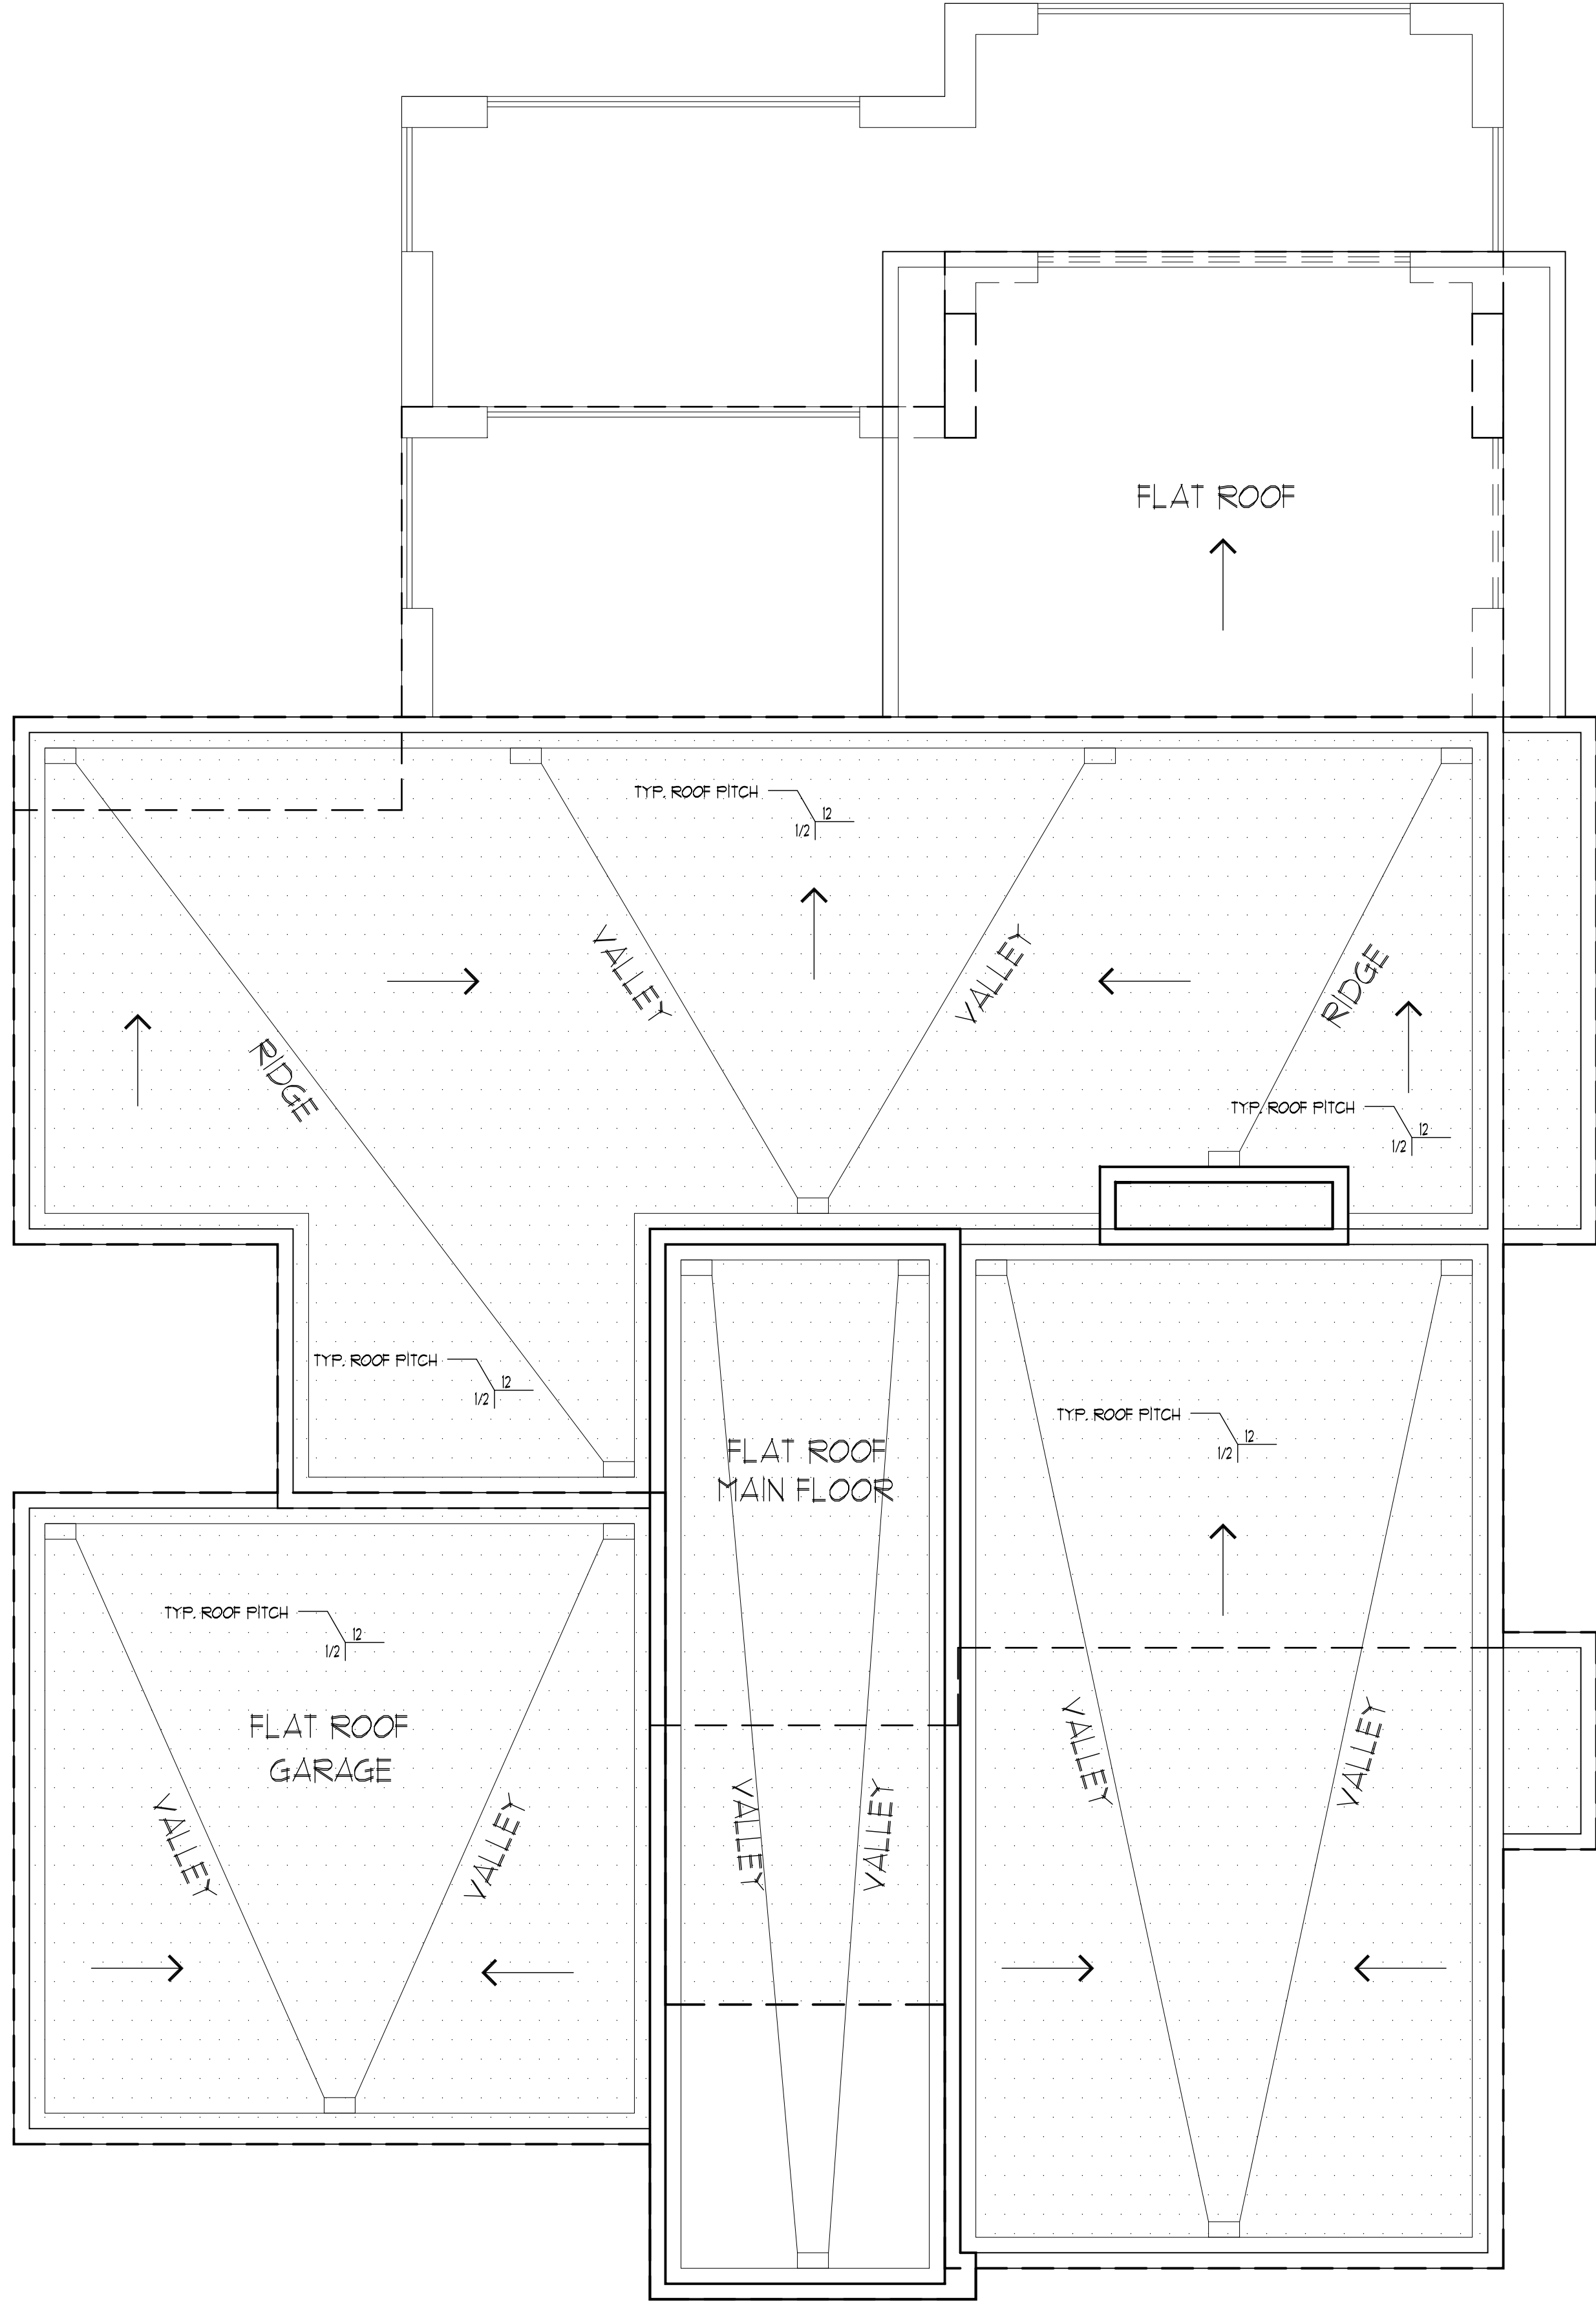

ROOF PLAN
SCALE: 1/4"=1'-0"


The drawing on this sheet, specification ideas, designs, and arrangements represented hereby are and shall remain the property of CHU DESIGN ASSOCIATES, INC.; and in no part thereof shall be copied, disclosed to others or used in connection with any work or project other than the specified project for which they have been prepared and developed without the written consent of CHU DESIGN ASSOCIATES, INC. Visual contact with these plans or specifications shall constitute conclusive evidence of acceptance to these restrictions.

NEW RESIDENCE
1385 HILLSIDE CIRCLE LOT 3
BURLINGAME, C.A.
A.P.N.: 000-000-000

DATE: 10/26/21
SCALE: AS NOTED
DRAWN: MC
XBB:
SHEET NO.

A.3.2

OF SHEETS

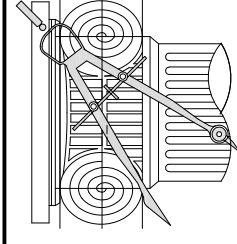


CHU DESIGN ASSOCIATES INC.
210 INDUSTRIAL RD. SUITE 205
SAN CARLOS, CALIFORNIA 94070
TEL.: (650) 345-9286 EXT. 1001

EE = EMERGENCY EGRESS

[illegible]

CHU DESIGN ASSOCIATES INC.
2210 INDUSTRIAL RD. SUITE 205
SAN CARLOS, CALIFORNIA 94070
TEL: (650) 345-9286 EXT. 1001

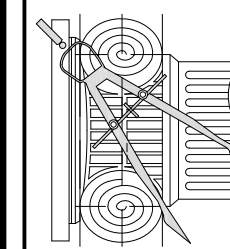

The drawing on this sheet, specification ideas, designs, and arrangements represented hereby are and shall remain the property of CHU DESIGN ASSOCIATES, INC.; and in no part thereof shall be copied, disclosed to others or used in connection with any work for or project other than the specified project for which they have been prepared and developed without the written consent of CHU DESIGN ASSOCIATES, INC. Visual contact with these plans or specifications shall constitute conclusive evidence of concurrence to these restrictions.


NEW RESIDENCE
1385 HILLSIDE CIRCLE LOT 3
BURLINGAME, C.A.
A.P.N.: 000-000-000


| | |
|----------|----------|
| DATE: | 10/26/21 |
| SCALE: | AS NOTED |
| DRAWN: | MC |
| JOB: | |
| SHEET NO | |

SHEET NO. _____

A.4

OF SHEET

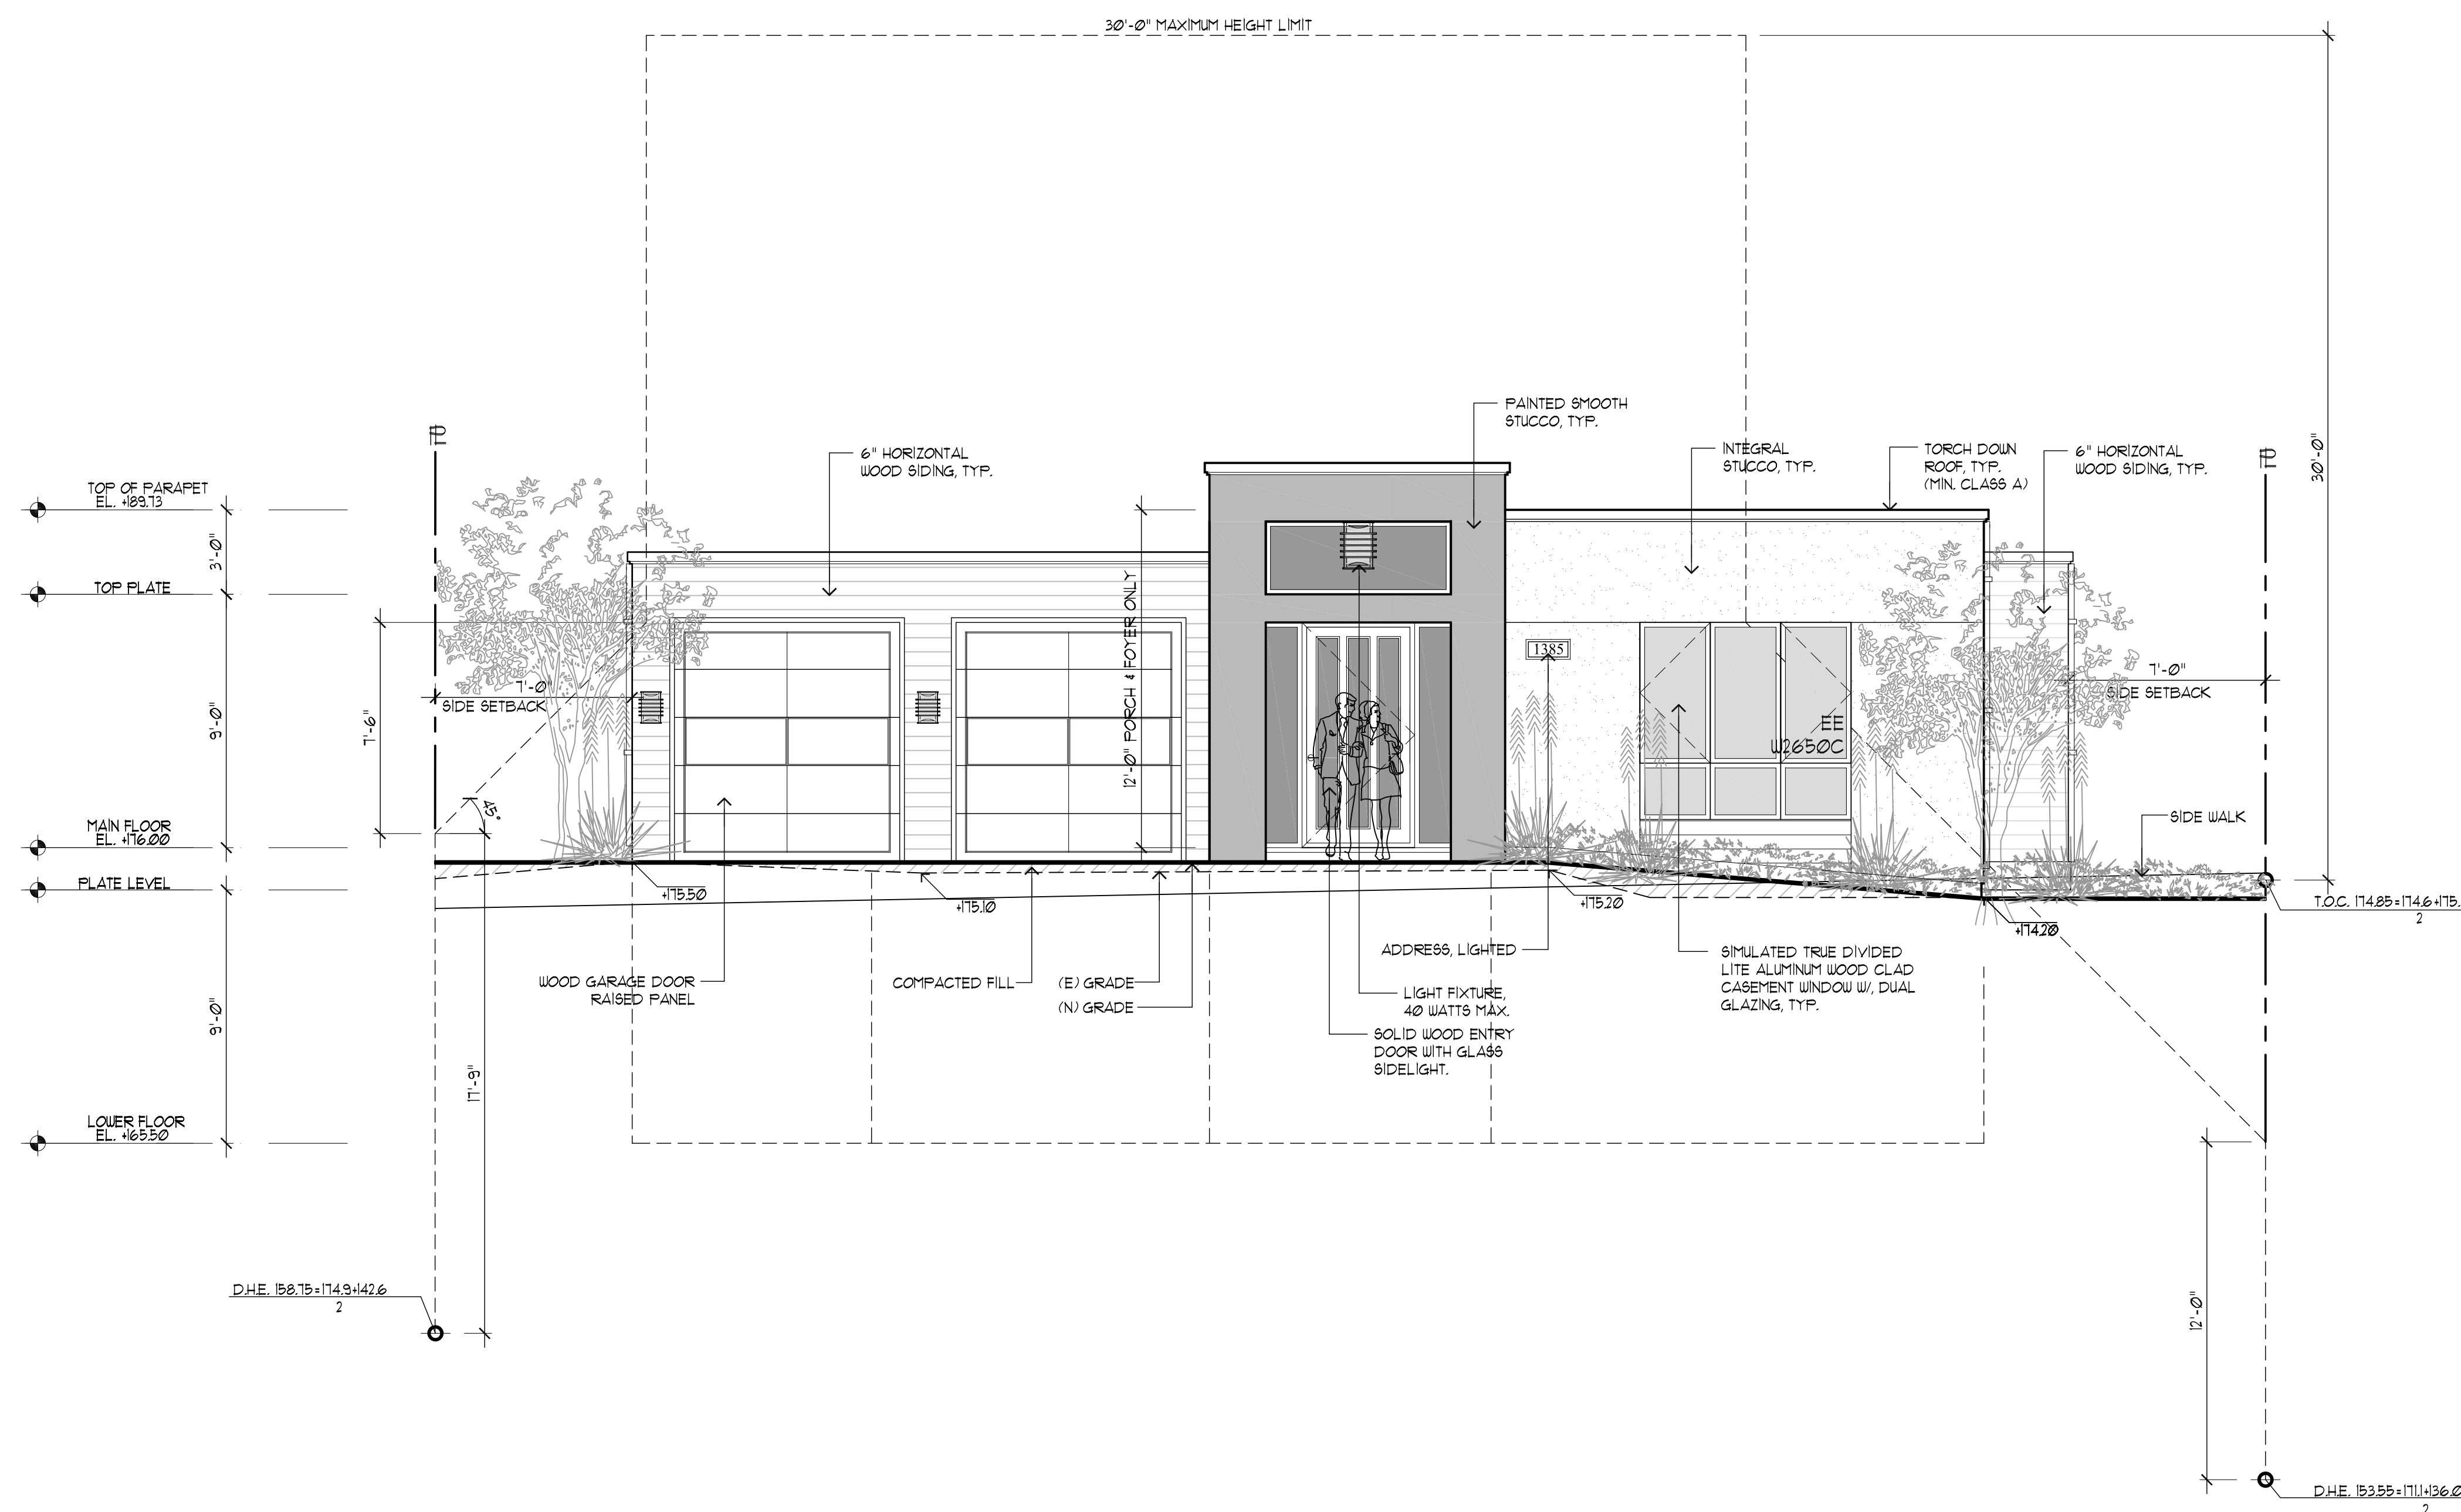

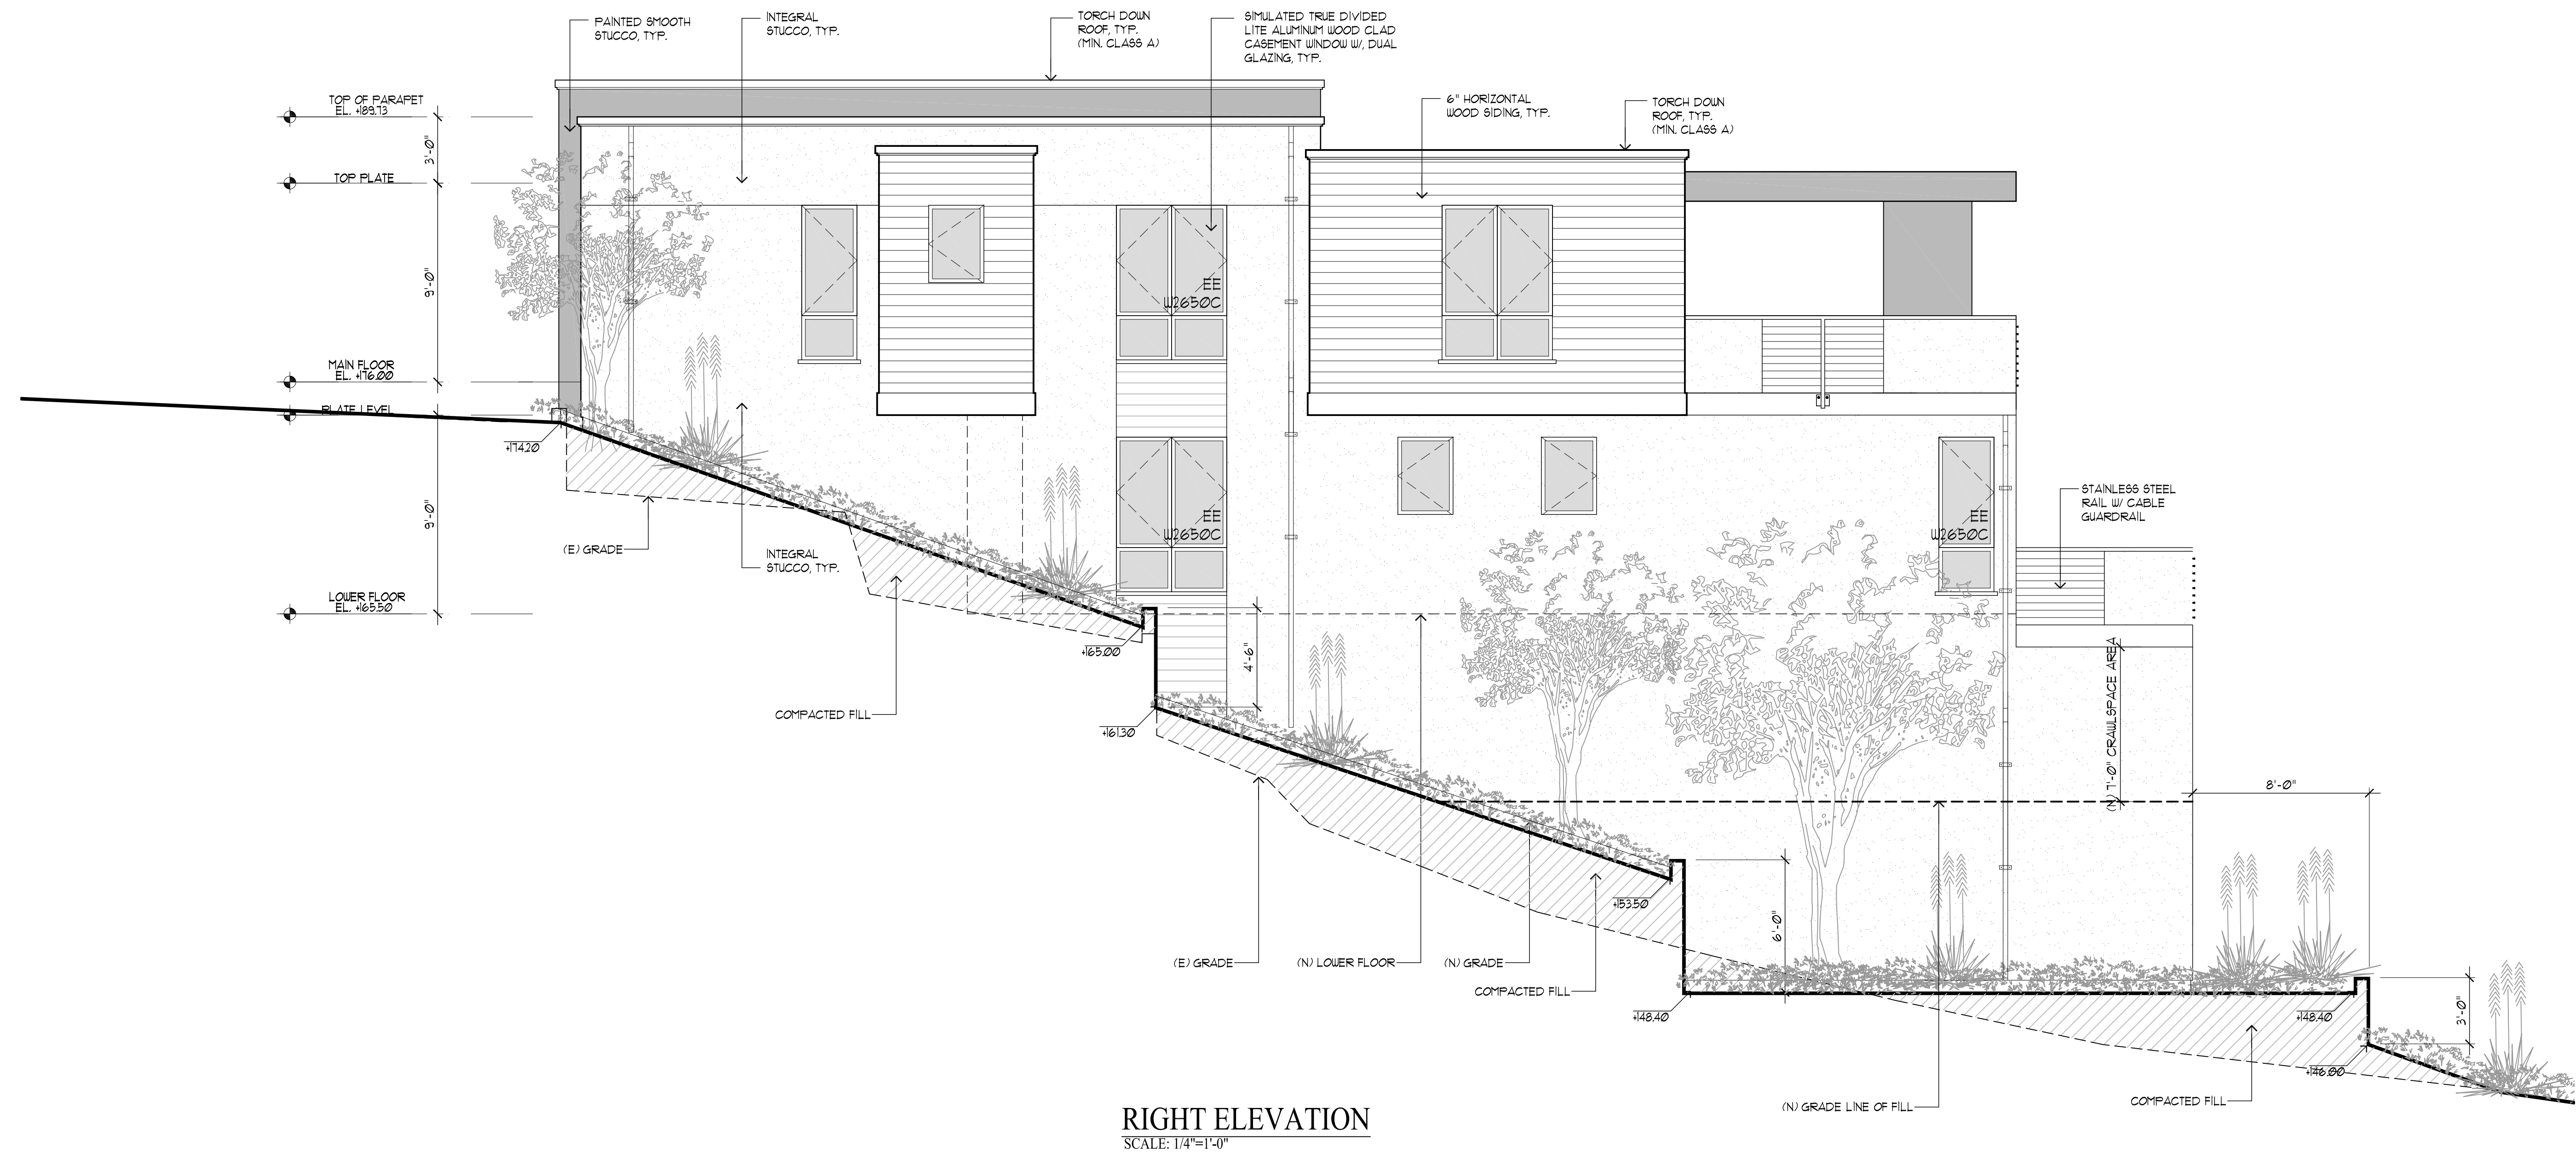

LEGEND
EE = EMERGENCY EGRESS


The drawing on this sheet, specification ideas, designs, and arrangements represented hereby are and shall remain the property of CHU DESIGN ASSOCIATES, INC., and in no part thereof shall be copied, disclosed to others or used in connection with any work or project other than the specified project for which they have been prepared and developed without the written consent of CHU DESIGN ASSOCIATES, INC. Visual contact with these plans or specifications shall constitute conclusive evidence of acceptance to these restrictions.

NEW RESIDENCE
1385 HILLSIDE CIRCLE LOT 3
BURLINGAME, C.A.
A.P.N.: 000-000-000

DATE: 10/26/21
SCALE: AS NOTED
DRAWN: MC
FOR: SHEET NO.

A.5
OF SHEETS

CHU DESIGN ASSOCIATES INC.
210 INDUSTRIAL RD. SUITE 205
SAN CARLOS, CALIFORNIA 94070
TEL: (650) 345-9286 EXT. 1001

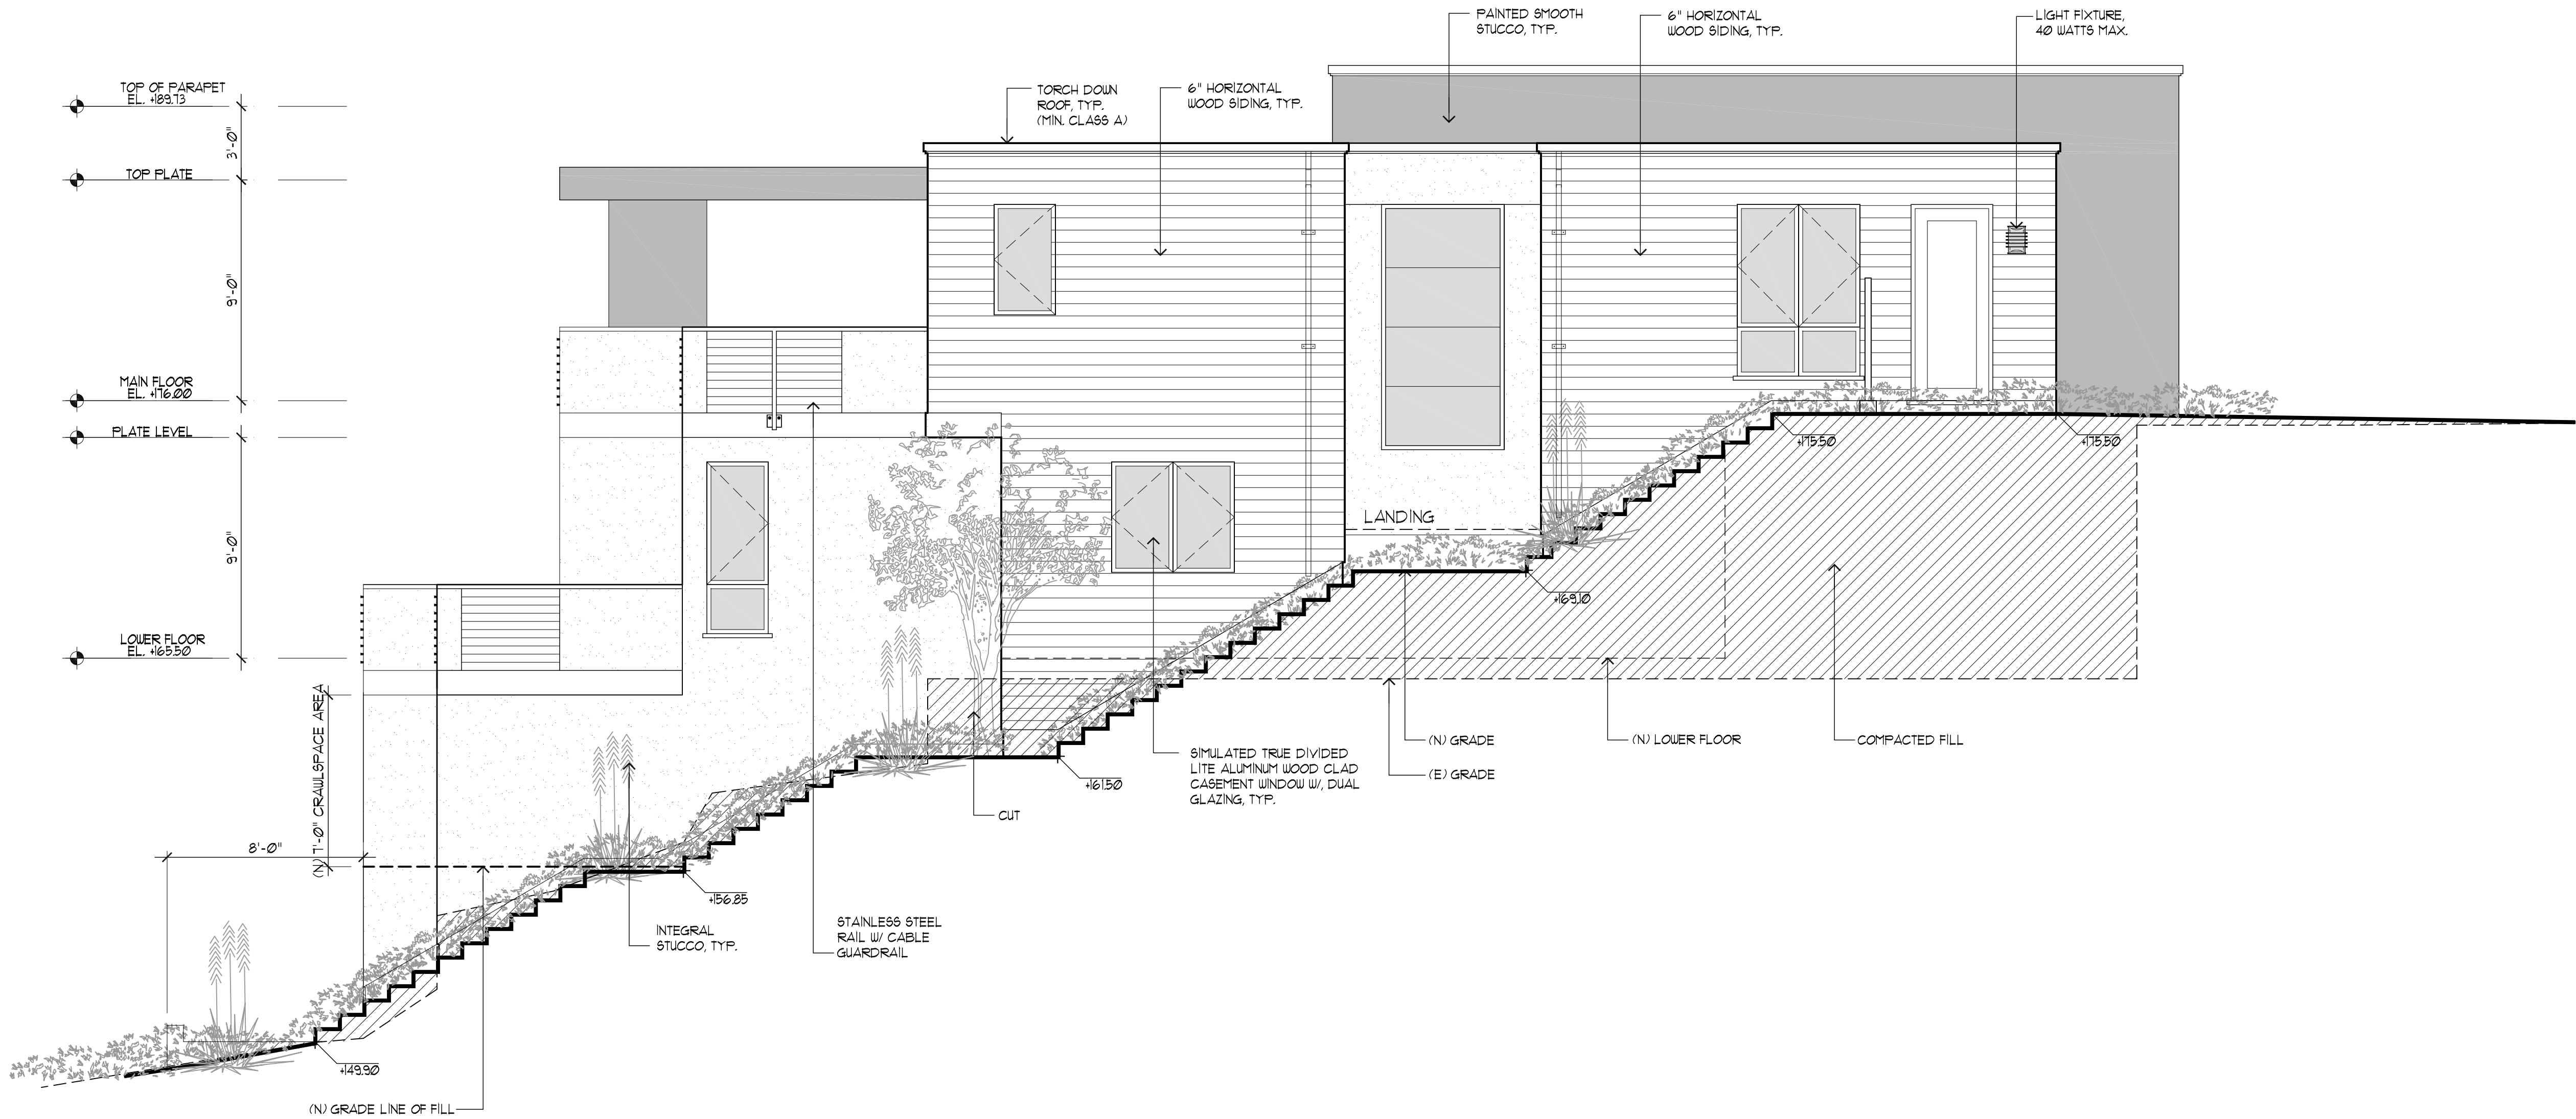

LEFT ELEVATION
SCALE: 1/4"=1'-0"

The drawing on this sheet, specification ideas, designs, and arrangements represented hereby are and shall remain the property of CHU DESIGN ASSOCIATES, INC.; and in no part thereof shall be copied, disclosed to others or used in connection with any work or project other than the specified project for which they have been prepared and developed without the written consent of CHU DESIGN ASSOCIATES, INC. Visual contact with these plans or specifications shall constitute conclusive evidence of acceptance to these restrictions.

NEW RESIDENCE
1385 HILLSIDE CIRCLE LOT 3
BURLINGAME, C.A.
A.P.N.: 000-000-000

DATE: 10/26/21
SCALE: AS NOTED
DRAWN: MC
CHK:
SHEET NO.

A.7
OF SHEETS

CHU DESIGN ASSOCIATES INC.
210 INDUSTRIAL RD. SUITE 205
SAN CARLOS, CALIFORNIA 94070
TEL.: (650) 345-9286 EXT. 1001

EE = EMERGENCY EGRESS

[illegible]


A technical drawing of a mechanical part, possibly a gear or a pulley, with a compass and a pencil. The drawing shows a cross-section of a cylindrical part with a central hole and a flange. A compass is used to draw a circle, and a pencil is used to draw a line.

thereby are and shall remain the property of CHU DESIGN ASSOCIATES, INC., and no part thereof shall be copied, disclosed to others or used in connection with any work or project other than the specified project for which they have been prepared and developed without the written consent of CHU DESIGN ASSOCIATES, INC. Visual contact with these plans or specifications shall constitute conclusive evidence of acceptance by these restrictions.

NEW RESIDENCE
1385 HILLSIDE CIRCLE LOT 3
BURLINGAME, C.A.
A.P.N.: 000-000-000

| | |
|---------|----------|
| DATE: | 10/26/21 |
| RE: | AS NOTED |
| ATTN: | MC |
| REF NO. | |


A.8
OF SHEETS

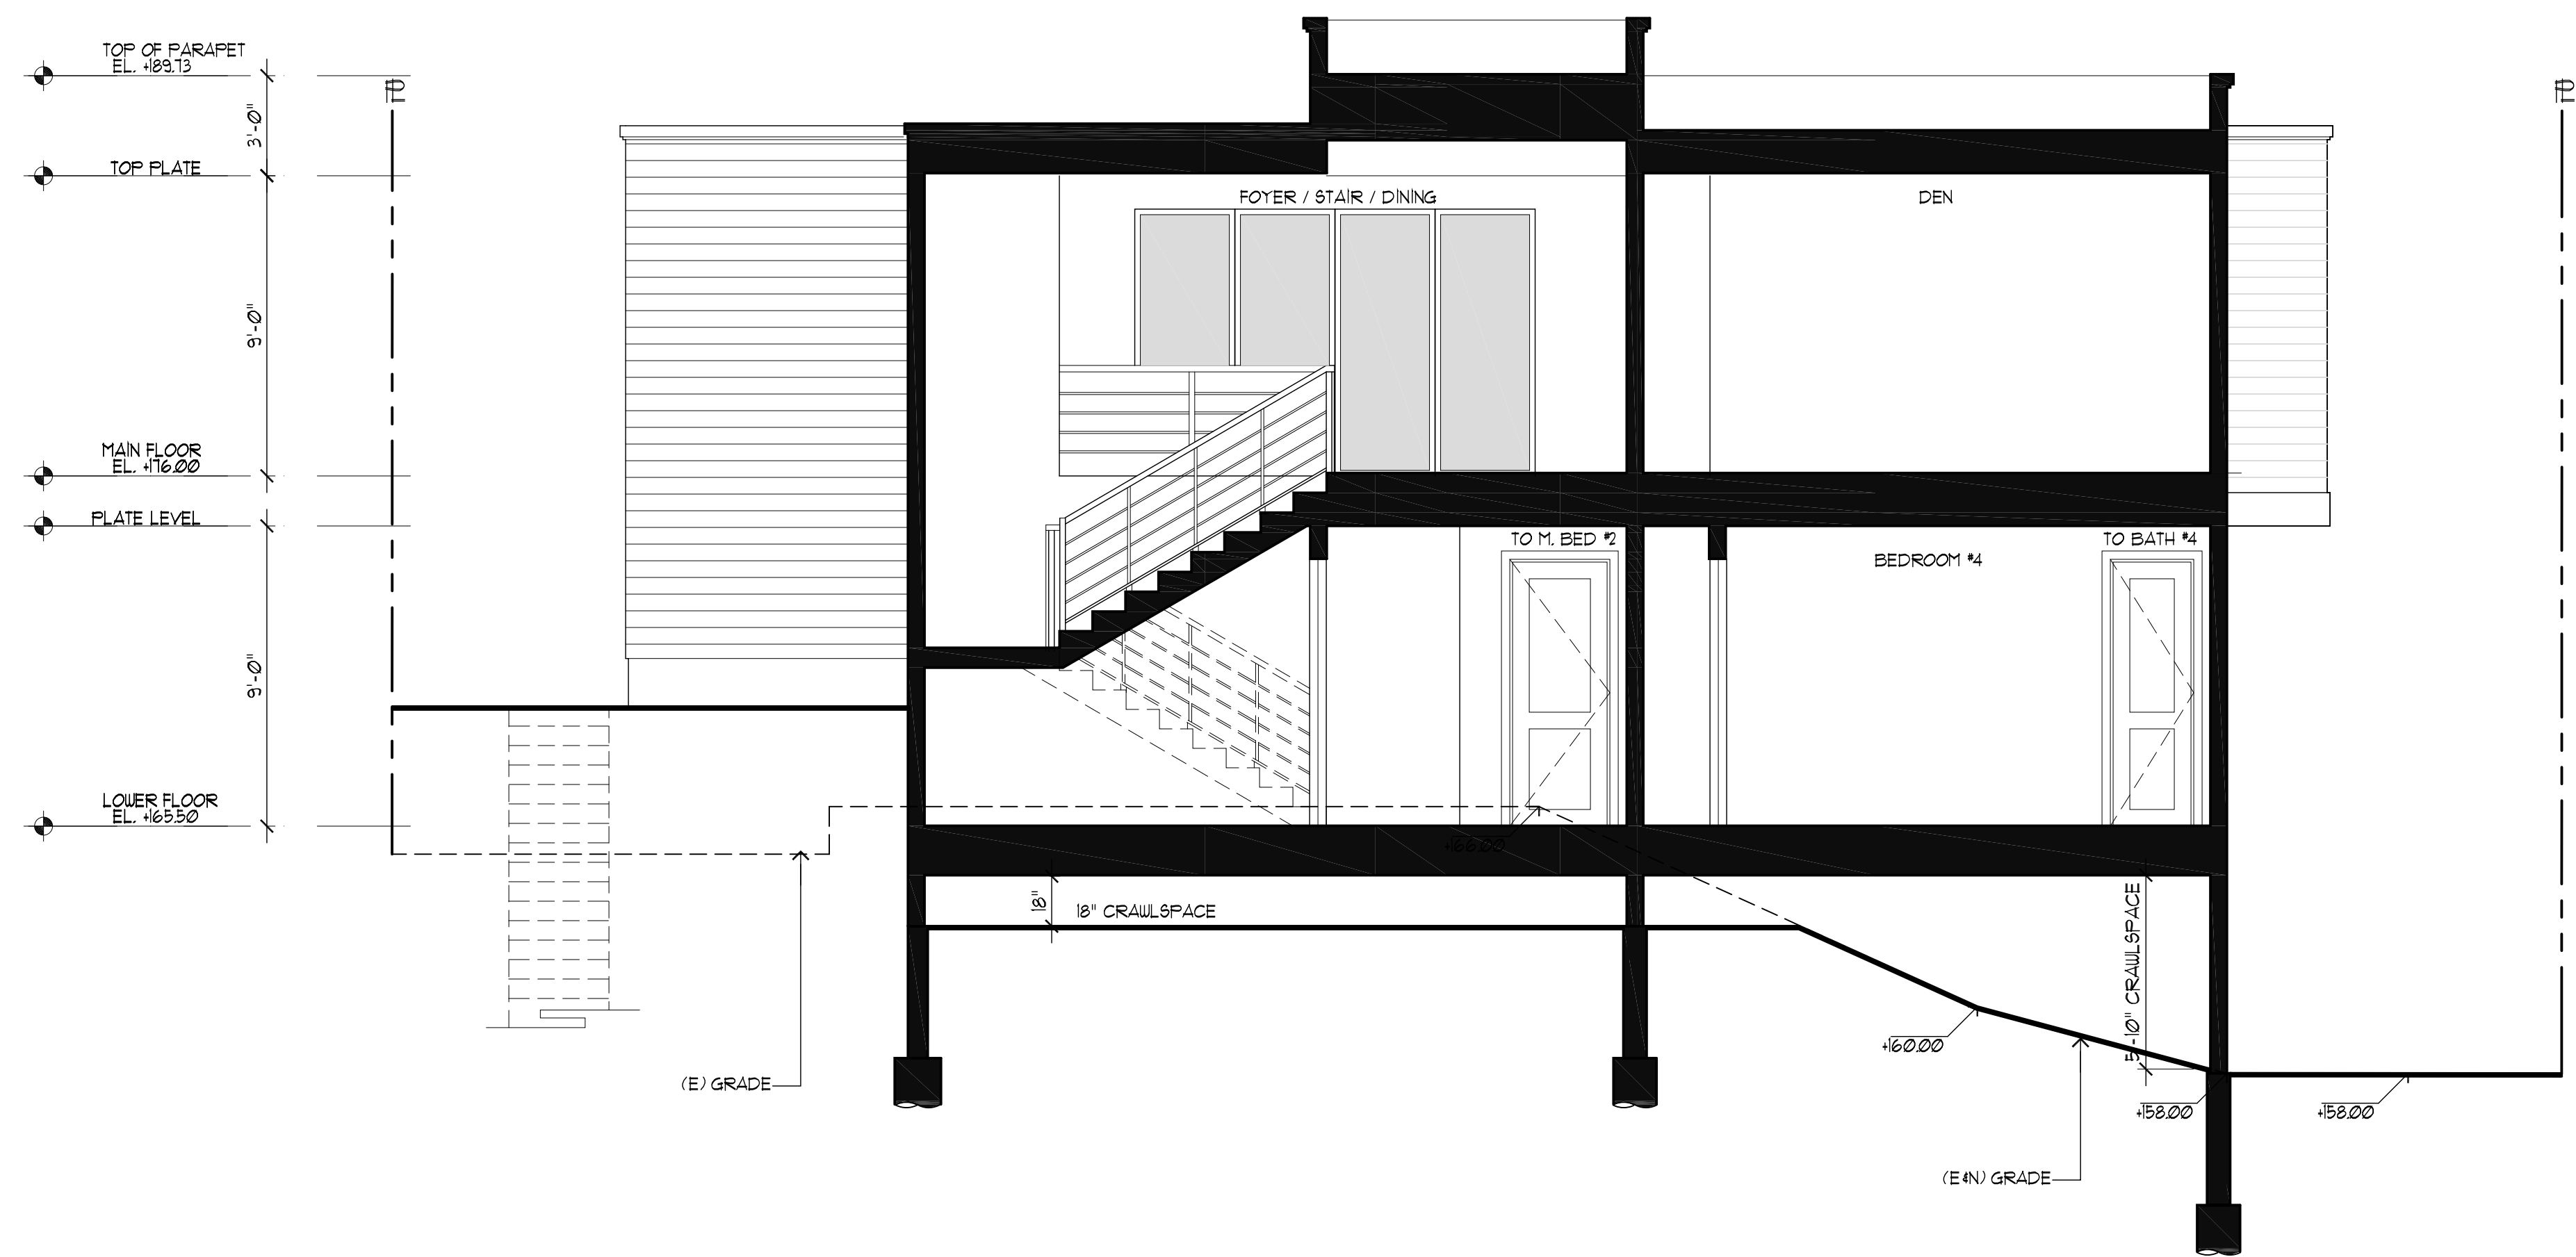

BUILDING SECTION B-B
SCALE: 1/4"=1'-0"

[illegible]

CHU DESIGN ASSOCIATES INC.
210 INDUSTRIAL RD. SUITE 205
SAN CARLOS, CALIFORNIA 94070
TEL: (650) 345-9286 EXT. 1001

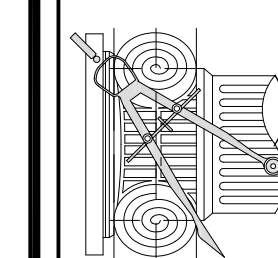


The drawing on this sheet, specification ideas, designs, and arrangements represented hereby are and shall remain the property of CHU DESIGN ASSOCIATES, INC.; and in no part thereof shall be copied, disclosed or used in connection with any work or project other than the specified project for which they have been prepared and developed without the written consent of CHU DESIGN ASSOCIATES, INC. Visual contact with these plans or specifications shall constitute conclusive evidence of acceptance to these restrictions.

NEW RESIDENCE
1385 HILLSIDE CIRCLE LOT 3
BURLINGAME, C.A.
A.P.N.: 000-000-000

| | |
|----------|----------|
| DATE: | 10/26/21 |
| SCALE: | AS NOTED |
| DRAWN: | MC |
| JOB: | |
| SHEET NO | |

A.9

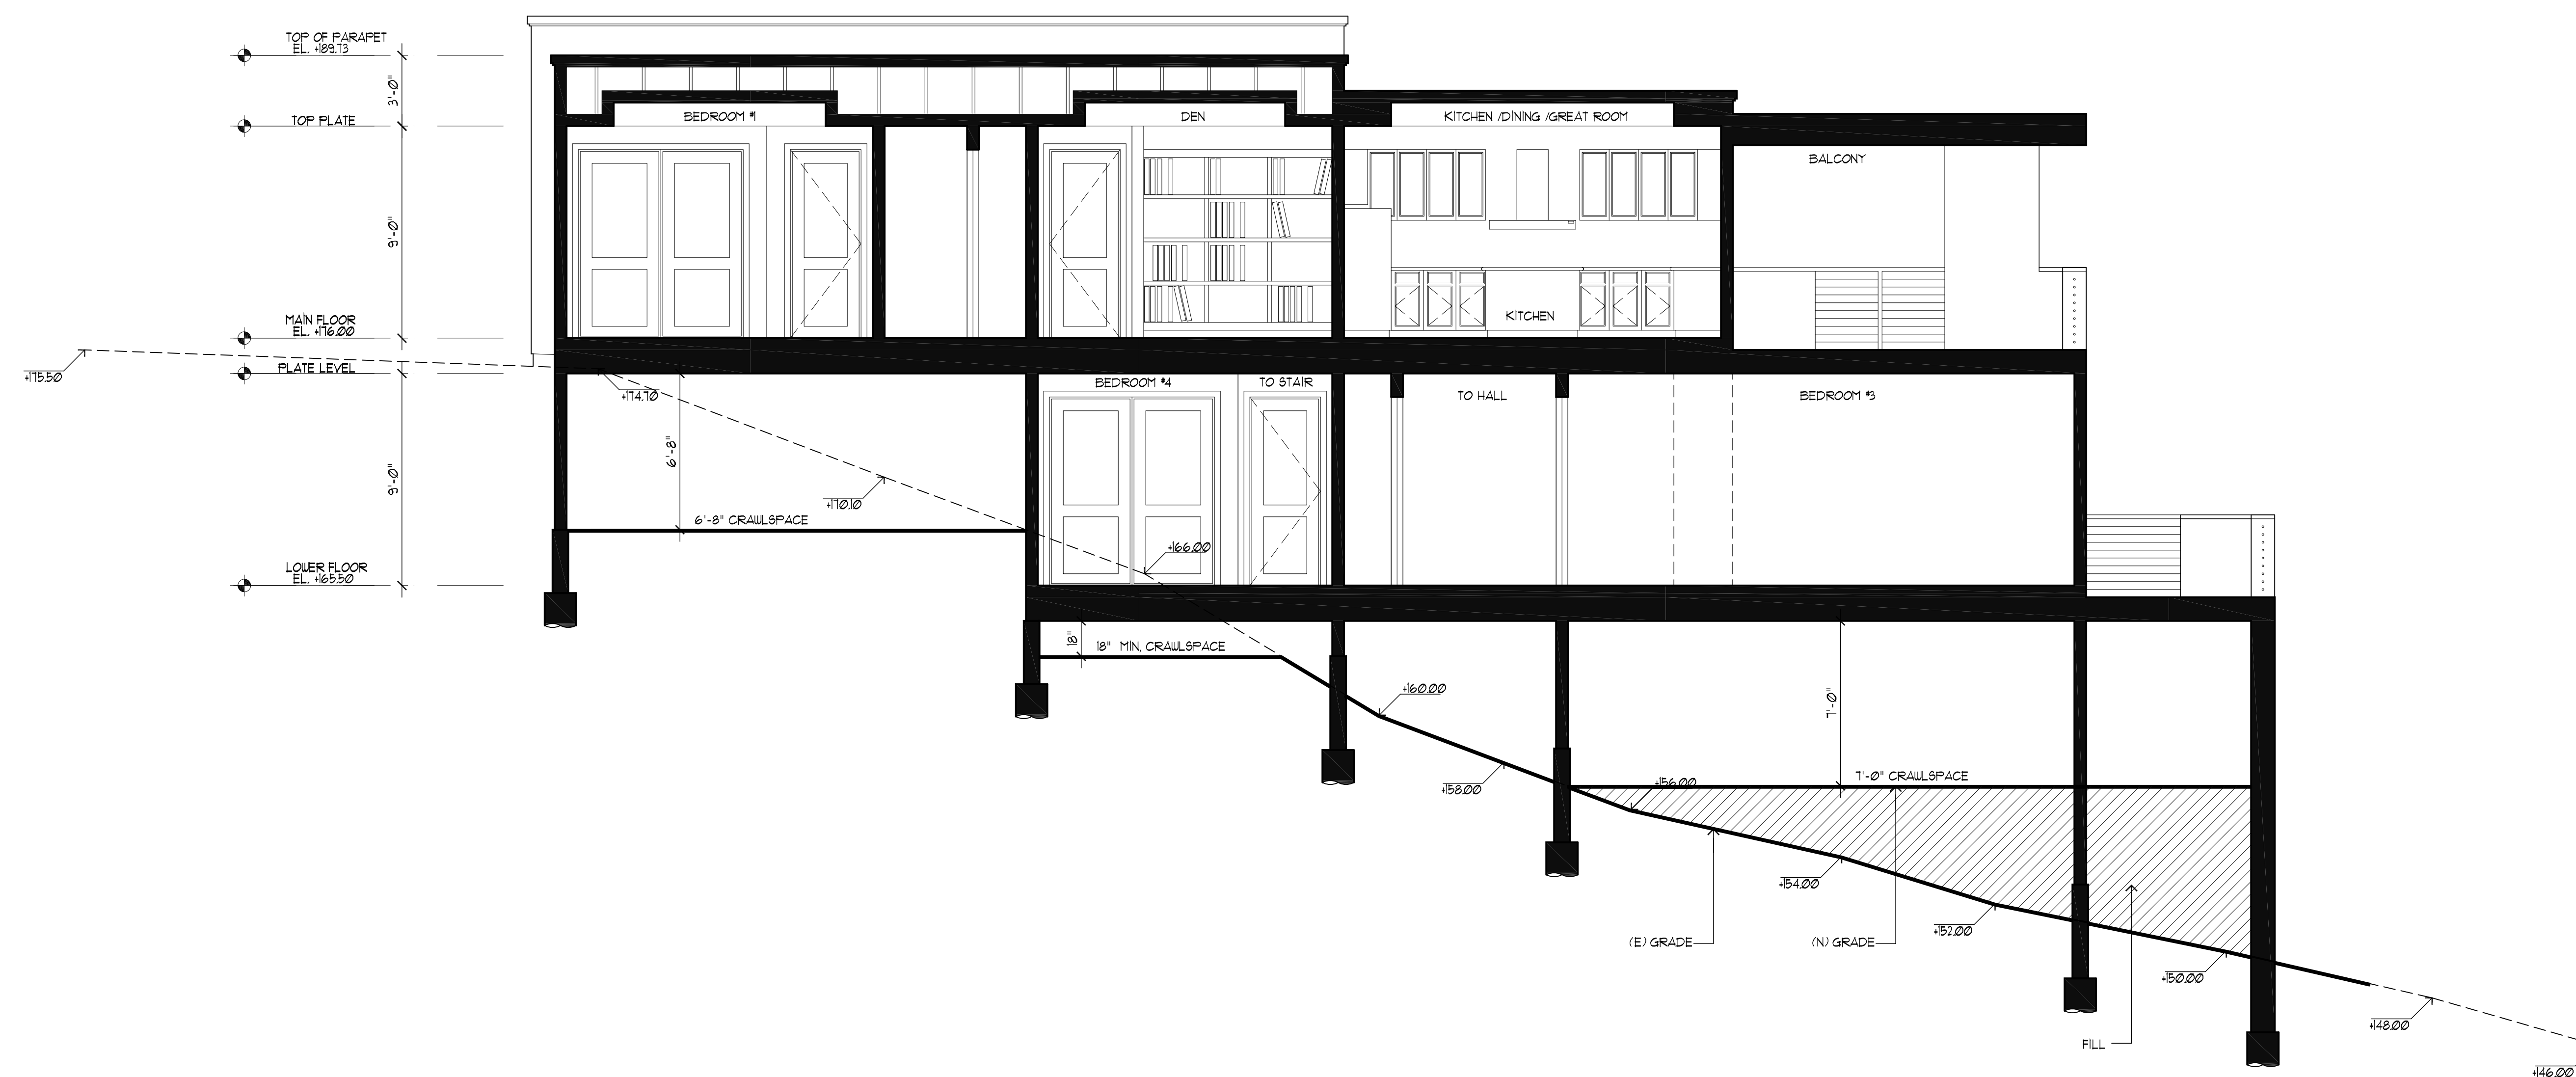

BUILDING SECTION A-A
SCALE: 1/4"=1'-0"



Clean Water. Healthy Community.

Construction projects are required to implement the stormwater best management practices (BMP) on this page, as they apply to your project, all year long.

- ☐ Berm and cover stockpiles of sand, dirt or other construction material with tarps when rain is forecast or if not actively being used within 14 days.
- ☐ Use (but don't overuse) reclaimed water for dust control.

- ❑ Label all hazardous materials and hazardous wastes (such as pesticides, paints, thinners, solvents, fuel, oil, and antifreeze) in accordance with city, county, state and federal regulations.
- ❑ Store hazardous materials and wastes in water tight containers, store in appropriate secondary containment, and cover them at the end of every work day or during wet weather or when rain is forecast.
- ❑ Follow manufacturer's application instructions for hazardous materials and be careful not to use more than necessary. Do not apply chemicals outdoors when rain is forecast within 24 hours.
- ❑ Arrange for appropriate disposal of all hazardous wastes.

- ❑ Cover waste disposal containers securely with tarps at the end of every work day and during wet weather.
- ❑ Check waste disposal containers frequently for leaks and to make sure they are not overfilled. Never hose down a dumpster on the construction site.
- ❑ Clean or replace portable toilets, and inspect them frequently for leaks and spills.
- ❑ Dispose of all wastes and debris properly. Recycle materials and wastes that can be recycled (such as asphalt, concrete, aggregate base materials, wood, gyp board, pipe, etc.)
- ❑ Dispose of liquid residues from paints, thinners, solvents, glues, and cleaning fluids as hazardous waste.

- ❑ Establish and maintain effective perimeter controls and stabilize all construction entrances and exits to sufficiently control erosion and sediment discharges from site and tracking off site.
- ❑ Sweep or vacuum any street tracking immediately and secure sediment source to prevent further tracking. Never hose down streets to clean up tracking.

- ❑ Designate an area, fitted with appropriate BMPs, for vehicle and equipment parking and storage.
- ❑ Perform major maintenance, repair jobs, and vehicle and equipment washing off site.
- ❑ If refueling or vehicle maintenance must be done onsite, work in a bermed area away from storm drains and over a drip pan big enough to collect fluids. Recycle or dispose of fluids as hazardous waste.
- ❑ If vehicle or equipment cleaning must be done onsite, clean with water only in a bermed area that will not allow rinse water to run into gutters, streets, storm drains, or surface waters.
- ❑ Do not clean vehicle or equipment onsite using soaps, solvents, degreasers, steam cleaning equipment, etc.

- ❑ Keep spill cleanup materials (rags, absorbents, etc.) available at the construction site at all times.
- ❑ Inspect vehicles and equipment frequently for and repair leaks promptly. Use drip pans to catch leaks until repairs are made.
- ❑ Clean up spills or leaks immediately and dispose of cleanup materials properly.
- ❑ Do not hose down surfaces where fluids have spilled. Use dry cleanup methods (absorbent materials, cat litter, and/or rags).
- ❑ Sweep up spilled dry materials immediately. Do not try to wash them away with water, or bury them.
- ❑ Clean up spills on dirt areas by digging up and properly disposing of contaminated soil.
- ❑ Report significant spills immediately. You are required by law to report all significant releases of hazardous materials, including oil. To report a spill: 1) Dial 911 or your local emergency response number, 2) Call the Governor's Office of Emergency Services Warning Center, (800) 852-7550 (24 hours).

A black and white line drawing showing four workers in a trench. One worker on the left carries a pipe section. Two workers in the center use a lever to move a pipe into the trench. A fourth worker on the right stands observing. The trench is lined with corrugated metal sheet piling.

- ❑ Schedule grading and excavation work for dry weather only.
- ❑ Stabilize all denuded areas, install and maintain temporary erosion controls (such as erosion control fabric or bonded fiber matrix) until vegetation is established.
- ❑ Seed or plant vegetation for erosion control on slopes or where construction is not immediately planned.

- ☐ Protect storm drain inlets, gutters, ditches, and drainage courses with appropriate BMPs, such as gravel bags, fiber rolls, berms, etc.
- ☐ Prevent sediment from migrating offsite by installing and maintaining sediment controls, such as fiber rolls, silt fences, or sediment basins.
- ☐ Keep excavated soil on the site where it will not collect into the street.
- ☐ Transfer excavated materials to dump trucks on the site, not in the street.
- ☐ Contaminated Soils
 - ☐ If any of the following conditions are observed, test for contamination and contact the Regional Water Quality Control Board:
 - Unusual soil conditions, discoloration, or odor.
 - Abandoned underground tanks.
 - Abandoned wells
 - Buried barrels, debris, or trash.

- ❑ Avoid paving and seal coating in wet weather, or when rain is forecast before fresh pavement will have time to cure.
- ❑ Cover storm drain inlets and manholes when applying seal coat, tack coat, slurry seal, fog seal, etc.
- ❑ Collect and recycle or appropriately dispose of excess abrasive gravel or sand. Do NOT sweep or wash it into gutters.
- ❑ Do not use water to wash down fresh asphalt concrete pavement.

- ❑ Completely cover or barricade storm drain inlets when saw cutting. Use filter fabric, catch basin inlet filters, or gravel bags to keep slurry out of the storm drain system.
- ❑ Shovel, absorb, or vacuum saw-cut slurry and dispose of all waste as soon as you are finished in one location or at the end of each work day (whichever is sooner!).
- ❑ If sawcut slurry enters a catch basin, clean it up immediately.

- ❑ Store concrete, grout and mortar under cover, on pallets and away from drainage areas. These materials must never reach a storm drain.
- ❑ Wash out concrete equipment/trucks offsite or in a contained area, so there is no discharge into the underlying soil or onto surrounding areas. Let concrete harden and dispose of as garbage.
- ❑ Collect the wash water from washing exposed aggregate concrete and remove it for appropriate disposal offsite.

- ❑ Effectively manage all run-on, all runoff within the site, and all runoff that discharges from the site. Divert run-on water from off-site away from all disturbed areas or otherwise ensure compliance.
- ❑ When dewatering, notify and obtain approval from the local municipality before discharging water to a street gutter or storm drain. Filtration or diversion through a basin, tank, or sediment trap may be required.
- ❑ In areas of known contamination, testing is required prior to reuse or discharge of groundwater. Consult with the Engineer to determine whether testing is required and how to interpret results. Contaminated groundwater must be treated or hauled off-site for proper disposal.

- ❑ Never clean brushes or rinse paint containers into a street, gutter, storm drain, or surface waters.
- ❑ For water-based paints, paint out brushes to the extent possible. Rinse to the sanitary sewer once you have gained permission from the local wastewater treatment authority. Never pour paint down a drain.
- ❑ For oil-based paints, paint out brushes to the extent possible and clean with thinner or solvent in a proper container. Filter and reuse thinners and solvents. Dispose of residue and unusable thinner/solvents as hazardous waste.

- ❑ Chemical paint stripping residue and chips and dust from marine paints or paints containing lead or tributyltin must be disposed of as hazardous waste.
- ❑ Paint chips and dust from non-hazardous dry stripping and sand blasting may be swept up or collected in plastic drop cloths and disposed of as trash.

- ❑ Contain stockpiled landscaping materials by storing them under tarps when they are not actively being used.
- ❑ Stack erodible landscape material on pallets. Cover or store these materials when they are not actively being used or applied.
- ❑ Discontinue application of any erodible landscape material within 2 days before a forecast rain event or during wet weather.

Storm drain polluters may be liable for fines of up to \$10,000 per day!

CITIC DESIGN ASSOCIATES INC.
2210 INDUSTRIAL RD. SUITE 205
SAN CARLOS, CALIFORNIA 94070
TEL: (650) 345-9286 EXT. 1001

any part thereof shall be copied, disclosed to others or used in connection with any work or project other than the specified project for which they have been prepared and developed without the written consent of CHU DESIGN ASSOCIATES, INC. Visual contact with these plans or specifications shall constitute conclusive evidence of acceptance to these restrictions.

1385 HILLSIDE CIRCLE LOT 3
BURLINGAME, C.A.
A.P.N.: 000-000-000

| |
|-----------|
| 10/26/21 |
| AS NOTED |
| MC |
| N.1 |
| OF SHEETS |

| | | | |
|---|---------------|---|-----------|
| A | 18'-0"x8'-6" | = | 153.00 SF |
| B | 3'-0"x7'-0" | = | 21.00 SF |
| C | 27'-0"x24'-6" | = | 661.50 SF |
| D | 12'-6"x8'-0" | = | 100.00 SF |
| E | 51'-0"x17'-0" | = | 867.00 SF |

(PORCH) 78.50 SF < 200 SF = 0 SF

LOWER FLR FLOOR AREA:

| | | | |
|---|--------------------------------------|---|-------------|
| A | $27^{\circ}-6''\times40^{\circ}-0''$ | = | 1,100.00 SF |
| B | $10^{\circ}-0''\times2^{\circ}-6''$ | = | 25.00 SF |
| C | $12^{\circ}-0''\times8^{\circ}-6''$ | = | 102.00 SF |
| D | $20^{\circ}-6''\times14^{\circ}-0''$ | = | 287.00 SF |
| E | $8^{\circ}-0''\times13^{\circ}-0''$ | = | 104.00 SF |
| F | $18^{\circ}-0''\times5^{\circ}-0''$ | = | 90.00 SF |


GARAGE:

$$G \mid 21' - \emptyset'' \times 21' - \emptyset'' = 441.00 \text{ SF}$$

TOTAL GARAGE AREA: = 441.00 SF

| | | |
|-------------------|---|-------------|
| MAIN FLR AREA: | + | 1,802.50 SF |
| LOWER FLOOR AREA: | + | 1,708.00 SF |
| GARAGE: | | 441.50 SF |


3,951.50 SF

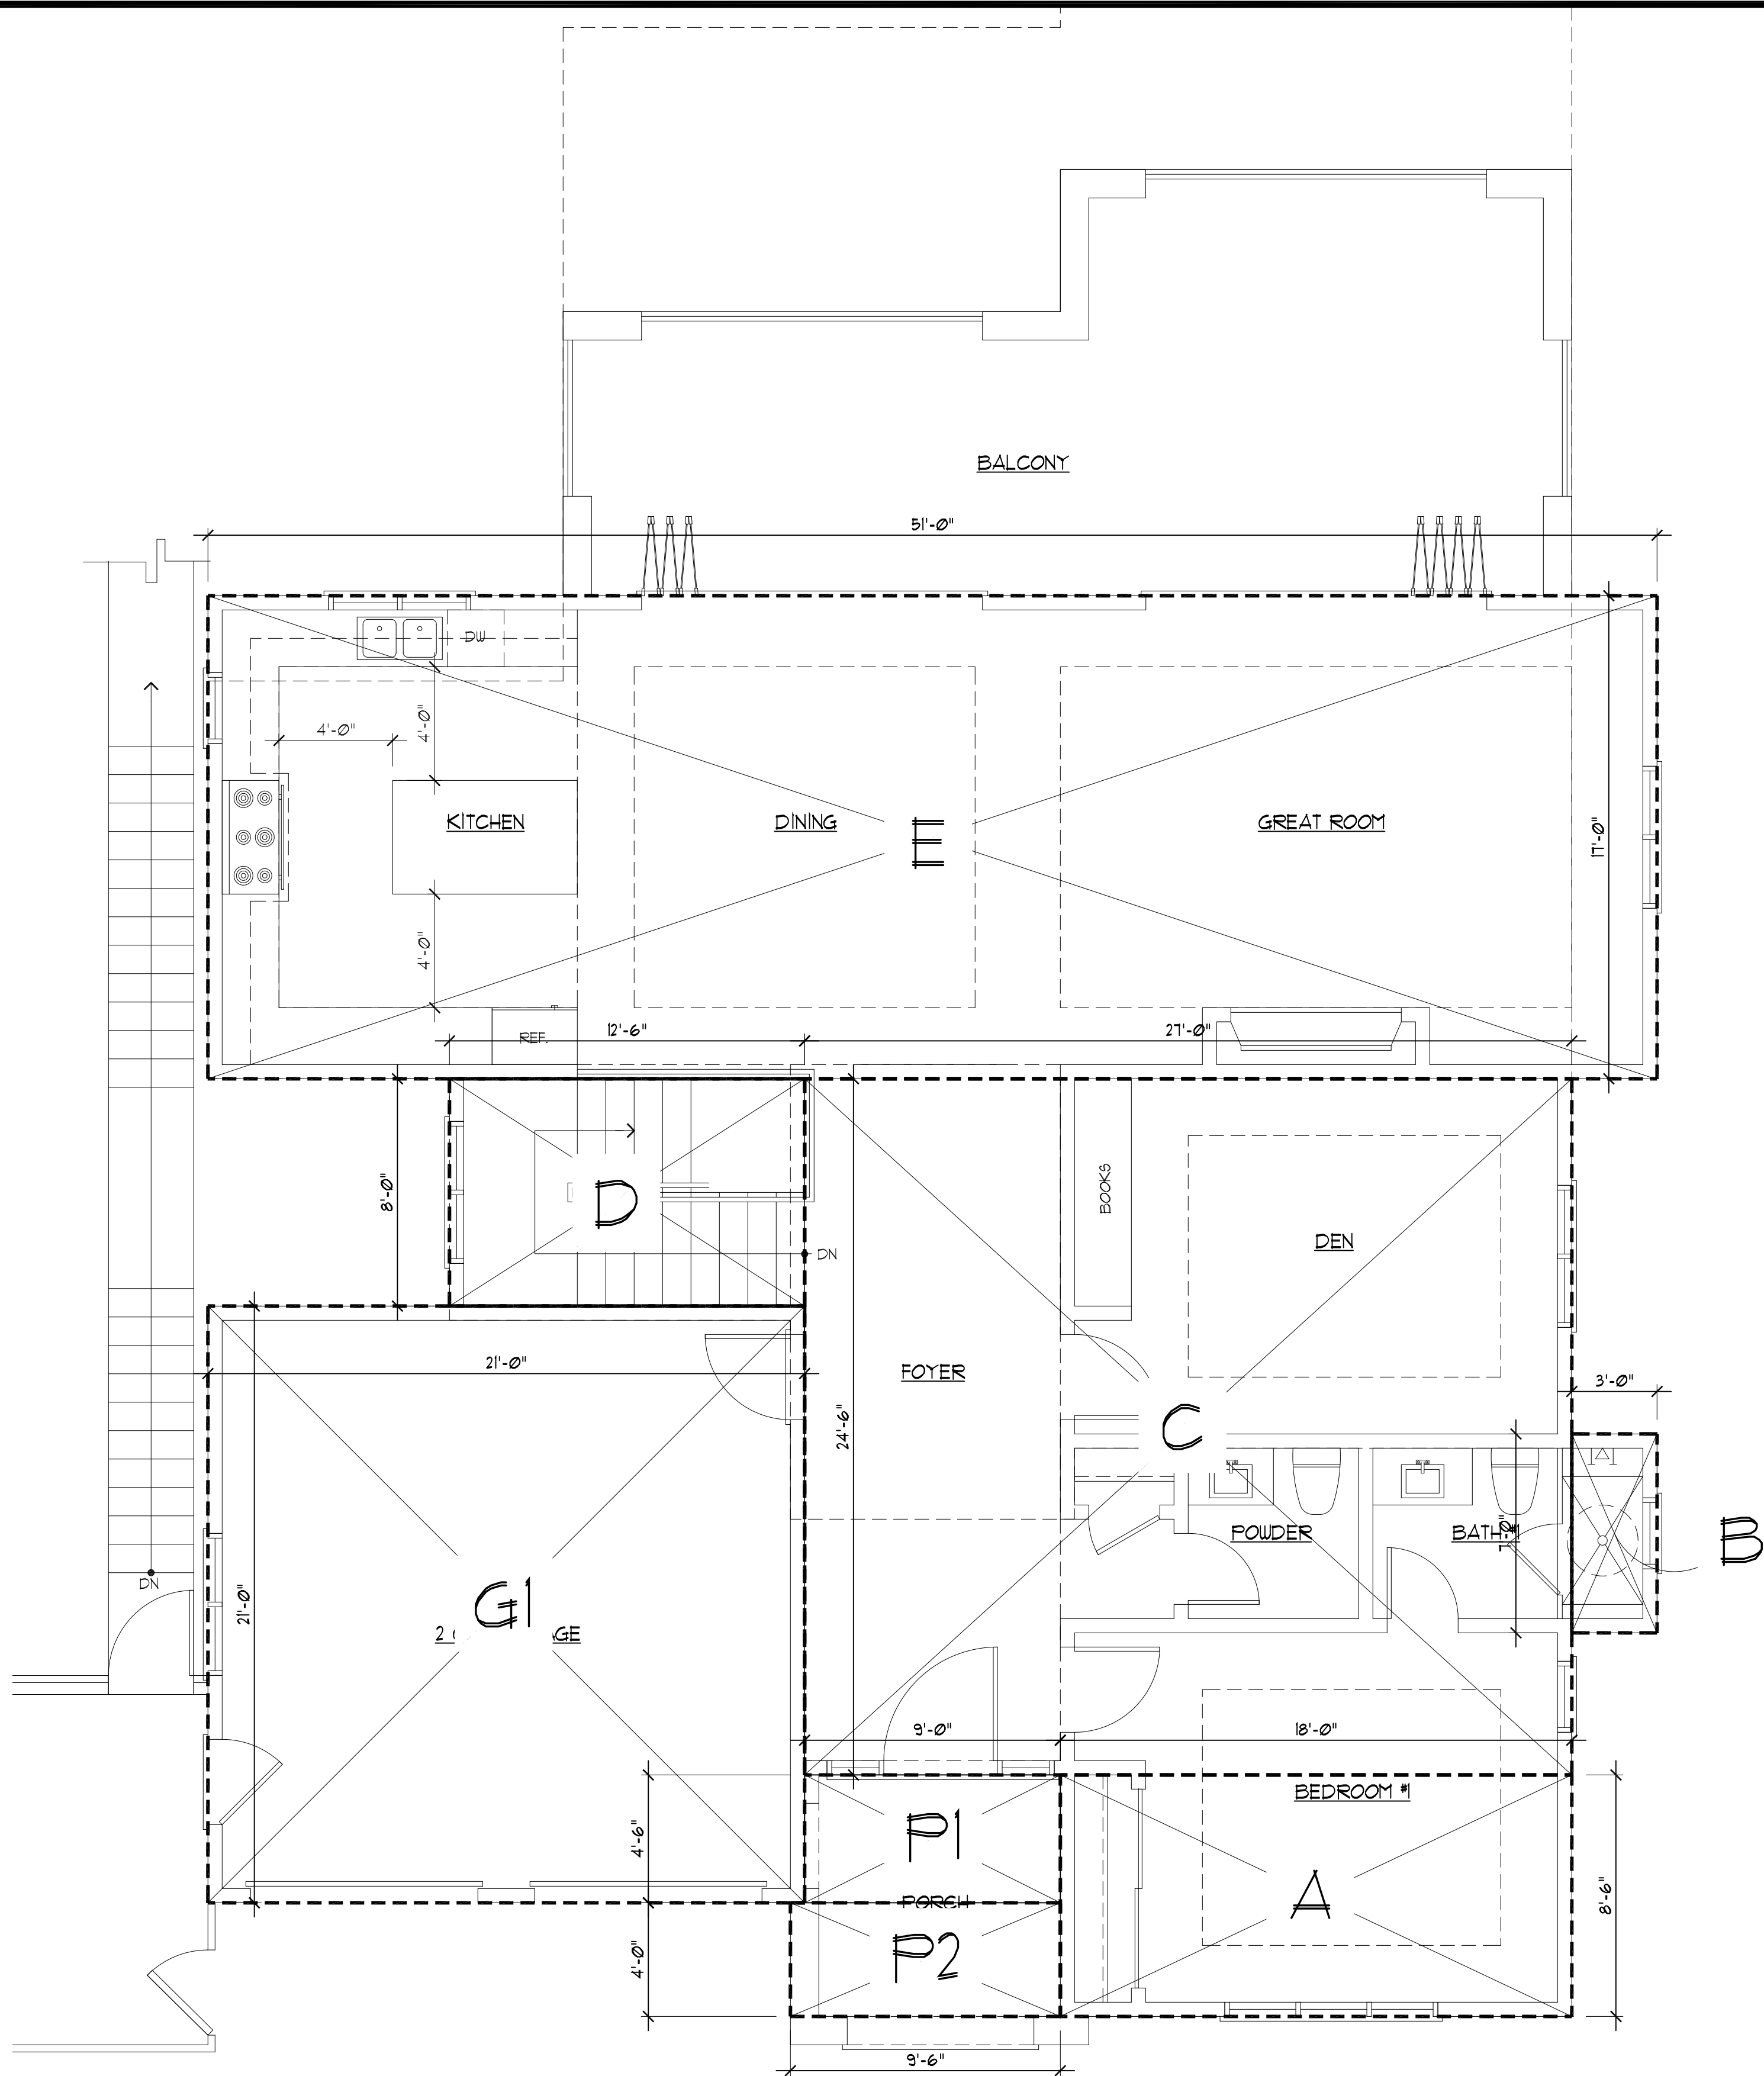

SCALE: 1/4"=1'-0"

[illegible]

CHU DESIGN ASSOCIATES INC.
210 INDUSTRIAL RD. SUITE 205
SAN CARLOS, CALIFORNIA 94070
TEL: (650) 345-9286 EXT. 1001

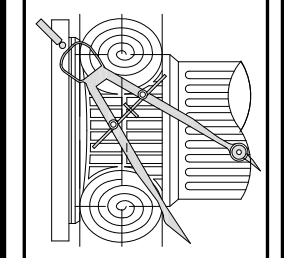

The drawing on this sheet, specification ideas, designs, and arrangements represented thereby are and shall remain the property of CHU DESIGN ASSOCIATES, INC.; and in no part thereof shall be copied, disclosed to others or used in connection with any work or project other than the specified project for which they have been prepared and developed without the written consent of CHU DESIGN ASSOCIATES, INC. Visual contact with these plans or specifications shall constitute conclusive evidence of acceptance by these restrictions.

NEW RESIDENCE
1385 HILLSIDE CIRCLE LOT 3
BURLINGAME, C.A.
A.P.N.: 000-000-000

| | |
|-----------|----------|
| DATE: | 10/26/21 |
| SCALE: | AS NOTED |
| DRAWN: | MC |
| JOB: | |
| SHEET NO. | |

AC.1

| | | | |
|---|-----------------|---|-----------|
| A | 18'-0" x 8'-6" | = | 153.00 SF |
| B | 3'-0" x 7'-0" | = | 21.00 SF |
| C | 27'-0" x 24'-6" | = | 661.50 SF |
| D | 12'-6" x 8'-0" | = | 100.00 SF |
| E | 51'-0" x 17'-0" | = | 867.00 SF |

(PORCH) 78.50 SF < 200 SF = 0 SF

LOWER FLR FLOOR AREA:

TOTAL LOWER FLR AREA: = 1,708.00 SF

$$G \mid 21' - \emptyset'' \times 21' - \emptyset'' = 441.00 \text{ SF}$$

| | |
|-------------------|-------------|
| MAIN FLR AREA: | 1,802.50 SF |
| LOWER FLOOR AREA: | 1,708.00 SF |
| GARAGE: | 441.50 SF |


3,951.50 SF



SCALE: 1/4"=1'-0"

[illegible]

CHU DESIGN ASSOCIATES INC.
210 INDUSTRIAL RD. SUITE 205
SAN CARLOS, CALIFORNIA 94070
TEL: (650) 345-9286 EXT. 1001

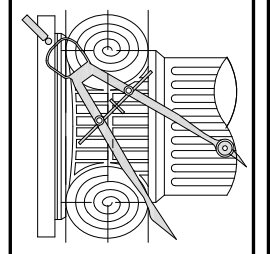


The drawing on this sheet, specification ideas, designs, and arrangements represented hereby are and shall remain the property of CHU DESIGN ASSOCIATES, INC.; and no part thereof shall be copied, disclosed to others or used in connection with any project other than the specified project for which they have been prepared and developed without the written consent of CHU DESIGN ASSOCIATES, INC. Visual contact with these plans or specifications shall constitute conclusive evidence of acceptance to these restrictions.

NEW RESIDENCE
1385 HILLSIDE CIRCLE LOT 3
BURLINGAME, C.A.
A.P.N.: 000-000-000


| | |
|-----------|----------|
| DATE: | 10/26/21 |
| SCALE: | AS NOTED |
| DRAWN: | MC |
| JOB: | |
| SHEET NO. | |

AC.2

OF SHEETS

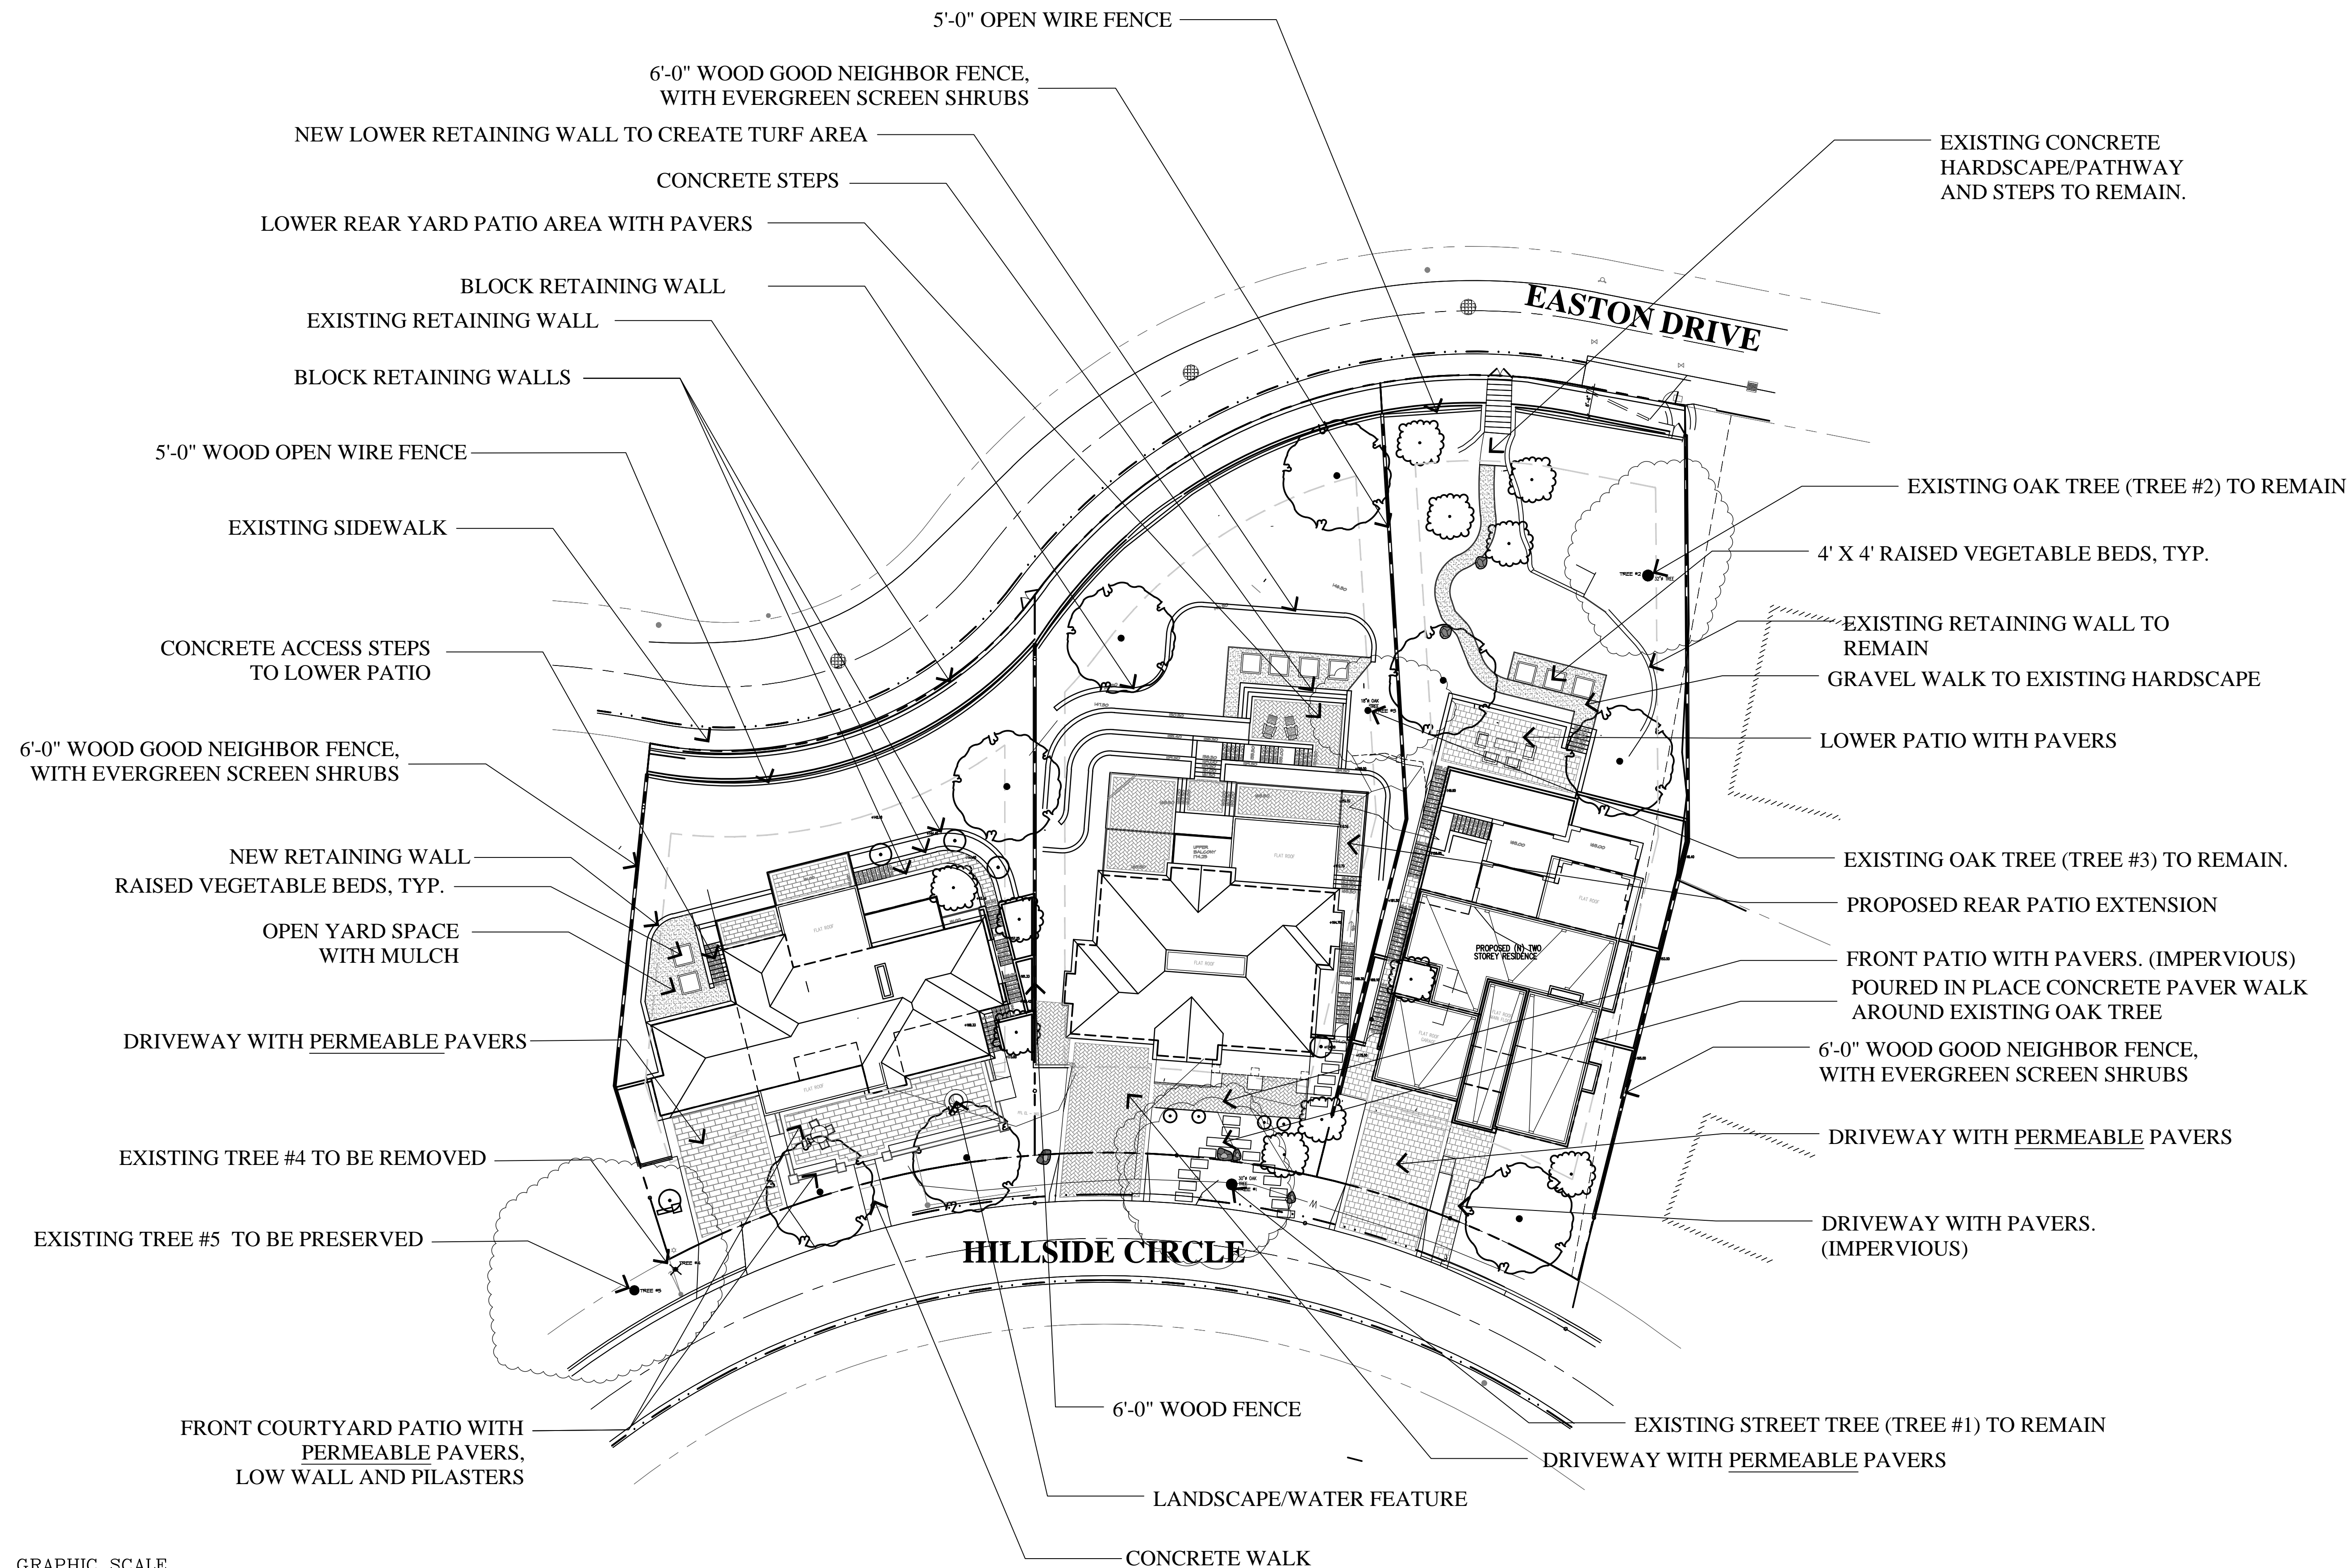

GRAPHIC SCALE
0 20 40 60
(IN FEET)
1 inch = 20 ft.

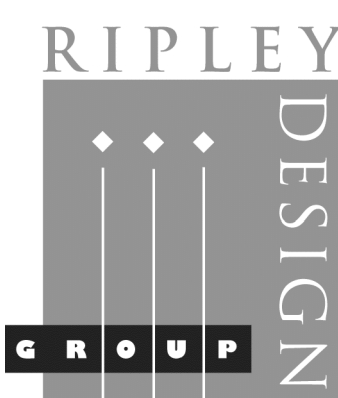

LANDSCAPE ARCHITECTURE
LAND PLANNING
1615 BONANZA STREET
SUITE 314
WALNUT CREEK, CA 94596
TEL: 925.938.7377
FAX: 925.938.7436




1385 Hillside Circle
Burlingame, California

Preliminary Landscape Plan


May 2025

L1

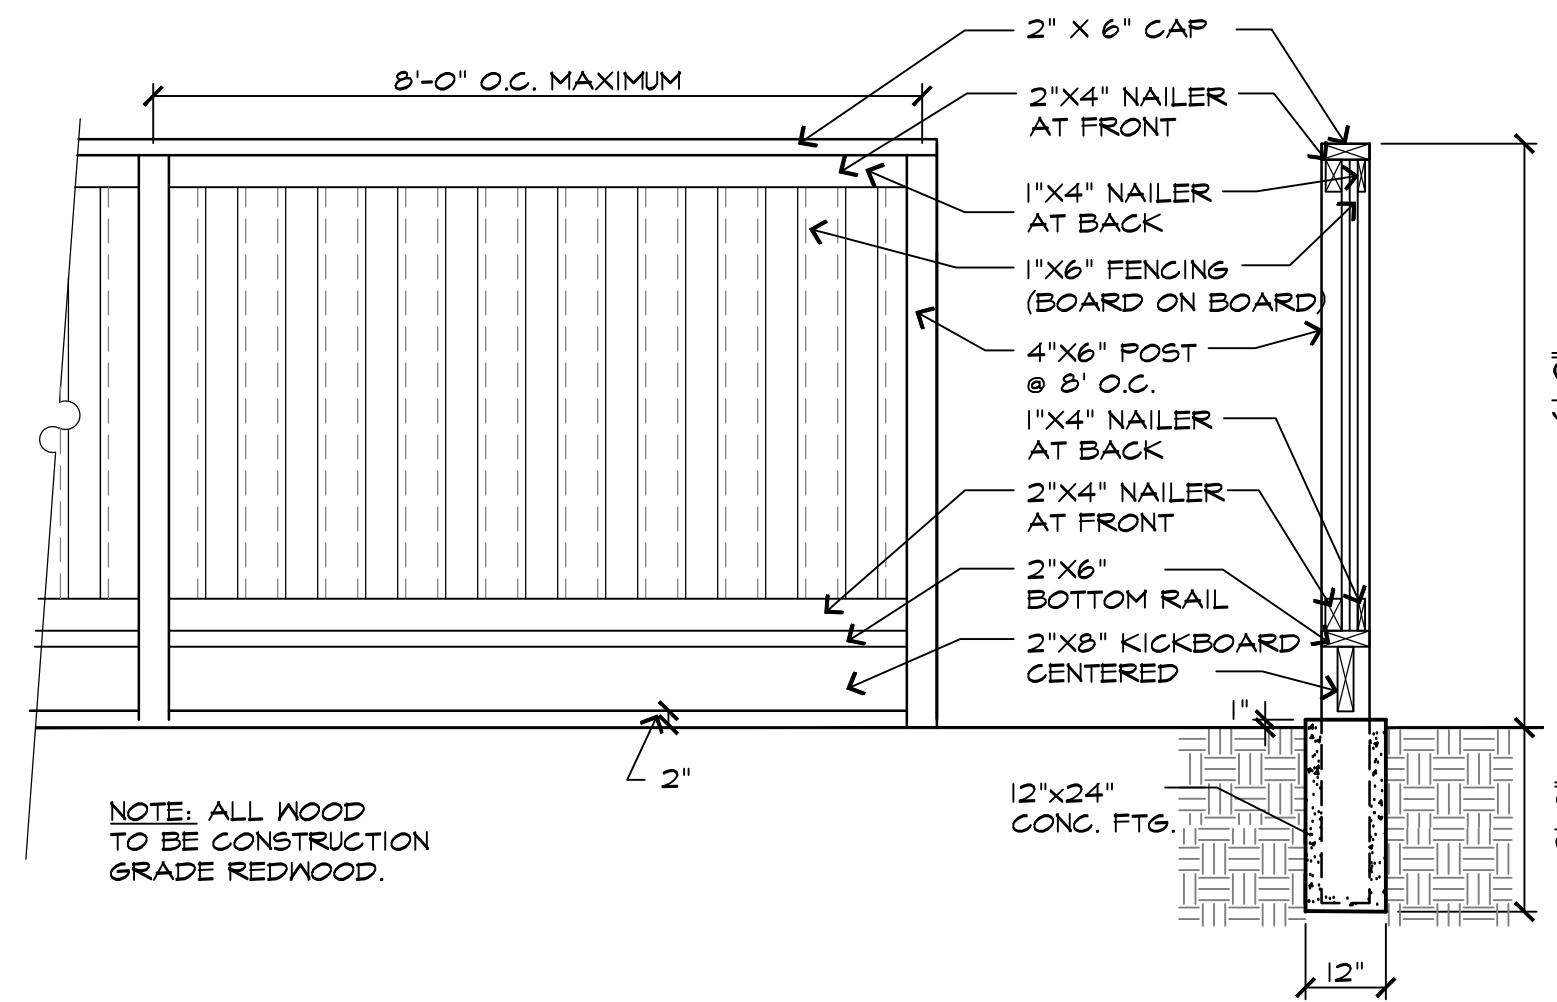

WOOD FENCE W/KICKERBOARD SCALE: 1/2" = 1'-0"


024 - FrieRur

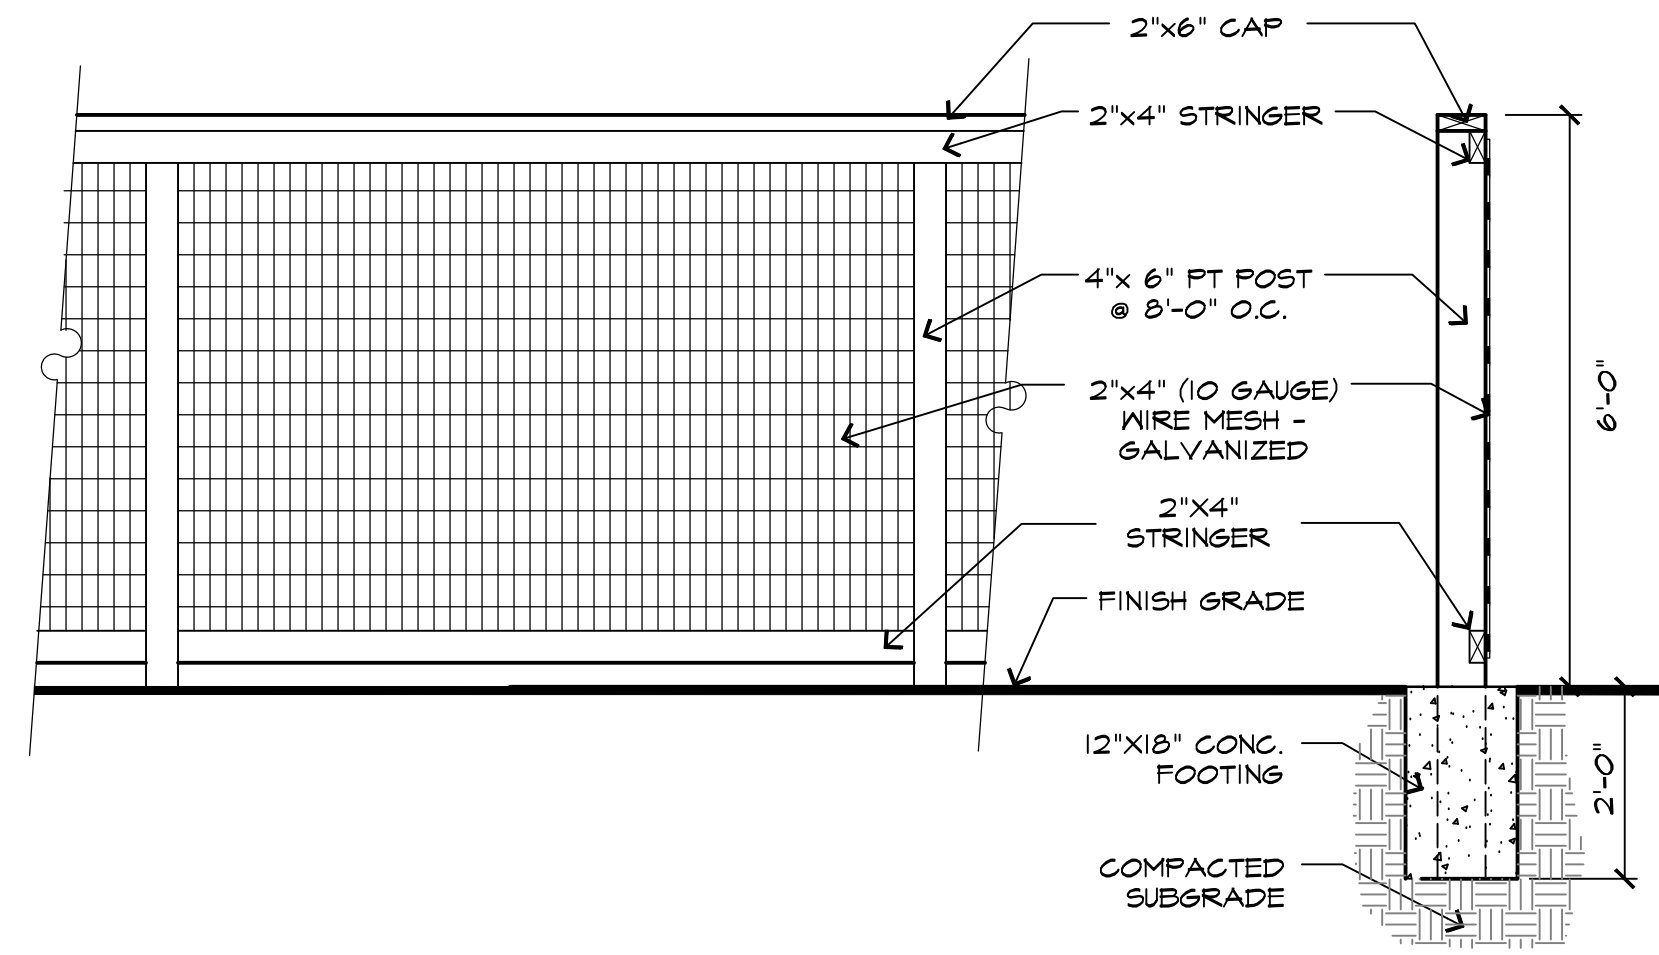

OPEN WIRE FENCE

SCALE: NTS


092 - FrieRur

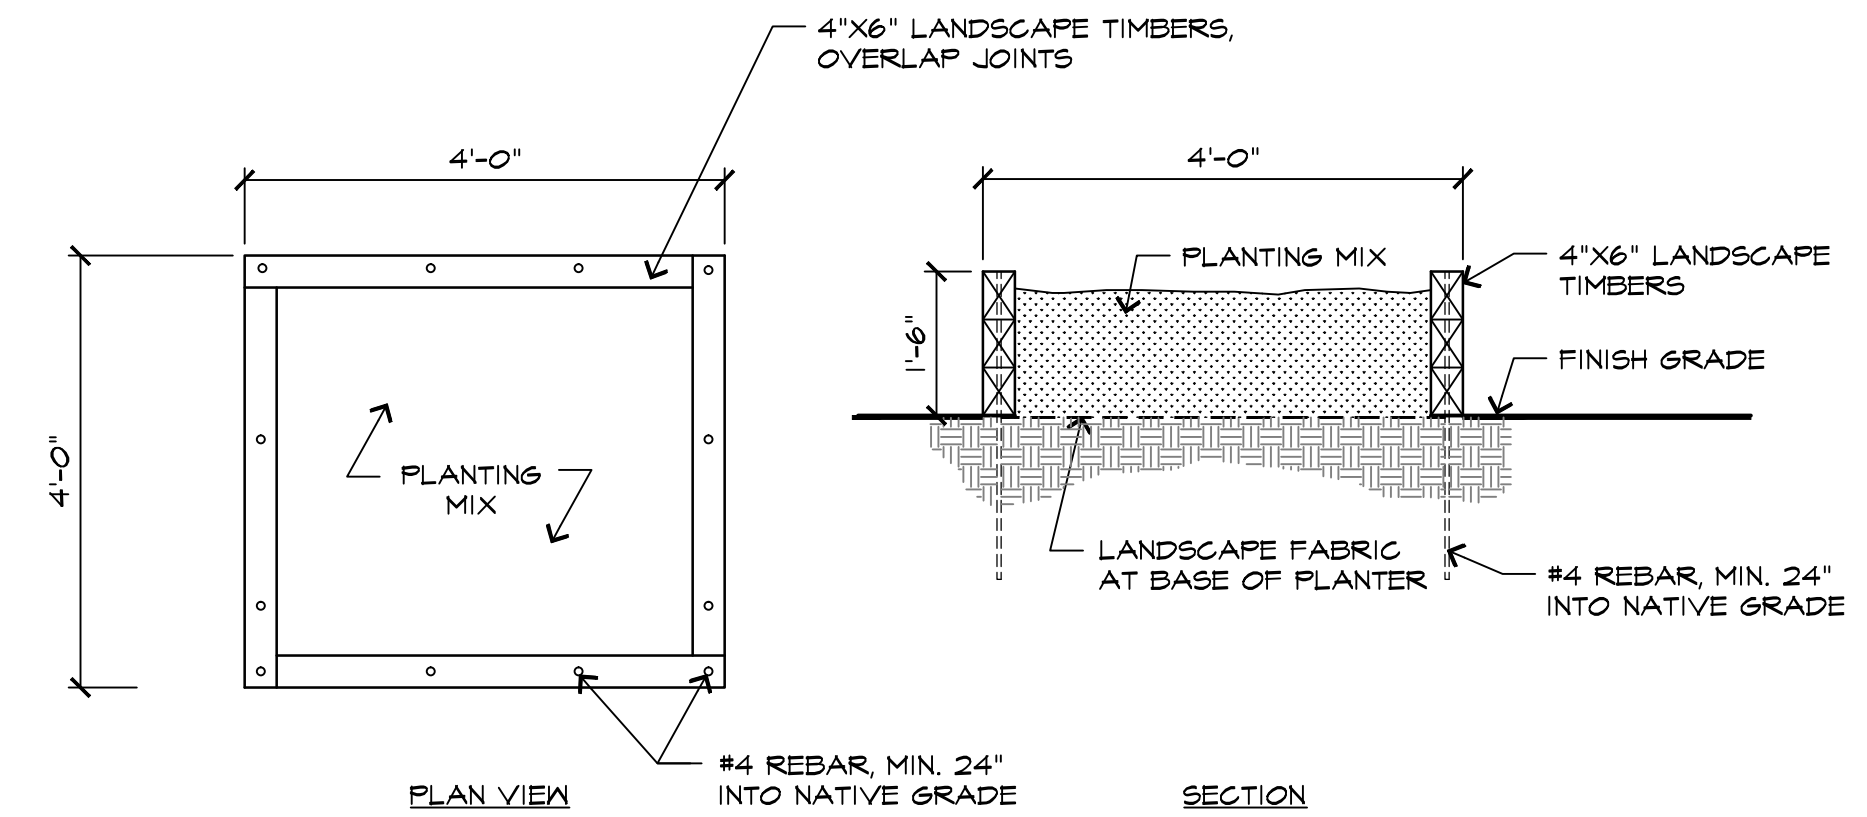

RAISED PLANTER

SCALE: 1/2" = 1'-0"


024 - FrieRur

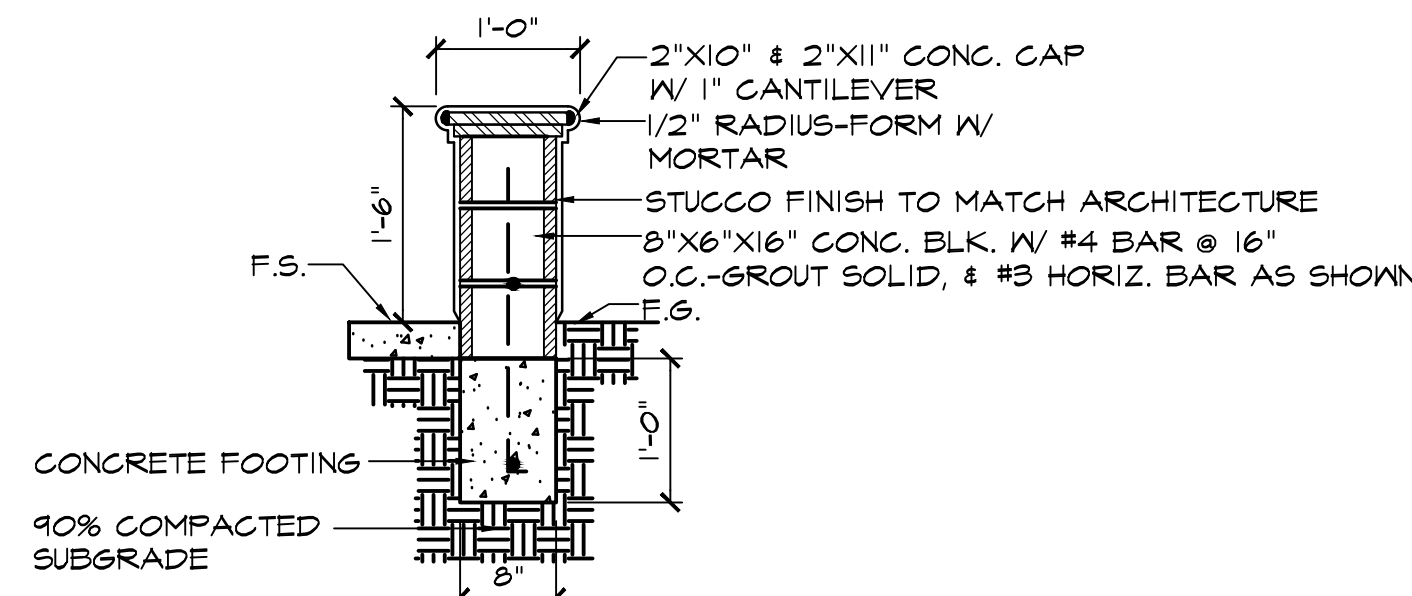

18" STUCCO WALL

SCALE: 3/4" = 1'-0"


016 - XXXXX

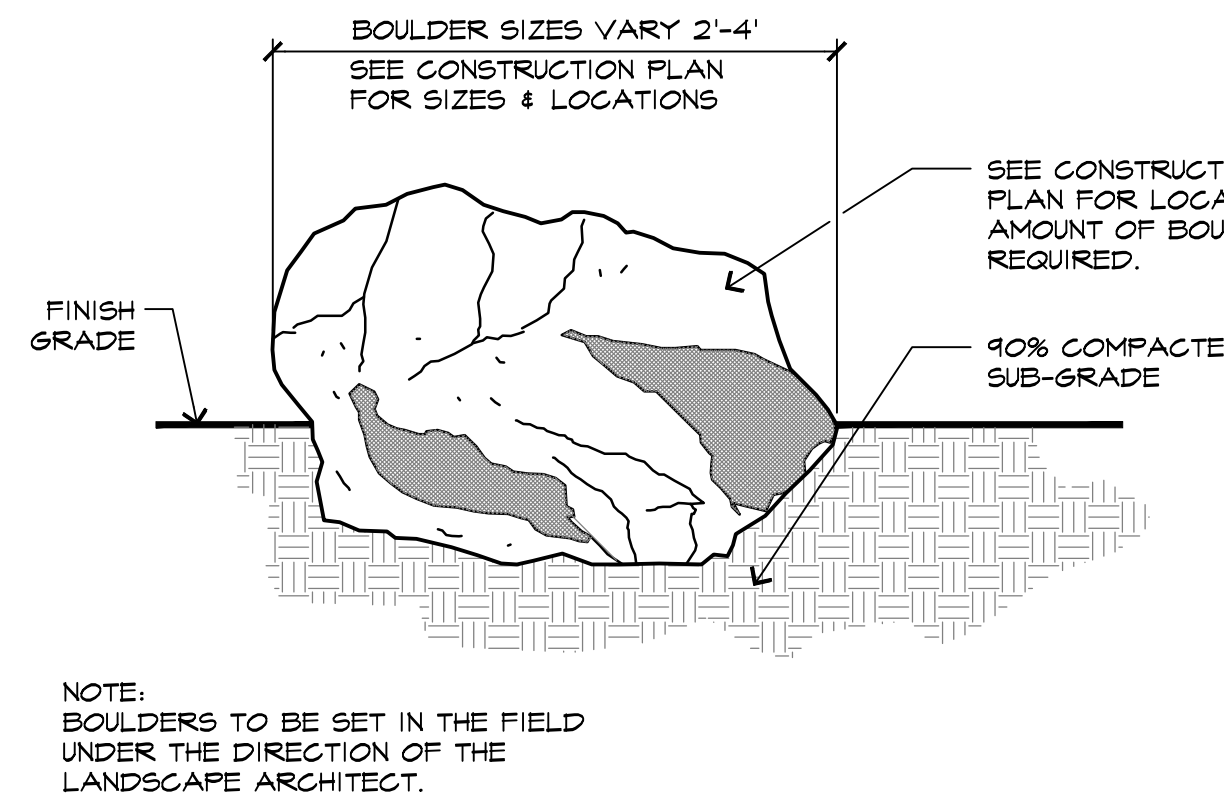

BOULDER INSET FINISHED GRADE

NTS


008 - Bld

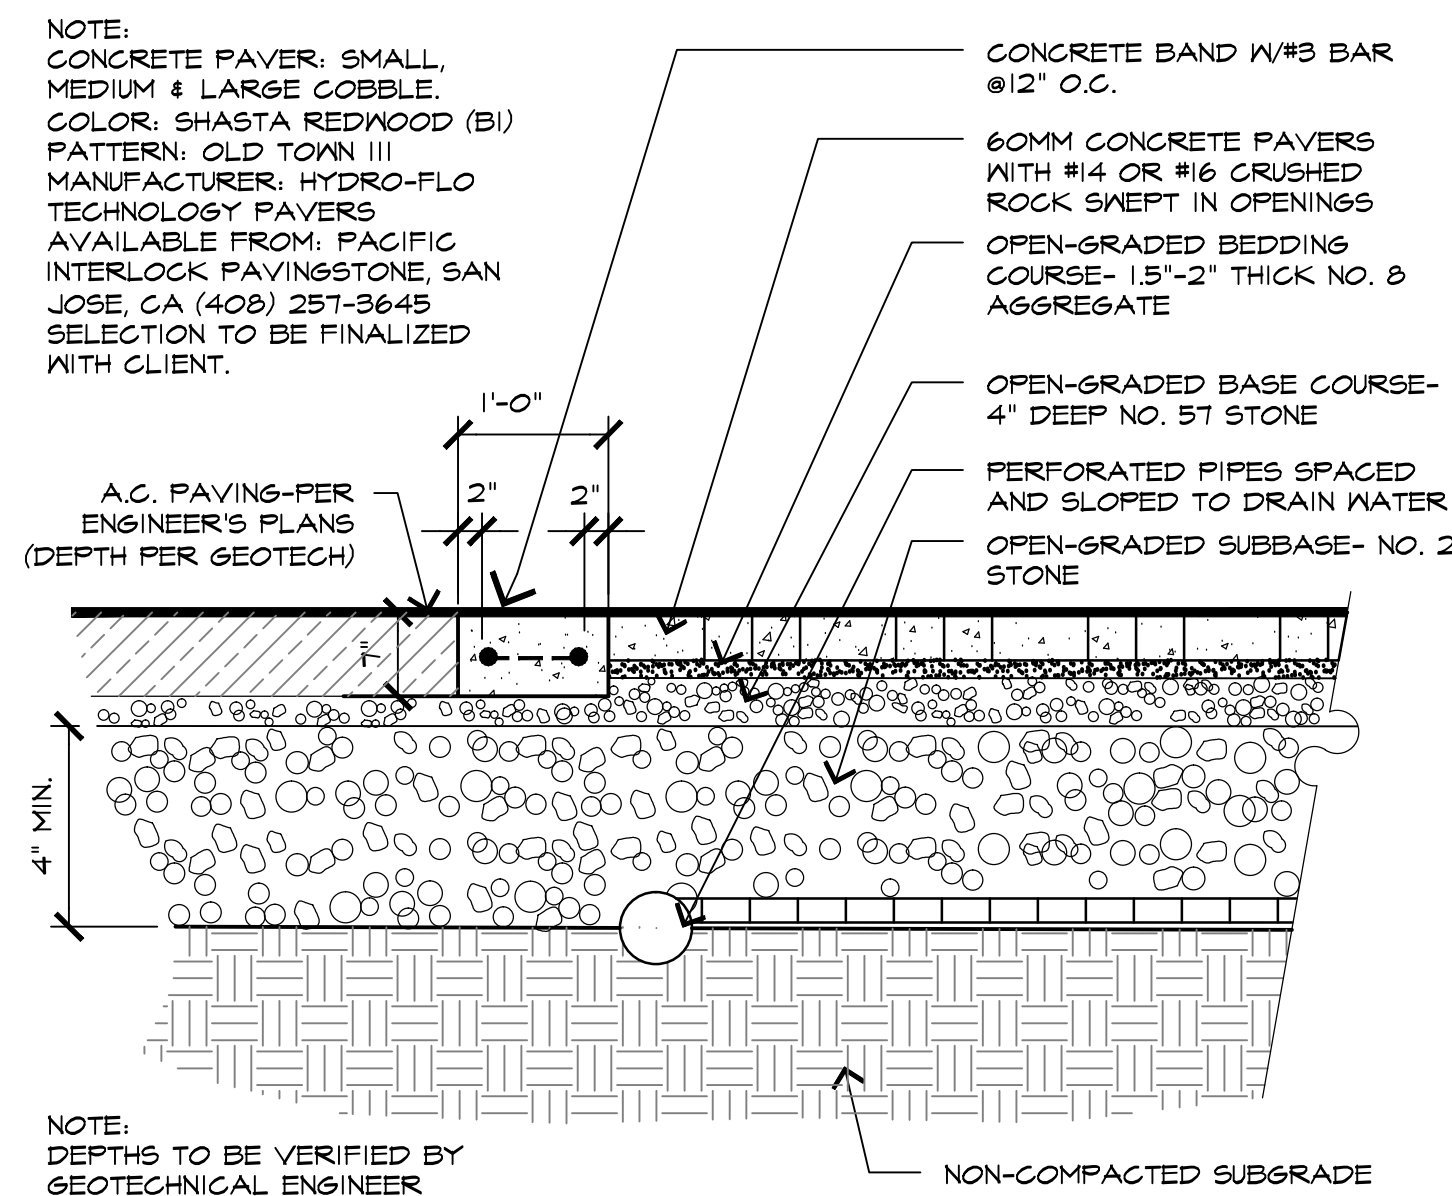

PERMEABLE PEDESTRIAN WALK

SCALE: 3/4" = 1'-0"


016 - PVPrecast

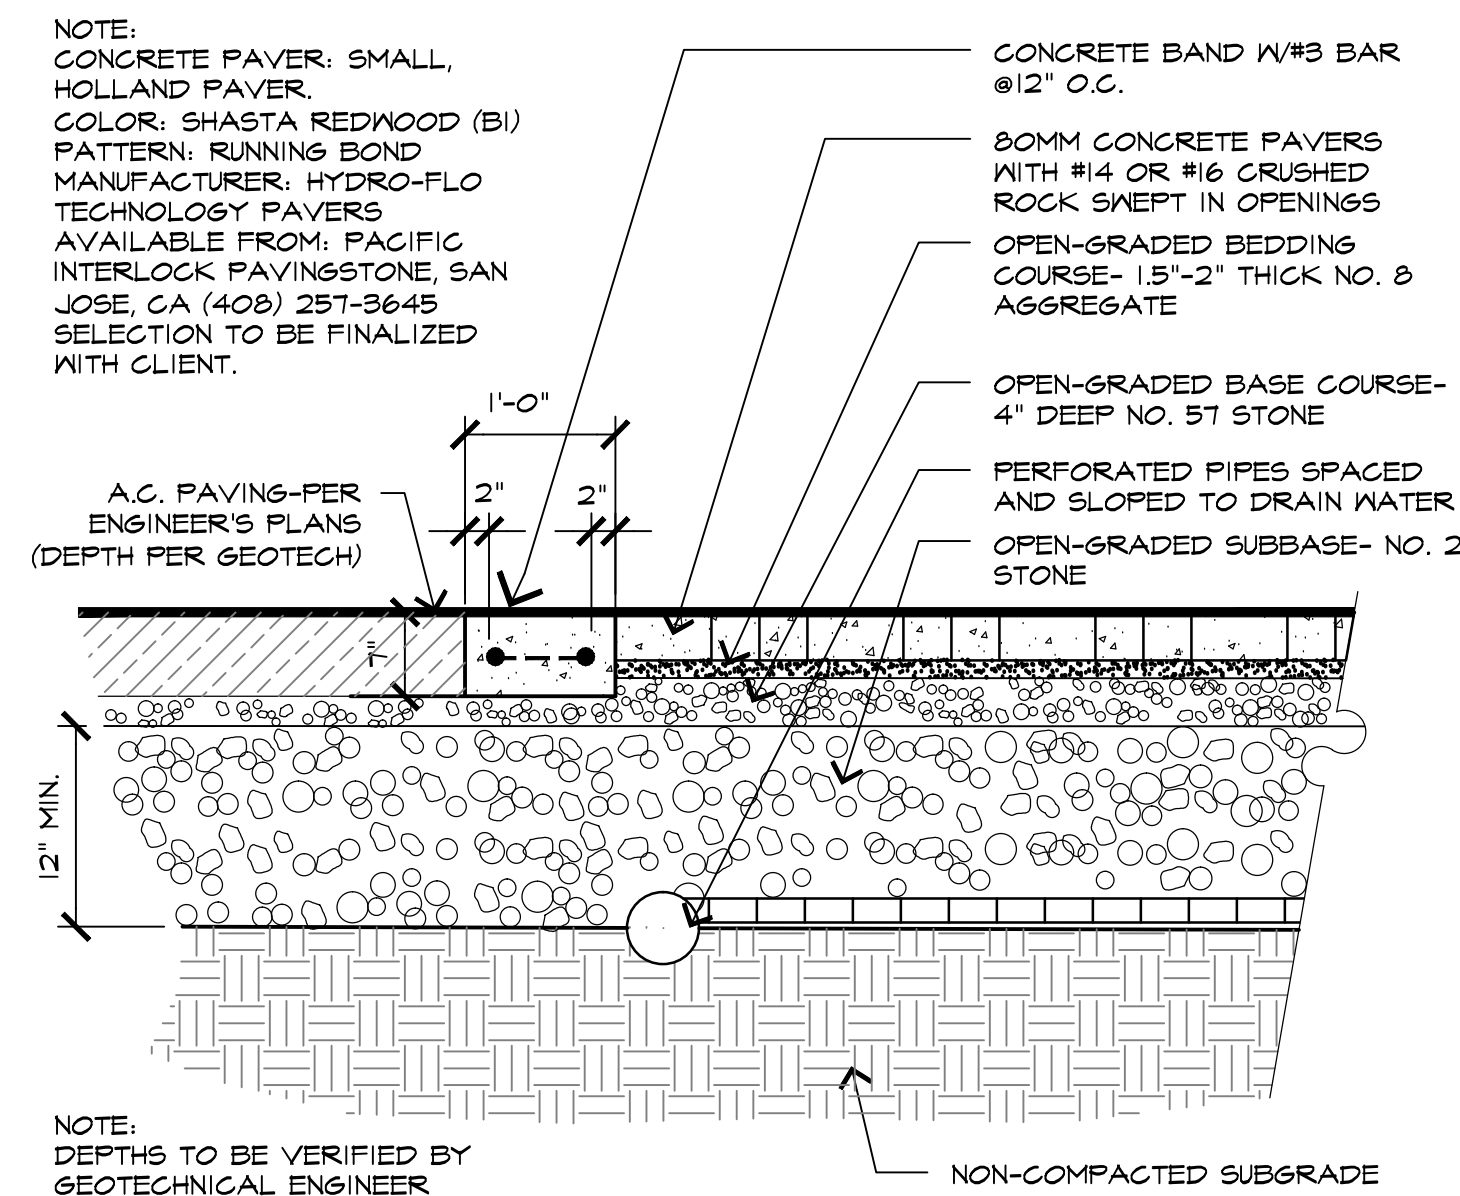

PERMEABLE VEHICULAR PAVING

SCALE: 3/4" = 1'-0"


016 - PVPrecast

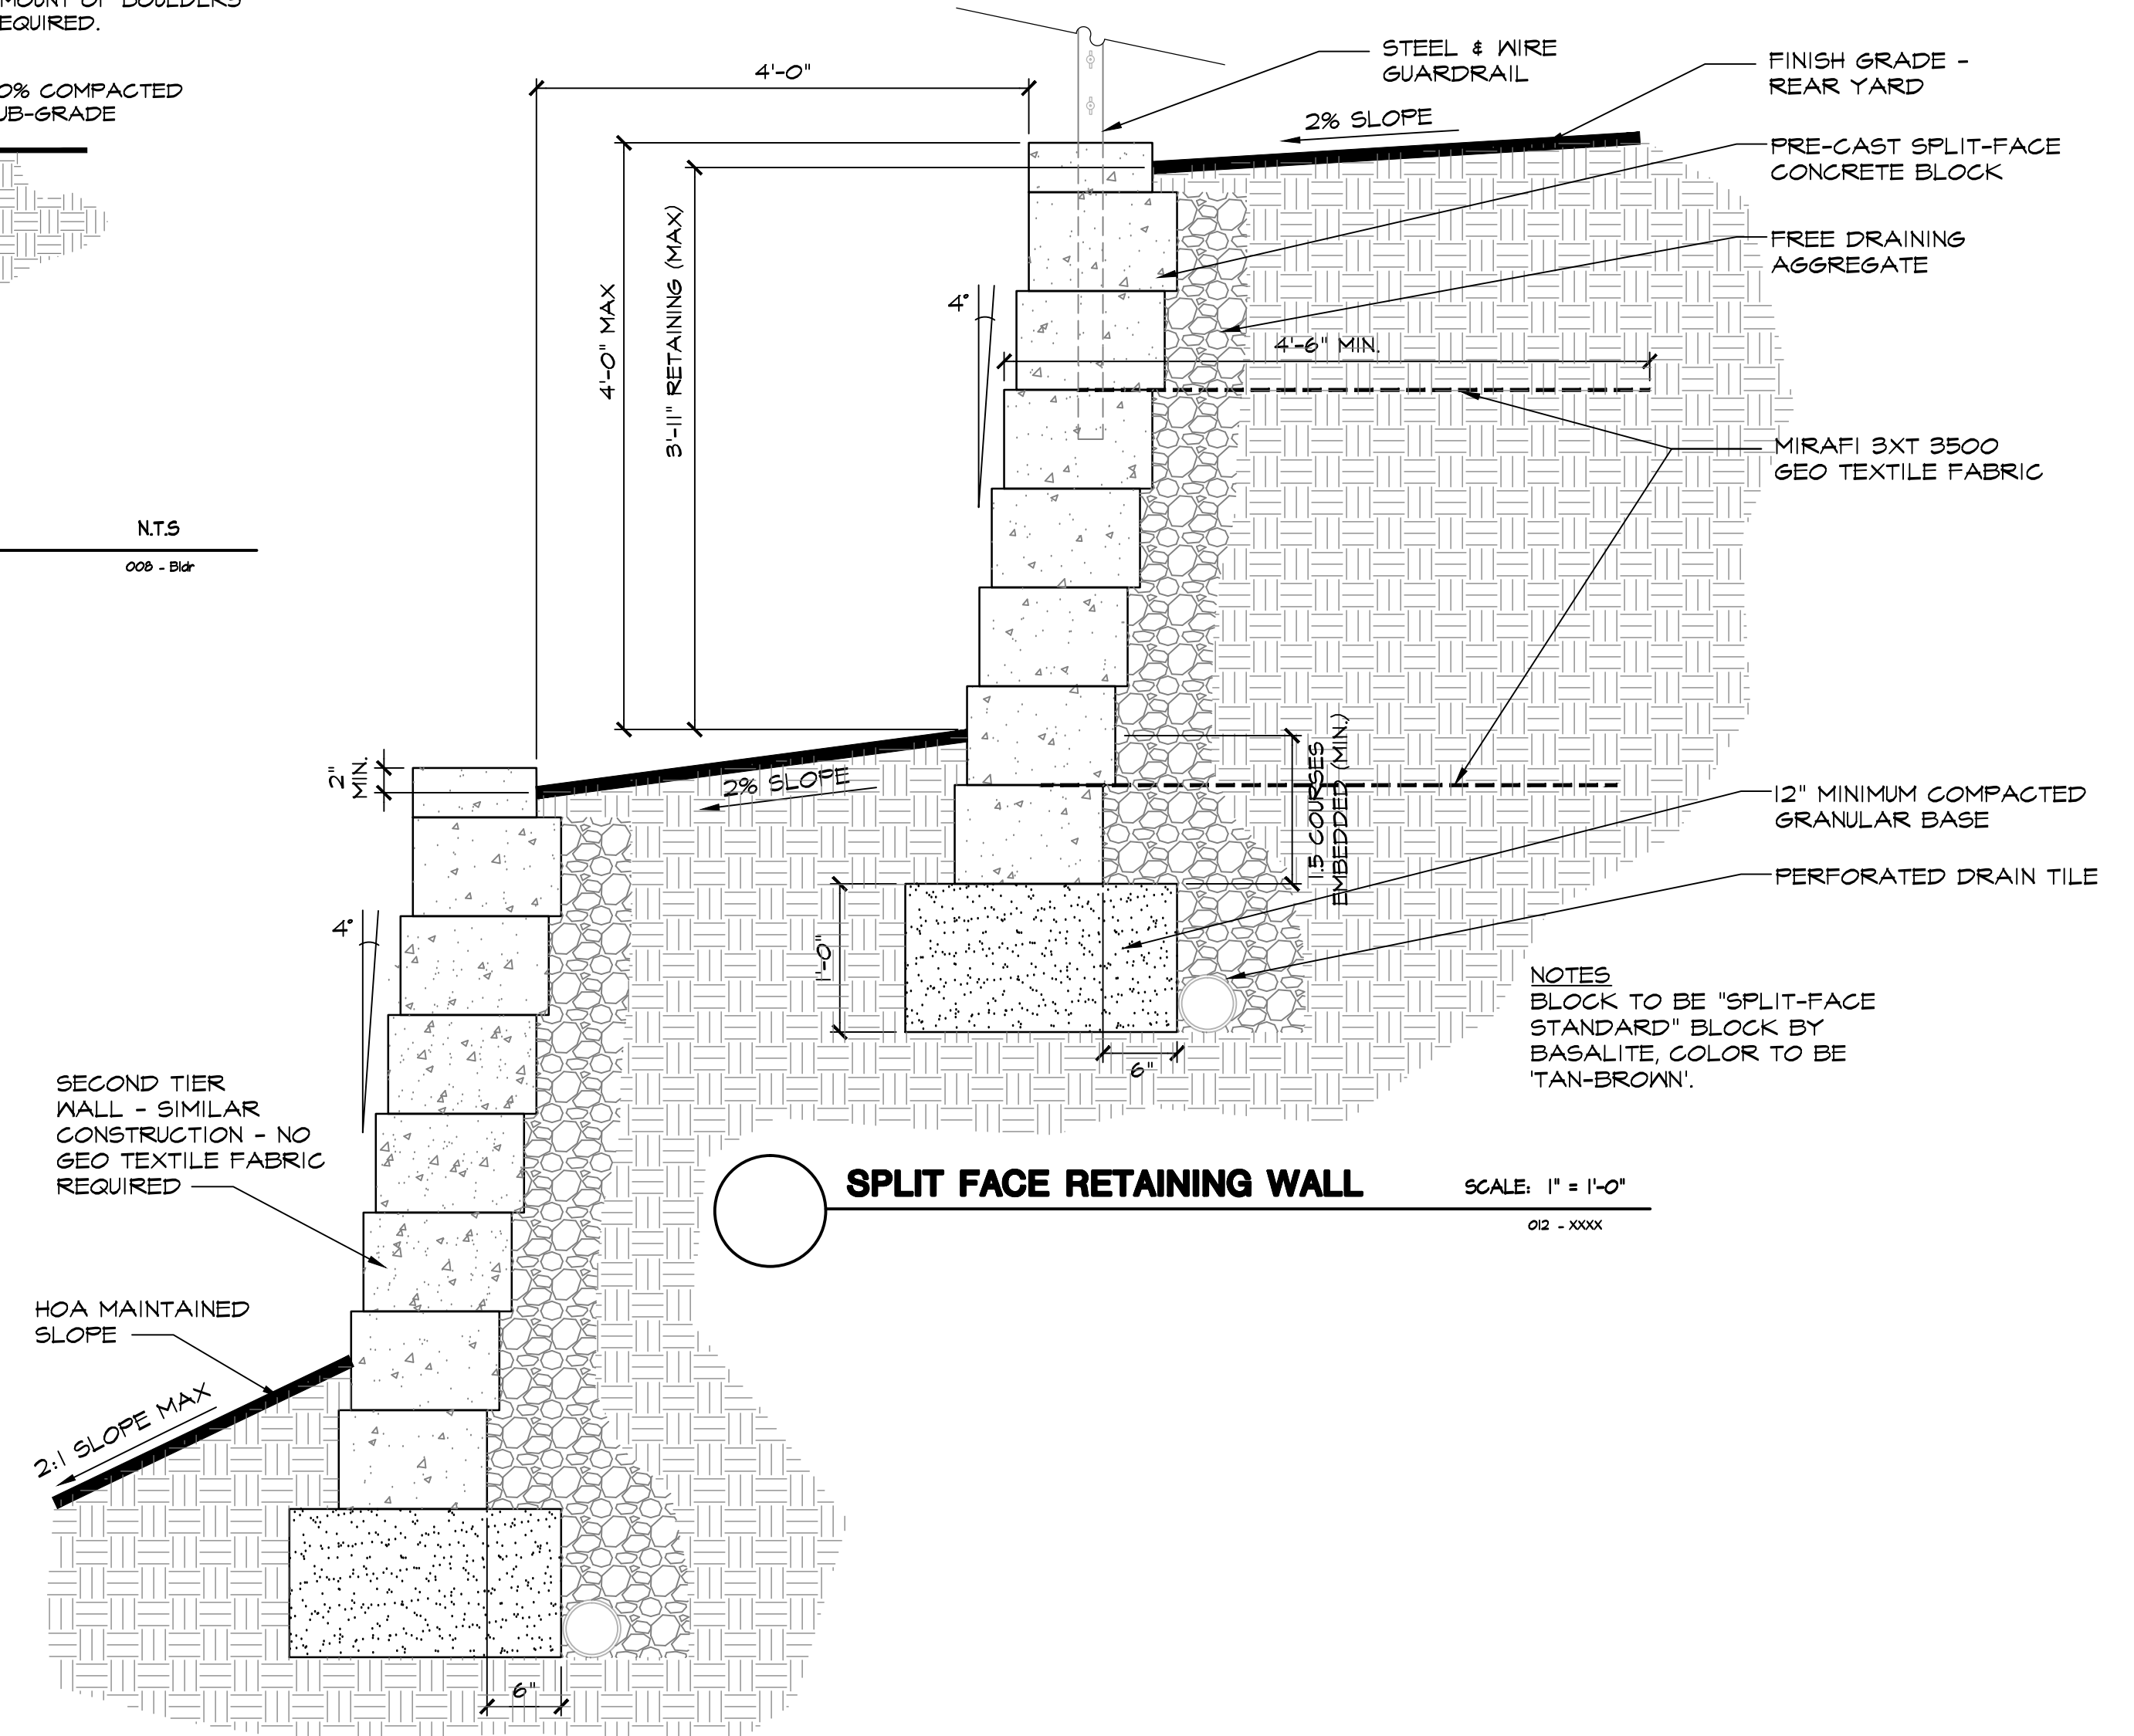

SPLIT FACE RETAINING WALL

SCALE: 1" = 1'-0"

02 - XXXX

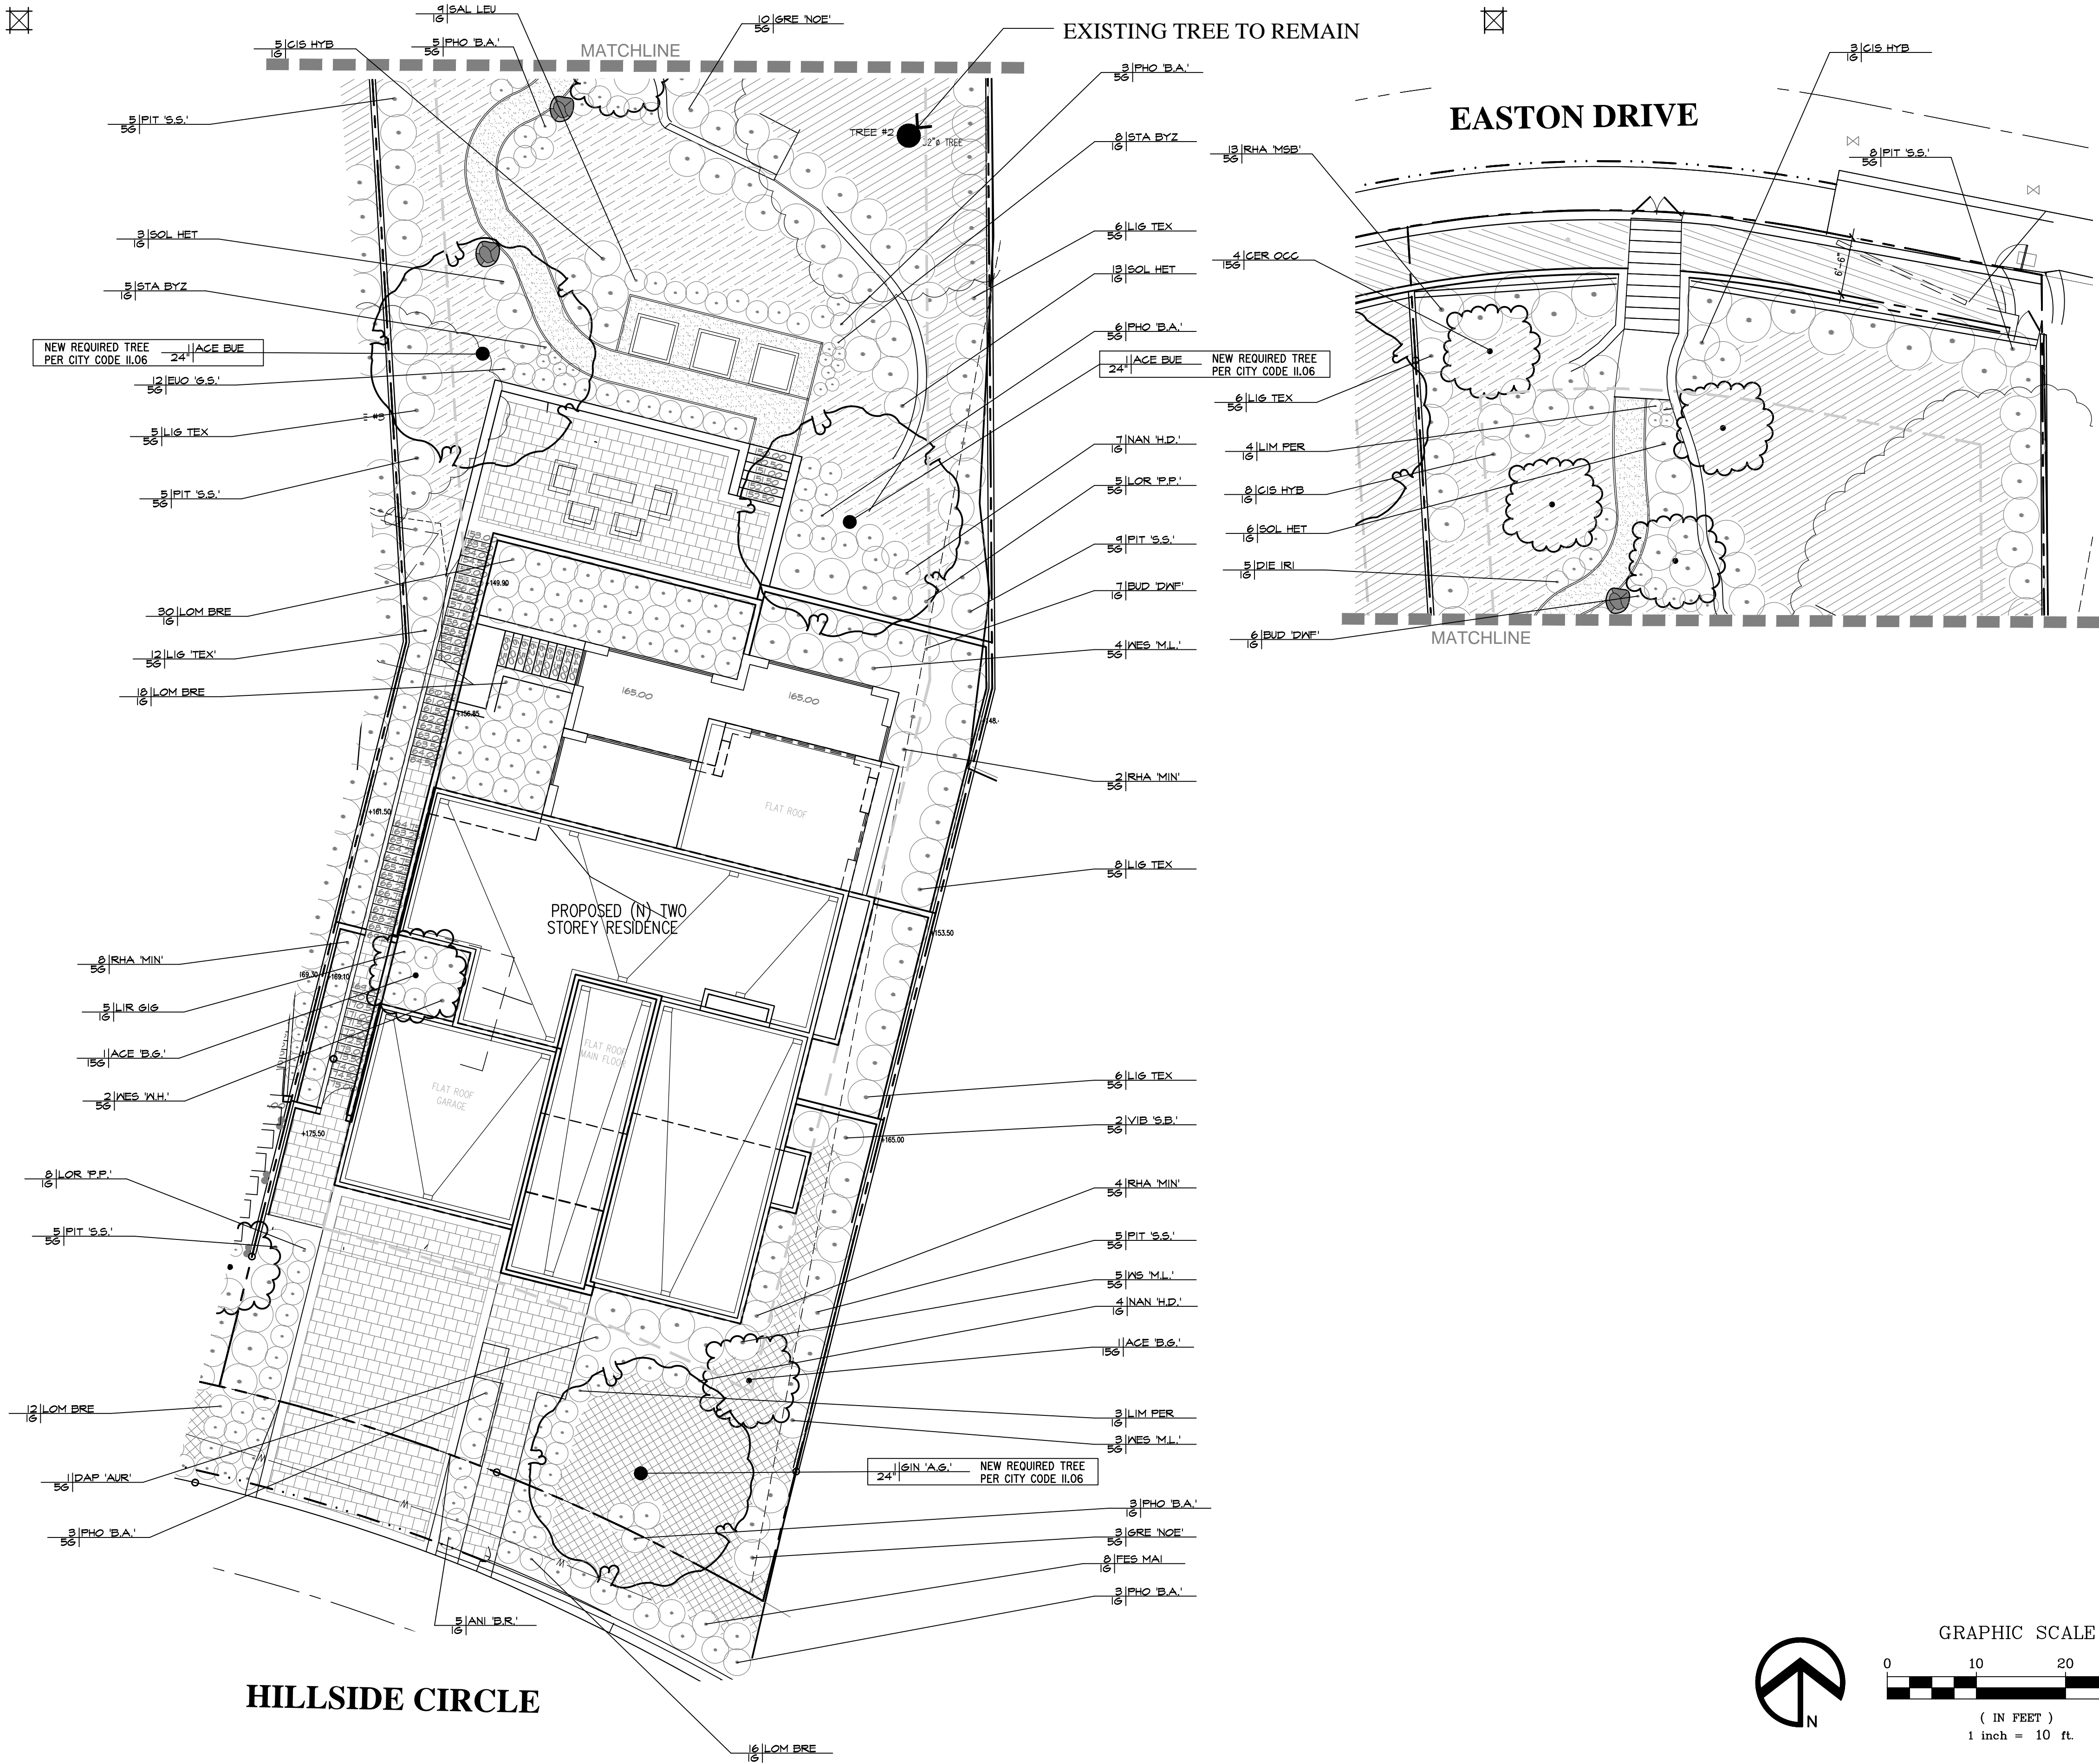


PROPOSED PLANT PALETTE

| SYMBOL | BOTANICAL NAME | COMMON NAME | SIZE | WATER USE |
|-------------------------|-------------------------------------|--------------------------|-----------|-----------|
| TREES | | | | |
| ACE BUE | ACER BUERGERIANUM | TRIDENT MAPLE | 24" BOX | LOW |
| ACE 'B.G.' | ACER PALMATUM 'BLOOD GOOD' | JAPANESE MAPLE | 15 GALLON | LOW |
| ARB 'MAR' | ABRUTUS 'MARINA' | MARINA MADRONE | 24" BOX | LOW |
| BUD 'B.K.' | CERCIS OCCIDENTALIS | WESTERN REDBUD | 15 GALLON | LOW |
| CER OCC | CERCIS OCCIDENTALIS | MADENHAIR TREE | 24" BOX | LOW |
| GIN 'P.S.' | GINKGO B. 'PRINCETON SENTRY' | LAGERSTROEMIA INDICA | 15 GALLON | LOW |
| LAS IND | LAGERSTROEMIA INDICA | CRAPPE MYRTLE | 24" BOX | LOW |
| OLE 'S.H.' | OLEA EUROPAEA 'SWAN HILL' | FRUITLESS OLIVE | 24" BOX | LOW |
| PYR KAW | PYRUS KAWAKAMI | EVERGREEN PEAR | 24" BOX | MEDIUM |
| SHRUBS | | | | |
| ABU 'HYB' | ABUTILON 'HYBRID' | FLOWERING MAPLE | 5 GALLON | LOW |
| ANI 'B.R.' | ANIGOSANTHOS 'BUSH RANGER' | KANGAROO PAW | 1 GALLON | LOW |
| ARC 'H.M.' | ARCTOSTAPHYLOS 'HOWARD MCINN' | MANZANITA | 5 GALLON | LOW |
| BUD 'B.K.' | BUDDEJA DAVIDI 'BLACK KNIGHT' | BUTTERFLY BUSH | 5 GALLON | LOW |
| BUD 'DW' | BUDDEJA DAVIDI 'LOW AND BEHOLD' | DWARF BUTTERFLY BUSH | 1 GALLON | LOW |
| CHO TEC | CHONDRPETALUM TECTORUM | DWARF CAPE RUSH | 5 GALLON | LOW |
| CIS HYB | CISTUS HYBRIDUS | ROCKROSE | 5 GALLON | LOW |
| DAP 'AUR' | DAPHNE O. 'AUREOMARGINATA' | WINTER FLOWERING DAPHNE | 5 GALLON | LOW |
| DIE BIC | DIETES BICOLOR | FORTNIGHT LILY | 1 GALLON | LOW |
| DIE IRI | DIETES IRIDIODES | FORTNIGHT LILY | 1 GALLON | LOW |
| ERI KAR | ERIGERON KARVINSKIANUS | SANTA BARBARA DAISY | 1 GALLON | LOW |
| ERY 'B.M.' | ERYSIMUM 'BOWLES MAUVE' | MAUVE CLUSTERS | 1 GALLON | LOW |
| EUD 'G.S.' | EUONYMUS J. 'GREEN SPIRE' | GREEN SPIRE EUONYMUS | 5 GALLON | LOW |
| EUD 'MIC' | EUONYMUS J. 'MICROPHYLLUS' | BOXLEAF EUONYMUS | 5 GALLON | LOW |
| EUR 'MUN' | EURYTOPS P. 'MUNCKHIN' | DWARF EURYTOPS | 1 GALLON | LOW |
| FEI SEL | FEIJOA SELLOWIANA | PINEAPPLE GUAVA | 5 GALLON | LOW |
| FES GLA | FESTUCA GLAUCA | BLUE FESCUE | 1 GALLON | LOW |
| FES MAI | FESTUCA MAIREI | ATLAS FESCUE | 1 GALLON | LOW |
| GRE 'NOE' | GREVILLEA 'NOELLI' | WOOLY GREVILLEA | 5 GALLON | LOW |
| JUN 'MED' | JUNIPERUS S. 'MEDORA' | COLUMNAR JUNIPER | 5 GALLON | LOW |
| LAV 'MUN' | LAVANDULA 'MUNSTEAD' | MUNSTEAD LAVENDER | 1 GALLON | LOW |
| LAV MON | LANTANA MONTEVIDENSIS | TRAILING LANTANA | 1 GALLON | LOW |
| LAV MAR | LAVATERA MARITIMA | TREE MALLOW | 5 GALLON | LOW |
| LIG 'TEX' | LIGUSTRUM J. 'TEXANUM' | WAX LEAF PRIVET | 5 GALLON | LOW |
| LIM PER | LIMONIUM PEREZEI | SEA LAVENDER | 1 GALLON | LOW |
| LIR 'GIG' | LIRIOPE 'GIAGANTEA' | GIANT LILY TURF | 1 GALLON | LOW |
| LOR 'P.P.' | LOROPETALUM C. 'PURPLE PIXIE' | DWARF CHINESE FRINGE FLR | 5 GALLON | LOW |
| MYR 'COM' | MYRTUS C. 'COMPACTA' | DWARF MYRTLE | 5 GALLON | LOW |
| NAN 'G.S.' | NANDINA D. 'GULF STREAM' | HEAVENLY BAMBOO | 1 GALLON | LOW |
| NAN 'H.D.' | NANDINA D. 'HARBOR DWARF' | DWARF HEAVENLY BAMBOO | 1 GALLON | LOW |
| OLE 'L.O.' | OLEA E. 'LITTLE OLLIE' | DWARF OLIVE | 5 GALLON | LOW |
| PHO 'B.A.' | PHORMIUM 'BLACK ADDER' | NEW ZEALAND FLAX | 5 GALLON | LOW |
| PHO 'D.D.' | PHORMIUM 'DARK DELIGHT' | NEW ZEALAND FLAX | 5 GALLON | LOW |
| PHO 'M.Q.' | PHORMIUM 'MAORI QUEEN' | NEW ZEALAND FLAX | 5 GALLON | LOW |
| PIT 'S.S.' | PITTOSPORUM T. 'SILVER SHEEN' | SILVER SHEEN TIBORA | 5 GALLON | LOW |
| PRU 'B&T' | PRUNUS 'BRIGHT AND TIGHT' | B & T LAUREL | 5 GALLON | LOW |
| RHA 'MSB' | RHAMNUS CAL. 'MOUND SAN BRUNO' | COFFEEBERRY | 5 GALLON | LOW |
| RHA 'MIN' | RHAPHIOLEPIS UMBELLATA 'MINOR' | DWARF YEDDO HAWTHORN | 5 GALLON | LOW |
| ROS 'T.B.' | ROSMARINUS O. 'TUSCAN BLUE' | ROSEMARY | 5 GALLON | LOW |
| SOL HET | SOLLYA HETEROPHYLLA | AUSTRALIAN BLUEBELL | 5 GALLON | LOW |
| STA BYZ | STACHYS BYZANTINA | LAMB'S EARS | 1 GALLON | LOW |
| TEU CHA | TEUCRIUM CHAMAEDRYIS | WALL GERMANDER | 1 GALLON | LOW |
| VIB 'S.B.' | VIBURNUM L. 'SPRING BOUQUET' | SPRING BOUQUET VIBURNUM | 5 GALLON | LOW |
| WES 'G.B.' | WESTRINGIA F. 'GREY BOX' | DWARF COAST ROSEMARY | 5 GALLON | LOW |
| WES 'W.H.' | WESTRINGIA F. 'WYNYABBIE HIGHLIGHT' | COAST ROSEMARY | 5 GALLON | LOW |
| XYL 'COM' | XYLOSMA C. 'COMPACTA' | COMPACT XYLOSMA | 5 GALLON | LOW |

GROUNDCOVERS

| | | | |
|--|---|----------------------------|-----|
| | APTEINIA 'RED APPLE' 1 GALLON @ 36" O.C. | NO COMMON NAME | LOW |
| | ARCTOSTAPHYLOS D. 'EMERALD CARPET' 1 GALLON @ 36" O.C. | BEARBERRY | LOW |
| | BACCHARIS PILULARIS 'PIGEON POINT' 1 GALLON @ 36" O.C. | COYOTE BUSH | LOW |
| | CEANOTHUS 'DIAMOND HEIGHTS' 1 GALLON @ 24" O.C. | DIAMOND HEIGHTS WILD LILAC | LOW |
| | MYOPORUM PARVIFOLIUM 1 GALLON @ 36" O.C. | MYOPORUM | LOW |
| | ROSMARINUS 'PROSTRATUS' 1 GALLON @ 36" O.C. | ROSEMARY | LOW |

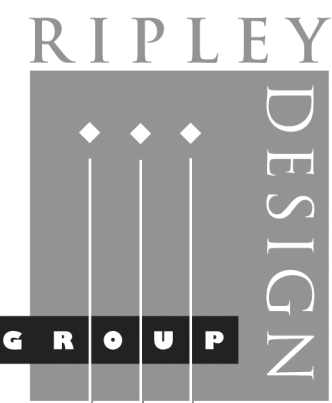

LANDSCAPE ARCHITECTURE
LAND PLANNING
1615 BONANZA STREET
SUITE 314
WALNUT CREEK, CA 94596
TEL: 925.938.7377
FAX: 925.9387436

Preliminary Planting Plan Lot 3

1385 Hillside Circle
Burlingame, California

May 2025



ARBUTUS MARINA
MARINA STRAWBERRY TREE



ANIGOZANTHOS FLAVIDUS
KANGAROO PAW



PHORMIUM H. 'MAORI QUEEN'
RED NEW ZEALAND FLAX



PHORMIUM 'PLATTS BLACK'
PLATTS BLACK NEW ZEALAND FLAX



APTENIA 'RED APPLE'
BABY SUN ROSE



RHAMNUS CALIFORNICA
COFFEEBERRY



PRUNUS C. 'MONUS'
BRIGHT AND TIGHT LAUREL



ACER PALMATUM 'BLOOD GOOD'
JAPANESE MAPLE




CERCIS OCCIDENTALIS
WESTERN REDBUD



BUDDLEJA DAVIDII 'BLACK KNIGHT'
PRUPLE BUTTERFLY BUSH



CHONDROPETALUM TECTORUM
CAPE REED

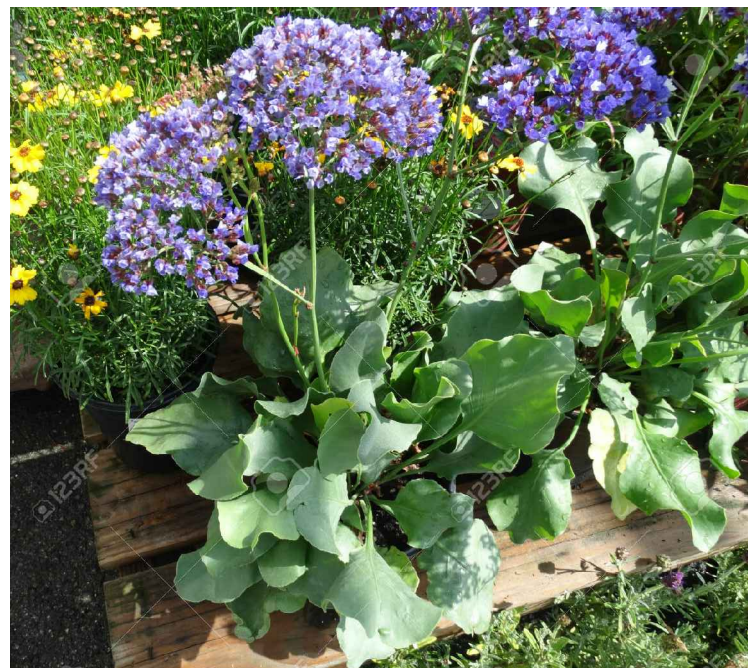

LIMONIUM PREZII
SEA LAVENDER



EUONYMUS J. 'MICROPHYLLUS'
BOXLEAF EUONYMUS



LIGUSTRUM J. 'TEXANUM'
WAXLEAF PRIVET




RHAMNUS CALIFORNICA 'EVE CASE'
COFFEEBERRY



ACER BERGERANUM
TRIDENT MAPLE



LAGERSTROEAMA INDICA 'CATAWBA'
PURPLE CRAPE TREE

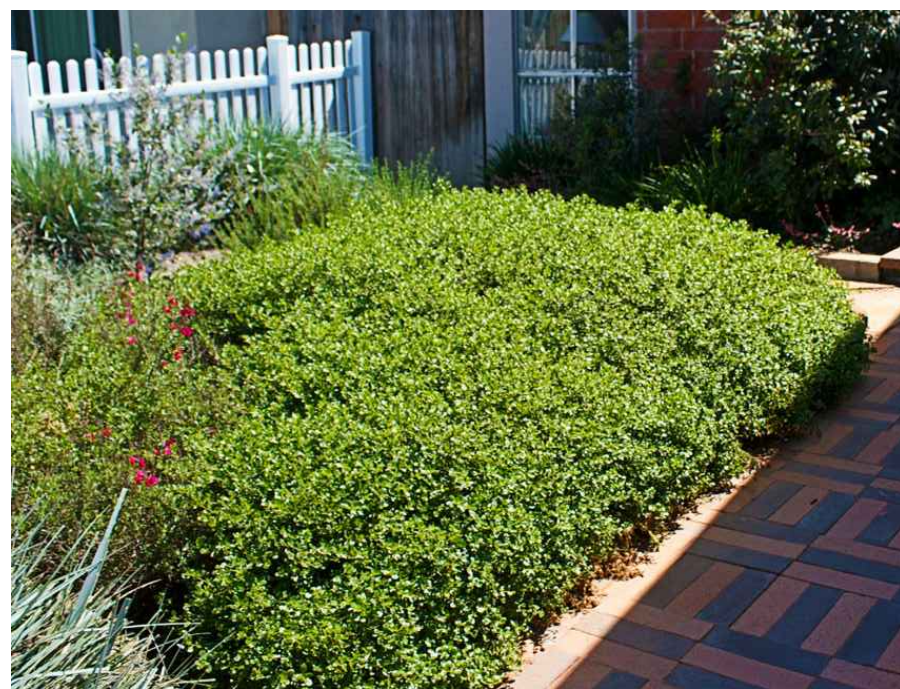

BACCHARIS PIULARIS 'PIGEON POINT'
DWARF COYOTE BRUSH



CISTUS SKANBERGII
PINK CORAL ROCKROSE



GREVILLEA 'NOELLI'
NOEL'S GREVILLEA



FELIOA SELLOWIANA
PINEAPPLE GUAVA



LAVATERA MARITIMA
TREE MALLOW



LAVANDULA A. MUNSTEAD'
DWARF ENGLISH LAVENDER



STACHY'S BYZANTINA
LAMBS EAR



LIRIOPE GIGANTEA
GIANT LILY TURF



DIETES IRIDIODES
AFRICAN ISIS




OLEA E. 'LITTLE OLLIE'
DWARF OLIVE



LANTANA MONTEVIDENSIS 'SELLOWIANA'
PURPLE TRAILING LANTANA



ARCTOSTAPHYLOS 'HOWARD MICMINN'
MANZANITA

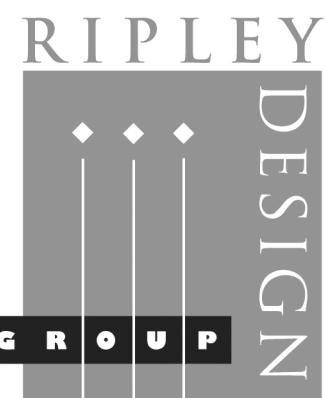

LANDSCAPE ARCHITECTURE
LAND PLANNING
1615 BONANZA STREET
SUITE 314
WALNUT CREEK, CA 94596
TEL: 925.938.7377
FAX: 925.938.7436





Plant Imagery

1385 Hillside Circle

Burlingame, California

May 2025

L6

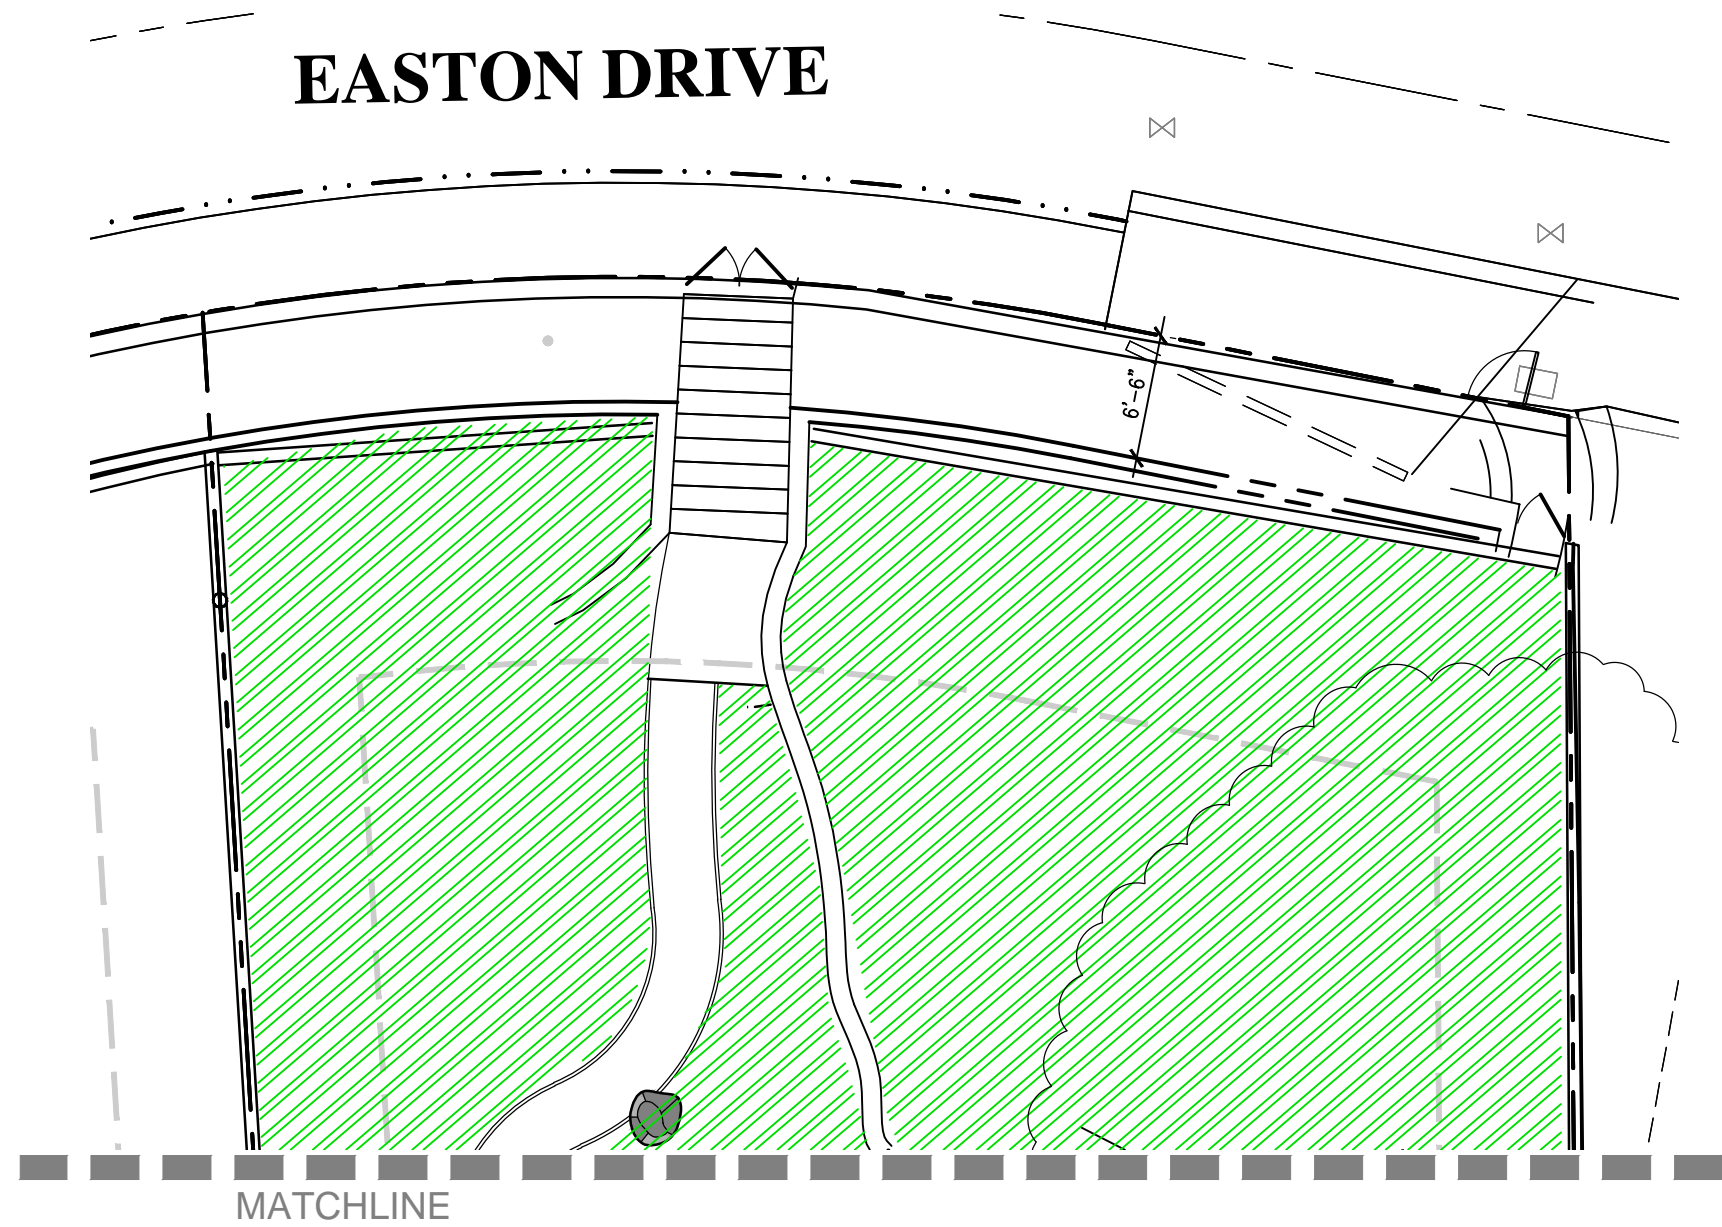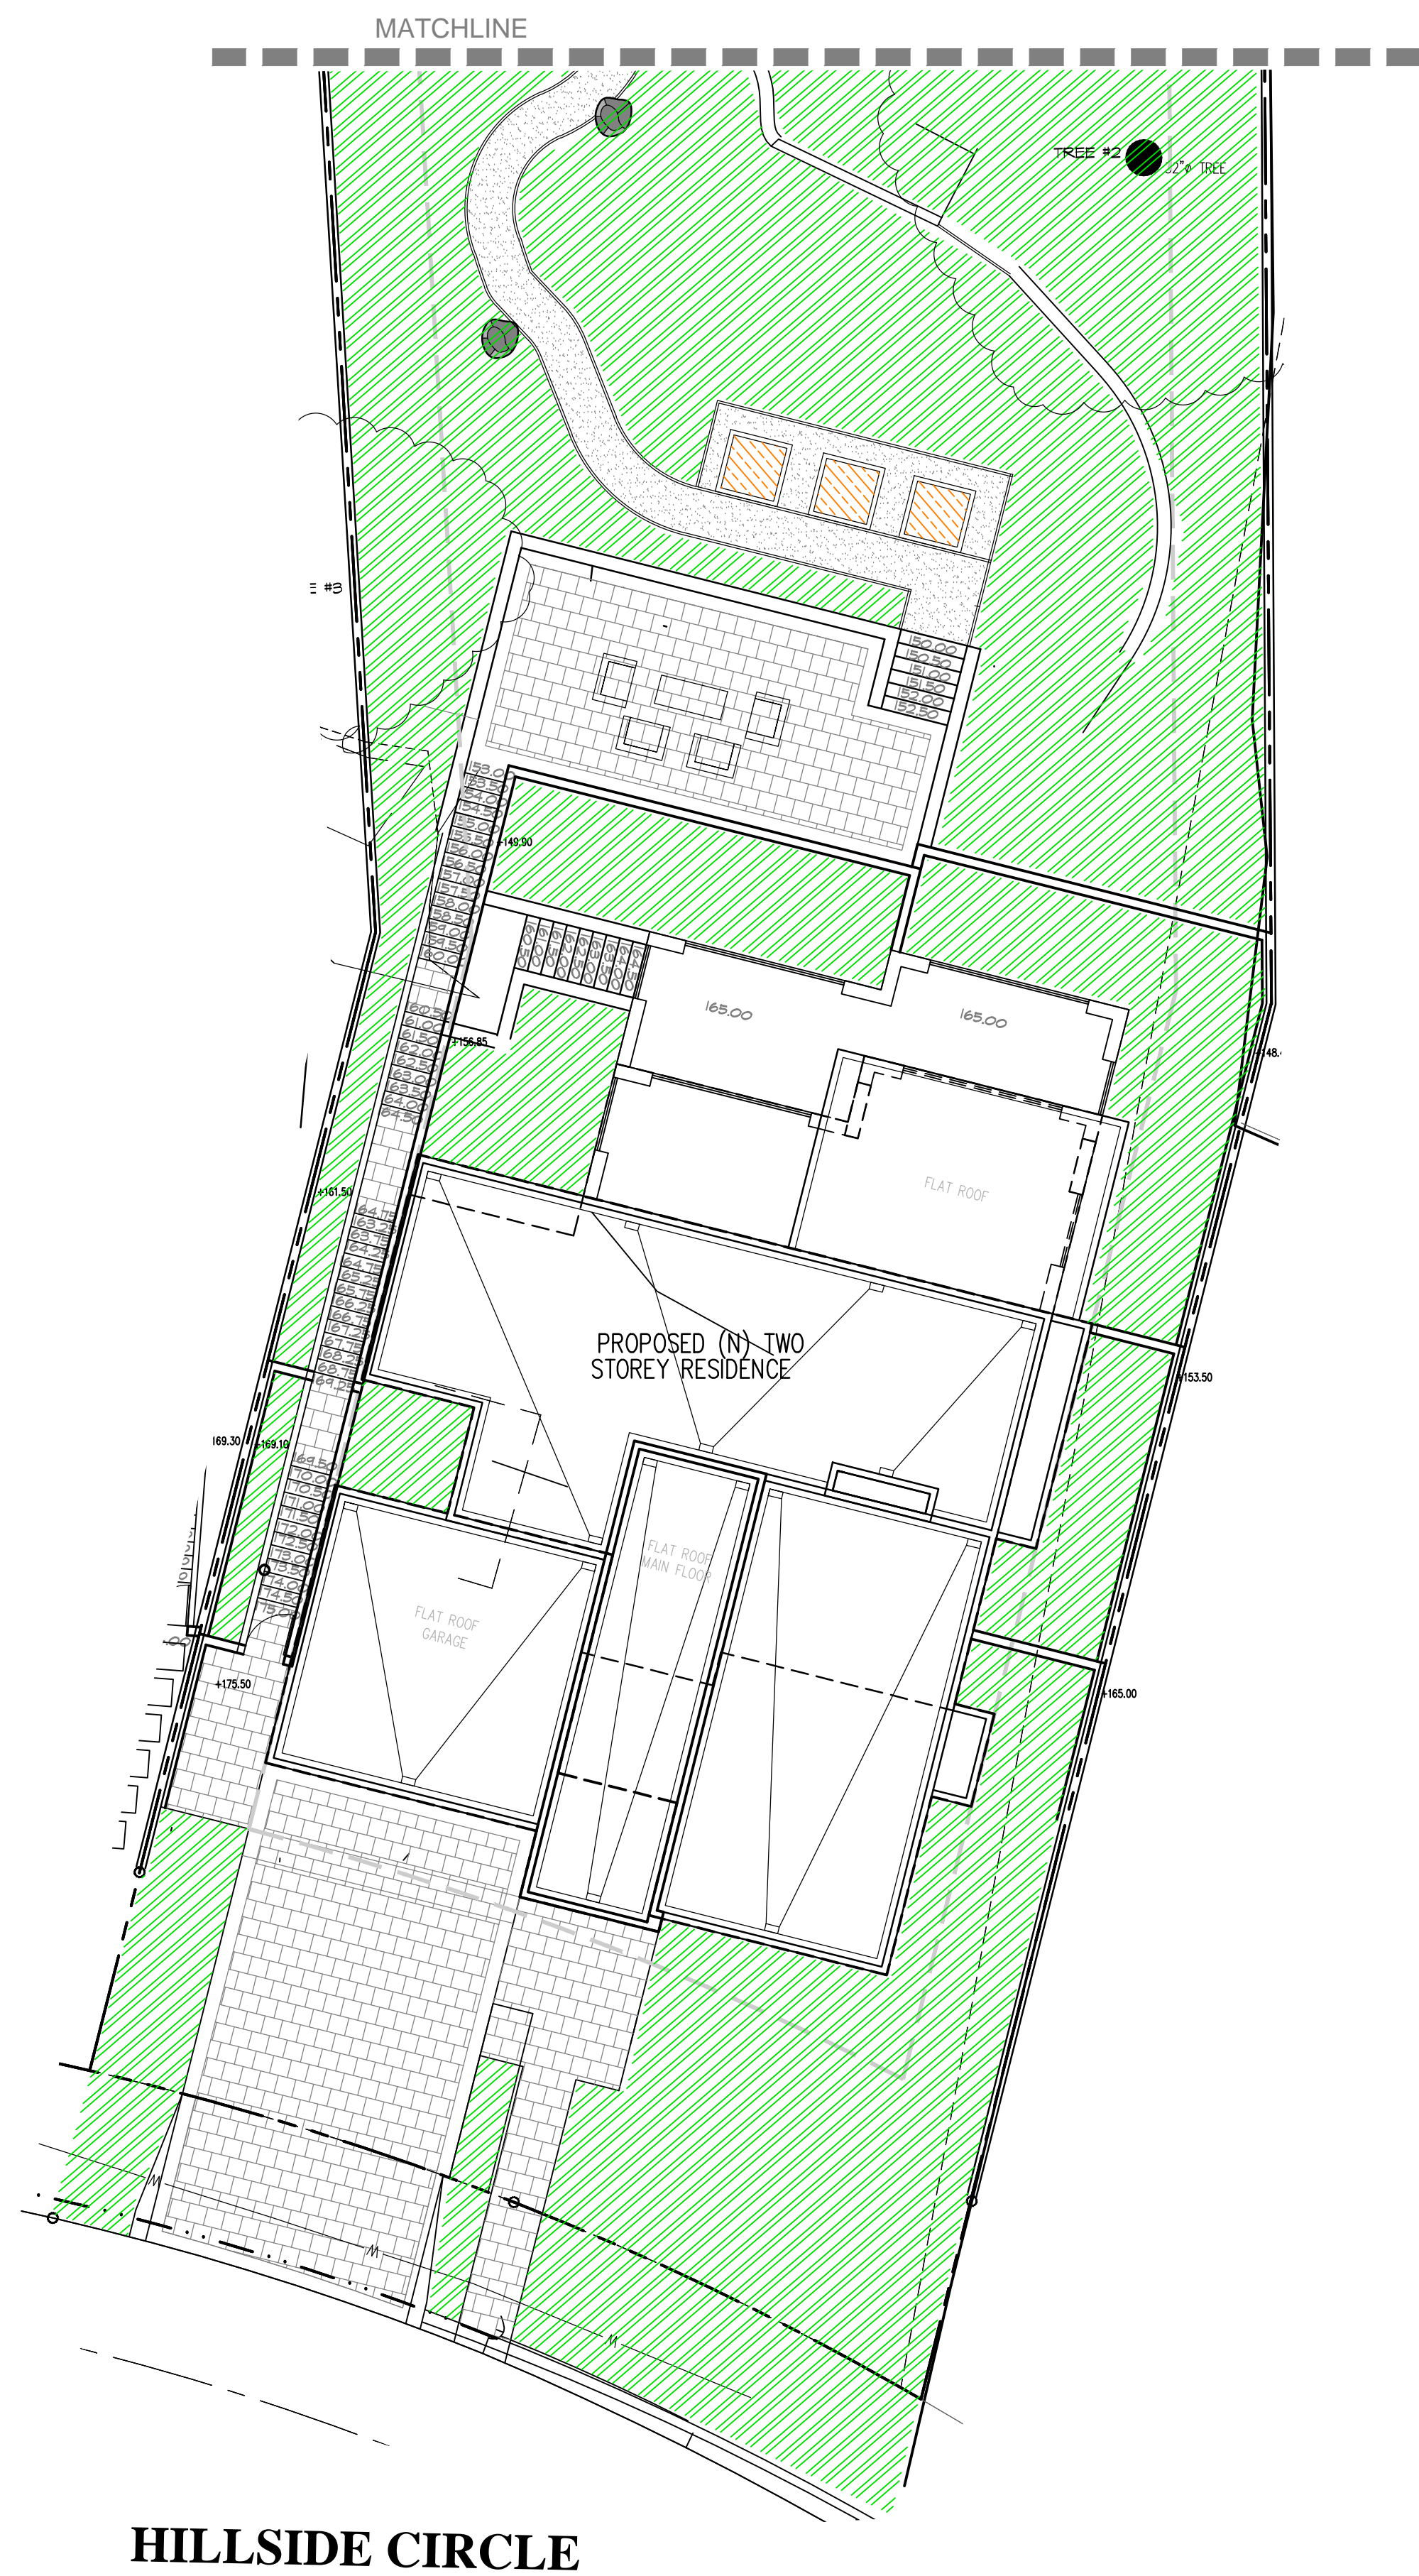

WATER BUDGET CALCULATIONS:



| | |
|--|---|
| LOW WATER USE SHRUB PLANTING AREA | = 7,019 SF |
| MED WATER USE TREE PLANTING AREA | = 80 SF |
| MED WATER USE VEGETABLE BEDS | = 50 SF |
| TOTAL PLANTING AREA | = 7,149 SF |
| ESTIMATED TOTAL WATER USE: | |
| ETWU (LOW WATER USE) | = (42.7) X (0.62) X $\frac{(0.2 \times 7,019)}{0.71}$ = 52,344 GAL/YR |
| ETWU (MED WATER USE) | = (42.7) X (0.62) X $\frac{(0.4 \times 130)}{0.71}$ = 1,939 GAL/YR |
| TOTAL ETWU | = 54,283 GAL/YR |
| MAXIMUM APPLIED WATER ALLOWANCE: | |
| MAWA(TOTAL LANDSCAPED AREA) = (42.7) X (0.62) X (0.45 X 7,149) = 85,168 GAL/YR | |

LANDSCAPE HYDROZONE LEGEND

| | |
|--|---|
| | ZONE A: RESIDENTIAL; PARTIAL TO FULL SUN, DROUGHT TOLERANT PLANTING WITH DRIP EMITTERS. LOW WATER USE. |
| | ZONE B: RAISED BED PLANTING WITH DRIP EMITTERS, MODERATE WATER USE |
| | ZONE C: STREET TREES AND ACCENT TREES WITH INDIVIDUAL BUBBLERS (NOT SHOWN). MODERATE WATER USE |

IRRIGATION SYSTEM LEGEND

| SYMBOL | DESCRIPTION | SPECIFICATION | NOZZLE GPM | OPERATING PSI |
|-----------|---------------------------|---|---------------|------------------|
| | IRRIGATION WATER METER | -BY OTHER SECTION OF CONTRACT | | |
| | 3/4" IRRIGATION SUBMETER | -HUNTER-HC-075-FLOW | | |
| | ELECTRIC CONTROLLER | -HUNTER-ICORE-IC-600-PP W/SOLAR SYNC (ET-BASED) | | |
| NOT SHOWN | WEATHER SENSOR | -HUNTER SOLAR-SYNC SENSOR (INSTALL PER MANUF) | | |
| | REMOTE CONTROL VALVES | -IRRITROL-2500T OR EQUAL | | |
| | REMOTE CONTROL VALVES | -IRRITROL-2500TF/REGULATOR & FILTER OR EQUAL | | |
| | BALL VALVE | -NIBCO-T-560-BR-20-IRR-LINE SIZE | | |
| | BUBBLER (TREE) | -RAIN BIRD-1401 | .25 | 30 |
| | BUBBLER (SHRUB) | -PEPCO-OCTA-BUBBLER (2 GPH) | .27 | 30 |
| | IRRIGATION SUPPLYLINE- 1" | -1120/SCHEDULE 40 PVC PIPE | -18" COVER | |
| | IRRIGATION SPRINKLERLINE | -1120/CLASS 200 PVC PIPE | -12" COVER | |
| | ELECTRICAL CONDUIT | -1120/SCHEDULE 40 PVC PIPE | -24" COVER | |
| | SLEEVING | -1120/SCHEDULE 40 PVC PIPE | -24" COVER | |
| | CONTROLLER STATION NUMBER | NOTE: EQUIVALENT SUBSTITUTIONS ACCEPTABLE | | |
| | CONTROL VALVE SIZE | | | |
| | IRRIGATED AREA | | | |

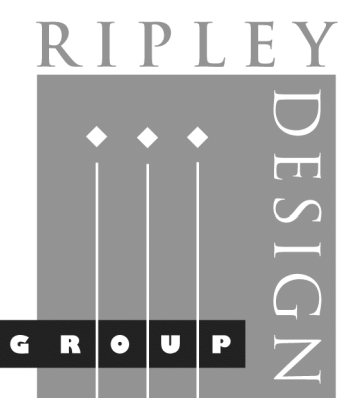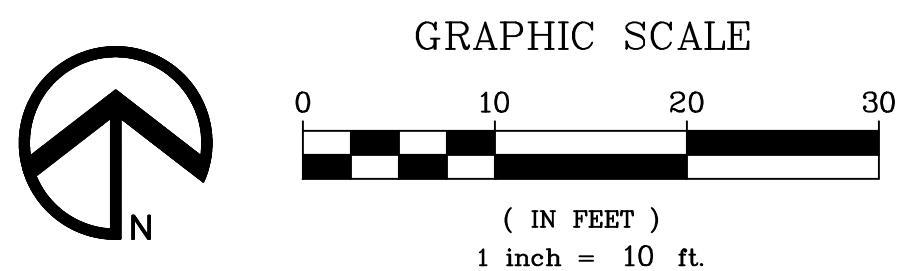


LANDSCAPE ARCHITECTURE
LAND PLANNING
1615 BONANZA STREET
SUITE 314
WALNUT CREEK, CA 94596
TEL: 925.938.7377
FAX: 925.9387436

Hydrozone/Preliminary Typical Irrigation

1385 Hillside Circle
Burlingame, California

May 2025

L7

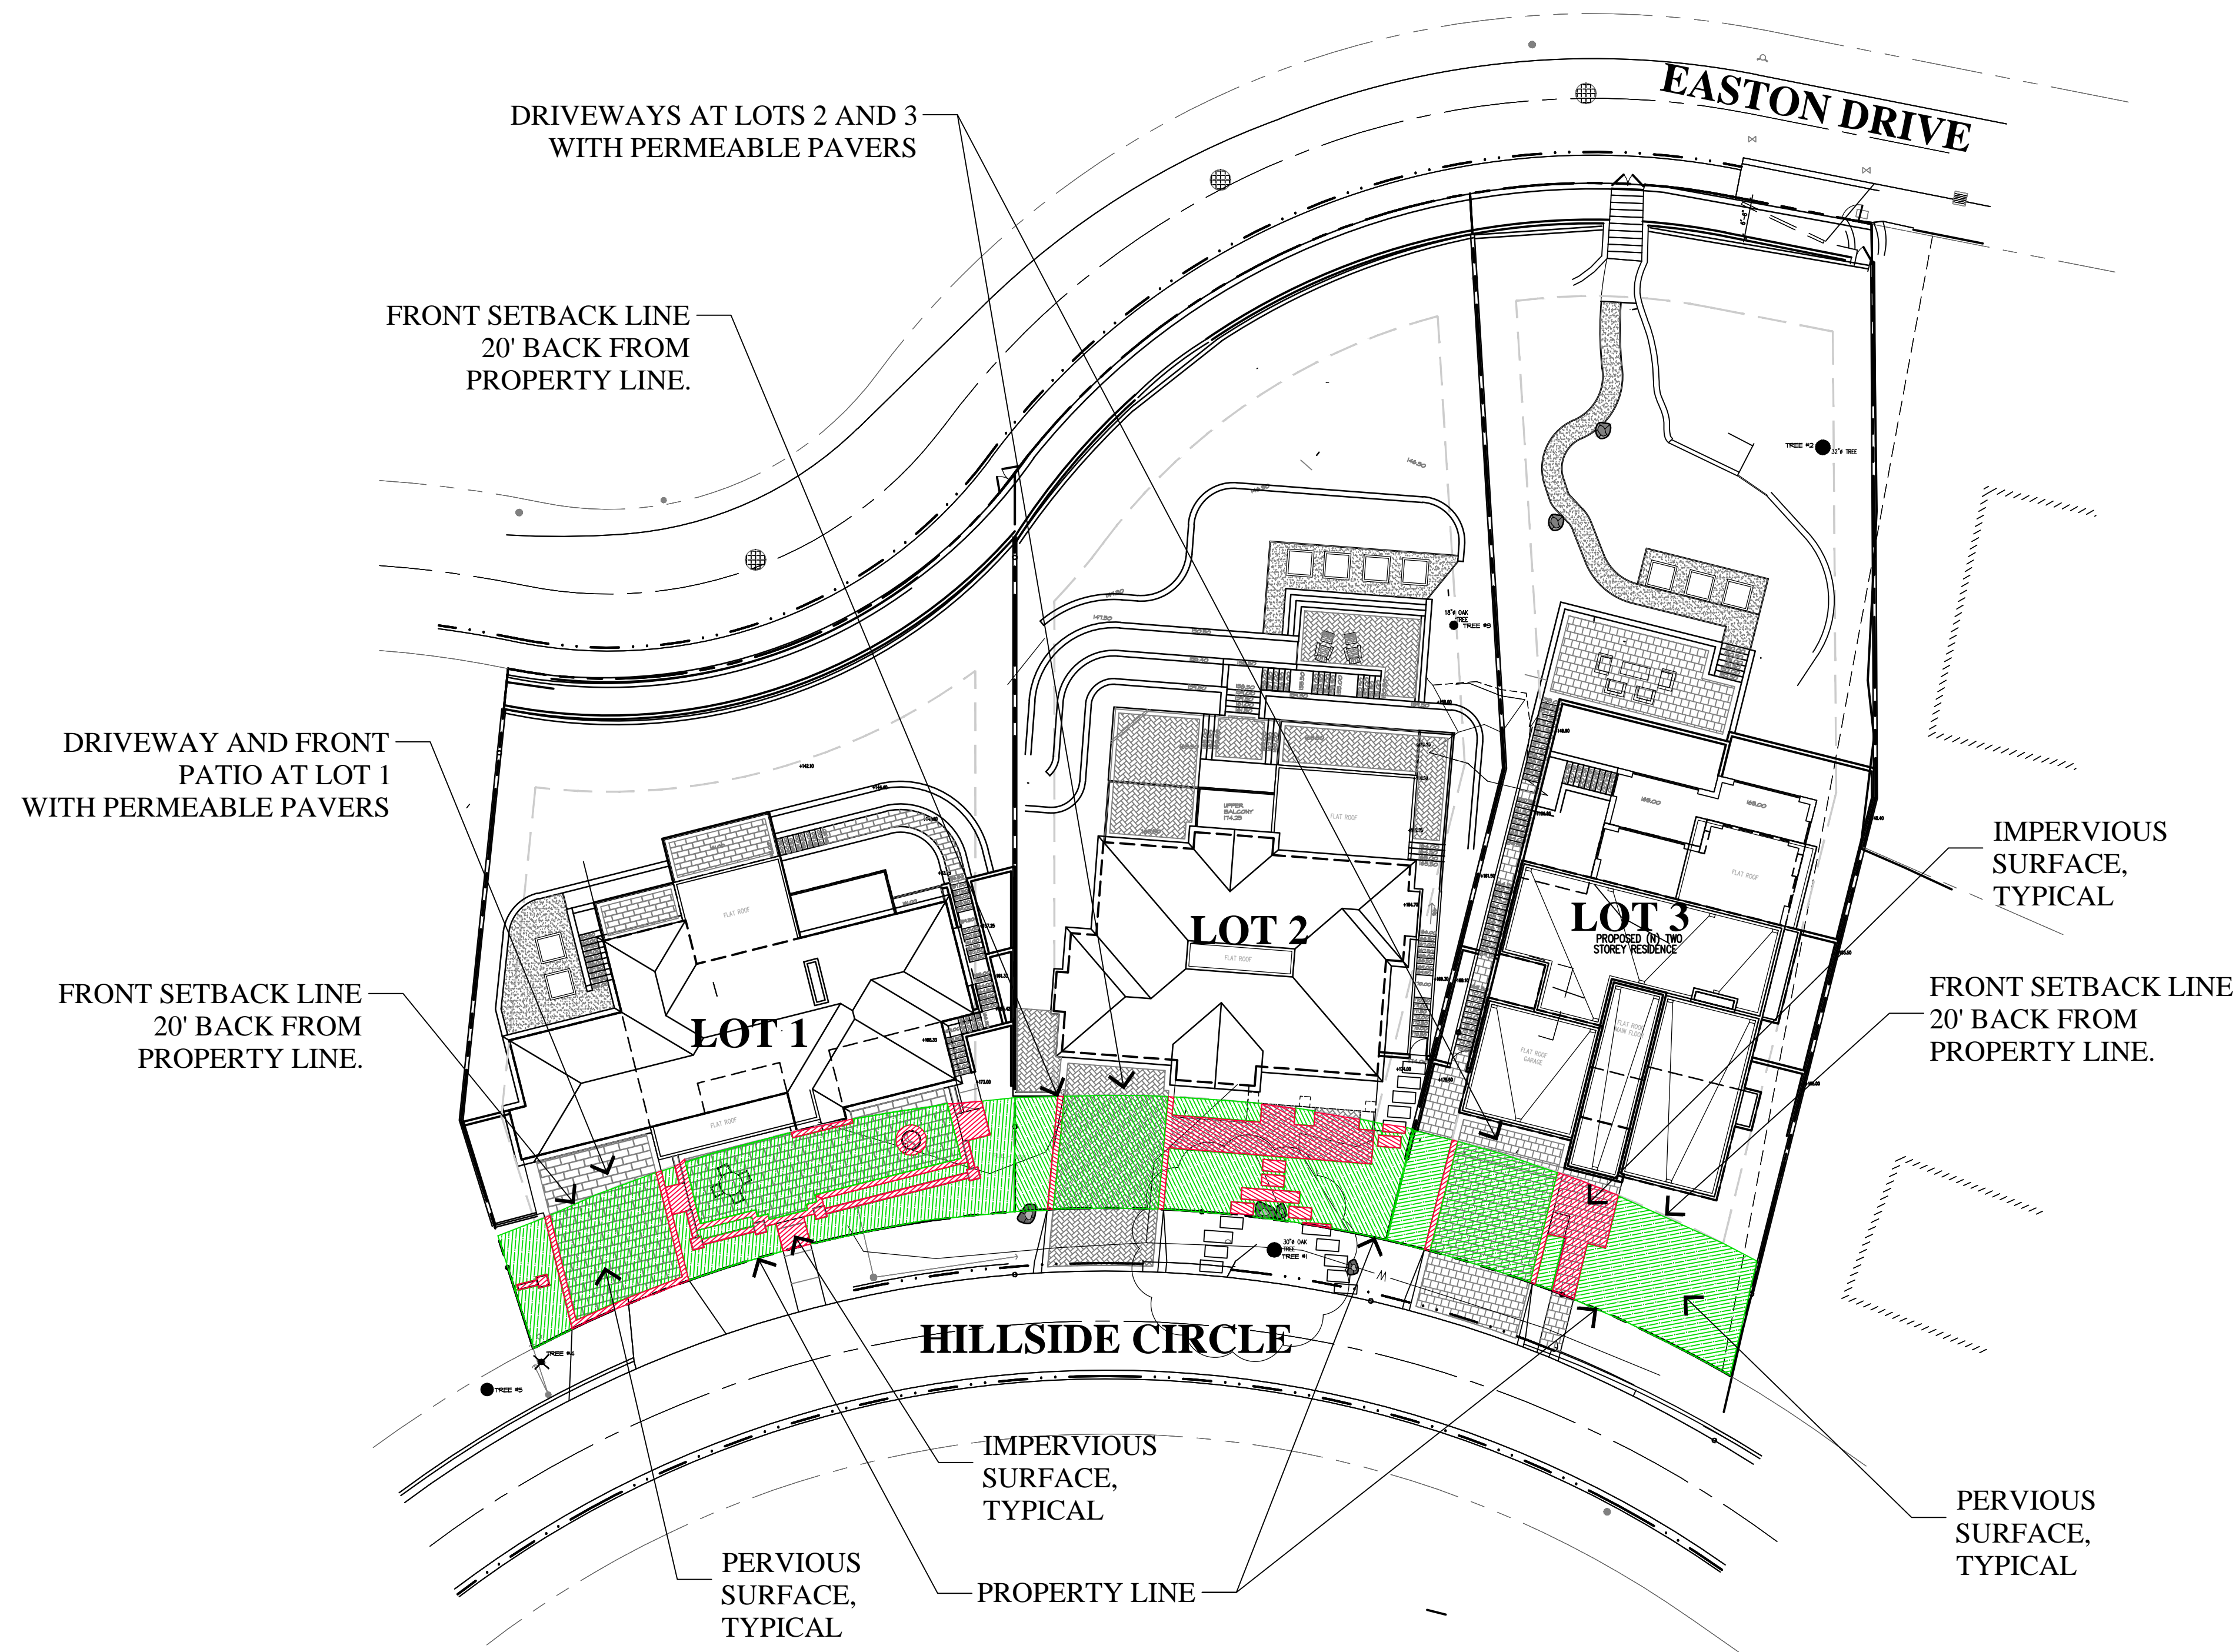

IMPERVIOUS SURFACE CALCULATIONS

LOT 1:

IMPERVIOUS AREA = 314 SQ. FEET

PERVIOUS AREA = 1,521 SQ. FEET

TOTAL AREA* = 1,835 SQ. FEET

PERCENT OF IMPERVIOUS AREA = 17.11% (314/1,835 X 100)

LOT 2:

IMPERVIOUS AREA = 353 SQ. FEET

PERVIOUS AREA = 1,015 SQ. FEET

TOTAL AREA* = 1,368 SQ. FEET

PERCENT OF IMPERVIOUS AREA = 25.8% (353/1,368 X 100)

LOT 3:

IMPERVIOUS AREA = 187 SQ. FEET

PERVIOUS AREA = 1,112 SQ. FEET

TOTAL AREA* = 1,299 SQ. FEET

PERCENT OF IMPERVIOUS AREA = 14.4% (187/1,299 X 100)


* TOTAL AREA IS CALCULATED AS TOTAL SQUARE FOOTAGE AREA OF IMPERVIOUS AND PERVIOUS SURFACES BETWEEN THE FRONT PROPERTY LINE, AND 20 FOOT SETBACK LINE.



GRAPHIC SCALE



(IN FEET)
1 inch = 20 ft.

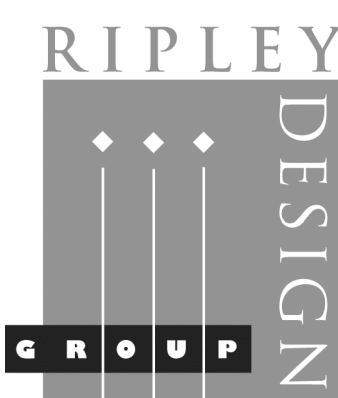

LANDSCAPE ARCHITECTURE
LAND PLANNING
1615 BONANZA STREET
SUITE 314
WALNUT CREEK, CA 94596
TEL: 925.938.7377
FAX: 925.938.7436


Preliminary Impervious Calculations

1385 Hillside Circle

Burlingame, California

May 2025

L8

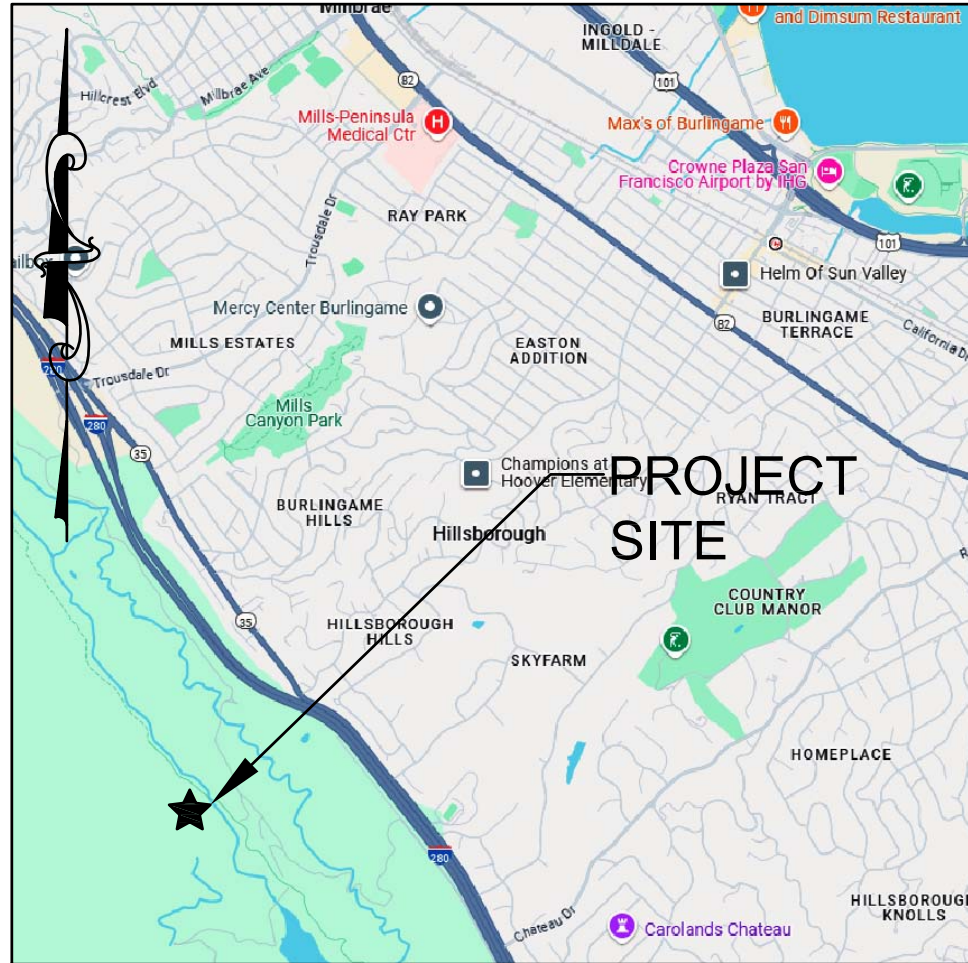

VICINITY MAP
N.T.S.

ABBREVIATIONS


| | |
|--------|-----------------------------|
| AB | AGGREGATE BASE |
| AC | ASPHALT CONCRETE |
| AD | AREA DRAIN |
| ATD | ATRIUM DRAIN |
| BFP | BACK FLOW PREVENTION DEVICE |
| BW | BOTTOM OF WALL ELEVATION |
| CB | CATCH BASIN |
| CL | CENTER LINE |
| CS | CRAWL SPACE ELEVATION |
| CIP | CAST IRON PIPE |
| CONC | CONCRETE |
| DD | DECK DRAIN |
| DDCV | DOUBLE DETECTOR CHECK VALVE |
| DG | DECOMPOSED GRANITE |
| DIP | DUCTILE IRON PIPE |
| DS | ROOF DOWN SPOUT |
| DWY | DRIVEWAY |
| (E) | EXISTING |
| ELEC | ELECTRICAL |
| EM | ELECTRICAL METER |
| EP | EDGE OF PAVEMENT |
| FC | FACE OF CURB ELEVATION |
| FDC | FIRE DEPARTMENT CONNECTION |
| FF | FINISHED FLOOR ELEVATION |
| FG | FINISHED GROUND ELEVATION |
| FL | FLOW LINE ELEVATION |
| FM | FORCE MAIN LINE |
| FS | FINISHED SURFACE ELEVATION |
| FP | FINISHED PAVEMENT ELEVATION |
| FW | FIRE WATER LINE |
| GB | GRADE BREAK |
| GM | GAS METER |
| GR | GRATE ELEVATION |
| GV | GATE VALVE |
| HP | HIGH POINT |
| HW | HEATED WATER LINE |
| INV | PIPE INVERT ELEVATION |
| JT | JOINT TRENCH |
| JP | JOINT POLE |
| LD | LANDSCAPE DRAIN |
| LP | LINEAR FEET |
| LP | LOW POINT |
| (N) | NEW |
| PIV | POST INDICATOR VALVE |
| POC | POINT OF CONNECTION |
| RIM | RIM ELEVATION |
| S | SLOPE |
| SAP | SEE ARCHITECTURAL PLANS |
| SBD | STORM SUB DRAIN |
| SBD/CO | STORM SUB DRAIN CLEANOUT |
| SD | STORM DRAIN |
| SDCO | STORM DRAIN CLEANOUT |
| SGR | SEE GEOTECHNICAL REPORT |
| SICB | SIDE INLET CATCH BASIN |
| SLP | SEE LANDSCAPE PLANS |
| SPP | SEE PLUMBING PLANS |
| SS | SANITARY SEWER |
| SSCO | SANITARY SEWER CLEANOUT |
| SSP | SEE STRUCTURAL PLANS |
| TW | TOP OF WALL ELEVATION |
| TYP | TYPICAL |
| VD | PIPE VERTICAL DROP |
| WM | DOMESTIC WATER LINE |
| WM | WATER METER |

EARTHWORK QUANTITIES

| GROSS QUANTITIES: | | QUANTITY BREAKDOWN: | |
|---|------------------------|---------------------|----------|
| CUT | 145 C.Y. | BUILDINGS: | |
| FILL | 460 C.Y. | CUT | 75 C.Y. |
| TOTAL TO BE MOVED | 605 C.Y. | FILL | 95 C.Y. |
| BALANCE | 315 C.Y. FILL (IMPORT) | SITE WORK: | |
| | | CUT | 70 C.Y. |
| | | FILL | 365 C.Y. |
| NET QUANTITIES (BUILDING AND STRUCTURES OMITTED): | | | |
| CUT | 70 C.Y. | | |
| FILL | 365 C.Y. | | |
| TOTAL TO BE MOVED | 435 C.Y. | | |
| BALANCE | 295 C.Y. FILL (IMPORT) | | |

EARTHWORK QUANTITIES SHOWN ABOVE ARE FOR PLANNING PURPOSES ONLY. CONTRACTOR SHALL CALCULATE THEIR OWN EARTHWORK QUANTITIES, AND USE THEIR CALCULATIONS FOR BIDDING AND COST ESTIMATING PURPOSES.

NEW RESIDENCE
1385 HILLSIDE CIRCLE LOT 3
BURLINGAME, CA 94010

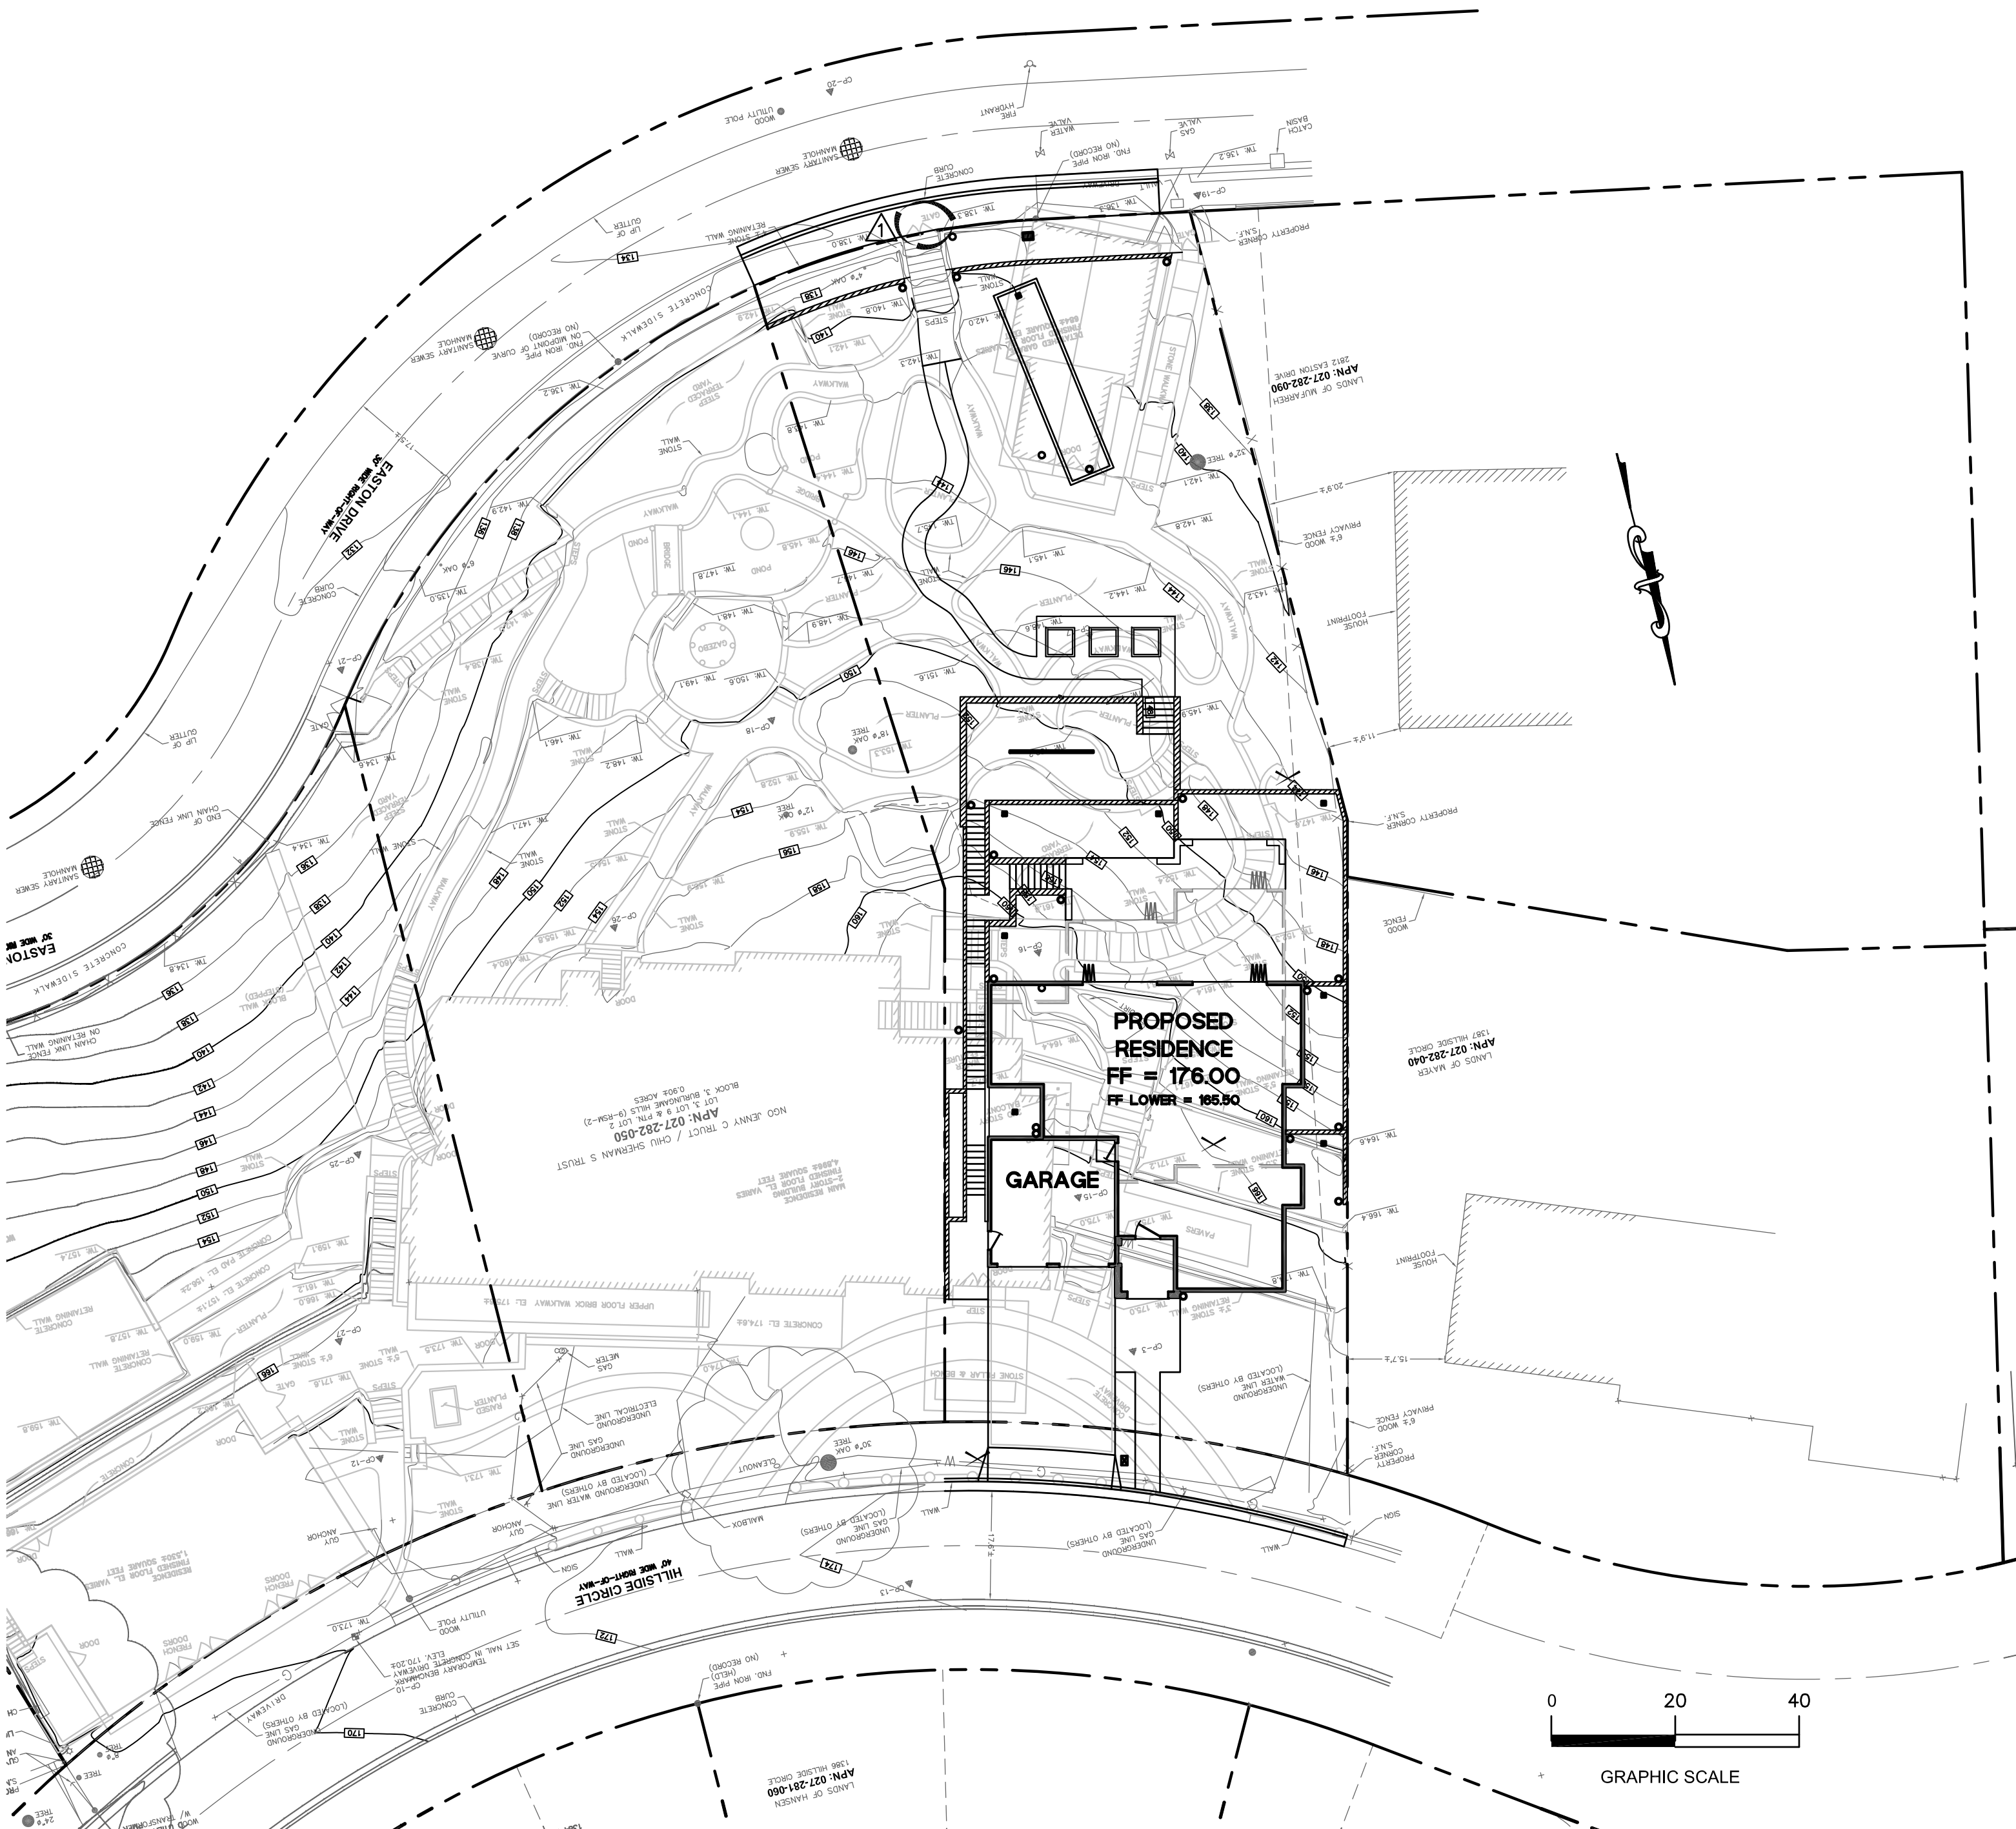

LOCATION MAP
N.T.S.

| EXISTING | | PROPOSED | | LEGEND: | |
|----------|----|----------|----|---------|--|
| SS | SS | SS | SS | SS | SANITARY SEWER |
| SD | SD | SD | SD | SD | STORM DRAIN |
| | | | | | STORM SUB-DRAIN (PERFORATED PIPE) |
| | | | | | TRANSITION FROM PERF. PIPE TO SOLID PIPE |
| | | | | | FORCE MAIN |
| | | | | | FIRE WATER LINE |
| | | | | | DOMESTIC WATER SERVICE |
| | | | | | IRRIGATION SERVICE |
| | | | | | NATURAL GAS |
| | | | | | ELECTRIC |
| | | | | | JOINT TRENCH |
| | | | | | FENCE |
| | | | | | CLEAN OUT |
| | | | | | DOUBLE DETECTOR CHECK VALVE |
| | | | | | POST INDICATOR VALVE |
| | | | | | VALVE |
| | | | | | METER BOX |
| | | | | | STREET LIGHT |
| | | | | | AREA DRAIN |
| | | | | | CATCH BASIN |
| | | | | | FIRE HYDRANT |
| | | | | | FIRE DEPARTMENT CONNECTION |
| | | | | | BENCHMARK |
| | | | | | MANHOLE |
| | | | | | SIGN |
| | | | | | DOWNSPOUT |
| | | | | | SPLASH BLOCK |
| | | | | | CONTOURS |
| | | | | | PROPERTY LINE |
| | | | | | SETBACK |
| | | | | | GRASS SWALE |
| | | | | | RETAINING WALL/ BUILDING STEMWALL |
| | | | | | (E) TREE TO BE REMOVED |

SHEET INDEX


| SHEET NO. | DESCRIPTION |
|-----------|-----------------------------------|
| C-0 | TITLE SHEET |
| C-1 | NOTES SHEET |
| C-2 | GRADING AND UTILITY PLAN |
| C-2.1 | GRADING AND UTILITY PLAN |
| C-3 | EROSION AND SEDIMENT CONTROL PLAN |
| C-3.1 | BEST MANAGEMENT PRACTICES (BMPs) |
| C-4 | DETAIL SHEET |
| C-4.1 | DETAIL SHEET |
| C-4.2 | DETAIL SHEET |
| C-5 | STORMWATER TREATMENT |

HYDROLOGY

| (E) IMPERVIOUS AREA | (N) IMPERVIOUS AREA | REQUIRED STORAGE VOL. | STORAGE VOL. PROVIDED |
|---------------------|---------------------|-----------------------|-----------------------|
| 4,733 SF | 4,264 SF | 0 CF | 177 CF |



| DATE: | 07/09/2025 |
|---------------|------------|
| REVISIONS: | |
| CITY COMMENTS | |

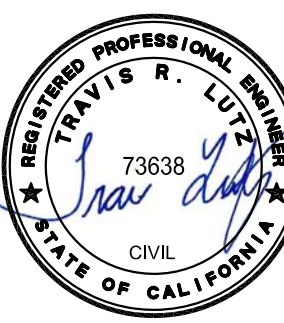

TITLE SHEET
NEW RESIDENCE
1385 HILLSIDE CIRCLE LOT 3
BURLINGAME, CA 94010

| | |
|-----------------|------------|
| Date: | 05/28/2025 |
| Scale: | AS SHOWN |
| Design: | AJP |
| Check: | TRL |
| Drawing Number: | C-0 |
| PEC Job No. | PEC 25-033 |

Drawn by: NAME, PROJECT NO. 1385, DATE: 05/28/2025, Project: 1385 HILLSIDE CIRCLE LOT 3, 1385 HILLSIDE CIRCLE, BURLINGAME, CA 94010, SHEET: 3 of 4

CAUTION:

- THE LOCATIONS, SIZES AND/OR DEPTHS OF EXISTING UNDERGROUND UTILITIES AS SHOWN ON THIS PLAN WERE OBSERVED FROM SOURCES OF VARYING RELIABILITY. THE CONTRACTOR IS CAUTIONED THAT ONLY ACTUAL EXCAVATION WILL REVEAL THE TYPES, EXTENT, SIZES, LOCATIONS AND DEPTHS OF SUCH UNDERGROUND UTILITIES. (A REASONABLE EFFORT HAS BEEN MADE TO LOCATE AND DELINEATE ALL KNOWN UNDERGROUND UTILITIES). CONTRACTOR SHALL VERIFY LOCATION AND DEPTH PRIOR TO ANY EXCAVATION OR IMPROVEMENT.
- CONTRACTOR SHALL CONTACT UNDERGROUND SERVICE ALERT FOR LOCATION OF UNDERGROUND UTILITIES AT LEAST 48 HOURS PRIOR TO COMMENCEMENT OF CONSTRUCTION- PHONE (800) 642-2444. CONTRACTOR SHALL VERIFY ALL EXISTING UTILITIES AND SHALL CLEARLY MARK (AND THEN PRESERVE THESE MARKERS) FOR THE DURATION OF CONSTRUCTION OF ALL TELEPHONE, DATA, STREET LIGHT, SIGNAL LIGHT AND POWER FACILITIES THAT ARE IN OR NEAR THE AREA OF CONSTRUCTION PRIOR TO BEGINNING ANY WORK ON THIS SITE.
- THESE DRAWINGS DO NOT ADDRESS CONTRACTOR MEANS AND METHODS OF CONSTRUCTION OR PROCESSES THAT MAY BE ASSOCIATED WITH ANY TOXIC SOILS IF FOUND ON SITE. THE CONTRACTOR IS RESPONSIBLE FOR COMPLYING WITH ALL CITY AND COUNTY STANDARDS AND APPROPRIATE REGULATIONS IF TOXIC SOILS ARE ENCOUNTERED OR SUSPECTED OF BEING CONTAMINATED.

GENERAL SITE NOTES:

- CONTRACTOR SHALL VISIT THE SITE PRIOR TO BIDDING ON THIS WORK AND CONSIDER THE EXISTING CONDITIONS AND SITE CONSTRAINTS IN THE BID. CONTRACTOR SHALL BE IN THE POSSESSION OF AND FAMILIAR WITH ALL APPLICABLE GOVERNING AGENCIES STANDARD DETAILS AND SPECIFICATIONS PRIOR TO SUBMITTING OF A BID.
- THE CONTRACTOR SHALL MAINTAIN ALL SAFETY DEVICES, AND SHALL BE RESPONSIBLE FOR CONFORMANCE TO ALL LOCAL, STATE AND FEDERAL SAFETY AND HEALTH STANDARDS LAWS AND REGULATIONS.
- ALL WORK ON-SITE AND IN THE PUBLIC RIGHT-OF-WAY SHALL CONFORM TO ALL APPLICABLE GOVERNING AGENCIES STANDARD DETAILS & SPECIFICATIONS.
- CONTRACTOR AGREES THAT HE SHALL ASSUME SOLE AND COMPLETE RESPONSIBILITY FOR JOB SITE CONDITIONS DURING THE COURSE OF CONSTRUCTION. THIS PROJECT INCLUDES SAFETY OF ALL PERSONS AND PROPERTY THAT THIS REQUIREMENT SHALL APPLY CONTINUOUSLY AND NOT BE LIMITED TO NORMAL WORKING HOURS AND THAT THE CONTRACTOR SHALL DEFEND INDEMNIFY AND HOLD THE OWNER, THE CONSULTING ENGINEER AND THE CITY HARMLESS FROM ANY AND ALL LIABILITY, REAL OR ALLEGED, IN CONNECTION WITH THE PERFORMANCE OF WORK ON THIS PROJECT, EXCEPTING FOR LIABILITY ARISING FROM THE SOLE NEGLIGENCE OF THE OWNER OR THE CONSULTING ENGINEER.
- THE CONTRACTOR SHALL BE RESPONSIBLE FOR SECURING THE JOB SITE AND SHALL TAKE NECESSARY PRECAUTIONS TO PREVENT UNAUTHORIZED PERSONS ON THE JOB SITE BY PROVIDING A CONSTRUCTION FENCE AROUND THE ENTIRE AREA OF DEMOLITION AND CONSTRUCTION, INCLUDING ALL STAGING AND STORAGE AREAS. CONSTRUCTION FENCE SHALL BE A MINIMUM OF A 6" HIGH GALVANIZED CHAIN LINK WITH GREEN WINDSCREEN FABRIC ON THE OUTSIDE OF THE FENCE.
- EXISTING PEDESTRIAN WALKWAYS, BIKE PATHS AND ACCESSIBLE PATHWAYS SHALL BE MAINTAINED, WHERE FEASIBLE, DURING CONSTRUCTION.
- IF A CONFLICT ARISES BETWEEN THE SPECIFICATIONS AND THE PLAN NOTES, THE MORE STRINGENT REQUIREMENT SHALL GOVERN.
- ALL WORK SHALL BE PERFORMED IN ACCORDANCE WITH THE GEOTECHNICAL REPORT BY GEOFOUNDATION, INC. DATED AUGUST 2024.

EXISTING CONDITIONS:

- EXISTING TOPOGRAPHIC SURVEYS PERFORMED BY QUIET RIVER LAND SERVICES ON APRIL, 2022. GRADES ENCOUNTERED ON-SITE MAY VARY FROM THOSE SHOWN. CONTRACTOR SHALL REVIEW THE PLANS AND CONDUCT FIELD INVESTIGATIONS AS REQUIRED TO VERIFY EXISTING CONDITIONS AT THE PROJECT SITE.
- CLIENT AGREES TO HOLD ENGINEER HARMLESS FROM ANY AND ALL OCCURRENCES RESULTING FROM THE INACCURACIES OF THE CLIENT SUPPLIED TOPOGRAPHIC AND/OR BOUNDARY SURVEY (PREPARED BY OTHERS).

SURVEYOR'S NOTES:

BASIS OF BEARINGS:

BURLINGAME HILLS TRACT MAP FILED IN BOOK 9 AT PAGE 2 IN THE RECORDS OF SAN MATEO COUNTY, AND TWO FOUND MONUMENTS AS SHOWN.

BASIS OF ELEVATIONS:

THE ELEVATIONS SHOWN HEREON WERE DERIVED FORM L-1/L-2 DATA COLLECTED USING NAVSTAR GLOBAL POSITIONING SYSTEM (GPS) AND A CHCX9D-OPUS RECEIVER AND POST-PROCESSED USING THE CORS NETWORK. ALL ELEVATION EXPRESSED IN NAVD 1988 DATUM.

TREE/PLANT PROTECTION NOTES:

- PRIOR TO BEGINNING CONSTRUCTION ON SITE, CONTRACTOR SHALL IDENTIFY AND PROTECT EXISTING TREES AND PLANTS DESIGNATED AS TO REMAIN.
- PROTECT EXISTING TREES TO REMAIN FROM SPILLED CHEMICALS, FUEL OIL, MOTOR OIL, GASOLINE AND ALL OTHER CHEMICALLY INJURIOUS MATERIAL. AS WELL AS FROM PUDDLING OR CONTINUOUSLY RUNNING WATER. SHOULD A SPILL OCCUR, STOP WORK IN THAT AREA AND CONTACT THE CITY'S ENGINEER/INSPECTOR IMMEDIATELY. CONTRACTOR SHALL BE RESPONSIBLE TO MITIGATE DAMAGE FROM SPILLED MATERIAL AS WELL AS MATERIAL CLEAN UP.
- CONTRACTOR SHALL BE RESPONSIBLE FOR ONGOING MAINTENANCE OF ALL TREES DESIGNATED TO REMAIN AND FOR MAINTENANCE OF RELOCATED TREES STOCKPILED DURING CONSTRUCTION. CONTRACTOR WILL BE REQUIRED TO REPLACE TREES THAT DIE DUE TO LACK OF MAINTENANCE.

HORIZONTAL CONTROL NOTES:

- ALL DIMENSIONS ON THE PLANS ARE IN FEET OR DECIMALS THEREOF UNLESS SPECIFICALLY CALLED OUT AS FEET AND INCHES.

RECORD DRAWINGS:

- THE CONTRACTOR SHALL KEEP UP-TO-DATE AND ACCURATE A COMPLETE RECORD SET OF PRINTS OF THE CONTRACT DRAWINGS SHOWING EVERY CHANGE FROM THE ORIGINAL DRAWINGS MADE DURING THE COURSE OF CONSTRUCTION INCLUDING EXACT FINAL LOCATION, ELEVATION, SIZES, MATERIALS, AND DESCRIPTION OF ALL WORK. RECORDS SHALL BE "REDLINED" ON A SET OF CONSTRUCTION PLAN DRAWINGS. A COMPLETE SET OF CORRECTED AND COMPLETED RECORD DRAWING PRINTS SHALL BE SUBMITTED TO THE OWNER PRIOR TO FINAL ACCEPTANCE .

DEMOLITION NOTES :

- PRIOR TO BEGINNING DEMOLITION WORK ACTIVITIES, CONTRACTOR SHALL INSPECT THE FINISHED GROUND SURFACE IN THE EROSION CONTROL PLAN & DETAILS.
- THE CONTRACTOR SHALL MAINTAIN ALL SAFETY DEVICES, AND SHALL BE RESPONSIBLE FOR CONFORMANCE TO ALL LOCAL, STATE AND FEDERAL SAFETY AND HEALTH STANDARDS LAWS AND REGULATIONS.
- CONTRACTOR IS TO COMPLY WITH ALL LOCAL, STATE AND FEDERAL REQUIREMENTS, INCLUDING BUT NOT LIMITED TO, THE SAFETY AND HEALTH STANDARDS LAWS AND REGULATIONS AND REMOVAL AND DISPOSAL OF HAZARDOUS MATERIAL(S).
- CONTRACTOR'S BID IS TO INCLUDE ALL VISIBLE SURFACE AND ALL SUBSURFACE FEATURES IDENTIFIED TO BE REMOVED OR ABANDONED IN THESE DOCUMENTS.
- THE CONTRACTOR SHALL BE RESPONSIBLE FOR A SITE INSPECTION TO FULLY ACKNOWLEDGE THE EXTENT OF THE DEMOLITION WORK.
- THE CONTRACTOR SHALL BE RESPONSIBLE FOR OBTAINING ANY AND ALL PERMITS NECESSARY FOR ENCROACHMENT, GRADING, DEMOLITION, AND DISPOSAL OF SAID MATERIALS AS REQUIRED BY PRIVATE, LOCAL AND STATE JURISDICTIONS. THE CONTRACTOR SHALL PAY ALL FEES ASSOCIATED WITH THE DEMOLITION WORK.
- BACKFILL ALL DEPRESSIONS AND TRENCHES FROM DEMOLITION. REMOVAL OF LANDSCAPING SHALL INCLUDE ROOTS AND ORGANIC MATERIALS.
- REMOVAL OF LANDSCAPING SHALL INCLUDE ROOTS AND ORGANIC MATERIALS TO THE SATISFACTION OF THE GEOTECHNICAL ENGINEER.
- THE CONTRACTOR SHALL PROTECT FROM DAMAGE ALL EXISTING IMPROVEMENTS FACILITIES AND STRUCTURES WHICH ARE TO REMAIN. ANY ITEMS DAMAGED BY THE CONTRACTOR OR HIS AGENTS OR ANY ITEMS REMOVED FOR HIS USE SHALL BE REPLACED IN EQUAL OR BETTER CONDITION AS APPROVED BY THE OWNER.
- COORDINATE ALL UTILITY SHUT-DOWN/DISCONNECT LOCATIONS WITH APPROPRIATE DRAWINGS (ELECTRICAL, MECHANICAL, ARCHITECTURAL, ETC.). CONTRACTOR IS TO SHUT OFF ALL UTILITIES AS NECESSARY PRIOR TO DEMOLITION. CONTRACTOR IS TO COORDINATE SERVICE INTERRUPTIONS WITH THE OWNER. DO NOT INTERRUPT SERVICES TO ADJACENT OFF-SITE OWNERS. ANY EXISTING UNDERGROUND UTILITY LINES TO BE ABANDONED, SHOULD BE REMOVED FROM WITHIN THE PROPOSED BUILDING ENVELOPE AND THEIR ENDS CAPPED OUTSIDE OF THE BUILDING ENVELOPE.
- THIS PLAN IS NOT INTENDED TO BE A COMPLETE CATALOGUE OF ALL EXISTING STRUCTURES AND UTILITIES. THIS PLAN INTENDS TO DISCLOSE GENERAL INFORMATION KNOWN BY THE ENGINEER AND TO SHOW THE LIMITS OF THE AREA WHERE WORK WILL BE PERFORMED. THIS PLAN SHOWS THE EXISTING FEATURES TAKEN FROM A FIELD SURVEY, FIELD INVESTIGATIONS AND AVAILABLE INFORMATION. THIS PLAN MAY OR MAY NOT ACCURATELY REFLECT THE TYPE OR EXTENT OF THE ITEMS TO BE ENCOUNTERED AS THEY ACTUALLY EXIST. WHERE EXISTING FEATURES ARE NOT SHOWN, IT IS NOT IMPLIED THAT THEY ARE NOT TO BE DEMOLISHED OR REMOVED. THE CONTRACTOR SHALL PERFORM A THOROUGH FIELD INVESTIGATION AND REVIEW OF THE SITE WITHIN THE LIMIT OF WORK SHOWN IN THIS PLAN SET TO DETERMINE THE TYPE, QUANTITY AND EXTENT OF ANY AND ALL ITEMS. THE CONTRACTOR SHALL BE SOLELY RESPONSIBLE FOR DETERMINING THE EXTENT OF EXISTING STRUCTURES AND UTILITIES AND QUANTITY OF WORK INVOLVED IN REMOVING THESE ITEMS FROM THE SITE.

STORM DRAIN NOTES:

- USE DETECTABLE METALIZED WARNING TAPE APPROXIMATELY 6" BELOW THE SURFACE. TAPE SHALL BE A BRIGHT COLOR AND IMPRINTED WITH "CAUTION-BURIED STORM DRAIN LINE BELOW".
- PRIVATE STORM DRAIN LINE 4-INCH THROUGH 12-INCH IN NON-TRAFFIC AREAS SHALL BE INSTALLED WITH A MINIMUM OF EIGHTEEN (18) INCHES OF COVER AND SHALL BE POLYVINYL CHLORIDE (PVC) SDR 35. ALL DIRECTION CHANGES SHALL BE MADE WITH WYE CONNECTIONS, 22.5° ELBOWS, 45° ELBOWS OR LONG SWEEP ELBOWS, 90° ELBOWS AND TEE'S ARE PROHIBITED.
- PRIVATE STORM DRAIN LINE 4-INCH THROUGH 12-INCH WITHIN VEHICULAR TRAFFIC AREAS SHALL BE INSTALLED WITH A MINIMUM OF EIGHTEEN (18) INCHES OF COVER AND SHALL BE POLYVINYL CHLORIDE (PVC) SDR 35 PIPE. ALL DIRECTION CHANGES SHALL BE MADE WITH WYE CONNECTIONS, OBTUSE ELBOWS OR LONG SWEEP ELBOWS, 90° ELBOWS AND TEE'S ARE PROHIBITED.
- PAINT THE TOP OF THE CURBS ADJACENT TO EACH CATCH BASIN INSTALLED UNDER THIS WORK OR ADJACENT TO THIS SITE WITH THE WORDS "NO DUMPING". WORDING TO BE BLUE 4" HIGH LETTERS ON A PAINTED WHITE BACKGROUND.
- ALL AREA DRAINS AND CATCH BASINS GRATES WITHIN PEDESTRIAN ACCESSIBLE AREAS SHALL MEET ADA REQUIREMENTS.
- DRAINS SHOWN ON CIVIL PLANS ARE NOT INTENDED TO BE THE FINAL NUMBER AND LOCATION OF ALL DRAINS. PLACEMENT AND NUMBER OF LANDSCAPING DRAINS ARE HIGHLY DEPENDENT ON GROUND COVER TYPE AND PLANT MATERIAL. CONTRACTOR SHALL ADD ADDITIONAL AREA DRAINS AS NEEDED AND AS DIRECTED BY THE LANDSCAPE ARCHITECT/OWNER.
- WHERE FEASIBLE ALL DOWNSPOUTS SHALL DISCHARGE TO A SPLASHBLOCK OR IMPERVIOUS SURFACE AND FLOW TO LANDSCAPED FEATURES BEFORE ENTERING THE DRAINAGE SYSTEM. USE OF AREA DRAINS (RATHER THAN DIRECT CONNECTION TO DRAINAGE SYSTEM) TO COLLECT ROOF/SURFACE WATER IS STRONGLY ENCOURAGED IN CONFORMANCE WITH COUNTYWIDE C.3 REQUIREMENTS. OTHERWISE, DOWNSPOUTS SHALL BE CONNECTED TO THE STORM DRAIN SYSTEM WITH 4" PVC SDR 35 PIPE WHERE SHOWN ON PLANS. SEE ARCHITECTURE PLANS FOR EXACT LOCATION OF THE DOWN SPOUTS.
- CONTRACTOR SHALL INSTALL RAIN GUTTER GUARDS OR WIRE MESH ON ROOF GUTTERS TO REDUCE THE AMOUNT TO LEAVES AND DEBRIS FROM ENTERING THE STORM DRAIN SYSTEM.
- CONTRACTOR TO COORDINATE ANY VENT WELL DRAINS AND RAT SLAB DRAINS WITH PERIMETER SUB-DRAIN SYSTEM. SEE ARCHITECTURAL PLANS FOR VENT WELL LOCATIONS. SEE STRUCTURAL PLANS FOR FOUNDATION AND RAT SLAB.
- INSTALL SEPARATE SUB-DRAIN SYSTEM BEHIND RETAINING WALLS PER GEOTECHNICAL REPORT AND CONNECT TO STORM DRAIN SYSTEM AT SUMP PUMP.

FIRE PROTECTION NOTES:

- CONTRACTOR SHALL INSTALL THE DESIGN BUILD FIRE SERVICE LINE, BACKFLOW PREVENTOR, SPRINKLERS AND EQUIPMENT IN ACCORDANCE WITH THE FIRE PROTECTION CONSULTANT'S PLANS, SPECIFICATIONS, LATEST EDITION OF THE UNIFORM/CALIFORNIA FIRE CODE AND CITY/TOWN STANDARDS.
- THE UNDERGROUND FIRE PROTECTION SYSTEM INSTALLER SHALL PREPARE SHOP DRAWINGS SHOWING ALL INFORMATION REQUIRED BY THE LOCAL FIRE MARSHAL, INCLUDING ANGLES, THRUST BLOCKS, VALVES, FIRE HYDRANTS, PIV'S, FDC's, BACKFLOW ASSEMBLIES, FLEXIBLE CONNECTIONS, VAULTS, ETC.
- SHOP DRAWINGS SHALL BE SUBMITTED TO THE LOCAL FIRE MARSHAL, THE RATING AGENCY AND THE PROJECT MANAGER, ALLOWING TIME FOR REVIEW AND ACCEPTANCE, PRIOR TO START OF WORK.
- THE UNDERGROUND FIRE PROTECTION SYSTEM INSTALLER SHALL OBTAIN ALL APPROVALS AND PERMITS PRIOR TO ORDERING MATERIALS, FABRICATING SYSTEMS OR ANY INSTALLATION.
- GENERAL CONTRACTOR IS RESPONSIBLE FOR VERIFICATION OF ALL DIMENSIONS AND EQUIPMENT LOCATIONS. RISER LOCATIONS ARE SHOWN ON ARCHITECTURAL AND PLUMBING DRAWINGS AND ARE TO BE COORDINATED WITH ACTUAL FIELD CONDITIONS.

GRADING NOTES:

- PROVIDE POSITIVE SURFACE DRAINAGE AWAY FROM ALL STRUCTURES BY SLOPING THE FINISHED GROUND SURFACE AT LEAST 5%, UNLESS OTHERWISE NOTED ON THE PLANS. SLOPE LANDINGS 2% (1/4" PER FOOT) AWAY FROM STRUCTURES UNLESS OTHERWISE NOTED ON PLANS. ANY AREAS ON THE SITE NOT CONFORMING TO THESE BASIC RULES DUE TO EXISTING CONDITIONS OR DISCREPANCIES IN THE DOCUMENTS ARE TO BE REPORTED TO THE CIVIL ENGINEER PRIOR TO PROCEEDING WITH PLACEMENT OF BASE ROCK OR FORMWORK FOR CURBS AND/OR FLATWORK.
- CONTRACTOR SHALL DETERMINE EARTHWORK QUANTITIES BASED ON THE TOPOGRAPHIC SURVEY, THE GEOTECHNICAL INVESTIGATION AND THE PROPOSED SURFACE THICKNESS AND BASE THE BID ACCORDINGLY. IT IS THE CONTRACTORS RESPONSIBILITY TO CONFIRM IF A SEPARATE DEMOLITION CONTRACT HAS BEEN ISSUED TO TAKE THE SITE FROM THE WAY IT IS AT THE TIME OF THE BID TO THE CONDITIONS DESCRIBED IN THESE DOCUMENTS. BRING ANY DIFFERENCES BETWEEN THE STATE IN WHICH THE SITE IS DELIVERED TO THE CONTRACTOR AND THESE DOCUMENTS TO THE ATTENTION OF THE CIVIL ENGINEER.
- ALL FILL SHALL BE COMPACTED PER THE GEOTECHNICAL REPORT AND THE CONTRACTOR SHALL COORDINATE AND COMPLY WITH THE GEOTECHNICAL ENGINEER TO TAKE THE APPROPRIATE TESTS TO VERIFY COMPACTION VALUES.
- IMPORT SOILS SHOULD MEET THE REQUIREMENTS OF THE SOILS REPORT AND SPECIFICATIONS.
- DO NOT ADJUST GRADES ON THIS PLAN WITHOUT PRIOR WRITTEN APPROVAL OF THE CIVIL ENGINEER.
- SITE STRIPPINGS THAT CONTAIN ONLY ORGANIC MATERIAL (NO DEBRIS TRASH, BROKEN CONC. OR ROCKS GREATER THAN 1" IN DIAMETER) MAY BE USED IN LANDSCAPE AREAS, EXCEPT FOR AREAS IDENTIFIED AS IMPORT TOP SOIL BY THE LANDSCAPE DRAWINGS. EXCESS STRIPPINGS SHALL BE REMOVED FROM SITE.
- ROUGH GRADING TO BE WITHIN 0.1' AND FINISH GRADES ARE TO BE WITHIN 0.05', HOWEVER CONTRACTOR SHALL NOT CORRECT ANY IMPROVEMENTS THAT WILL CAUSE WATER TO POND OR NOT MEET REQUIREMENTS IN GRADING NOTE #1.
- THE CONTRACTOR SHALL EXERCISE EXTREME CARE TO CONFORM TO THE LINES, GRADES, SECTIONS, AND DIMENSIONS AS SET FORTH ON THESE PLANS. ALL GRADED AREAS SHALL CONFORM TO THE VERTICAL ELEVATIONS SHOWN WITH A TOLERANCE OF ONE-TENTH OF A FOOT. WHERE GRADED AREAS DO NOT CONFORM TO THESE TOLERANCES, THE CONTRACTORS SHALL BE REQUIRED TO DO CORRECTIVE GRADING, AT NO EXTRA COST TO THE CLIENT.
- IT SHALL BE THE CONTRACTOR'S RESPONSIBILITY TO CONFIRM THE GROUND ELEVATIONS AND OVERALL TOPOGRAPHY OF THE SITE PRIOR TO THE START OF CONSTRUCTION AS TO THE ACCURACY BETWEEN THE WORK SET FORTH ON THESE PLANS AND THE WORK IN THE FIELD. ANY DISCREPANCIES SHALL BE IMMEDIATELY BROUGHT TO THE ATTENTION OF THE CONSTRUCTION MANAGER AND CIVIL ENGINEER IN WRITING PRIOR TO START OF CONSTRUCTION WHICH MAY REQUIRE CHANGES IN DESIGN AND/OR AFFECT THE EARTHWORK QUANTITIES.
- THE CONTRACTOR SHALL ADJUST TO FINAL GRADE ALL EXISTING MANHOLES, CURB INLETS, CATCH BASINS, VALVES, MONUMENT COVERS, AND OTHER CASTINGS WITHIN THE WORK AREA TO FINAL GRADE IN PAVEMENT AND LANDSCAPE AREAS UNLESS NOTED OTHERWISE.

WATER SYSTEM NOTES:

- USE DETECTABLE METALIZED WARNING TAPE APPROXIMATELY 6" BELOW THE SURFACE. TAPE SHALL BE A BRIGHT COLOR AND IMPRINTED WITH "CAUTION-BURIED WATER LINE BELOW".
- ALL WATER SERVICE CONNECTIONS, INCLUDING BUT NOT LIMITED TO WATER VALVES TEMPORARY AND PERMANENT AIR RELEASE VALVES AND BLOW OFF VALVES, SHALL BE INSTALLED IN ACCORDANCE WITH THE CITY/COUNTY OR APPLICABLE WATER DISTRICT STANDARDS.
- CONTRACTOR SHALL SIZE AND INSTALL ALL NEW DESIGN BUILD DOMESTIC IIGATION AND FIRE WATER LINE(S) IN ACCORDANCE WITH THE LATEST EDITION OF THE UNIFORM/CALIFORNIA PLUMBING AND FIRE CODES. (ALL FIXTURE UNIT COUNTS SHALL BE REVIEWED AND APPROVED BY THE CITY'S BUILDING AND/OR WATER DEPARTMENT PRIOR TO CONSTRUCTION.)
- ALL WATER LINES SHALL BE INSTALLED WITH 36" MINIMUM COVER.
- PUBLIC AND PRIVATE WATER MAIN AND WATER SERVICE LINE4" THROUGH 12-INCH SHALL BE POLYVINYL CHLORIDE (PVC) AND SHALL MEET AWWA C900, RATED FOR 200 PSI CLASS PIPE WITH EPOXY COATED DUCTILE IRON FITTINGS AND FUSION EPOXY COATED GATE VALVES. ALL JOINTS SHALL BE FACTORY MANUFACTURED WITH BELL AND SPIGOT ENDS AND RUBBER GASKETS.
- ALL WATER LINES 2" OR SMALLER SHALL BE TYPE K COPPER WITH SILVER BRAZED JOINTS. CONTRACTOR TO VERIFY PRESSURES FROM EXISTING LINES ARE ADEQUATE TO SERVICE BUILDINGS AS SPECIFIED BY THE PLUMBING PLANS.
- CONNECTIONS TO THE EXISTING WATER MAIN SHALL BE APPROVED BY THE APPLICABLE WATER DISTRICT STANDARDS. THE CONTRACTOR SHALL PAY THE ACTUAL COSTS OF CONSTRUCTION. THE CONTRACTOR SHALL PERFORM ALL EXCAVATING, PREPARE THE SITE, FURNISH ALL MATERIALS, INSTALL TAPPING TEE, VALVE AND ALL THURST BLOCKS, BACKFILL, RESTORE THE SURFACE, AND CLEAN UP. THE APPLICABLE WATER DISTRICT STANDARDS WILL PROVIDE THE CONTRACTOR WITH A LIST OF APPROVED CONTRACTORS FOR MAKING WET TAPS.
- ALL WATER VALVES SHALL BE CLUSTERED, UNLESS OTHERWISE DIRECTED BY THE CITY/COUNTY OR APPLICABLE WATER DISTRICT.
- THE CONTRACTOR SHALL BE RESPONSIBLE FOR COLLECTING AND DELIVERING WATER SAMPLES FOR ANALYSIS TO A CITY/COUNTY/APPLICABLE WATER DISTRICT APPROVED LAB.
- ALL ON AND OFF-SITE LANDSCAPE IRRIGATION SYSTEMS SHALL BE IN ACCORDANCE WITH THE LANDSCAPE ARCHITECTURAL PLANS AND SPECIFICATIONS AND SHALL BE CONNECTED TO THE EXISTING AND/OR NEW WATER SYSTEM AND METERED ACCORDINGLY.
- INSTALL CITY/COUNTY/APPLICABLE WATER DISTRICT APPROVED PRESSURE REGULATOR AND REDUCED BACKFLOW PREVENTOR ON WATER LINE AT ENTRANCE TO BUILDING. REFERENCE PLUMBING PLANS FOR MORE DETAIL.

PAVEMENT SECTION:

- SEE STRUCTURAL DRAWINGS FOR BUILDING SLAB SECTIONS AND PAD PREPARATIONS.
- SEE GEOTECHNICAL REPORT FOR ALL FLATWORK, VEHICULAR PAVEMENT SECTIONS, BASE AND COMPACTION REQUIREMENTS.
- THE FINAL OR SURFACE LAYER OF ASPHALT CONCRETE SHALL NOT BE PLACED UNTIL ALL ON-SITE IMPROVEMENTS HAVE BEEN COMPLETED, INCLUDING ALL GRADING, AND ALL UNACCEPTABLE CONCRETE WORK HAS BEEN REMOVED AND REPLACED, UNLESS OTHERWISE APPROVED BY THE CITY/COUNTY ENGINEER AND/OR DEVELOPER'S CIVIL ENGINEER.
- ALL PAVING SHALL BE IN CONFORMANCE WITH SECTION 26 "AGGREGATE BASE" AND SECTION 27 "ASPHALT CONCRETE" PER LATEST EDITION OF CALTRANS STANDARD SPECIFICATIONS.

GENERAL UTILITY SYSTEM NOTES :

- UNDERGROUND UTILITIES OR STRUCTURES ARE SHOWN IN THEIR APPROXIMATE LOCATION. LOCATIONS ARE BASED UPON FIELD OBSERVATION ONLY. NO GUARANTEE IS MADE TO THE ACCURACY OR COMPLETENESS OF THE INFORMATION SHOWN. THE CONTRACTOR SHALL VERIFY THE TYPE, SIZE, LOCATION AND DEPTH OF ALL THE UTILITIES AND CROSSINGS TO ENSURE THEY ARE CORRECT AS SHOWN. THE CONTRACTOR SHALL EXERCISE CAUTION WHEN EXCAVATING AND SHALL PROTECT ALL EXISTING UTILITIES FROM DAMAGE DUE TO CONSTRUCTION OPERATIONS.
- CONTRACTOR SHALL PREPARE AN ACCURATE COMPOSITE UTILITY PLAN THAT TAKES INTO ACCOUNT THE ACTUAL LOCATIONS OF EXISTING UTILITIES AS DETERMINED DURING THE DEMOLITION WORK, AND ALL PROPOSED UTILITIES SHOWN ON THE CIVIL, ELECTRICAL, JOINT TRENCH AND FIRE SPRINKLER DRAWINGS.
- THE CONTRACTOR SHALL BE RESPONSIBLE FOR CONTACTING APPROPRIATE UTILITIES AND REQUESTING VERIFICATION OF SERVICE POINTS, FIELD VERIFICATION OF LOCATION, SIZE, DEPTH, ETC. FOR ALL THEIR FACILITIES AND TO COORDINATE WORK SCHEDULES.
- CONTRACTOR SHALL REPLACE ALL COVERS AND GRATE LIDS FOR MANHOLES, VAULTS, CATCH BASINS, ETC., WITH VEHICULAR-RATED STRUCTURES IN ALL TRAFFIC ACCESSIBLE AREAS.
- TRENCHES SHALL NOT BE LEFT OPEN OVERNIGHT IN EXISTING PUBLIC STREET AREAS. CONTRACTOR SHALL BACKFILL TRENCHES, OR PLACE STEEL PLATING WITH ADEQUATE CUTBACK TO PREVENT SHIFTING OF STEEL PLATE AND/OR HOT-MIX ASPHALT REQUIRED TO PROTECT OPEN TRENCHES AT THE END OF THE WORKING DAY.
- ALL TRENCHES SHALL BE BACK FILLED PER THE SPECIFICATIONS WITH APPROPRIATE TESTS BY THE GEOTECHNICAL ENGINEER TO VERIFY COMPACTION VALUES.
- CLEAN OUTS, CATCH BASINS, MANHOLES, AREA DRAINS AND UTILITY VAULTS ARE TO BE ACCURATELY LOCATED BY THEIR RELATIONSHIP TO THE BUILDING, FLATWORK, ROOF DRAINS, AND/OR CURB LAYOUT, NOT BY THE LENGTH OF PIPE SPECIFIED IN THE DRAWINGS (WHICH IS APPROXIMATE). CONTRACTOR SHALL STAKE LOCATIONS OF ABOVE GROUND UTILITY EQUIPMENT (BACKFLOW PREVENTOR, TRANSFORMER, UTILITY METERS, ETC.) AND MEET WITH OWNER TO REVIEW LOCATION PRIOR TO INSTALLATION.
- ALL UTILITY SYSTEMS (SANITARY SEWER, STORM DRAIN, WATER SYSTEM, ETC.) ARE DELINEATED IN A SCHEMATIC MANNER ON THESE PLANS. CONTRACTOR IS TO PROVIDE ALL FITTINGS, ACCESSORIES AND WORK NECESSARY TO COMPLETE THE UTILITY SYSTEM SO THAT IT IS FULLY FUNCTIONING FOR THE PURPOSE INTENDED.
- CONTRACTOR SHALL VERIFY ALL EXISTING INVERT ELEVATIONS FOR STORM DRAIN AND SANITARY SEWER CONSTRUCTION PRIOR TO COMMENCEMENT OF ANY WORK. ALL WORK FOR STORM AND SANITARY SEWER INSTALLATION SHALL BEGIN AT THE DOWNSTREAM CONNECTION POINT TO ALLOW FOR ANY NECESSARY ADJUSTMENTS TO BE MADE PRIOR TO THE INSTALLATION OF THE ENTIRE LINE. IF THE CONTRACTOR FAILS TO BEGIN AT THE DOWNSTREAM CONNECTION POINT AND WORKS UP STREAM, HE SHALL PROCEED AT HIS OWN RISK AND BE RESPONSIBLE FOR ANY ADJUSTMENTS NECESSARY. CONTRACTOR SHALL VERIFY LOCATION OF SANITARY SEWER LATERAL WITH OWNER PRIOR TO CONSTRUCTION.
- CONTRACTOR SHALL UNCOVER AND EXPOSE ALL EXISTING UTILITIES WHERE THEY ARE TO BE CROSSED ABOVE OR BELOW BY THE NEW FACILITY BEING CONSTRUCTED IN ORDER TO VERIFY THE GRADE AND TO ASSURE THAT THERE IS SUFFICIENT HORIZONTAL AND VERTICAL CLEARANCE. BRING ANY DISCREPANCIES TO THE ATTENTION OF THE CIVIL ENGINEER PRIOR TO INSTALLATION.
- VERTICAL SEPARATION REQUIREMENTS:

A MINIMUM OF SIX (6) INCHES VERTICAL CLEARANCE SHALL BE PROVIDED BETWEEN CROSSING UTILITY PIPES, EXCEPT THAT THE MINIMUM VERTICAL CLEARANCE BETWEEN WATER AND SANITARY SEWER PIPELINES SHALL BE 12 INCHES AND ALL NEW WATER PIPES SHALL BE TYPICALLY INSTALLED TO CROSS ABOVE/OVER EXISTING SANITARY SEWER PIPELINES.

WHERE NEW WATER PIPELINES ARE REQUIRED TO CROSS UNDER EXISTING AND/OR NEW SANITARY SEWER PIPELINES, THE MINIMUM VERTICAL SEPARATION SHALL BE 12 INCHES. WATER LINE PIPE ENDS SHALL BE INSTALLED NO CLOSER THAN 10' MINIMUM HORIZONTAL DISTANCE FROM CENTERLINE OF UTILITY CROSSINGS, WHERE FEASIBLE.

HORIZONTAL SEPARATION REQUIREMENTS:

A MINIMUM HORIZONTAL SEPARATION BETWEEN NEW PIPELINES AND ANY EXISTING UTILITIES SHALL BE 5' FEET, EXCEPT THAT THE MINIMUM HORIZONTAL SEPARATION FOR WATER AND SANITARY SEWER PIPELINES SHALL BE 10' MINIMUM, UNLESS OTHERWISE NOTED. WHERE WATER LINES HAVE TO CROSS SANITARY SEWER LINES, DO SO AT A 90° ANGLE AND WATER LINES SHALL BE A MINIMUM OF 12" ABOVE TOP OF SANITARY SEWER LINES.

A MINIMUM HORIZONTAL SEPARATION BETWEEN NEW PIPELINES AND JOINT TRENCH SHALL BE 5 FEET.

SANITARY SEWER NOTES:

- USE DETECTABLE METALIZED WARNING TAPE APPROXIMATELY 6" BELOW THE SURFACE. TAPE SHALL BE A BRIGHT COLOR AND IMPRINTED WITH "CAUTION-BURIED SANITARY SEWER LINE BELOW".
- ALL SEWER WORK SHALL BE IN CONFORMANCE WITH THE CITY OR APPROPRIATE SANITARY SEWER DISTRICT.
- PUBLIC AND PRIVATE SANITARY SEWER MAIN AND SERVICE LINE 4-INCH THROUGH 8-INCH WITH A MINIMUM OF TWENTY FOUR (24) INCHES OF COVER SHALL BE POLYVINYL CHLORIDE (PVC) SDR 26 GREEN SEWER PIPE AND SHALL CONFORM TO THE REQUIREMENTS OF ASTM DESIGNATION D 3034-73 WITH GLUED JOINTS. ALL DIRECTION CHANGES SHALL BE MADE WITH WYE CONNECTIONS, 22.5° ELBOWS OR 45° ELBOWS, 90° ELBOWS AND TEE'S ARE PROHIBITED.
- ALL LATERALS SHALL HAVE A CLEANOUT AT FACE OF BUILDING, AT THE PROPERTY LINE AND AS SHOWN ON PLANS PER THE CITY STANDARD OR APPROPRIATE SANITARY SEWER DISTRICT.
- ABANDON EXISTING SEWER LATERAL AS FOLLOWS: PLUG WITH NON SHRINK GROUT A MINIMUM OF 5' AT BOTH THE UPSTREAM AND DOWNSTREAM SIDES OF ALL PIPE SEGMENTS TO BE ABANDONED. UPPER PIPE SECTIONS TO BE PLUGGED MAY REQUIRE INSTALLING SOMETHING IN THE PIPE TO PREVENT NON SHRINK GROUT FROM FLOWING FURTHER DOWN THE ABANDONED MAIN, IN LIEU OF FILLING THE ENTIRE PIPE SECTION WITH NON SHRINK GROUT.

SITE MAINTENANCE

- UPON PROJECT COMPLETION THE OWNER SHALL BE SOLELY RESPONSIBLE TO ROUTINELY INSPECT AND MAINTAIN ALL ON-SITE STORM DRAIN FACILITIES. STORM DRAIN FACILITIES INCLUDE RAIN GUTTERS, ROOF GUTTERS AND DOWNSPOUTS, SURFACE DRAINS, FLOW-THRU PLANTER AND DISCHARGE POINTS (BUBBLE UP BOX, CURB DRAIN). STORM DRAIN SYSTEM SHALL BE CLEANED AND/OR FLUSHED ON A BIANNIAL BASIS OR AS FOUND NECESSARY.

PUBLIC WORKS CONDITIONS:

- ANY WORK IN THE CITY RIGHT-OF-WAY, SUCH AS STREET, SIDEWALK AREA, PUBLIC EASEMENTS, UTILITY EASEMENTS, OR USE OF THE RIGHT-OF-WAY SUCH AS PLACEMENT OF DEBRIS BOX OR CONSTRUCTION PARKING IS REQUIRED TO OBTAIN AN ENCROACHMENT PERMIT PRIOR TO STARTING WORK. FOR REQUIREMENTS RELATED TO ISSUANCE OF AN ENCROACHMENT PERMIT, VISIT: [HTTPS://WWW.BURLINGAME.ORG/DEPARTMENTS/PUBLIC_WORKS/ENCROACHMENT_PERMIT](https://www.burlingame.org/departments/public_works/encroachment_permit) PHP WORK WITHOUT THE BENEFIT OF AN ENCROACHMENT PERMIT WILL BE CHARGED DOUBLE THE PERMIT FEE.
- ALL WORK WITHIN CITY RIGHT-OF-WAY SHALL COMPLY WITH CITY STANDARDS AND DETAILS. STANDARD DETAILS ARE AVAILABLE AT: [HTTPS://WWW.BURLINGAME.ORG/DEPARTMENTS/PUBLIC_WORKS/CITY_STANDARD_DETAILS.PHP](https://www.burlingame.org/departments/public_works/city_standard_details.php).
- PUBLIC WORKS CONSTRUCTION HOURS IN THE RIGHT-OF-WAY ARE LIMITED TO WEEKDAYS AND NON-CITY HOLIDAYS BETWEEN 8:00 A.M. AND 5:00 P.M. THIS INCLUDES CONSTRUCTION HAULING. IF APPLICANT/CONTRACTOR WISHES TO WORK BEYOND THE NORMAL CONSTRUCTION HOURS, A WAIVER OF WORKING HOUR FORM MAY BE SUBMITTED TO THE PUBLIC WORKS DEPARTMENT TEN (10) WORKING DAYS IN ADVANCE FOR REVIEW AND APPROVAL BY PUBLIC WORKS AND BUILDING DEPARTMENT.
- FOR PROJECTS IN THE BURLINGAME PLAZA, BROADWAY, AND BURLINGAME DOWNTOWN DISTRICTS: CONSTRUCTION IN THE PUBLIC RIGHT-OF-WAY IS PROHIBITED DURING THE HOLIDAY SHOPPING MORATORIUM PERIOD, FROM FIRST SATURDAY OF NOVEMBER THROUGH THE FIRST SATURDAY AFTER NEW YEAR'S DAY.
- FOR DOWNTOWN BURLINGAME AVENUE PROJECTS, PER CITY OF BURLINGAME MUNICIPAL CODE 12.05, ANY WORK WITHIN THE PUBLIC RIGHT-OF-WAY SHALL REQUIRE APPROVAL FROM THE PUBLIC WORKS DEPARTMENT AND SHALL COMPLY WITH THE FOLLOWING SPECIAL CONDITIONS, SPECIFICATIONS, DETAILS, AND CONSTRUCTION MORATORIUM.
- FOR PROJECTS FACING EL CAMINO REAL: ANY WORK IN THE CALTRANS RIGHT-OF-WAY, SUCH AS STREET AND SIDEWALK AREA IS REQUIRED TO OBTAIN AN ENCROACHMENT PERMIT FROM CALTRANS PRIOR TO STARTING WORK. IT IS THE APPLICANT'S RESPONSIBILITY TO OBTAIN ALL REQUIRED PERMITS.
- NO STRUCTURE SHALL BE BUILT INTO CITY'S RIGHT-OF-WAY, THIS INCLUDES ALL EXISTING AND OVERHANG PROJECTIONS. ON HILLSIDE CIRCLE, THIS MEASUREMENT IS NINE AND EIGHT TENTH FEET (9'8") MEASURED FROM FACE OF CURB.
- FOR NEW SINGLE FAMILY HOMES OR REMODELS THAT ARE 50% AND GREATER: SHOW ON THE SITE PLAN - (1) REPLACEMENT OF ALL CURB, GUTTER, DRIVEWAY AND SIDEWALK FRONTING SITE, (2) PLUG ALL EXISTING SANITARY SEWER LATERAL CONNECTIONS AND INSTALL A NEW 4" LATERAL TO CITY'S SEWER CLEANOUT, (3) NEW WATER SERVICE TO WATER METER, AND WHEN APPLICABLE, (4) WATER LINES ABOVE 2" AND ALL FIRE SERVICES OF ANY SIZE ARE TO BE INSTALLED BY APPLICANT AND PER CITY STANDARD PROCEDURES AND SPECIFICATION.
- SEWER BACKWATER PROTECTION CERTIFICATION IS REQUIRED FOR THE INSTALLATION OF ANY NEW SEWER FIXTURE PER ORDINANCE NO. 1710. THE SEWER BACKWATER PROTECTION CERTIFICATE IS REQUIRED PRIOR TO THE ISSUANCE OF BUILDING PERMIT AND THE BACKWATER DEVICE MUST BE PLACED ON PRIVATE PROPERTY.
- FOR REMODEL PROJECTS (LESS THAN 50% REMODEL), ALL DAMAGED AND DISPLACED CURB, GUTTER, SIDEWALK, AND DRIVEWAY APPROACH FRONTING SITE MUST BE REPLACED PRIOR TO FINAL OF BUILDING PERMIT. A PRE-INSPECTION BY PUBLIC WORKS OF THE CONDITION OF THE SIDEWALK IS RECOMMENDED, BUT NOT REQUIRED, HOWEVER, IF A PRE-INSPECTION IS NOT CONDUCTED, THE APPLICANT/CONTRACTOR WAIVES THE RIGHT TO CONTRAST THE LIMITS OF THE REPAIRS CAUSED BY THE CONSTRUCTION ACTIVITIES.
- FRONT LANDSCAPE (HARDSCAPE) IMPROVEMENTS THAT ARE NOT SHOWN ON THE PLANS, THIS WILL BE SUBJECT TO A PUBLIC WORKS INSPECTION PRIOR TO BUILDING PERMIT FINAL TO CONFIRM THAT NO ENCROACHMENTS EXIST BEYOND THE PROPERTY LINE.
- IF APPLICABLE, FOR LARGE DEVELOPMENTS (4-UNITS OR MORE), OR IMPROVEMENTS IN DOWNTOWN AREA: CONTRACTOR SHALL COORDINATE A MEETING WITH THE CITY PUBLIC WORKS ENGINEERING INSPECTOR 48 HOURS PRIOR TO INITIATION OF THE SITE WORK. THE PURPOSE IS TO DISCUSS AND CLEARLY UNDERSTAND THE FOLLOWING: A. PLAN OF WORK WITHIN CITY'S RIGHT OF WAY, INCLUDING, BUT NOT LIMITED TO, HOURS OF WORK, DELIVERIES, TRAFFIC CONTROL AND/OR PEDESTRIAN ACCESS WITHIN PUBLIC RIGHT OF WAY, SIDEWALK ISSUES, PARKING, STORAGE, LOADING OF MATERIALS, REPAIR OF DAMAGED PUBLIC FACILITIES SUCH AS SIDEWALK, ROAD PAVEMENT, ETC., AND COORDINATION WITH CITY PROJECTS WITHIN THE VICINITY. B. CONTRACTOR SHALL PROVIDE FIELD CONTACT NAMES AND NUMBERS OF RESPONSIBLE FIELD PERSONNEL.
- THE PROJECT SHALL COMPLY WITH THE CITY'S NPDES PERMIT REQUIREMENTS TO PREVENT STORM WATER POLLUTION. ALL CONSTRUCTION WORK SHALL BE DONE IN ACCORDANCE WITH THE MOST CURRENT APWA-AGC STANDARD SPECIFICATIONS FOR PUBLIC WORKS CONSTRUCTION, THE CALIFORNIA STORMWATER QUALITY ASSOCIATION'S STORMWATER BEST MANAGEMENT PRACTICE HANDBOOK, AND THE CITY OF BURLINGAME STORMWATER MANAGEMENT AND DISCHARGE CONTROL ORDINANCE (MUNICIPAL CODE CHAPTER 15.14). A COPY OF THE STORMWATER CONSTRUCTION BEST MANAGEMENT PRACTICES CAN BE FOUND AT [HTTP://WWW.FLOWSTOBAY.ORG/BROCHURES](http://www.flowstobay.org/brochures). UPON COMPLETION OF THE WORK, ALL STORMWATER PROTECTION MEASURES SHALL BE ENTIRELY REMOVED AND THE RIGHT-OF-WAY SHALL BE LEFT IN AS PRESENTABLE A CONDITION AS EXISTED BEFORE WORK STARTED. PLEASE BE AWARE THAT DURING WINTER MONTHS (OCTOBER 15TH TO APRIL 15TH) APPLICANT/CONTRACTOR ARE RESPONSIBLE TO REMOVE PROJECTS STORMWATER INLET PROTECTION DEVICES(S) (SANDBAGS/FILTERS/ETC.) IN THE PUBLIC RIGHT-OF-WAY TO PREVENT FLOODING DURING RAIN EVENTS, AND REINSTALL DEVICES ONCE THE RAIN EVENT ENDS. ALL PRIVATE PROPERTY STORMWATER PROTECTION MEASURES MUST BE PROTECTED AND REPAIRED AFTER EACH RAIN EVENT.
- PER MUNICIPAL CODE SECTION 18.08.090, NO STORM WATER OR UNDERGROUND WATER DRAINING FROM ANY LOT, BUILDING, OR PAVED AREA SHALL BE ALLOWED TO DRAIN TO ADJACENT PROPERTIES NOR SHALL THIS WATER BE CONNECTED TO THE CITY'S SANITARY SEWER SYSTEM. REGARDLESS OF THE SLOPE OF THE SOURCE PROPERTY, SUCH WATER SHALL DRAIN TO EITHER ARTIFICIAL OR NATURAL STORM DRAINAGE FACILITIES BY GRAVITY OR PUMPING.
- ALL WATER LINES CONNECTIONS TO CITY WATER MAINS FOR SERVICES OR FIRE LINE PROTECTION ARE TO BE INSTALLED PER CITY STANDARD PROCEDURES AND MATERIAL SPECIFICATIONS. CONTACT THE CITY'S WATER DEPARTMENT FOR CONNECTION FEES, DOMESTIC WATER SERVICES 2" AND OVER SHALL BE INSTALLED BY BUILDER.
- IF REQUIRED, ALL FIRE SERVICES SHALL BE INSTALLED BY BUILDER. ALL UNDERGROUND FIRE SERVICE CONNECTIONS SHALL BE SUBMITTED AS SEPARATE UNDERGROUND FIRE SERVICE PERMIT FOR REVIEW AND APPROVAL.
- ALL DEBRIS/GARBAGE CONTAINERS LOCATION SHALL BE ON PROPERTY. NO WET GARBAGE FLUID SHALL ENTER PUBLIC RIGHT-OF-WAY OR THE STORM DRAIN SYSTEM.
- PORTA POTTY'S MUST BE PLACED ON PRIVATE PROPERTY AND ARE NOT ALLOWED IN THE PUBLIC RIGHT-OF-WAY.
- IT IS THE RESPONSIBILITY OF THE OWNER AND/OR CONTRACTOR TO NOTIFY UNDERGROUND SERVICE ALERT (USA) AT LEAST 48 HOURS BEFORE THE START OF ANY EXCAVATION WORK.

PRECISION ENGINEERING AND CONSTRUCTION, INC.



T: 650.226.8640
E: Travis@precision-ec.com

1331B Old County Road
Burlingame, CA 94002

| | | | |
|------------|---------------|--|--|
| DATE: | 07/09/2025 | | |
| REVISIONS: | CITY COMMENTS | | |
| | | | |



NOTES SHEET

NEW RESIDENCE

1385 HILLSIDE CIRCLE LOT 3

BURLINGAME, CA 94010

Date: 05/28/2025

Scale: NONE

Design: AJP


Check: TRL

Drawing Number: C-1

PEC Job No. PEC 25-033

FOR CONTINUATION SEE SHEET C-2.1

GRADING PLAN

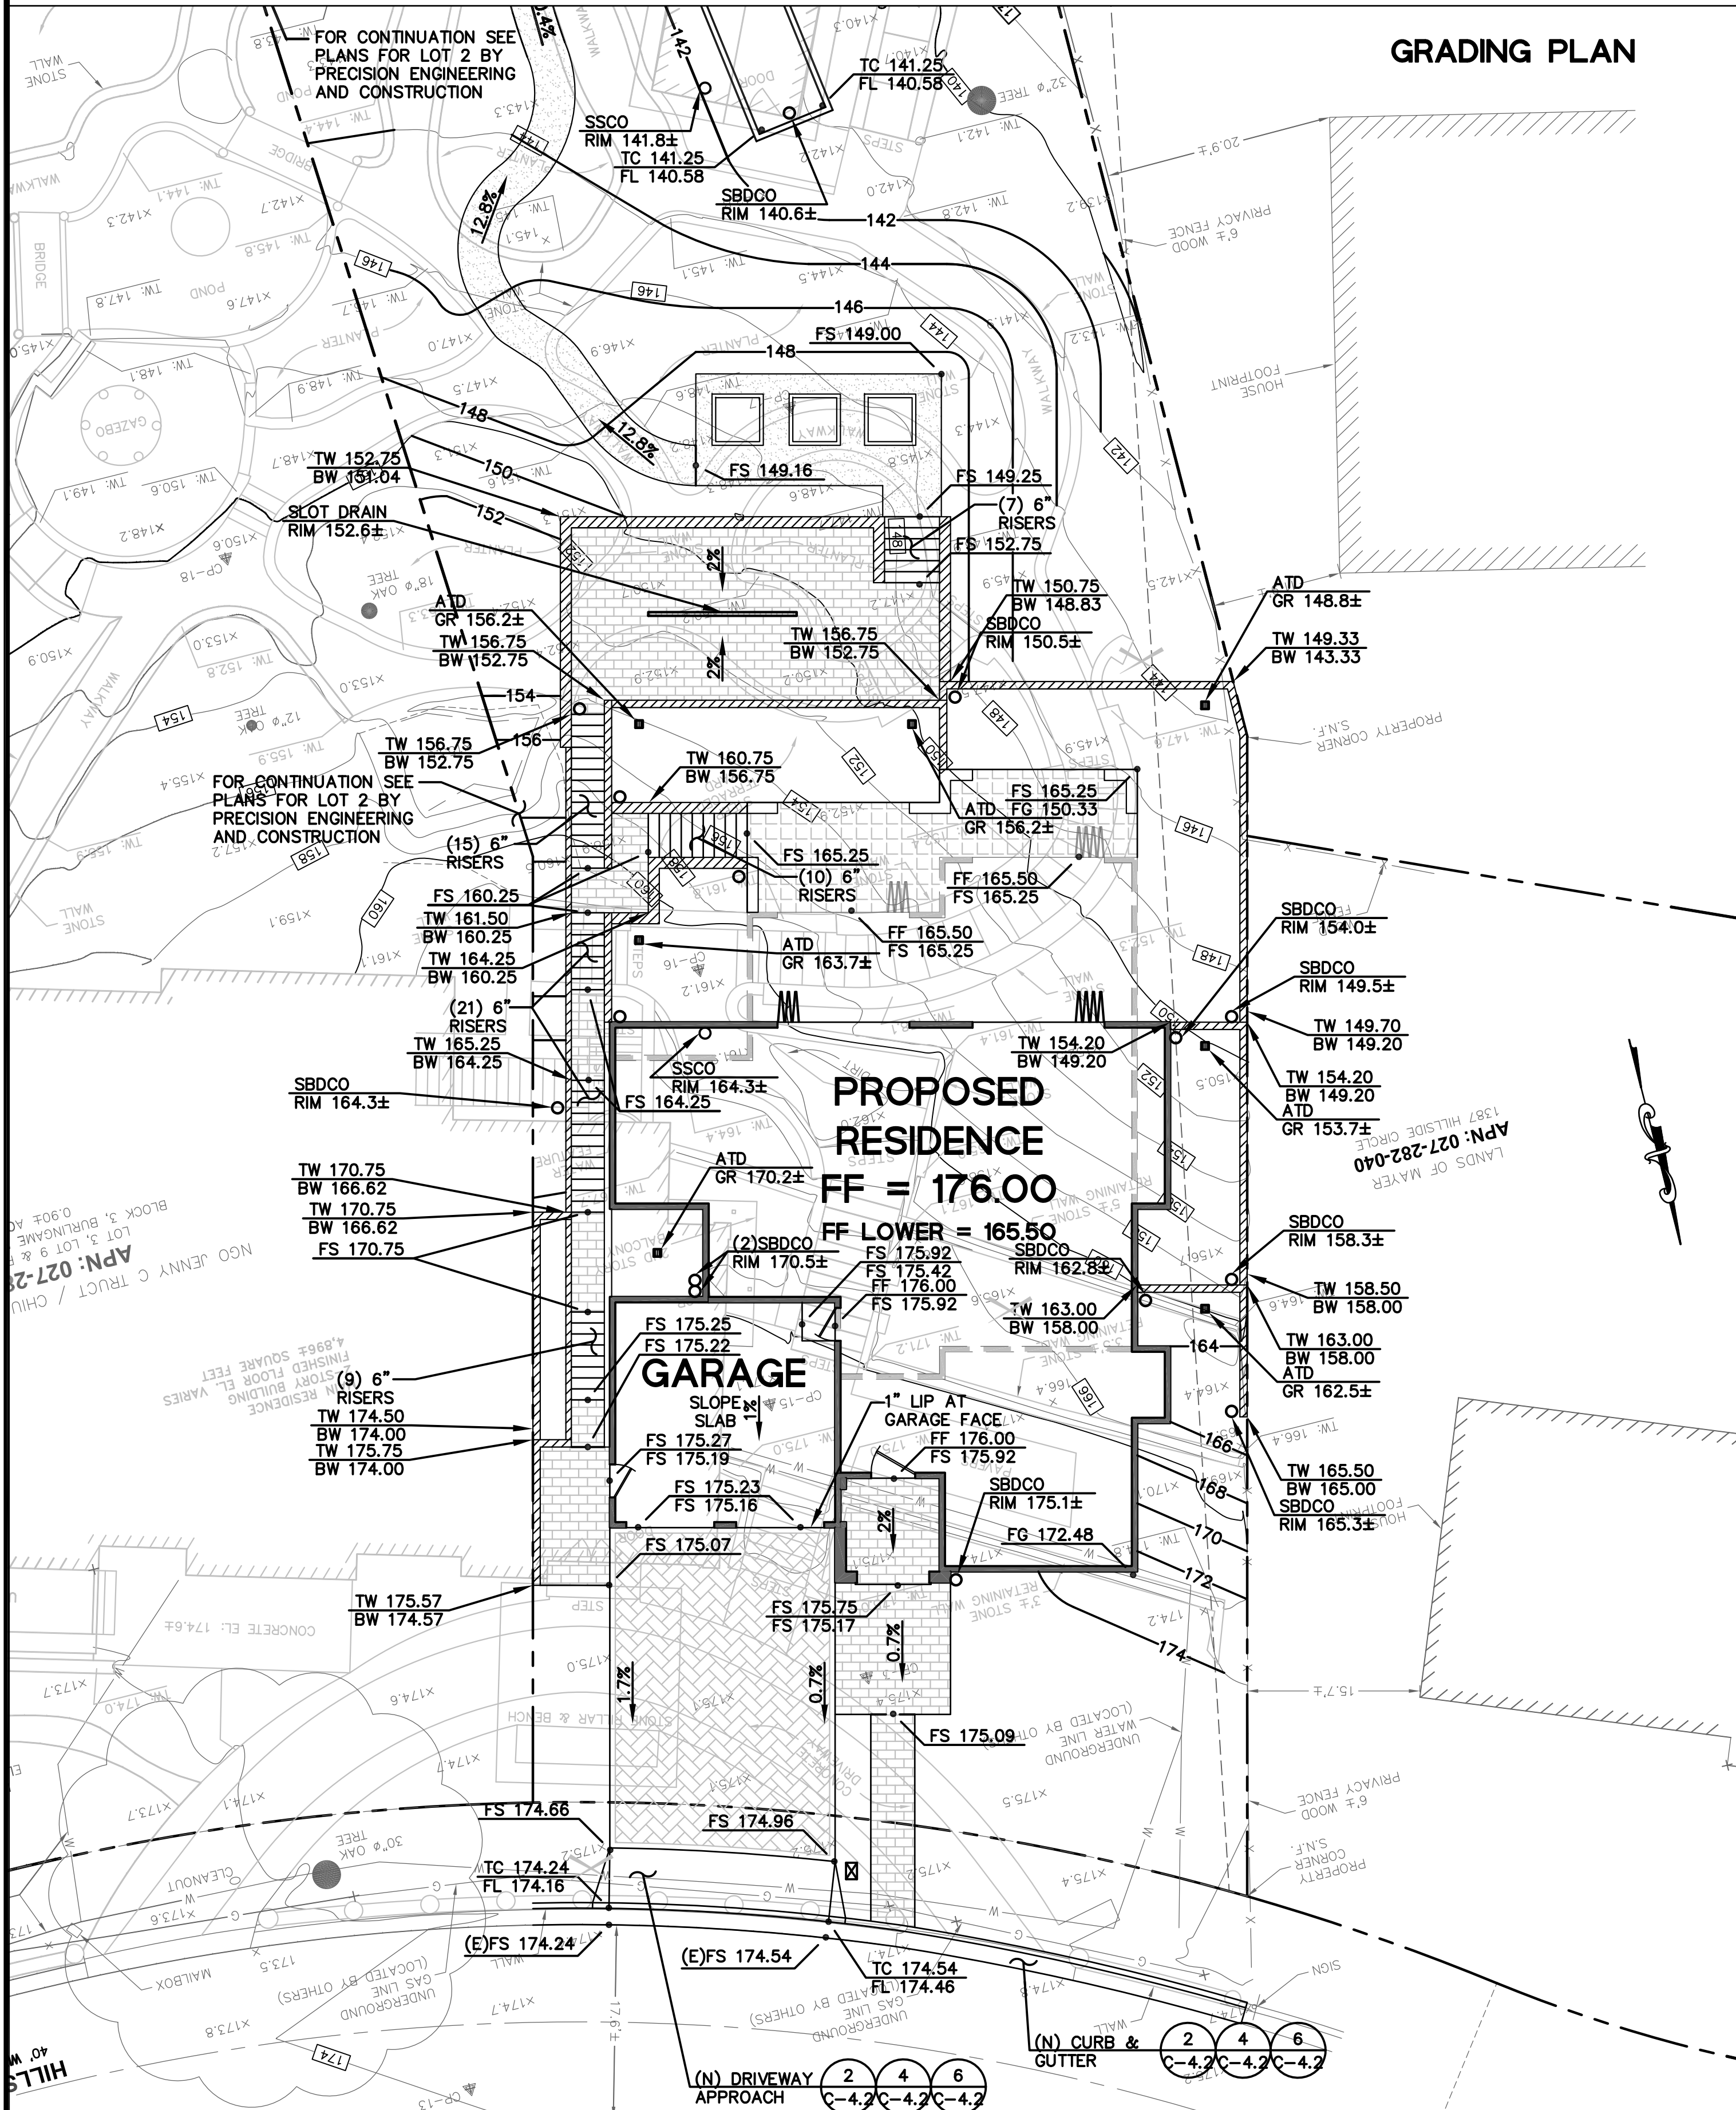

PAVEMENT LEGEND:

SEE GEOTECHNICAL REPORT BY GEOPROFESSIONAL, INC. DATED AUGUST 2024 FOR EXACT PAVEMENT SECTIONS, OVER-EXCAVATION AND COMPACTION REQUIREMENTS. SEE ARCHITECTURAL PLAN(S) FOR EXACT MATERIAL SELECTION.


| | | | | | |
|--|------------------|--|---------|--|------|
| | PAVERS | | BALCONY | | SAP. |
| | PERMEABLE PAVERS | | DG | | SLP. |

PAVER UNIT OVER A THIN LEVELING COURSE OF SAND OVER 8" MIN OF CLASS II AGGREGATE BASE. INSTALL PER MANUFACTURERS RECOMMENDATIONS. COLOR AND TYPE TO BE APPROVED BY THE OWNER PRIOR TO INSTALLATION. INSTALL EDGE CONSTRAINT SUCH AS A FLUSH CURB. SLP.


PERMEABLE PAVEMENT UNIT OVER 2" OF #8 BEDDING OVER 4" OF #57 OPEN GRADED AGGREGATE BASE OVER 6" OF #2 STONE SUBBASE. INSTALL EDGE CONSTRAINT SUCH AS A FLUSH CURB. SLP.

FOR CONTINUATION SEE SHEET C-2.1

UTILITY PLAN

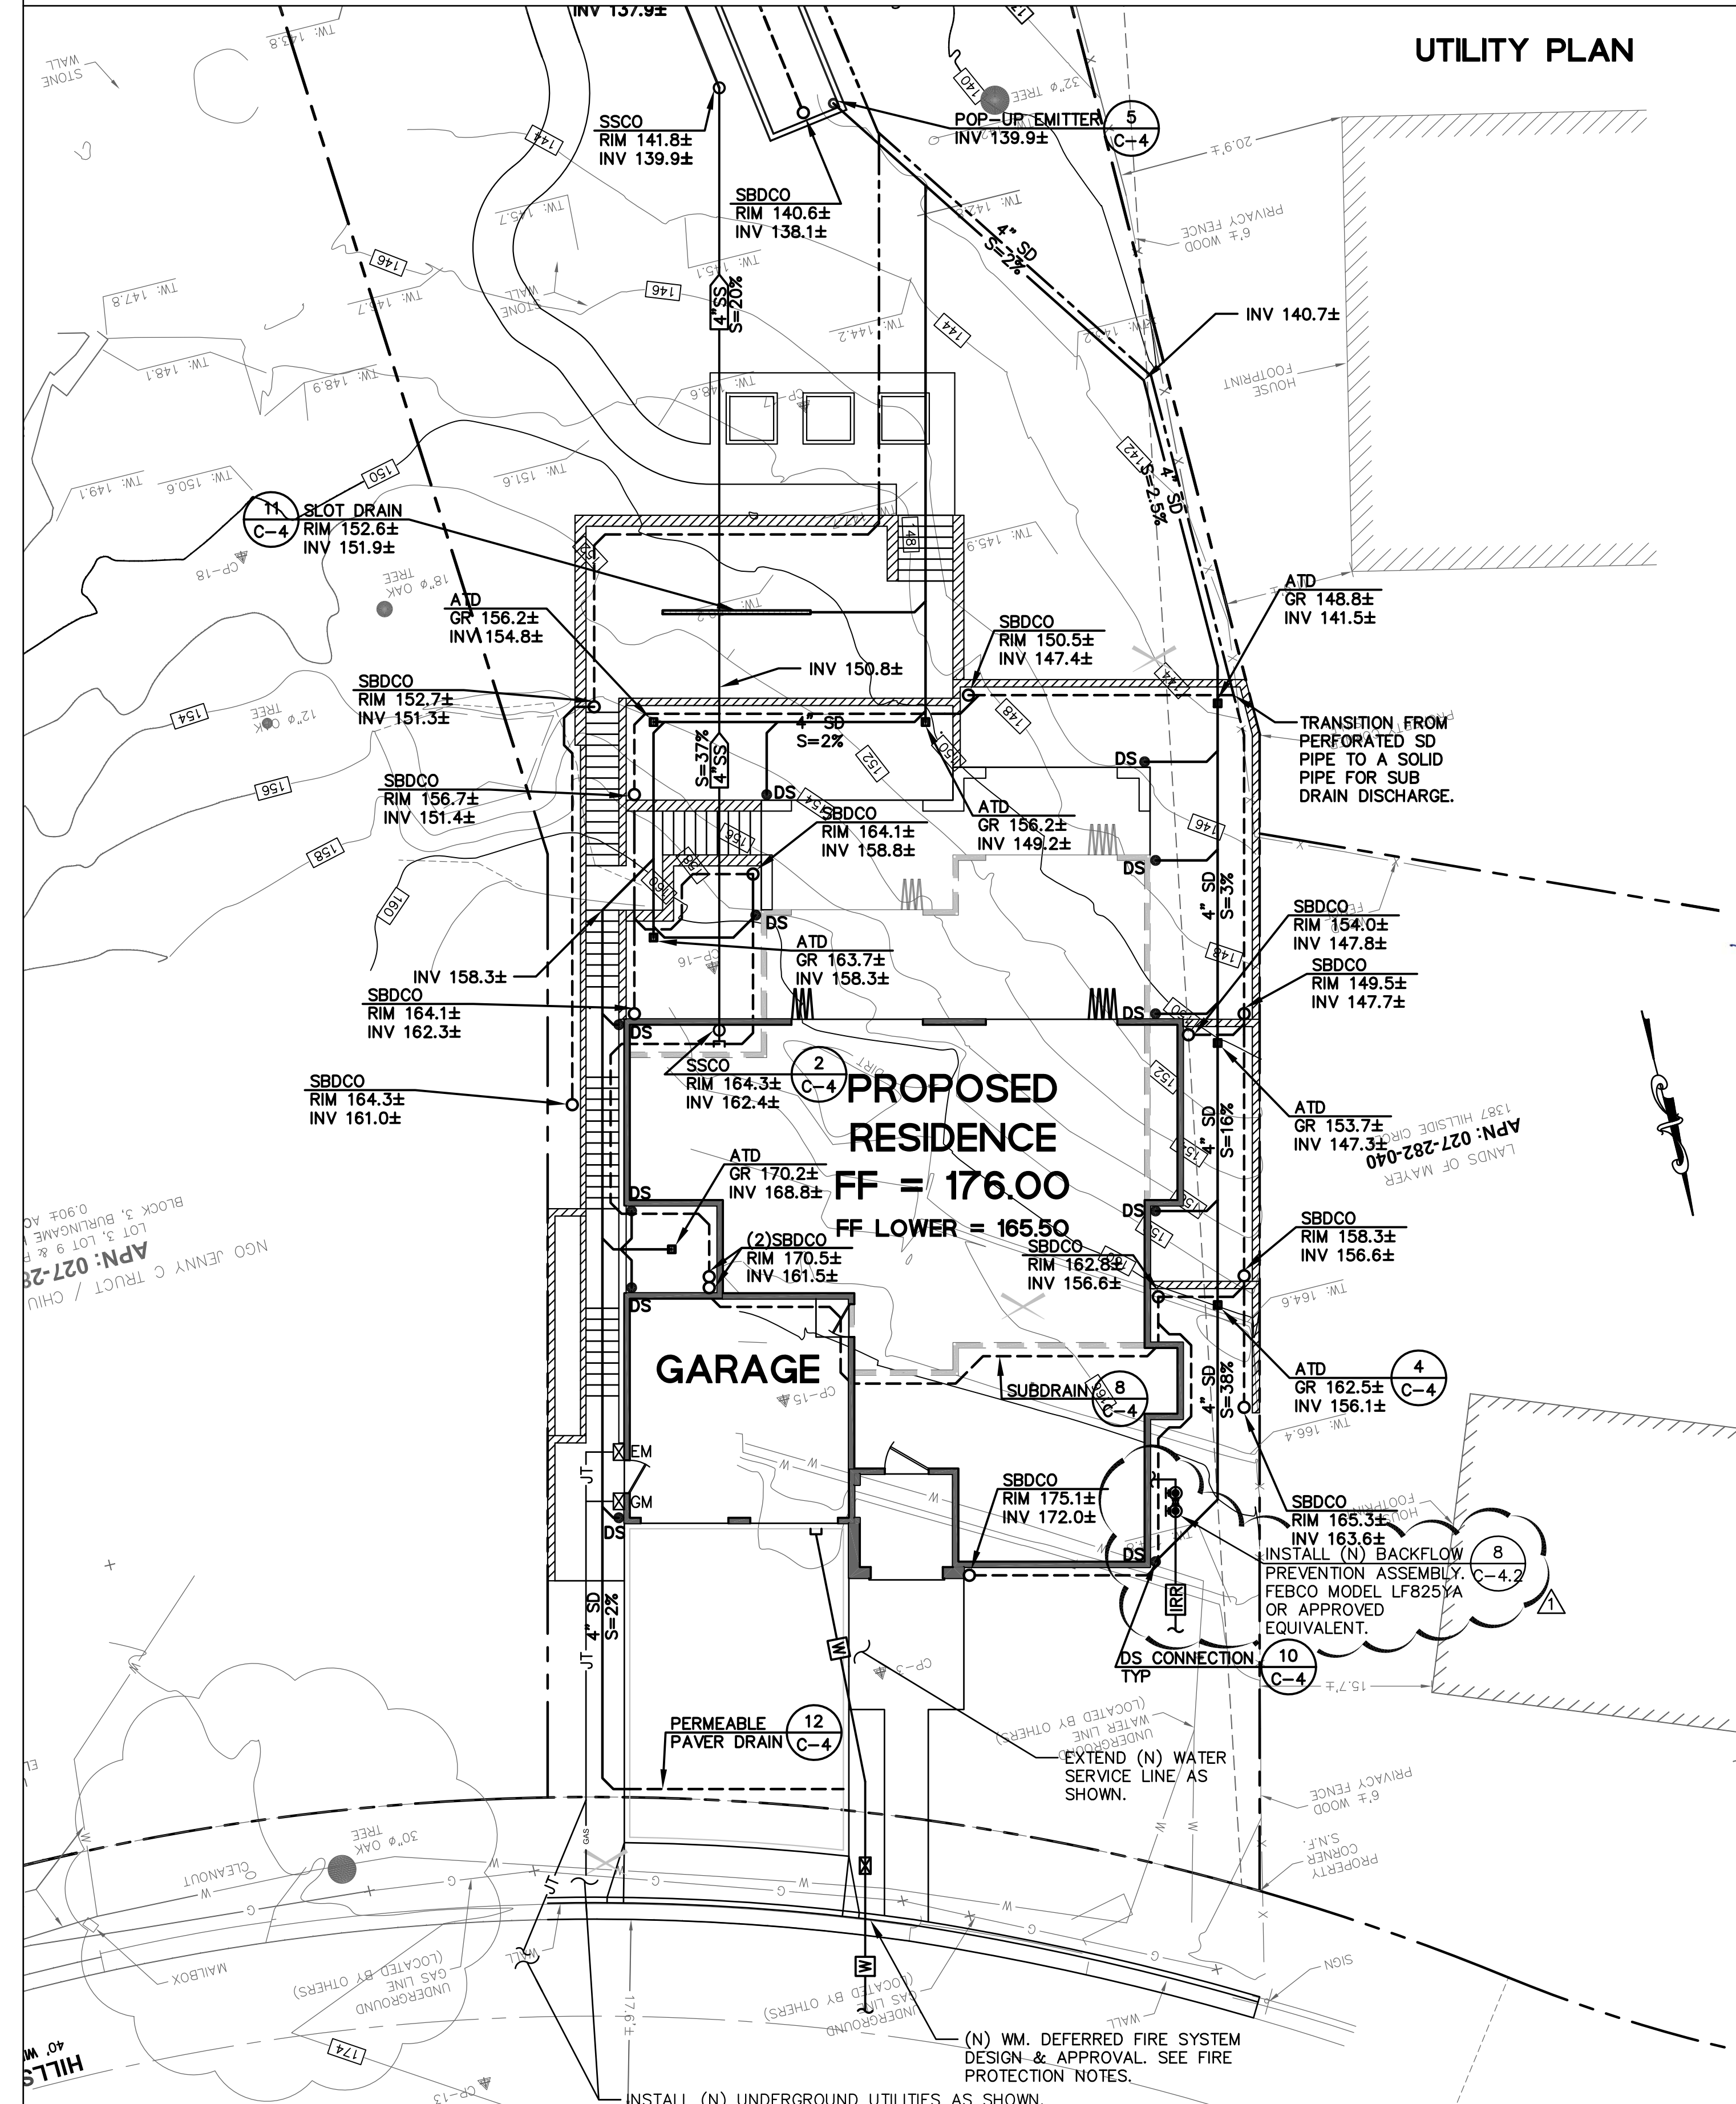

SEE SHEET C-0 FOR
LEGEND AND SHEET
C-1 FOR NOTES

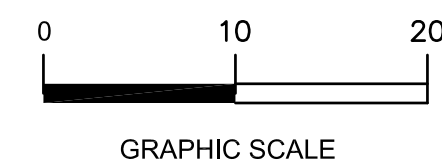

GRADING AND UTILITY PLAN
NEW RESIDENCE
1385 HILLSIDE CIRCLE LOT 3
BURLINGAME, CA 94010


Date: 05/28/2025
Scale: 1" = 10'
Design: AJP
Check: TRL
Drawing Number: C-2
PEC Job No.: PEC 25-033








REVISIONS:

DATE: 07/09/2025

PRECISION ENGINEERING
AND
CONSTRUCTION, INC.
13318 Old County Road
Belmont, CA 94002
T: 650.226.8640
travis@precision-ec.com

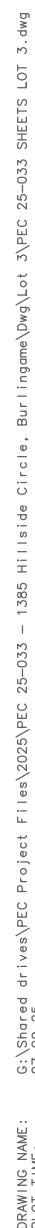

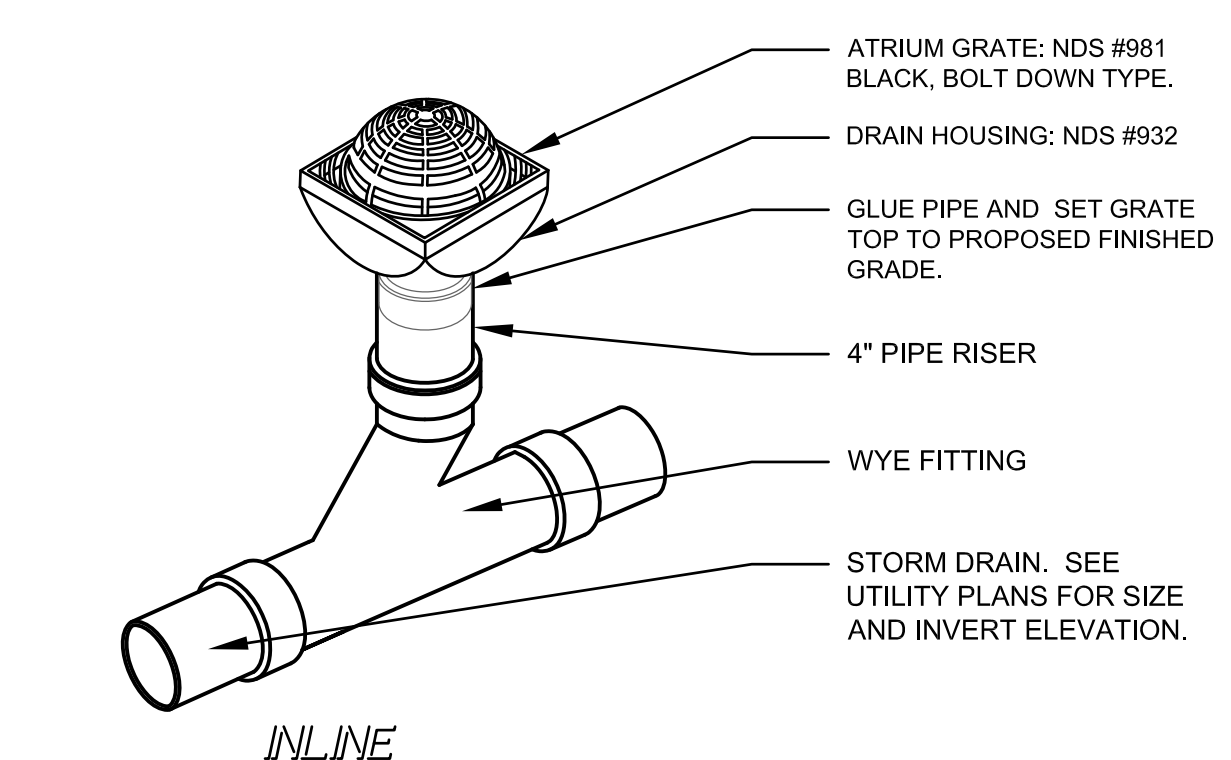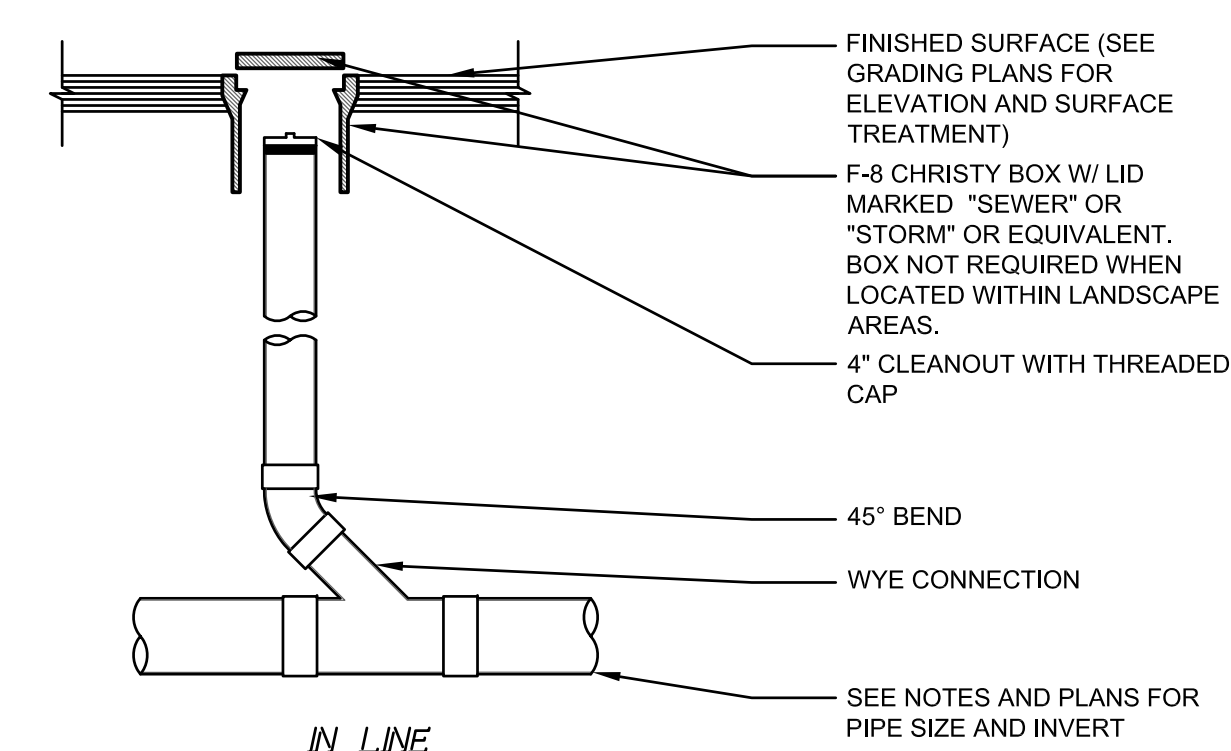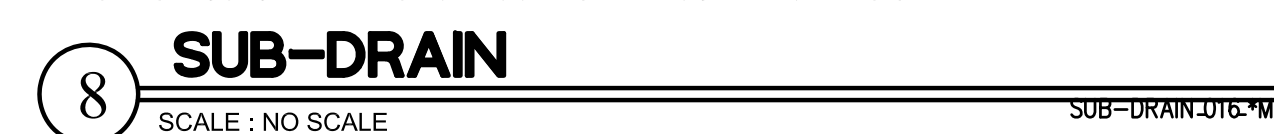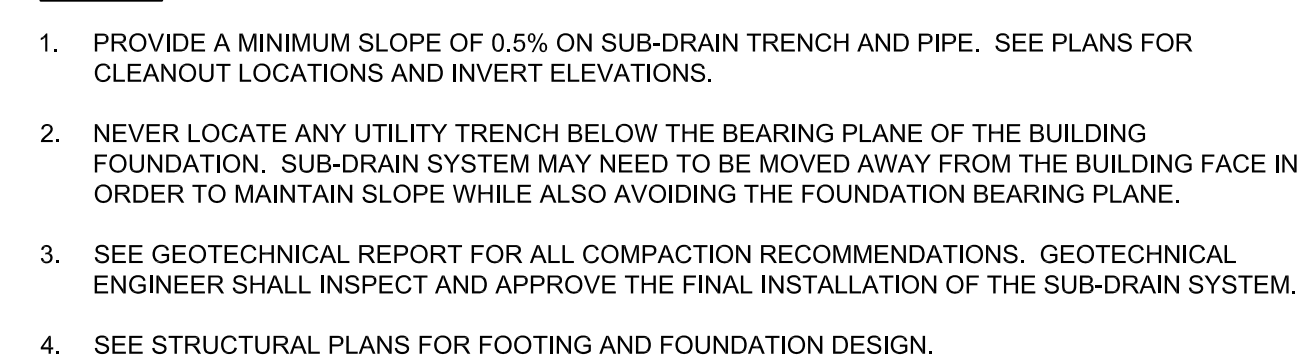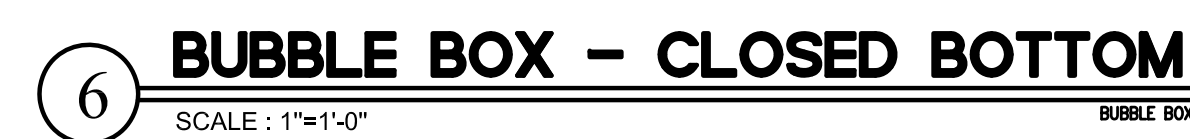


4. ALL NEW RESIDENTIAL, APARTMENT, INDUSTRIAL AND COMMERCIAL BUILDINGS SHALL REQUIRE A NEW SEWER LATERAL. A MINIMUM 4" (NOT 4") LATERAL SHALL BE INSTALLED FOR 2 OR LESS APARTMENT UNITS AND A MINIMUM 6" (NOT 6") LATERAL SHALL BE INSTALLED FOR 3 OR MORE APARTMENT UNITS. ALL NEW BUILDINGS SHALL BE CONNECTED "FUTURE UNITS" IN BUILDINGS. ALL NEW INDUSTRIAL AND COMMERCIAL BUILDINGS SHALL REQUIRE A MINIMUM 8" (NOT 8") LATERAL.
5. THE LATERAL, INCLUDING CONNECTION TO THE MAIN, RISE AND WYE, SHALL BE CAST IRON, PLASTIC SD-28, HIGH DENSITY POLYETHYLENE (HDPE), C-900, OR VITRIFIED CLAY PIPE IN CONFORMANCE WITH UNIFORM CODE, SECTION 105.01. ALL LATERALS SHALL BE 10' MINIMUM DEPTH. 3/8" IS NOT RECOMMENDED BECAUSE LIQUIDS TEND TO DRAIN AWAY, LEAVING SOLIDS TO CLOG THE MAIN.
6. A WYE CONNECTION MAY BE USED AT ANY DEPTH AND AT ANY SIZE OF MAIN. A SADDLE CONNECTION MAY BE USED ONLY AT A DEPTH OF 6 FEET (6') OR MORE AND TO A MAIN WHICH IS LARGER IN SIZE THAN THE LATERAL ITSELF.
7. A MANUFACTURER'S COUPLING WITH STAINLESS STEEL SHEAR BAND AND FOUR STRIPS SHALL BE USED FOR ALL JOINT CONNECTIONS. NO CONCRETE SHALL BE USED FOR JOINT CONNECTION.
8. REGARDLESS OF THE PIPE MATERIAL USED, THE BUILDING SEWER PIPE SHALL BE LAID ON A CONTINUOUS, UNBROKEN SLOPE THROUGHOUT ITS ENTIRE LENGTH.
9. THE DEPARTMENT OF PUBLIC WORKS SHALL INSPECT ALL SEWER CONNECTIONS BEFORE BACKFILLING. ALL BACKFILL MATERIALS SHALL BE APPROVED BY THE ENGINEER AND SHALL BE COMPACTED TO A MINIMUM OF 95% DENSITY. ALL EXISTING MAINS AND BOXES IN THE STREETS TWENTY FOUR (24) HOURS NOTICE SHALL BE GIVEN FOR AN INSPECTION.
10. THE LATERAL/SLT SHALL BE LOCATED ADJACENT TO AND APPROXIMATELY 2' (2') ABOVE (NOT ± 2') BACK FILL. THE LATERAL/SLT SHALL BE 6" CURB OR SHOULDER ALONG STREETS WITH EXISTENCE LINES ALONG EASEMENTS. UNLESS OTHERWISE APPROVED BY THE ENGINEER, THE LATERAL/SLT SHALL BE 12" (12") DEEP TO 12" (12") TO 1' (1') DEPTH ABOVE THE ADJACENT GRADE OR CURB GRADE. THE PAD AND SIDEWALK SHALL BE 12" (12") DEEP TO 12" (12") TO 1' (1') DEPTH ABOVE THE ADJACENT GRADE OR CURB GRADE. THE LATERAL/SLT IS PROHIBITED FROM CROSSING OR DRIVING TO THE ELEVATION LEVEL IN PLANTING AREA. PONDING OVER THE LATERAL/SLT SHALL BE PROHIBITED. THE LATERAL/SLT SHALL BE PROTECTED BY A 24" (24") CONCRETE FENCE, SEE STANDARD DRAWING SS-1 (5 OF 6) FOR LATERAL/SLT PLACEMENT GUIDELINES.
11. ON WORK IN STREETS, PAVEMENT SHALL BE SAW CUT AND REPLACED TO THE REQUIREMENTS OF THE STANDARD SPECIFICATIONS FOR CONSTRUCTION OF PUBLIC WORKS. ALL EXISTING PAVEMENT SHALL BE EXCAVATION SHALL BE ACCOMPLISHED SO THAT TRENCH EDGES ARE STRAIGHT AND PARALLEL LINES AND THE MAINS BEFORE OR AFTER THE EXCAVATION SHALL BE PROTECTED. THE PAVEMENT SECTION SHALL BE REPLACED TO AT LEAST 60 INCHES (60") WIDE OF ANY EXCAVATION AREA.
12. ALL MAINS BEFORE OR 5 FEET (5') OF DEPTH SHALL BE SHORED OR SLOPED IN ACCORDANCE WITH O.S.H.A. REQUIREMENTS. O.S.H.A. PERMIT IS REQUIRED FOR ALL EXCAVATIONS OVER 5 FEET (5') IN DEPTH.
13. LATERAL LINES SHALL HAVE A MINIMUM COVER OF 18 INCHES (18") AND THE MAIN LINES SHALL HAVE A MINIMUM COVER OF 21 INCHES (21"). ALL MAINS SHALL HAVE THE PROPER SLOTERS IN STREET RIGHT-OF-WAY SHALL HAVE A 30 INCH (30") MINIMUM COVER.
14. ALL ABANDONED SEWER MAINS SHALL HAVE THE WYES OR SADDLES REMOVED OFF THE MAIN.



| | |
|-------------|-------------|
| APPROVED BY | DRAWING NO. |
| DR. A. DEB | SS-4 |

(14)

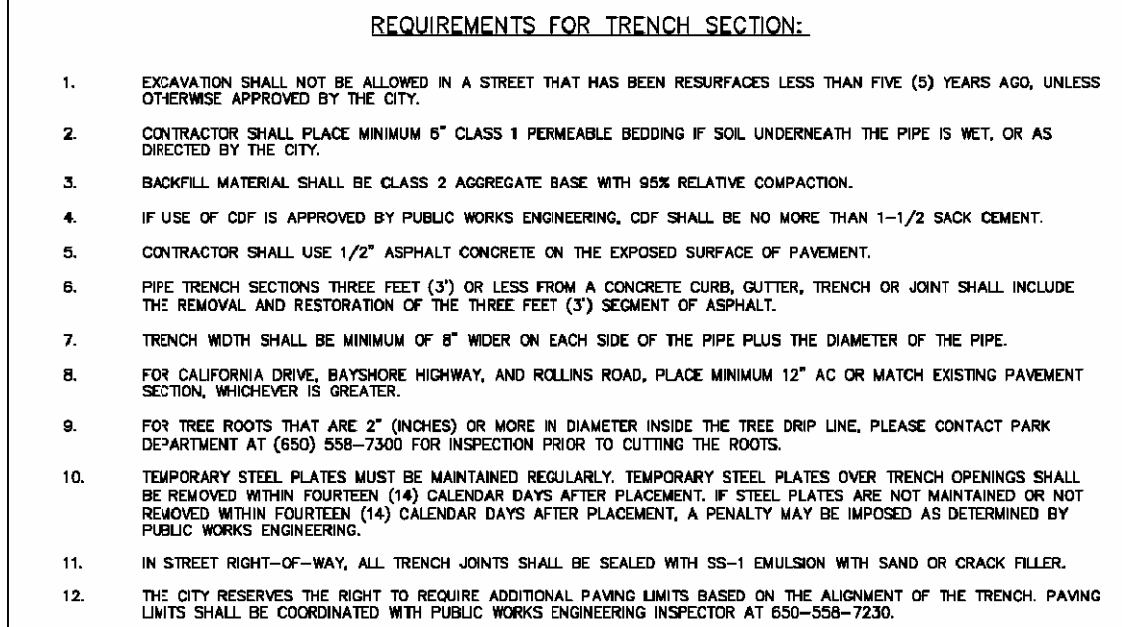

| | |
|-------------|-------------|
| APPROVED BY | DRAWING NO. |
| DATE | |

(16)




| | |
|-------------|-------------|
| APPROVED BY | DRAWING NO. |
|-------------|-------------|

(10)



| | |
|-------------|---------|
| APPROVED BY | DRAW NO |
|-------------|---------|

(6)

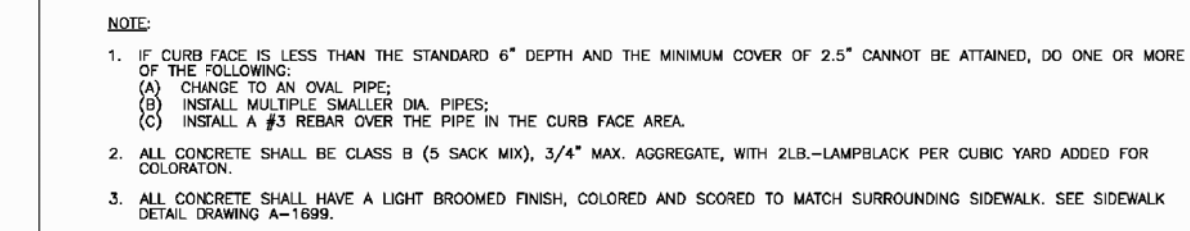


| | |
|-------------|-------------------------------|
| APPROVED BY | DRAWING NO. SW-2 |
| DATE | |

2)



| | |
|-------------|----------|
| APPROVED BY | DRAW NO. |
| DATE | SS |

(8)

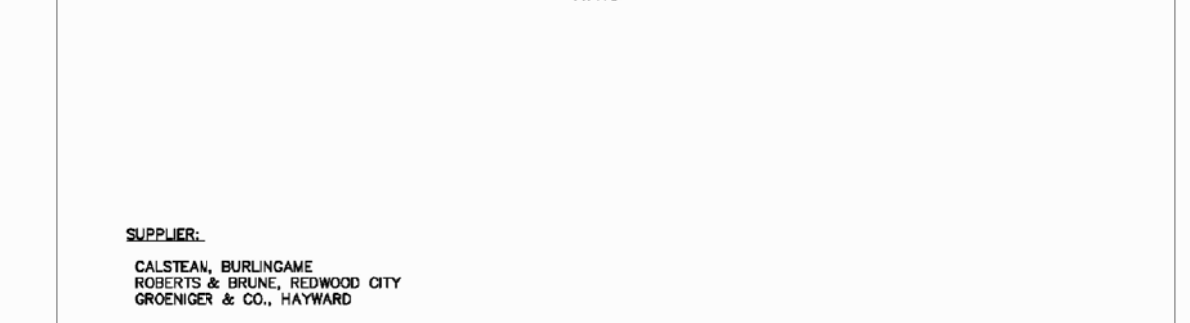

lateral Connection_2013-08-19.dwg

4




| | |
|-------------|-------------|
| APPROVED BY | DRAWING NO. |
|-------------|-------------|

(12)



| | |
|-------------|----------|
| APPROVED BY | DRAW NO. |
| DATE | SS |


(8)

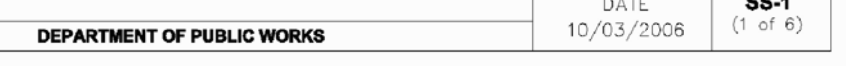

| | |
|--------------------|------------------|
| DATE 10/03/2006 | SS-1 (1 of 6) |
|--------------------|------------------|

4

| | REVISIONS: | DATE: |
|---|---------------|------------|
| 1 | CITY COMMENTS | 07/09/2025 |
| | | |
| | | |
| | | |
| | | |

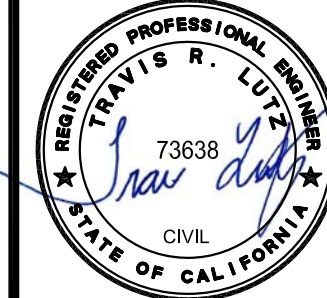

DETAIL SHEET
NEW RESIDENCE
1385 HILLSIDE CIRCLE LOT 3
BURLINGAME, CA 94010

| | |
|-----------------|-------------------|
| Date: | 05/28/2025 |
| Scale: | AS SHOWN |
| Design: | AJP |
| Check: | TRL |
| Drawing Number: | C-4.1 |
| PEC Job No. | PEC 25-033 |

REQUIREMENTS FOR CONSTRUCTION OF
SIDEWALK, DRIVEWAY, CURB AND GUTTER
(UNLESS OTHERWISE APPROVED BY ENGINEER)


- SUBGRADE SHALL BE COMPACTED TO A MINIMUM OF 90% RELATIVE COMPACTION IN SIDEWALK AREA OR 90% IN DRIVEWAY.
- ALL DRIVEWAY APPROACH RAMP SHALL BE A MINIMUM 4" WIDE MEASURED FROM FACE OF CURB EXCEPT IN THE SINGLE FAMILY AREA WHERE THE RAMP MAY MATCH EXISTING. WHERE THE PARKING STRIP WIDTH IS LESS THAN 4", THE RAMP SHALL BE CONSTRUCTED INTO SIDEWALK AREA BEHIND THE RAMP. SIDEWALK WIDTH SHALL BE A MINIMUM OF 4'-0" IN COMMERCIAL, INDUSTRIAL AND MULTI-FAMILY AREAS.
- ALL CONCRETE SHALL BE CLASS 8 (5 SACK MIX), 3/4" MAX. AGGREGATE, WITH 2LB-LAMPBLACK PER CUBIC YARD ADDED FOR COLORATION.
- SIDEWALK SHALL HAVE A LIGHT BROOMED FINISH, COLORED AND SCORED TO MATCH SURROUNDING SIDEWALK.
- EXPANSION JOINTS SHALL BE INSTALLED ON EACH SIDE OF DRIVEWAY AND A MAXIMUM AT 20' CENTERS ALONG SIDEWALKS, CURBS AND GUTTERS.
- DRIVEWAY OR SIDEWALK ADJACENT TO CURB/GUTTER SHALL BE POURED MONOLITHIC WITH CURB AND GUTTER.
- DRIVEWAY WIDTH MAY VARY TO MEET SPECIAL CONDITIONS WITH APPROVAL OF THE CITY. (SEE MUNICIPAL CODE SECTION 15.06.060).
- CONCRETE THICKNESS FOR DRIVEWAYS IN INDUSTRIAL AREAS IS 8" MINIMUM. CONCRETE THICKNESS FOR DRIVEWAYS IN RESIDENTIAL MULTI-FAMILY AND COMMERCIAL AREAS IS 6" MINIMUM.
- ALL CONSTRUCTION SHALL CONFORM TO CITY STANDARDS AND THE LATEST CALTRANS STANDARDS.
- ALL TREES IN PARKING STRIP MUST BE PROTECTED FROM DAMAGE.
- NO TREE ROOTS LARGER THAN 2" ARE TO BE CUT UNLESS SPECIFICALLY APPROVED BY THE PARKS DEPARTMENT AT (650) 558-7300.
- ALL CONCRETE SHALL BE CURED FOR A PERIOD OF 72 HOURS. (CALTRANS SECTION 90-7)
- ALL CONCRETE REMOVALS SHALL BE SAWCUT FULL DEPTH.
- SAWCUT AND REMOVE/REPLACE A.C. PAVING 1" WIDE (MIN.) WITH HOT MIX A.C.
- THE NEW DRIVEWAY MUST NOT ENCROACH TO NEIGHBOR'S PROPERTY LINE PROJECTION INTO THE STREET WITHOUT WRITTEN APPROVAL FROM THE NEIGHBOR.
- ALL SIDEWALK MUST MEET CURRENT ADA REQUIREMENTS.
- ACTUAL DRIVEWAY WIDTH SHALL BE DETERMINE UPON APPLICATION OF THE CITY ENCROACHMENT FORM.




SIDEWALK, DRIVEWAY, CURBS AND GUTTER

APPROVED BY
NO.
DATE 8/29/2008
DRAWING NO. SW-1 (3 of 3)


DEPARTMENT OF PUBLIC WORKS

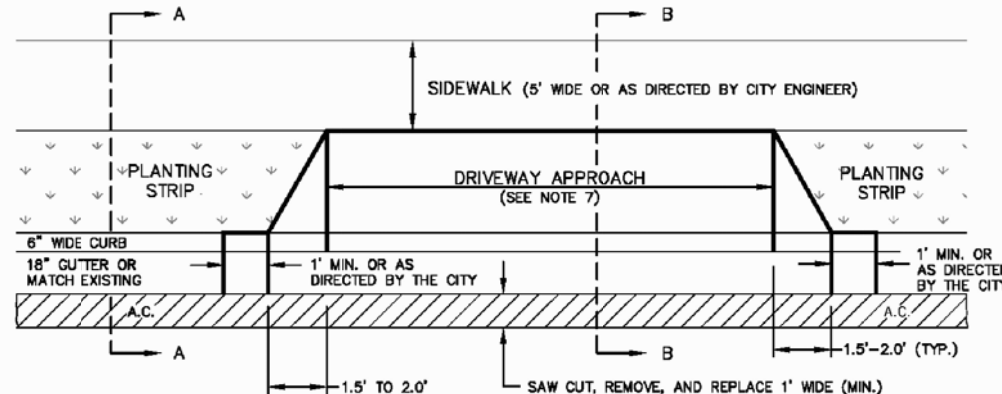

DRIVEWAY (DETACHED)
PLAN VIEW
N.T.S.

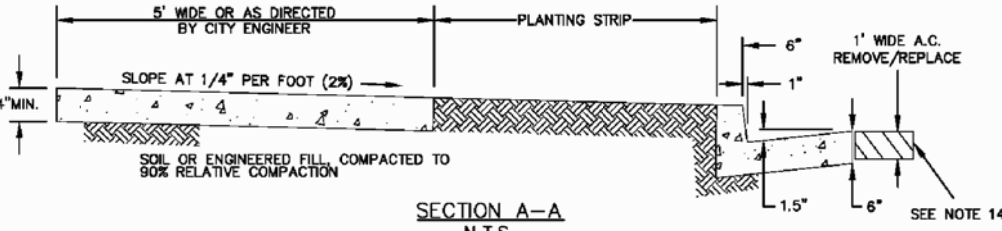

SECTION A-A
N.T.S.

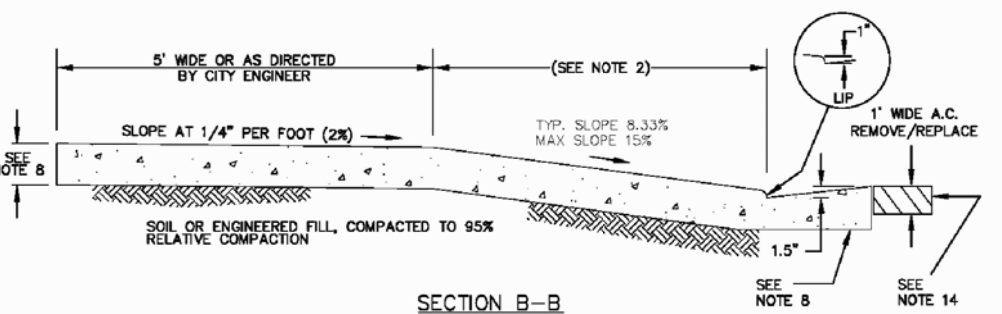

SECTION B-B
N.T.S.




SIDEWALK, DRIVEWAY, CURB AND GUTTER

APPROVED BY
NO.
DATE 8/29/2008
DRAWING NO. SW-1 (1 of 3)

DEPARTMENT OF PUBLIC WORKS

6 SIDEWALK DRIVEWAY, CURB
& GUTTER

ALL BACKFLOW PREVENTION ASSEMBLIES MUST BE APPROVED BY THE UNIVERSITY OF SOUTHERN CALIFORNIA (USC) AND TESTED BY A SAN MATEO COUNTY CERTIFIED TESTER BEFORE APPROVAL OF THE WATER SYSTEM. SEE THE SAN MATEO COUNTY WEB SITE FOR APPROVED LIST OF CERTIFIED TESTER'S AT [HTTP://SMOHEALTH.ORG/NODE/428](http://smohealth.org/node/428). FOR ADDITIONAL INFORMATION ON USC APPROVED DEVICES PLEASE CALL THE WATER DIVISION AT (650) 558-7670. PLEASE COMPLETE THE "WATER DEMAND WORKSHEET" FOR DETERMINING THE WATER SERVICE AND METER SIZE. THE WORKSHEET IS AVAILABLE AT THE BUILDING DEPARTMENT OR ON THE CITY OF BURLINGAME WEB SITE AT [HTTP://WWW.BURLINGAME.ORG/INDEX.ASPX?PAGE=125](http://www.burlingame.org/index.aspx?page=125).

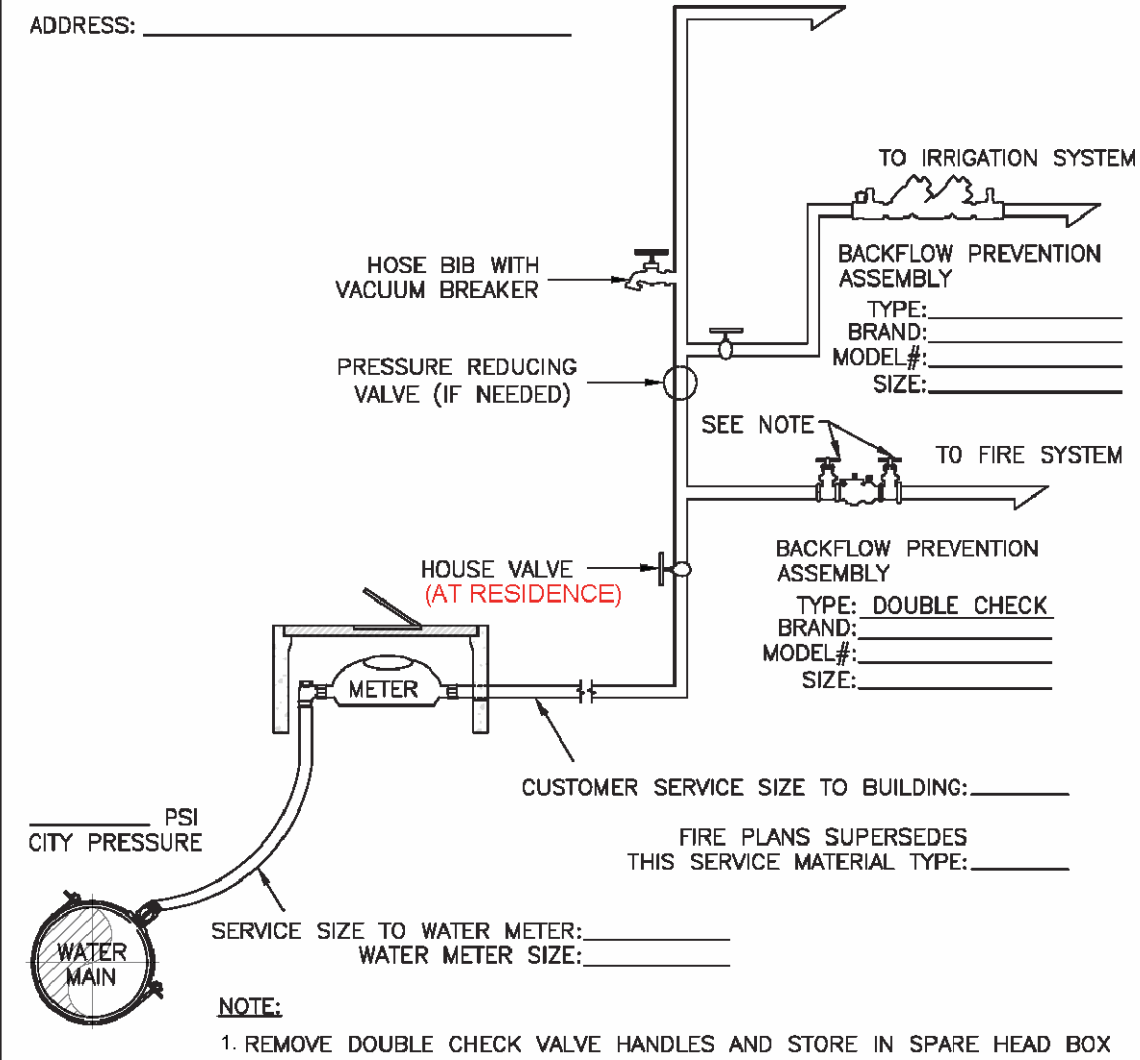


TYPICAL RESIDENTIAL WATER SERVICE DETAIL
(WITH FIRE SYSTEM)


DEC 2020 W-760
NONE 1 OF 1

8 WATER SERVICE DETAIL


2 SIDEWALK DRIVEWAY, CURB
& GUTTER

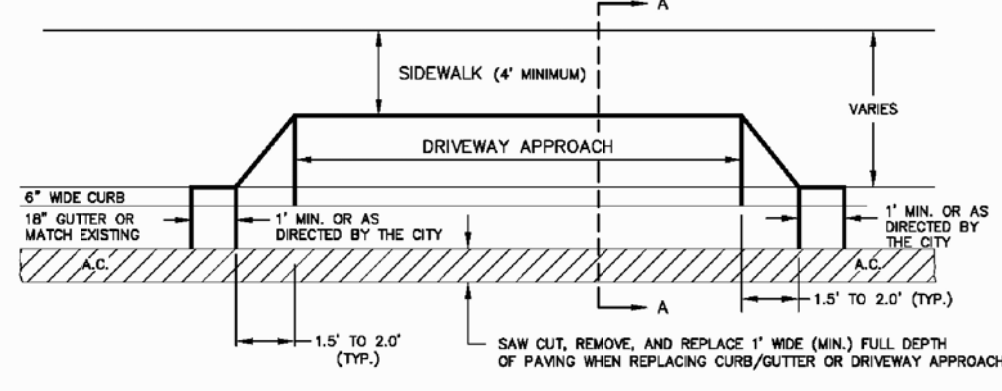

DRIVEWAY (ATTACHED)
PLAN VIEW
N.T.S.

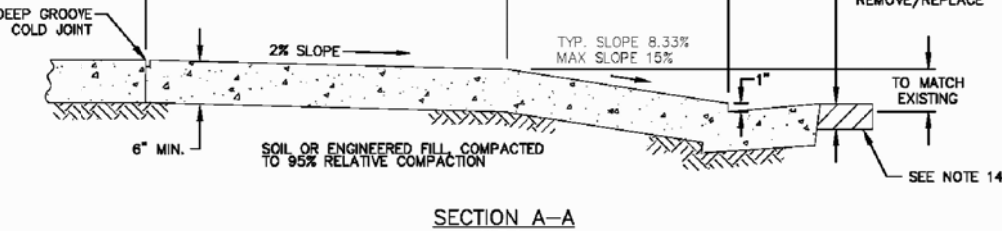

SECTION A-A
N.T.S.

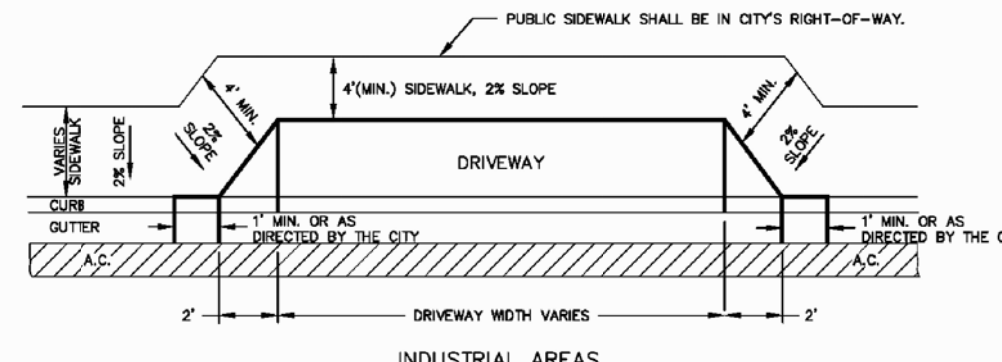

INDUSTRIAL AREAS
PLAN VIEW
N.T.S.



SIDEWALK, DRIVEWAY, CURB AND GUTTER

APPROVED BY
NO.
DATE 8/29/2008
DRAWING NO. SW-1 (2 of 3)

DEPARTMENT OF PUBLIC WORKS


4 SIDEWALK DRIVEWAY, CURB
& GUTTER

DATE:

07/09/2025

REVISIONS:
CITY COMMENTS

1

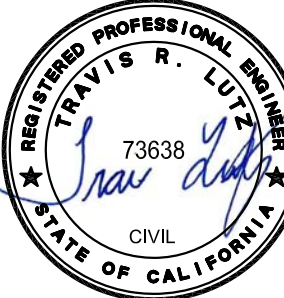

DETAIL SHEET
NEW RESIDENCE
1385 HILLSIDE CIRCLE LOT 3
BURLINGAME, CA 94010

Date: 05/28/2025

Scale: AS SHOWN

Design: AJP

Check: TRL

Drawing Number:

C-4.2

PEC Job No.
PEC 25-033

DRAINAGE MANAGEMENT AREA 1

| IMPERVIOUS AREA REQUIRED TO BE TREATED | C.3 REQUIRED TREATMENT AREA | TREATMENT AREA PROVIDED |
|---|--------------------------------|----------------------------|
| 4,141 S.F. | 166 S.F. | *208 S.F. |

TREATMENT AREA SIZING CRITERIA: SAN MATEO COUNTYWIDE
WATER POLLUTION PREVENTION PROGRAM: C.3 STORMWATER
TECHNICAL GUIDANCE.

*PROVIDED BY FLOW-THRU PLANTER = 208 SF

DRAINAGE MANAGEMENT AREA 2

| IMPERVIOUS AREA REQUIRED TO BE TREATED | C.3 REQUIRED TREATMENT AREA | TREATMENT AREA PROVIDED |
|---|--------------------------------|----------------------------|
| 277 S.F. | 11 S.F. | *40 S.F. |

TREATMENT AREA SIZING CRITERIA: SAN MATEO COUNTYWIDE
WATER POLLUTION PREVENTION PROGRAM: C.3 STORMWATER
TECHNICAL GUIDANCE.

*PROVIDED BY SILVA CELLS = 4 X 10 = 40 SF
(SEE CIVIL PLANS FOR LOT 2 FOR LOCATION)

DRAINAGE MANAGEMENT AREA 3

| IMPERVIOUS AREA REQUIRED TO BE TREATED | C.3 REQUIRED TREATMENT AREA | TREATMENT AREA PROVIDED |
|---|--------------------------------|----------------------------|
| 597 S.F. | 24 S.F. | *80 S.F. |

TREATMENT AREA SIZING CRITERIA: SAN MATEO COUNTYWIDE
WATER POLLUTION PREVENTION PROGRAM: C.3 STORMWATER
TECHNICAL GUIDANCE.

*PROVIDED BY SILVA CELLS = 8 X 10 = 80 SF
(SEE CIVIL PLANS FOR LOT 2 FOR LOCATION)

PERMEABLE PAVER AREA



Worksheet for Calculating the Water Quality Design Volume (80 percent capture method)

Instructions: After completing Section 1, make as many copies of this Excel file as needed to fill out the worksheet for each Drainage Management Area of the project. Enter information specific to the project and DMA in the cells shaded in yellow. Cells shaded in light blue contain formulas and values that will be automatically calculated.

1.0 Project Information

| | | |
|--|----------------------------|---|
| 1.1 Project Name: | New Residence | The calculations presented herein are based on the 100% design method of using volume based treatment measures provided in the Countywide Program C.3 Technical Guidance, v. 5.0 (2018). The steps presented below are explained in Section 5.3 of the Guidance. Equivalency portions of which are included in this file, in the sheet named "Guidance from Chapter 5." |
| 1.2 City application ID: | 1385 Hillside Circle LOT 3 | |
| 1.3 Site Address or APN: | | |
| 1.4 Tract or Parcel Map No: | 6 | |
| 1.5 Rainfall Region | 20.10 | |
| 1.6 Region Mean Annual Precipitation (MAP) | 26 | |
| 1.7 Site Mean Annual Precipitation (MAP) | | |

Click here for map

1.8 MAP adjustment factor is automatically calculated as: 1.29

(The "Site Mean Annual Precipitation (MAP)" is divided by the MAP for the applicable rain gauge, shown in Table 5-3, below.)
Refer to the map in Appendix C of the C.3 Technical Guidance to identify the Rainfall Region for the site.

2.0 Calculate Percentage of Impervious Surface for Drainage Management Area (DMA)

| | | | | |
|--|---------------------------------------|---|-------------------------|---------------------------|
| 2.1 | Name of DMA: | | | |
| For items 2.2 and 2.3, enter the areas in square feet for each type of surface within the DMA. | | | | |
| | Type of Surface | Area of surface type within DMA (Sq. Ft.) | Adjust Permeous Surface | Effective Impervious Area |
| 2.2 | Impervious surface | | 1.0 | |
| 2.3 | Permeous surface | 607 | 0.1 | 61 |
| Total DMA Area (square feet) = | | 607 | | |
| 2.4 | Total Effective Impervious Area (EIA) | | 61 | Square feet |

3.0 Calculate Unit Basin Storage Volume in Inches

| Region | Station, and Mean Annual Precipitation (inches) | Runoff Coefficient of 1.0 |
|--------|---|---------------------------|
| 1 | Beaumont Creek, 55.9" | 2.54" |
| 2 | La Honda, 24.4" | 0.86" |
| 3 | Half Moon Bay, 25.9" | 0.82" |
| 4 | Palo Alto, 24.5" | 0.64" |
| 5 | San Francisco, 45.7" | 0.73" |
| 6 | San Francisco Airport, 20.1" | 0.85" |
| 7 | San Francisco Downtown, 19.2" | 0.72" |

Unit basin storage volume from Table 5.2: 0.85 Inches
(The coefficient for this method is 1.00, due to the conversion of any land use to its effective impervious area.)

Adjusted unit basin storage volume: 1.10 Inches
(The unit basin storage volume is adjusted by applying the MAP adjustment factor.)

Required Capture Volume (in cubic feet): 6 Cubic feet
(The adjusted unit basin storage volume [inches] is multiplied by the size of the DMA and converted to feet.)

To size an infiltration trench, enter the surface area available: 607 Square feet


Required depth of infiltration trench, given the surface area available (in 3-4): 0.03 Feet
(Assumes 35% void space in rectangular trench with vertical sides.)
(Note: Infiltration trench depths are typically between 3 and 4 feet.)

Volume (100% Capture)

1

Revised August 2017

| PERMEABLE PAVER AREA | C.3 REQUIRED VOLUME | VOLUME PROVIDED |
|-------------------------|------------------------|--------------------|
| 607 S.F. | 6 S.F. | 18 S.F. |

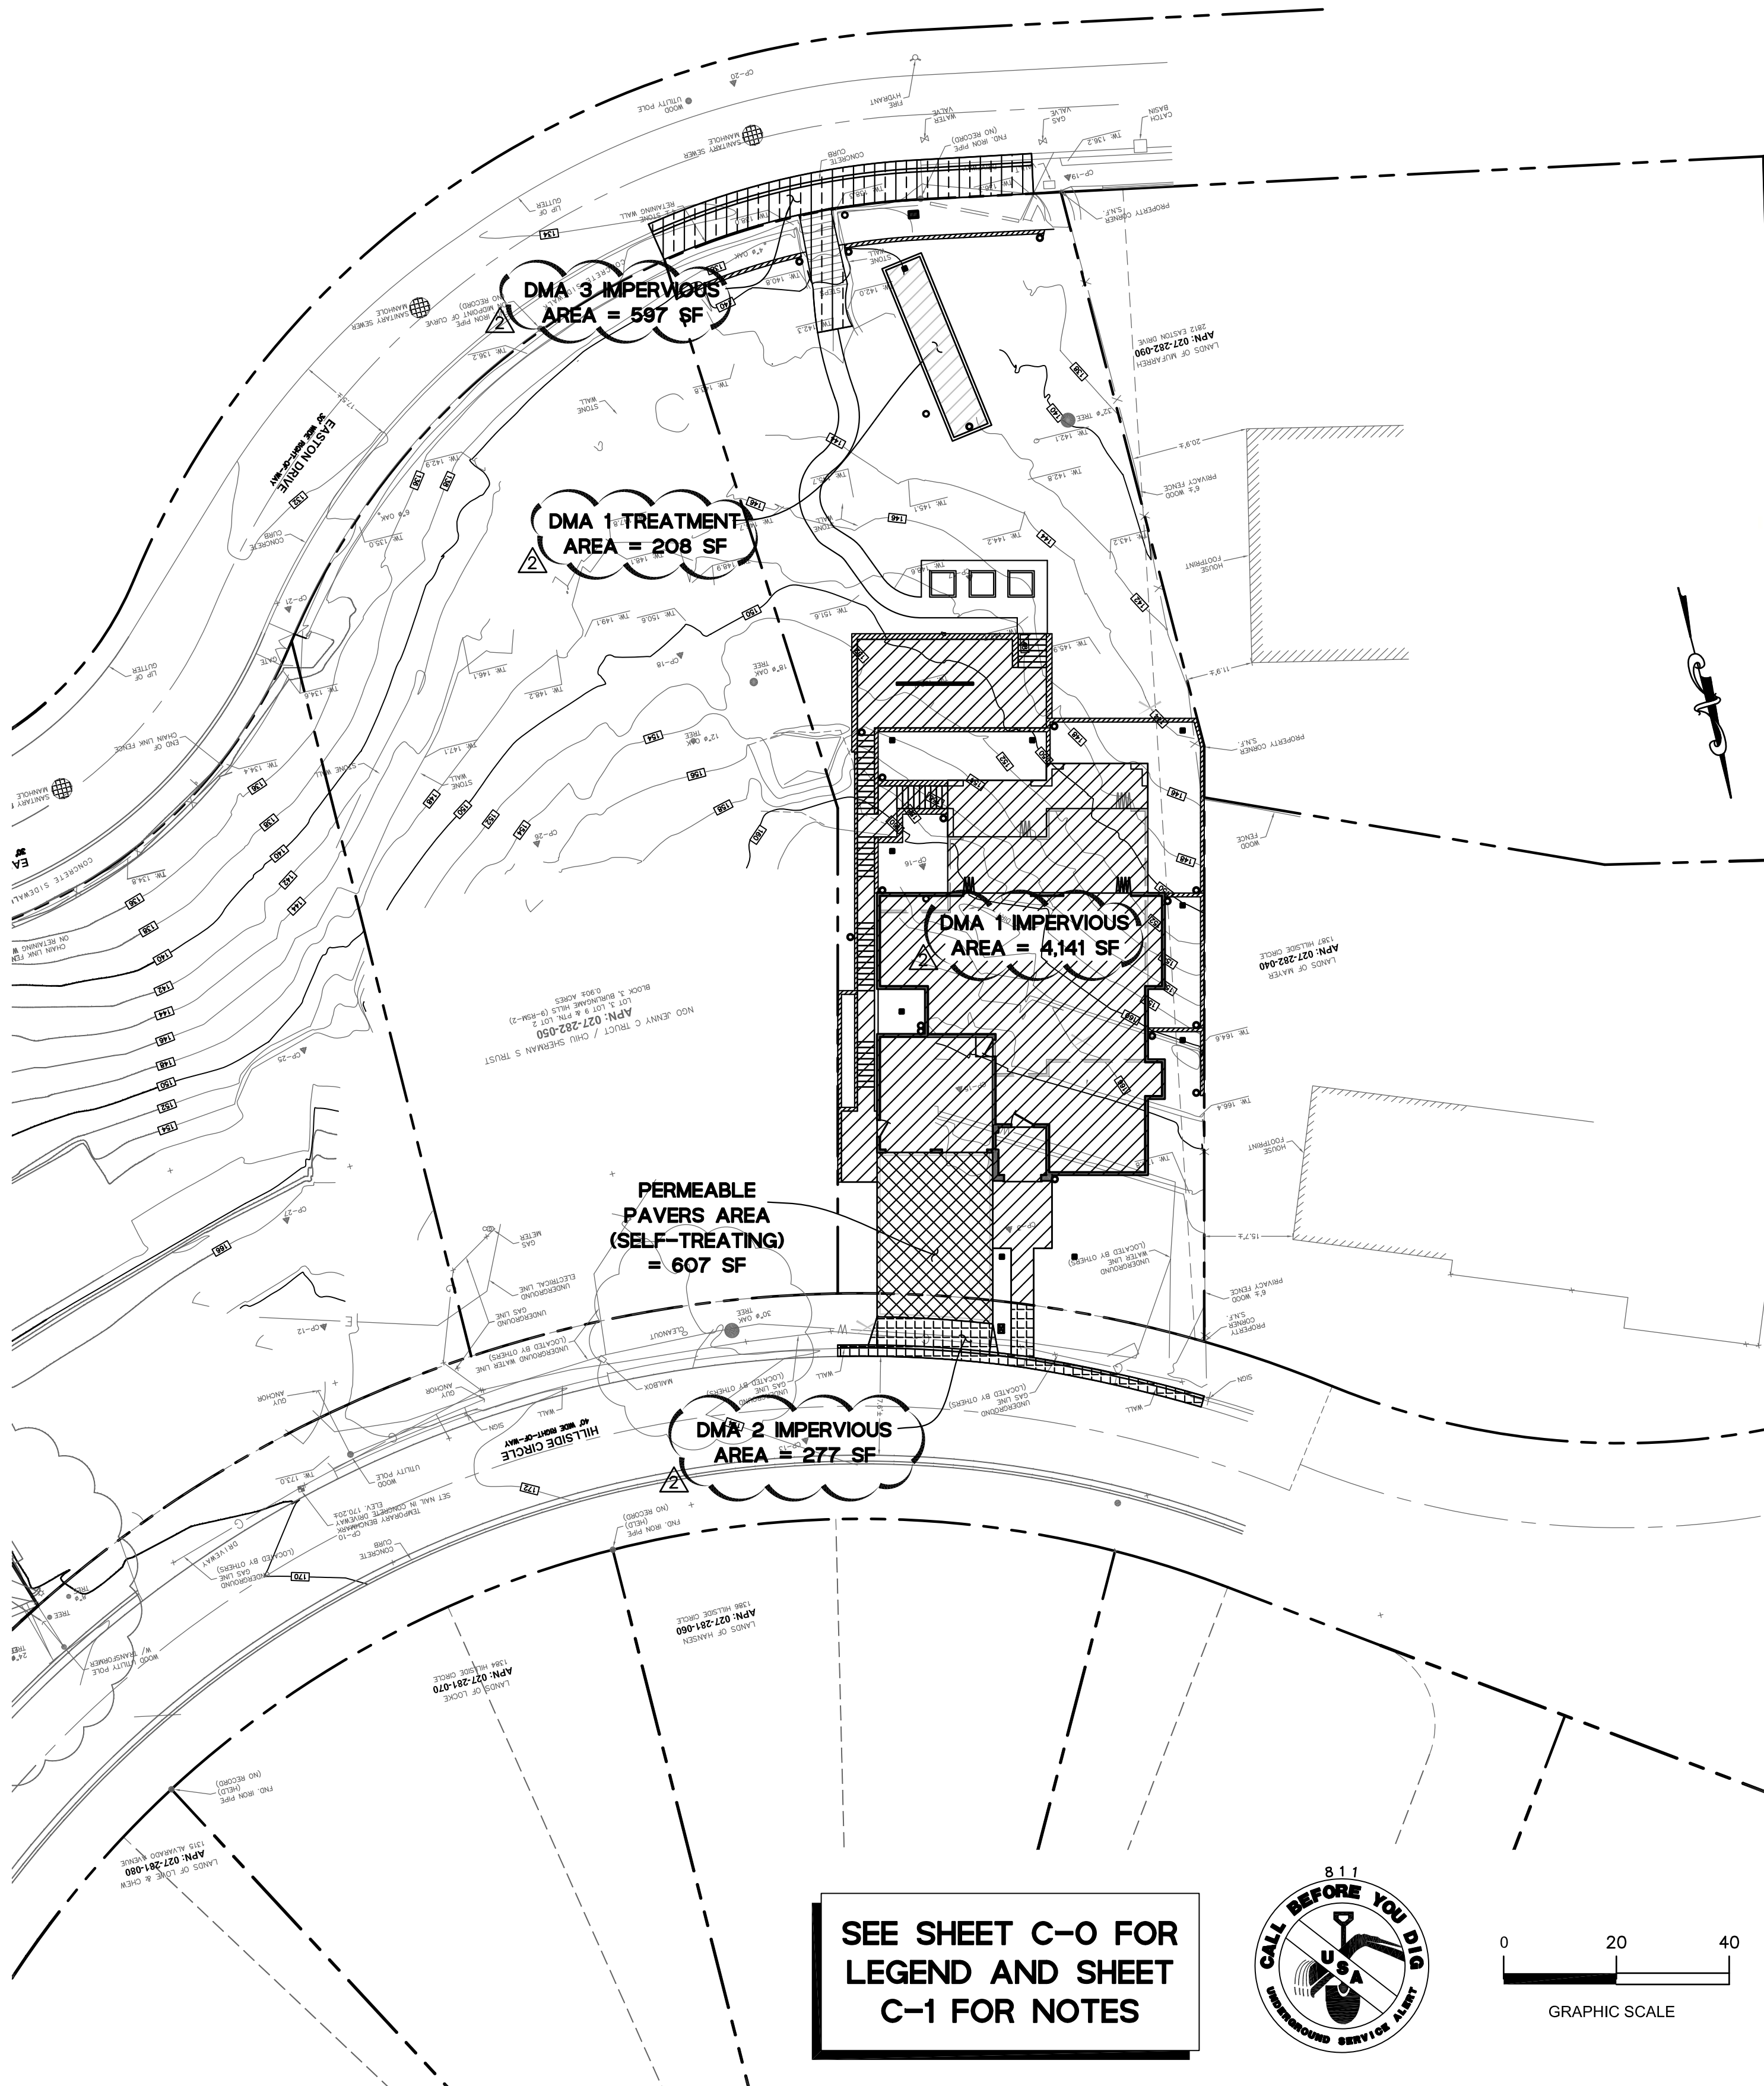


STORMWATER TREATMENT PLAN
NEW RESIDENCE
1385 HILLSIDE CIRCLE LOT 3
BURLINGAME, CA 94010

| | |
|-----------------|------------|
| Date: | 05/28/2025 |
| Scale: | 1" = 20' |
| Design: | AJP |
| Check: | TRL |
| Drawing Number: | C-5 |
| PEC Job No. | PEC 25-033 |



| | |
|----------------|------------|
| DATE: | 07/09/2025 |
| REVISIONS: | |
| CITY COMMENTS: | |
| CITY COMMENTS: | |



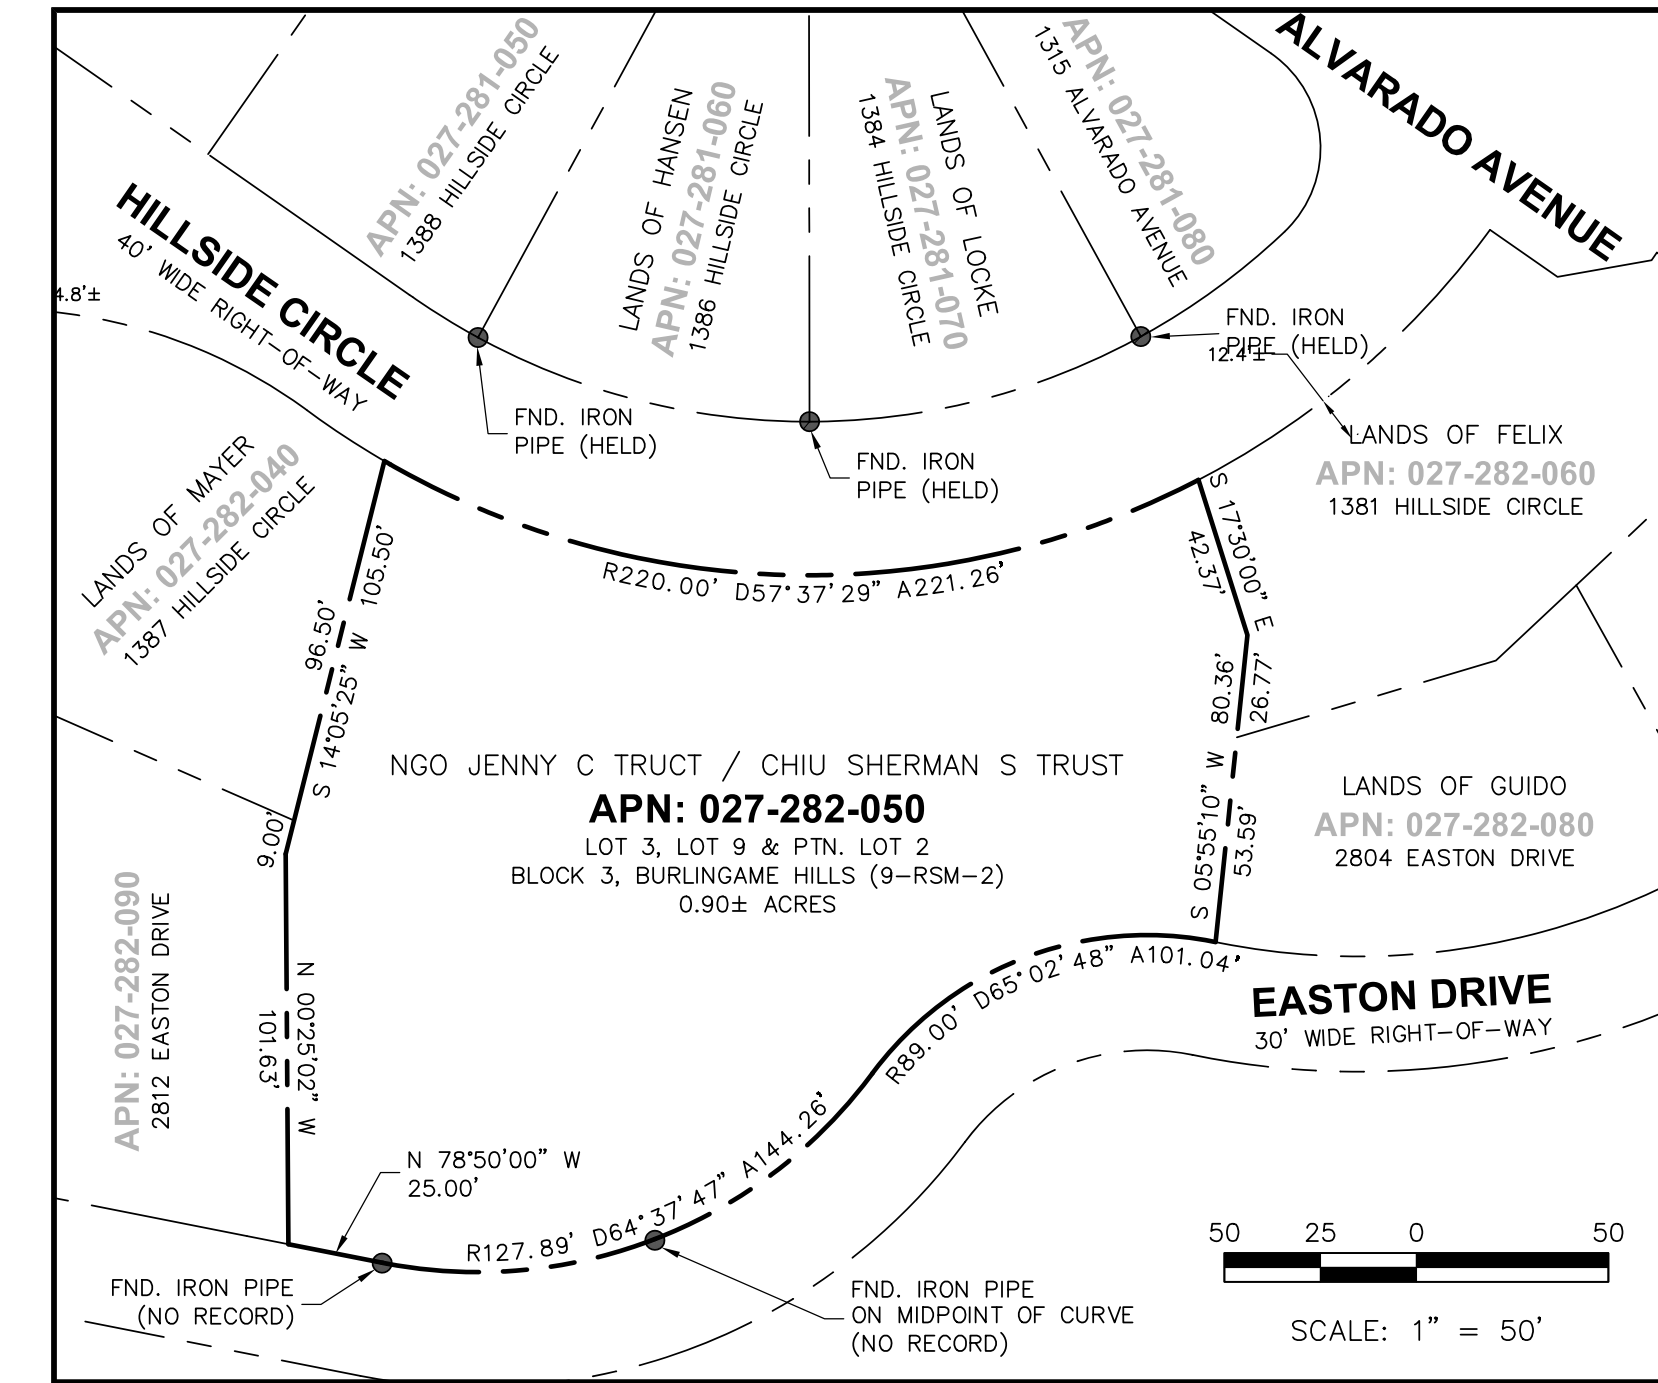


| SETBACK TABLE | | |
|---------------|----------------------|------------------|
| 12.4' | 1381 HILLSIDE CIRCLE | APN: 027-282-060 |
| 0.0' | 1385 HILLSIDE CIRCLE | APN: 027-282-040 |
| 14.8' | 1387 HILLSIDE CIRCLE | APN: 027-282-040 |
| 14.6' | 2101 SUMMIT DRIVE | APN: 027-282-030 |
| 17.7' | 1401 HILLSIDE CIRCLE | APN: 027-104-380 |
| 17.9' | 1405 HILLSIDE CIRCLE | APN: 027-104-370 |

TOPOGRAPHIC SURVEY

LANDS OF NGO & CHUI
LOT 3, LOT 9 & PTN. LOT 2, BLOCK 3
BURLINGAME HILLS (9 RSM 2)
1385 HILLSIDE CIRCLE

CITY OF BURLINGAME SAN MATEO COUNTY CALIFORNIA
SCALE: 1" = 10' MAY 2025

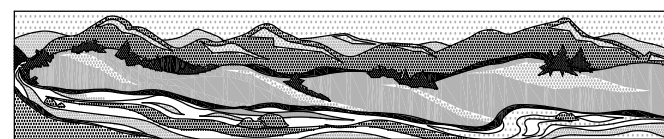

QUIET RIVER
Land Services Inc.

11501 Dublin Boulevard, Suite 200
Dublin, CA 94568
(925) 734-6788 Phone

BASIS OF BEARINGS

BURLINGAME HILLS TRACT MAP FILED IN BOOK 9 AT PAGE 2 IN THE RECORDS OF SAN MATEO COUNTY, AND TWO FOUND MONUMENTS AS SHOWN.

BASIS OF ELEVATION

THE ELEVATIONS SHOWN HEREON WERE DERIVED FROM L-1/L-2 DATA COLLECTED USING NAVSTAR GLOBAL POSITIONING SYSTEM (GPS) AND A CHCX900-OPUS RECEIVER AND POST-PROCESSED USING THE CORS NETWORK. ALL ELEVATION EXPRESSED IN NAVD 1988 DATUM.

NOTES

- 1.) THIS MAP IS NOT A PROPERTY BOUNDARY SURVEY, THIS IS TOPOGRAPHY MAP. NO PROPERTY CORNER MONUMENTS WERE SET FOR THIS PROJECT.
- 2.) NO TITLE REPORTS WERE SUPPLIED FOR THIS PROJECT AND ONLY LIMITED PROPERTY/DEED RESEARCH WAS DONE, CONSEQUENTLY EASEMENTS OF RECORD, IF ANY, AND ANY RECENT CHANGES IN LAND PARCEL BOUNDARIES WILL NOT BE REFLECTED HEREON. UNDERGROUND UTILITY LINES WERE NOT LOCATED FOR THIS SURVEY.
- 3.) DATE OF FIELD SURVEY: APRIL 23, 24 & 30, 2019, APRIL 20, 2022 & NOVEMBER 26, 2024
- 4.) PROJECT BENCHMARK: SET NAIL IN CONCRETE DRIVEWAY ELEV. 170.20±
- 5.) CONTOURS SHOWN HEREON ARE AT 2 FOOT INTERVALS

LEGEND

- SUBJECT PROPERTY LINE
- ADJOINER PROPERTY LINE
- EXISTING EASEMENT LINE
- EXISTING FENCE LINE
- SPOT ELEVATION
- S.N.F. SEARCHED FOR, NOT FOUND
- STONE WALL
- PAVERS
- ROCKS

SURVEYOR'S STATEMENT

I, KEVIN M. MCGUIRE, A REGISTERED PROFESSIONAL LAND SURVEYOR DULY LICENSED BY THE LAWS OF THE STATE OF CALIFORNIA DO HEREBY STATE THAT THE TOPOGRAPHY, SPOT ELEVATIONS, LOCATIONS OF IMPROVEMENTS AS SHOWN, ARE BASED UPON A FIELD SURVEY PERFORMED APRIL 23, 24, 30, 2019 & APRIL 20, 2022 & NOVEMBER 26, 2024 BY OUR COMPANY FIELD CREW; AND I FURTHERMORE DO STATE THAT THE PROPERTY BOUNDARY LINES, RIGHTS-OF-WAY AND EASEMENTS, IF ANY, ARE BASED UPON ITEMS OF PUBLIC RECORD AND FIT TO FOUND MONUMENTS AS SHOWN AND REFERENCED HEREON. THIS MAP AND THE ITEMS AND INFORMATION AS SHOWN, WERE DONE UNDER MY SUPERVISION AND DIRECTION AND ARE TRUE AND ACCURATE TO THE BEST OF MY KNOWLEDGE AND BELIEF.




KEVIN M. MCGUIRE, CA PLS #6437

5/7/2025
DATE

TOPOGRAPHIC SURVEY


LANDS OF NGO & CHUI
LOT 3, LOT 9 & PTN. LOT 2, BLOCK 3
BURLINGAME HILLS (9 RSM 2)
1385 HILLSIDE CIRCLE

CITY OF BURLINGAME SAN MATEO COUNTY CALIFORNIA
SCALE: 1" = 10' MAY 2025



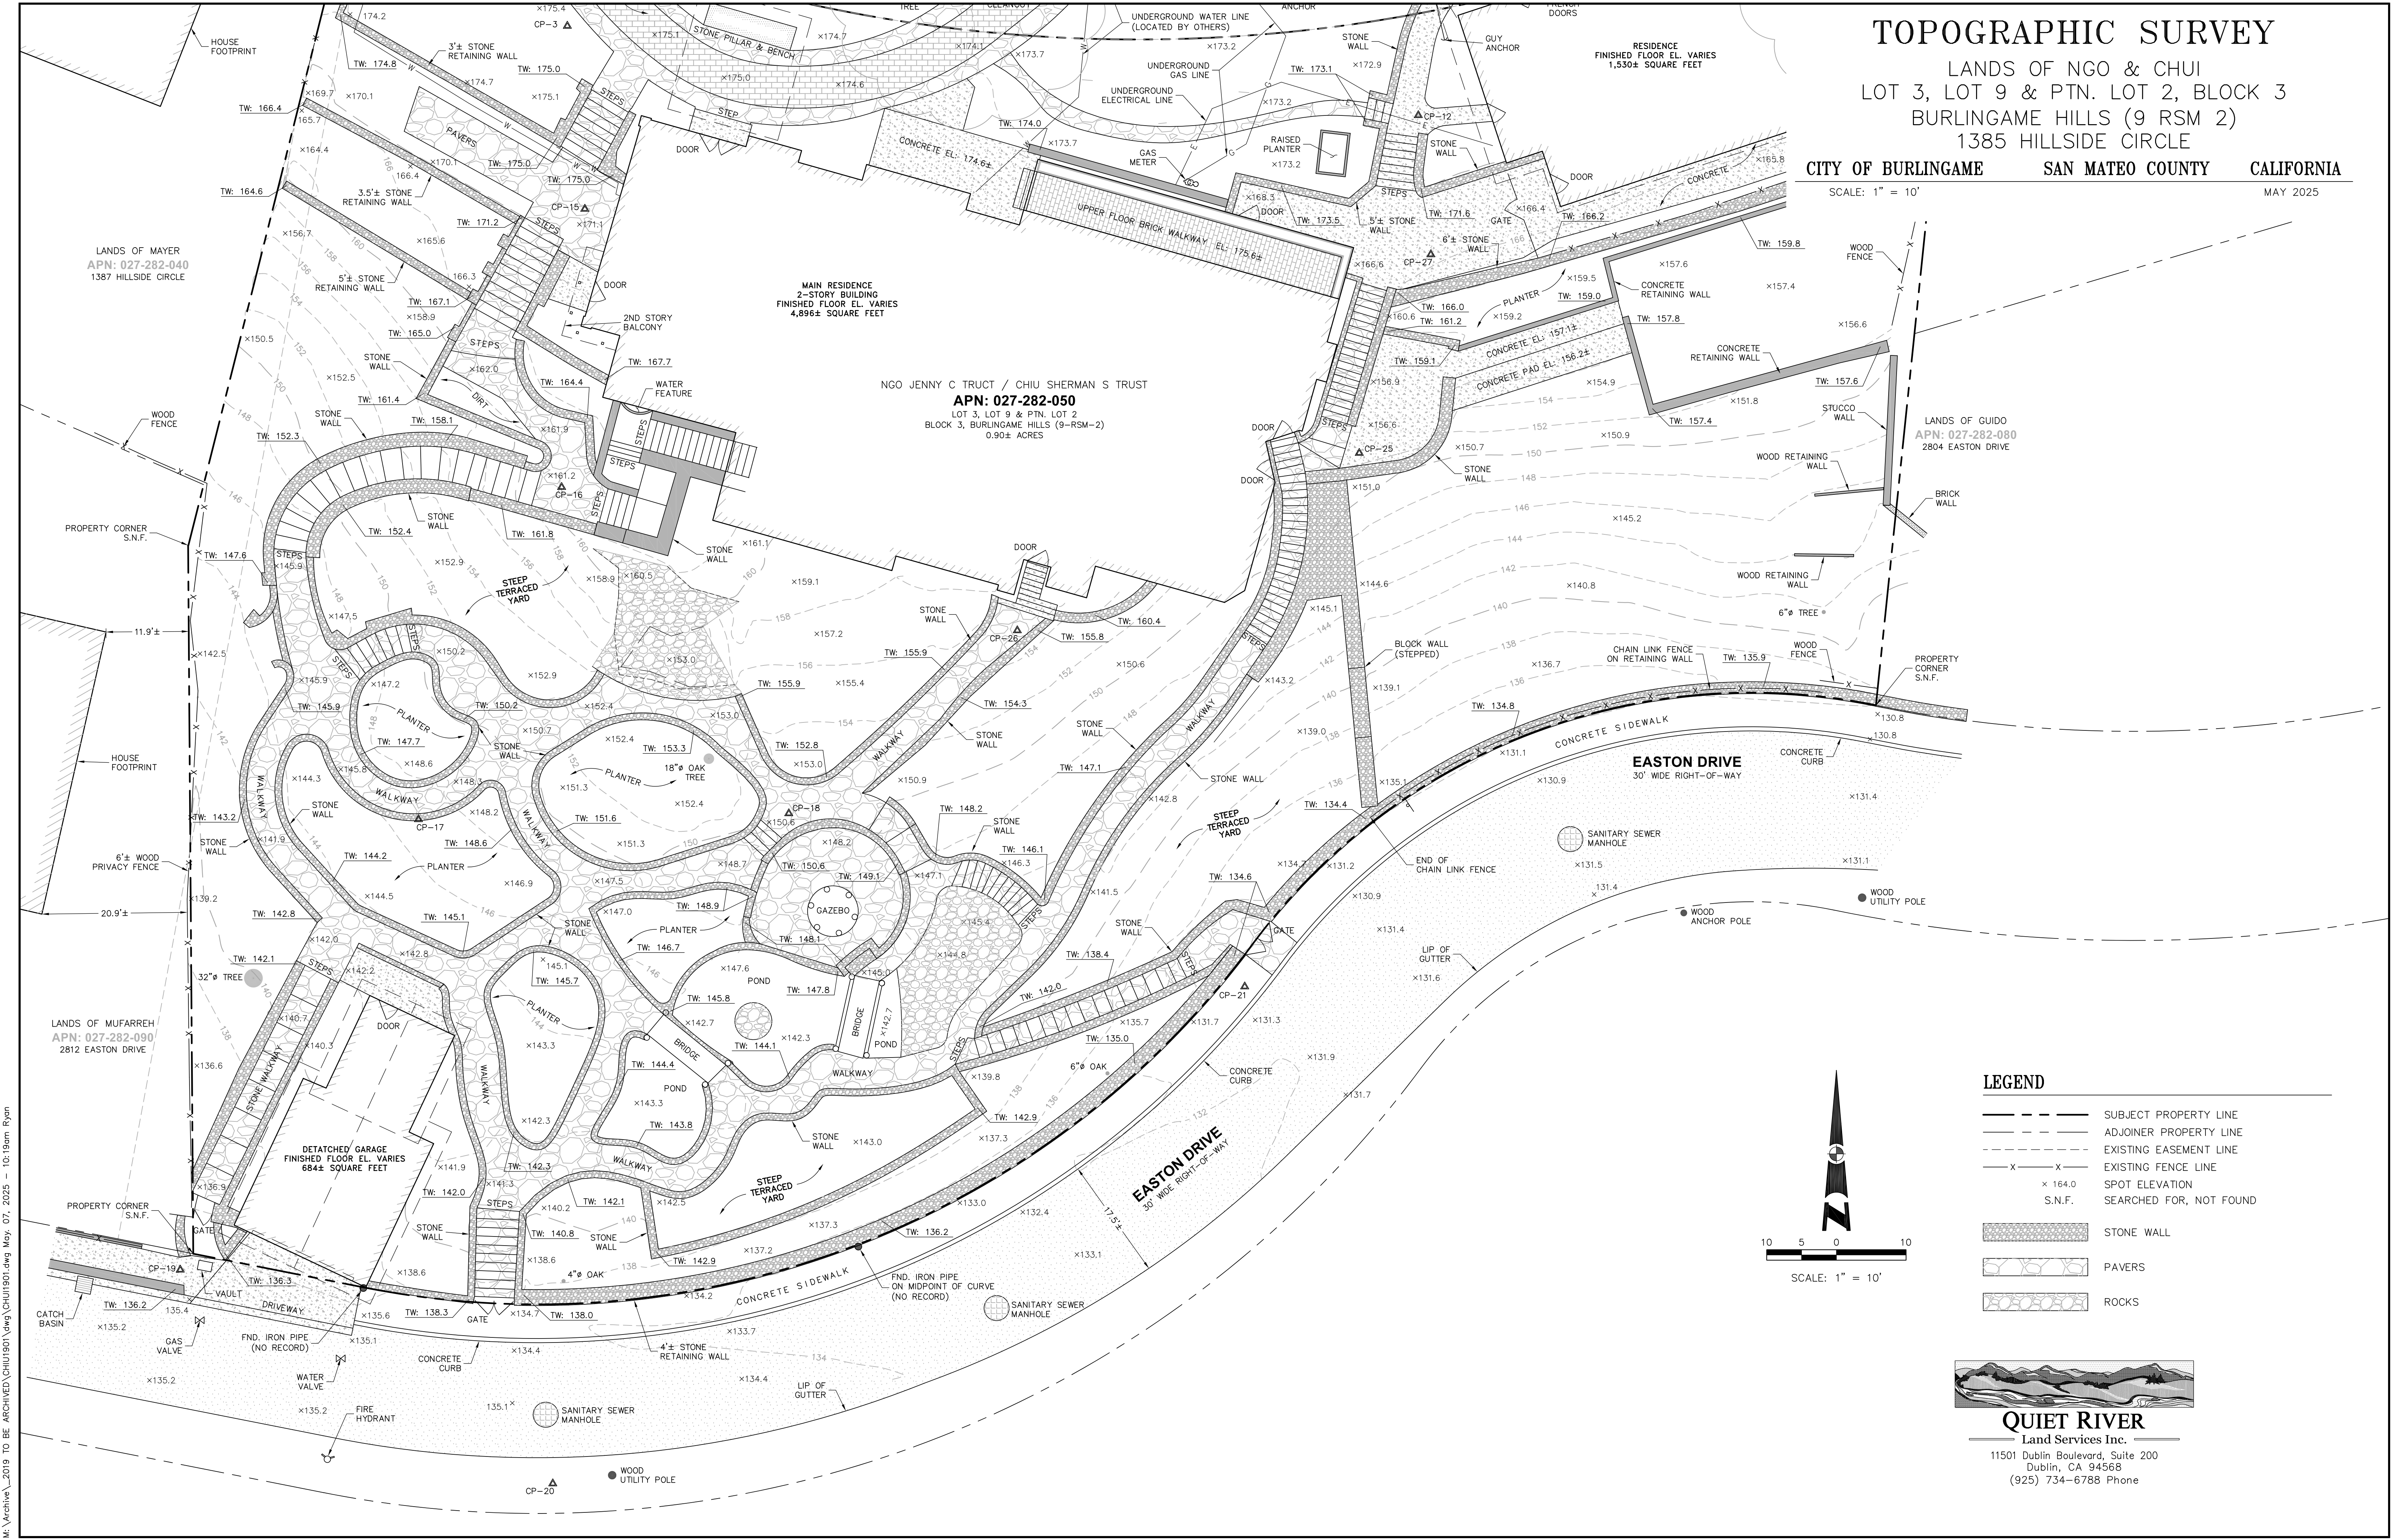


- LEGEND**
- SUBJECT PROPERTY LINE
 - ADJOINER PROPERTY LINE
 - EXISTING EASEMENT LINE
 - EXISTING FENCE LINE
 - SPOT ELEVATION
 - S.N.F. SEARCHED FOR, NOT FOUND

- STONE WALL
- PAVERS
- ROCKS

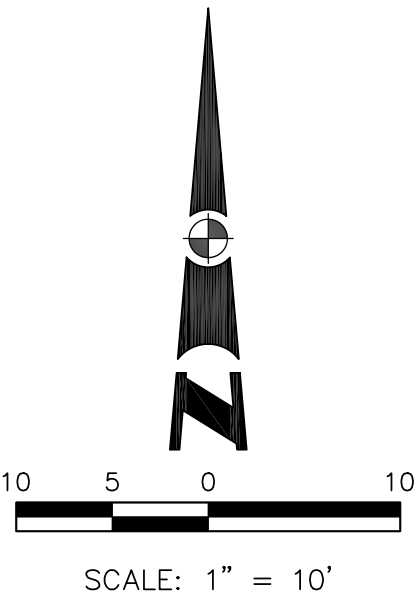

QUIET RIVER
Land Services Inc.
11501 Dublin Boulevard, Suite 200
Dublin, CA 94568
(925) 734-6788 Phone

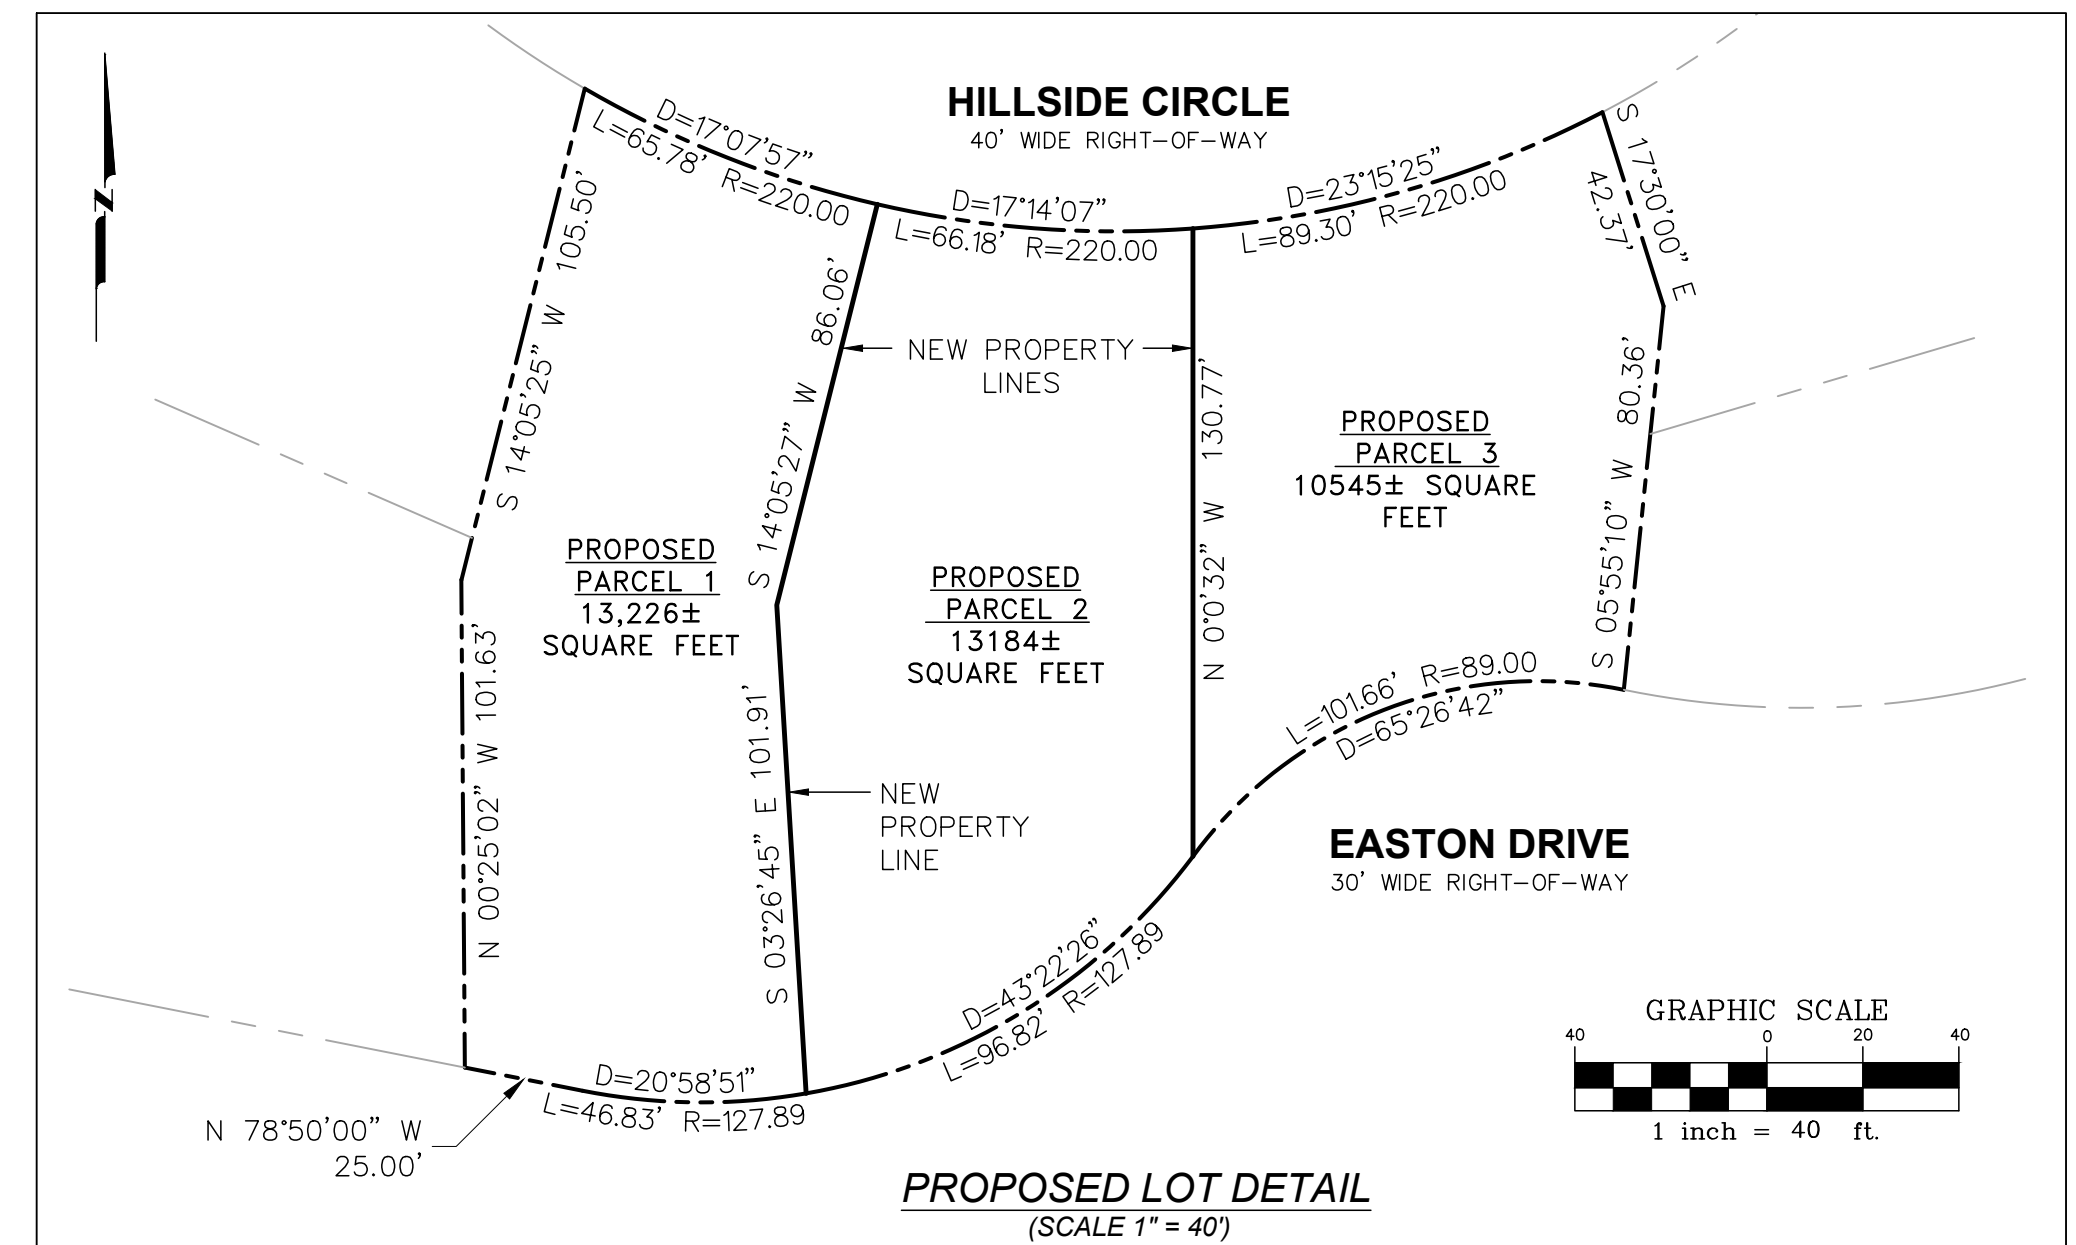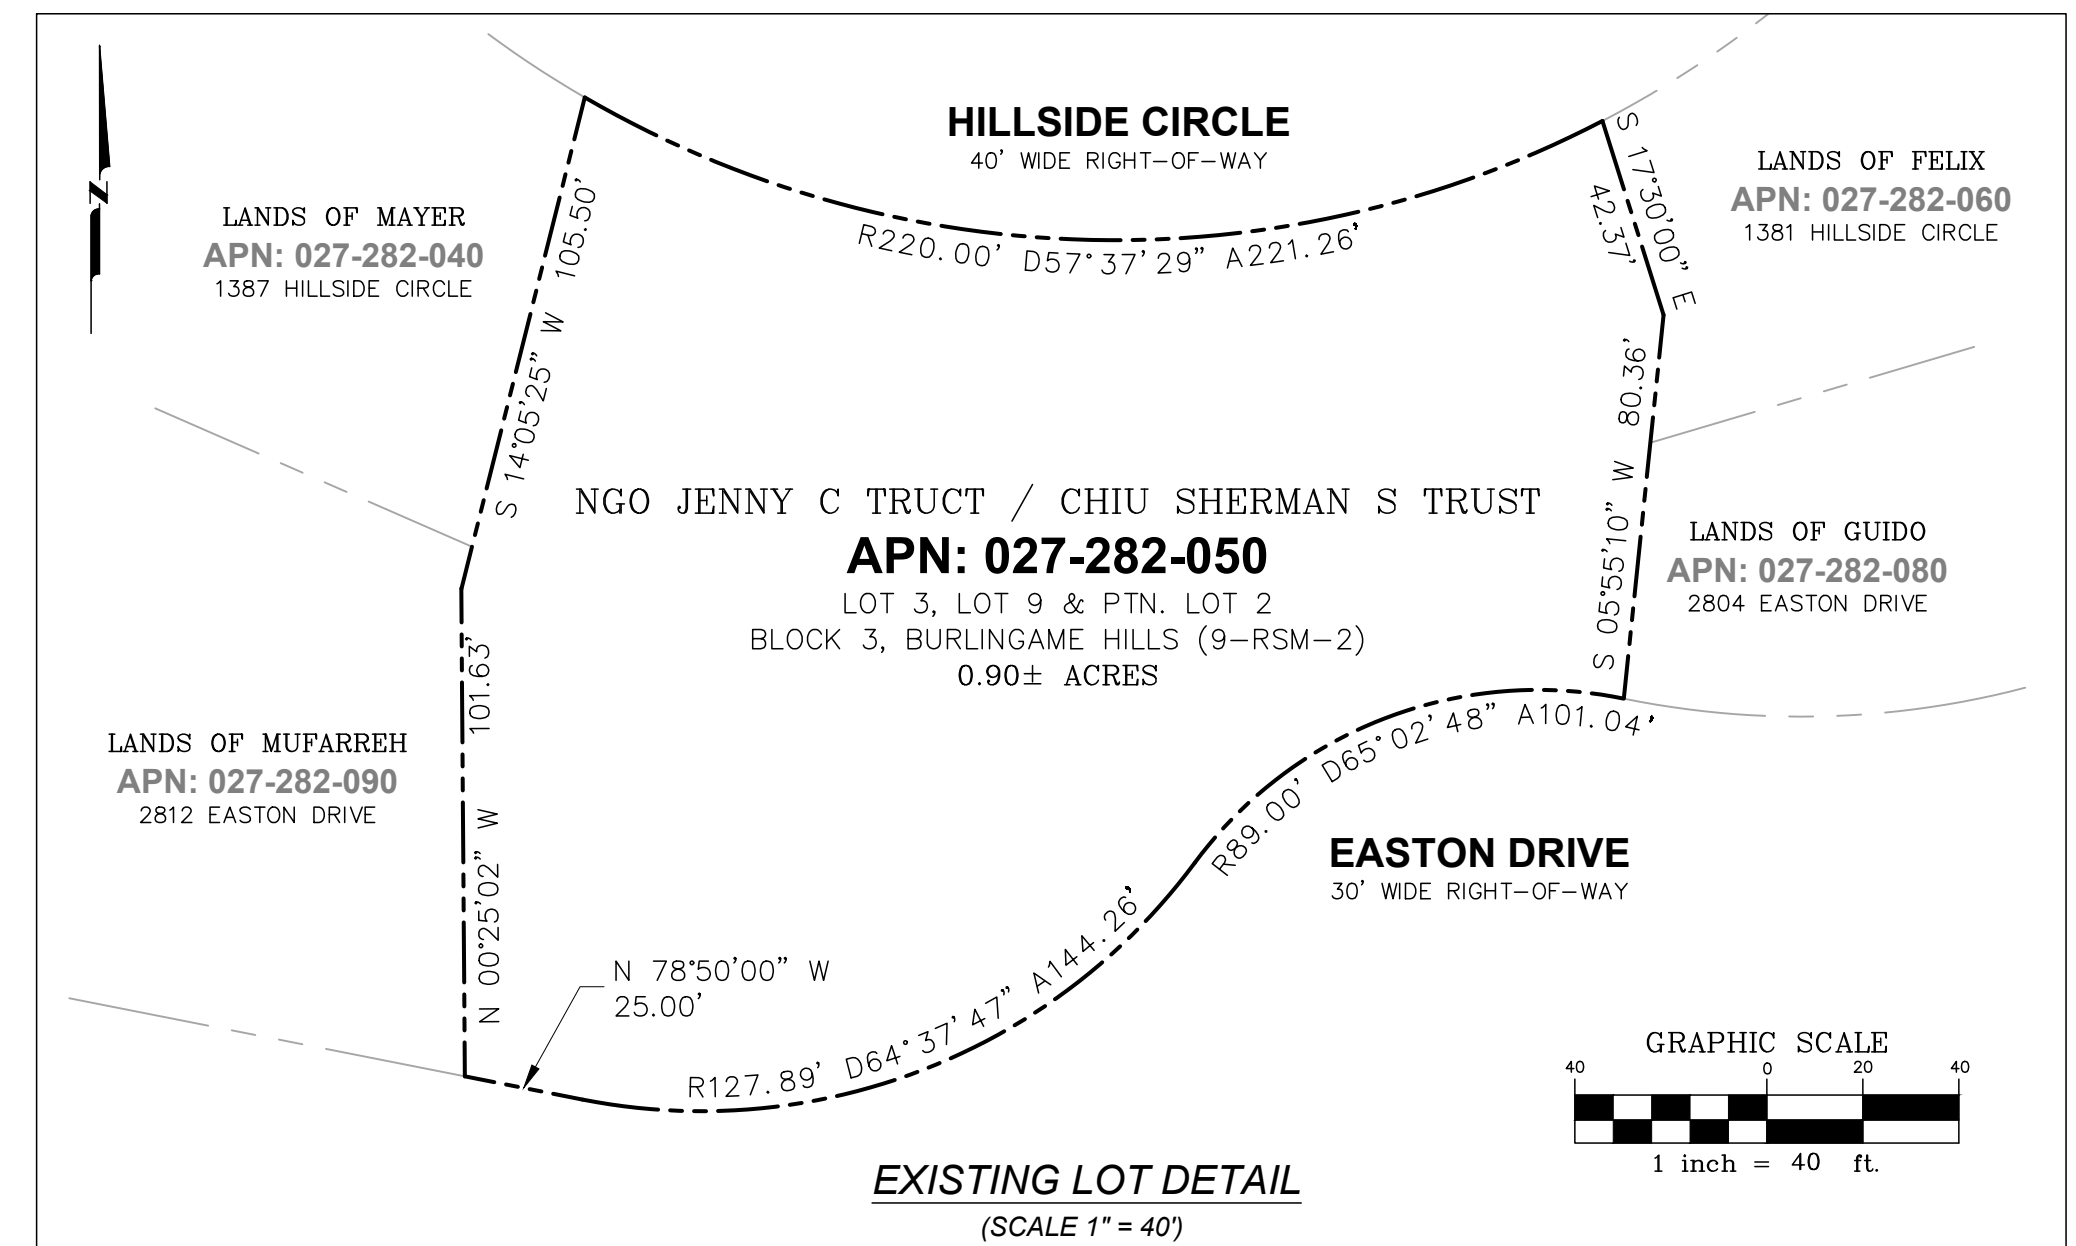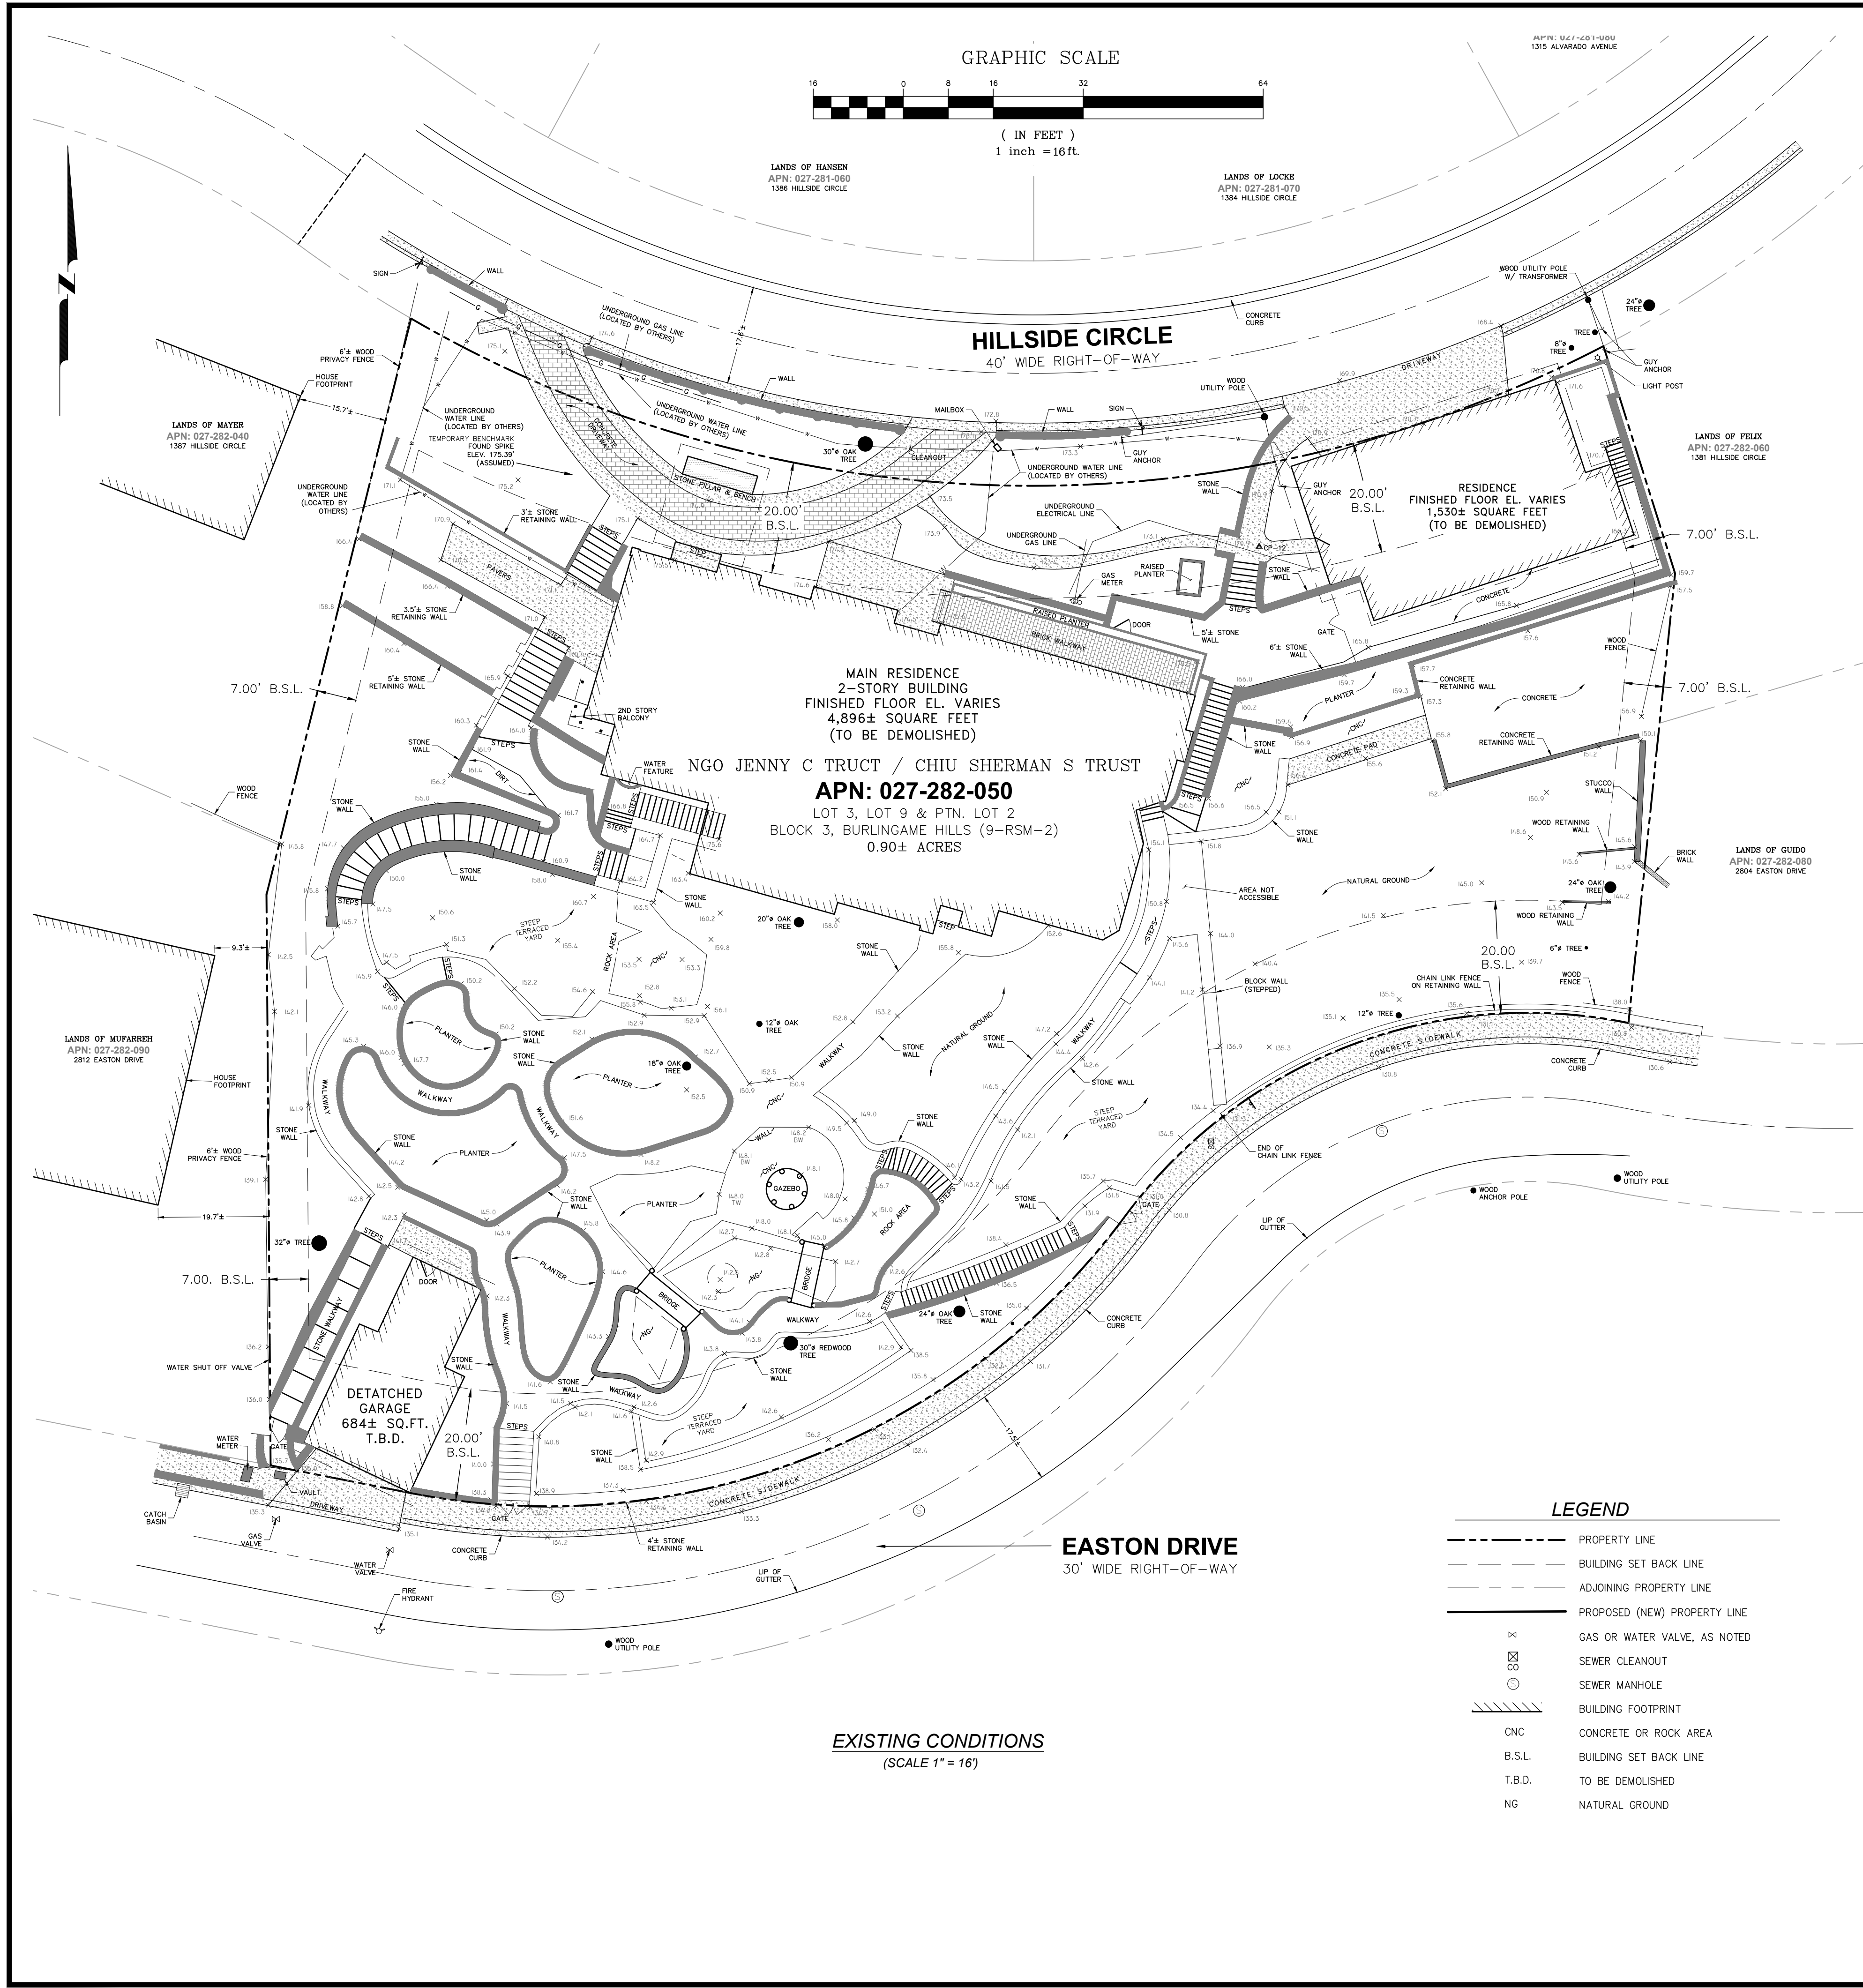

- GENERAL NOTES:
- ALL DISTANCES ARE IN DECIMAL FEET UNLESS OTHERWISE NOTED.
 - ALL ANGLES ARE AT 90° UNLESS OTHERWISE NOTED.
 - THIS MAP REPRESENTS THE SITE CONDITIONS ON DATE OF FIELD SURVEY, MAY 26, 2021.
 - ELEVATIONS ARE ASSUMED.
 - EXISTING STRUCTURES AND IMPROVEMENTS ARE TO BE DEMOLISHED.

BOUNDARY NOTE:

BOUNDARY INFORMATION SHOWN HEREON IS FOR PLANNING PURPOSES ONLY. PROPERTY AND RIGHT-OF-WAY LINES SHOWN HEREON ARE BASED ON RECORD DATA AND EXISTING IMPROVEMENTS AND ARE NOT INTENDED TO BE A FINAL BOUNDARY SURVEY OF THE PROPERTY WHICH REQUIRES FILING A RECORD OF SURVEY OR SUBDIVISION MAP WITH THE COUNTY RECORDER. NO PROPERTY LINES OR CORNERS WERE SET ON THIS SURVEY.

SURVEYOR'S STATEMENT

THIS MAP WAS PREPARED BY ME OR UNDER MY DIRECTION AND IS BASED UPON A FIELD SURVEY AT THE REQUEST OF SHERMAN CHIU IN MAY 2021.

BY: *Daniel J. Westover*
DANIEL J. WESTOVER, L.S. 7779

DATE: 7/16/2021



336 CLAREMONT BLVD STE 1
SAN FRANCISCO, CA 94127
(415) 242-5400
www.westoversurveying.com

WS
Westover
Surveying

| NO. | DATE | COMMENTS |
|-----|------|----------|
| 1 | | |
| 2 | | |
| 3 | | |

JOB NO. 21037

DRAWN BY: SPA
CHECKED BY: DJW
DATE: 07/12/2021
SCALE: VARIES

TENTATIVE MAP

1385 HILLSIDE DRIVE
LOT 3, LOT 9 & PTN. LOT 2, BLOCK 3, BURLINGAME HILLS (9-RSM-2)
APN: 027-282-050
CITY OF BURLINGAME, SAN MATEO COUNTY, CALIFORNIA

SHEET
1 OF 1

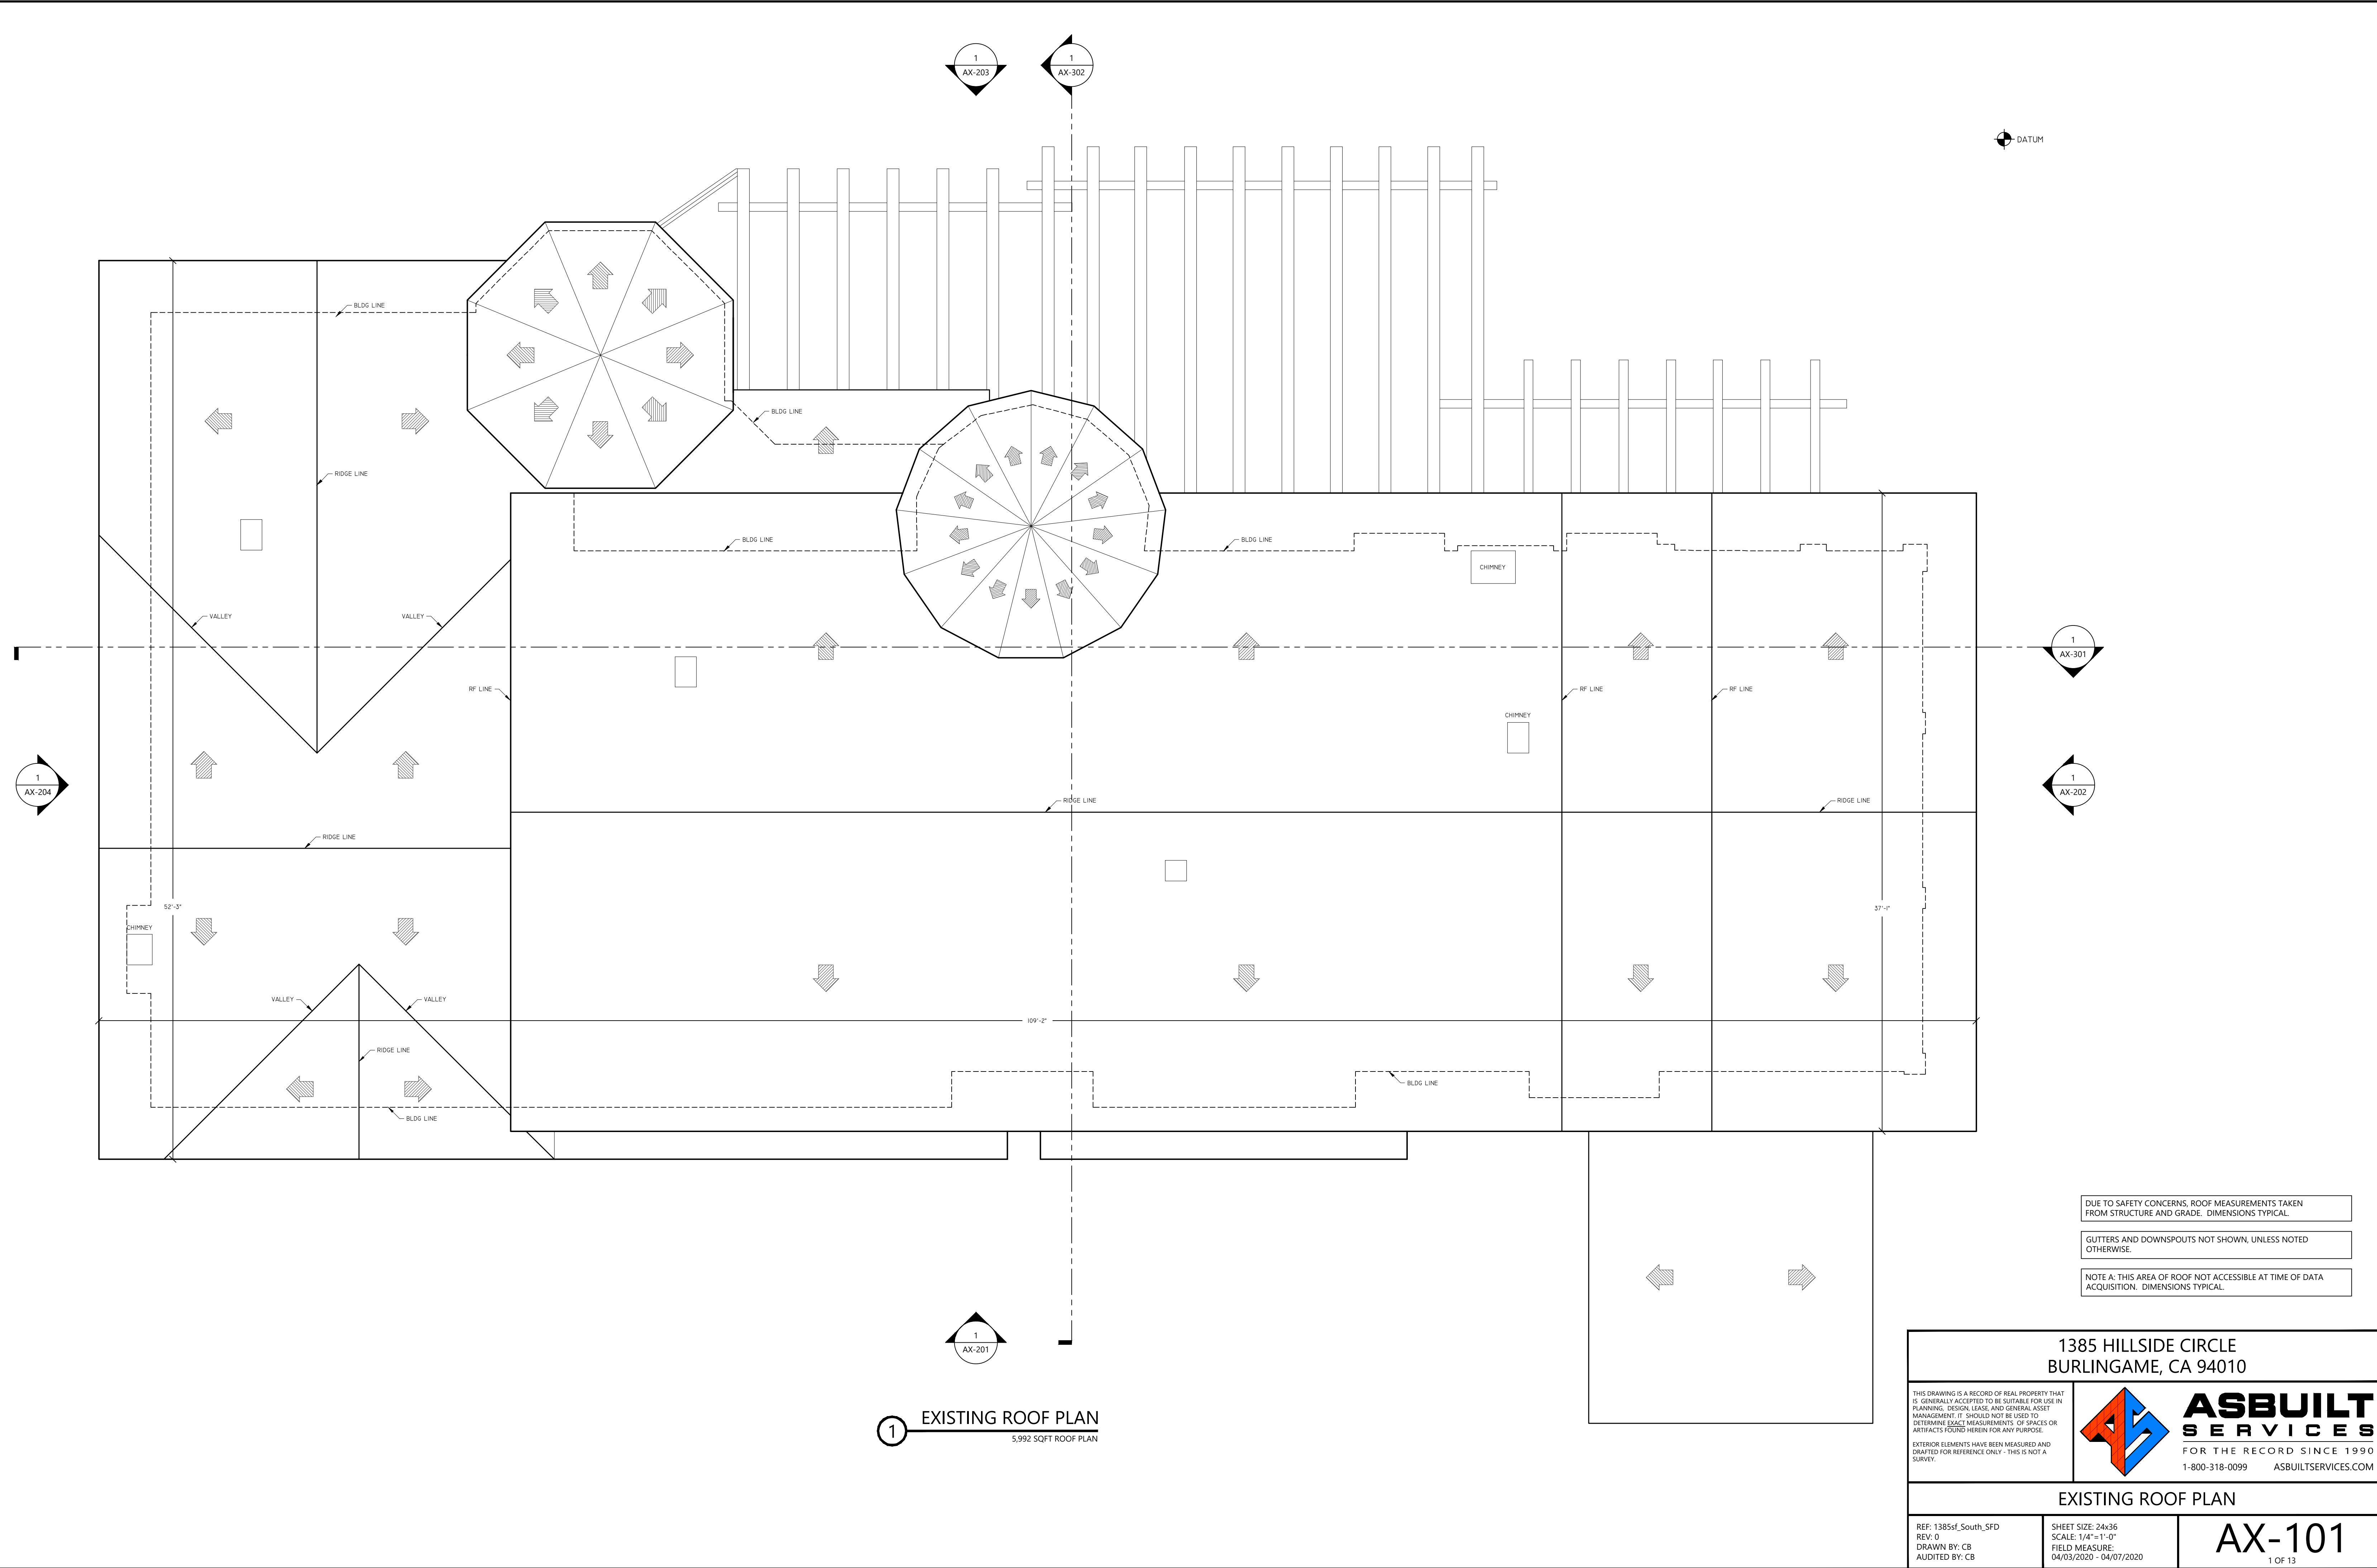


DUE TO SAFETY CONCERNS, ROOF MEASUREMENTS TAKEN FROM STRUCTURE AND GRADE. DIMENSIONS TYPICAL.

GUTTERS AND DOWNSPOUTS NOT SHOWN, UNLESS NOTED OTHERWISE.

NOTE A: THIS AREA OF ROOF NOT ACCESSIBLE AT TIME OF DATA ACQUISITION. DIMENSIONS TYPICAL.

| | | |
|---|---|-------------------|
| 1385 HILLSIDE CIRCLE BURLINGAME, CA 94010 | | |
| <small>THIS DRAWING IS A RECORD OF REAL PROPERTY THAT IS GENERALLY ACCEPTED TO BE SUITABLE FOR USE IN PLANNING, DESIGN, LEASE, AND GENERAL ASSET MANAGEMENT. IT SHOULD NOT BE USED TO DETERMINE EXACT MEASUREMENTS OF SPACES OR ARTIFACTS FOUND HEREIN FOR ANY PURPOSE. EXTERIOR ELEMENTS HAVE BEEN MEASURED AND QUOTED FOR REFERENCE ONLY. THIS IS NOT A SURVEY.</small> | | |
|  | | |
| FOR THE RECORD SINCE 1990 1-800-318-0099 ASBUILTSERVICES.COM | | |
| EXISTING ROOF PLAN | | |
| REF: 1385sf_South_SFD REV: 0 DRAWN BY: CB AUDITED BY: CB | SHEET SIZE: 24x36 SCALE: 1/4"=1'-0" FIELD MEASURE: 04/03/2020 - 04/07/2020 | AX-101 1 OF 13 |

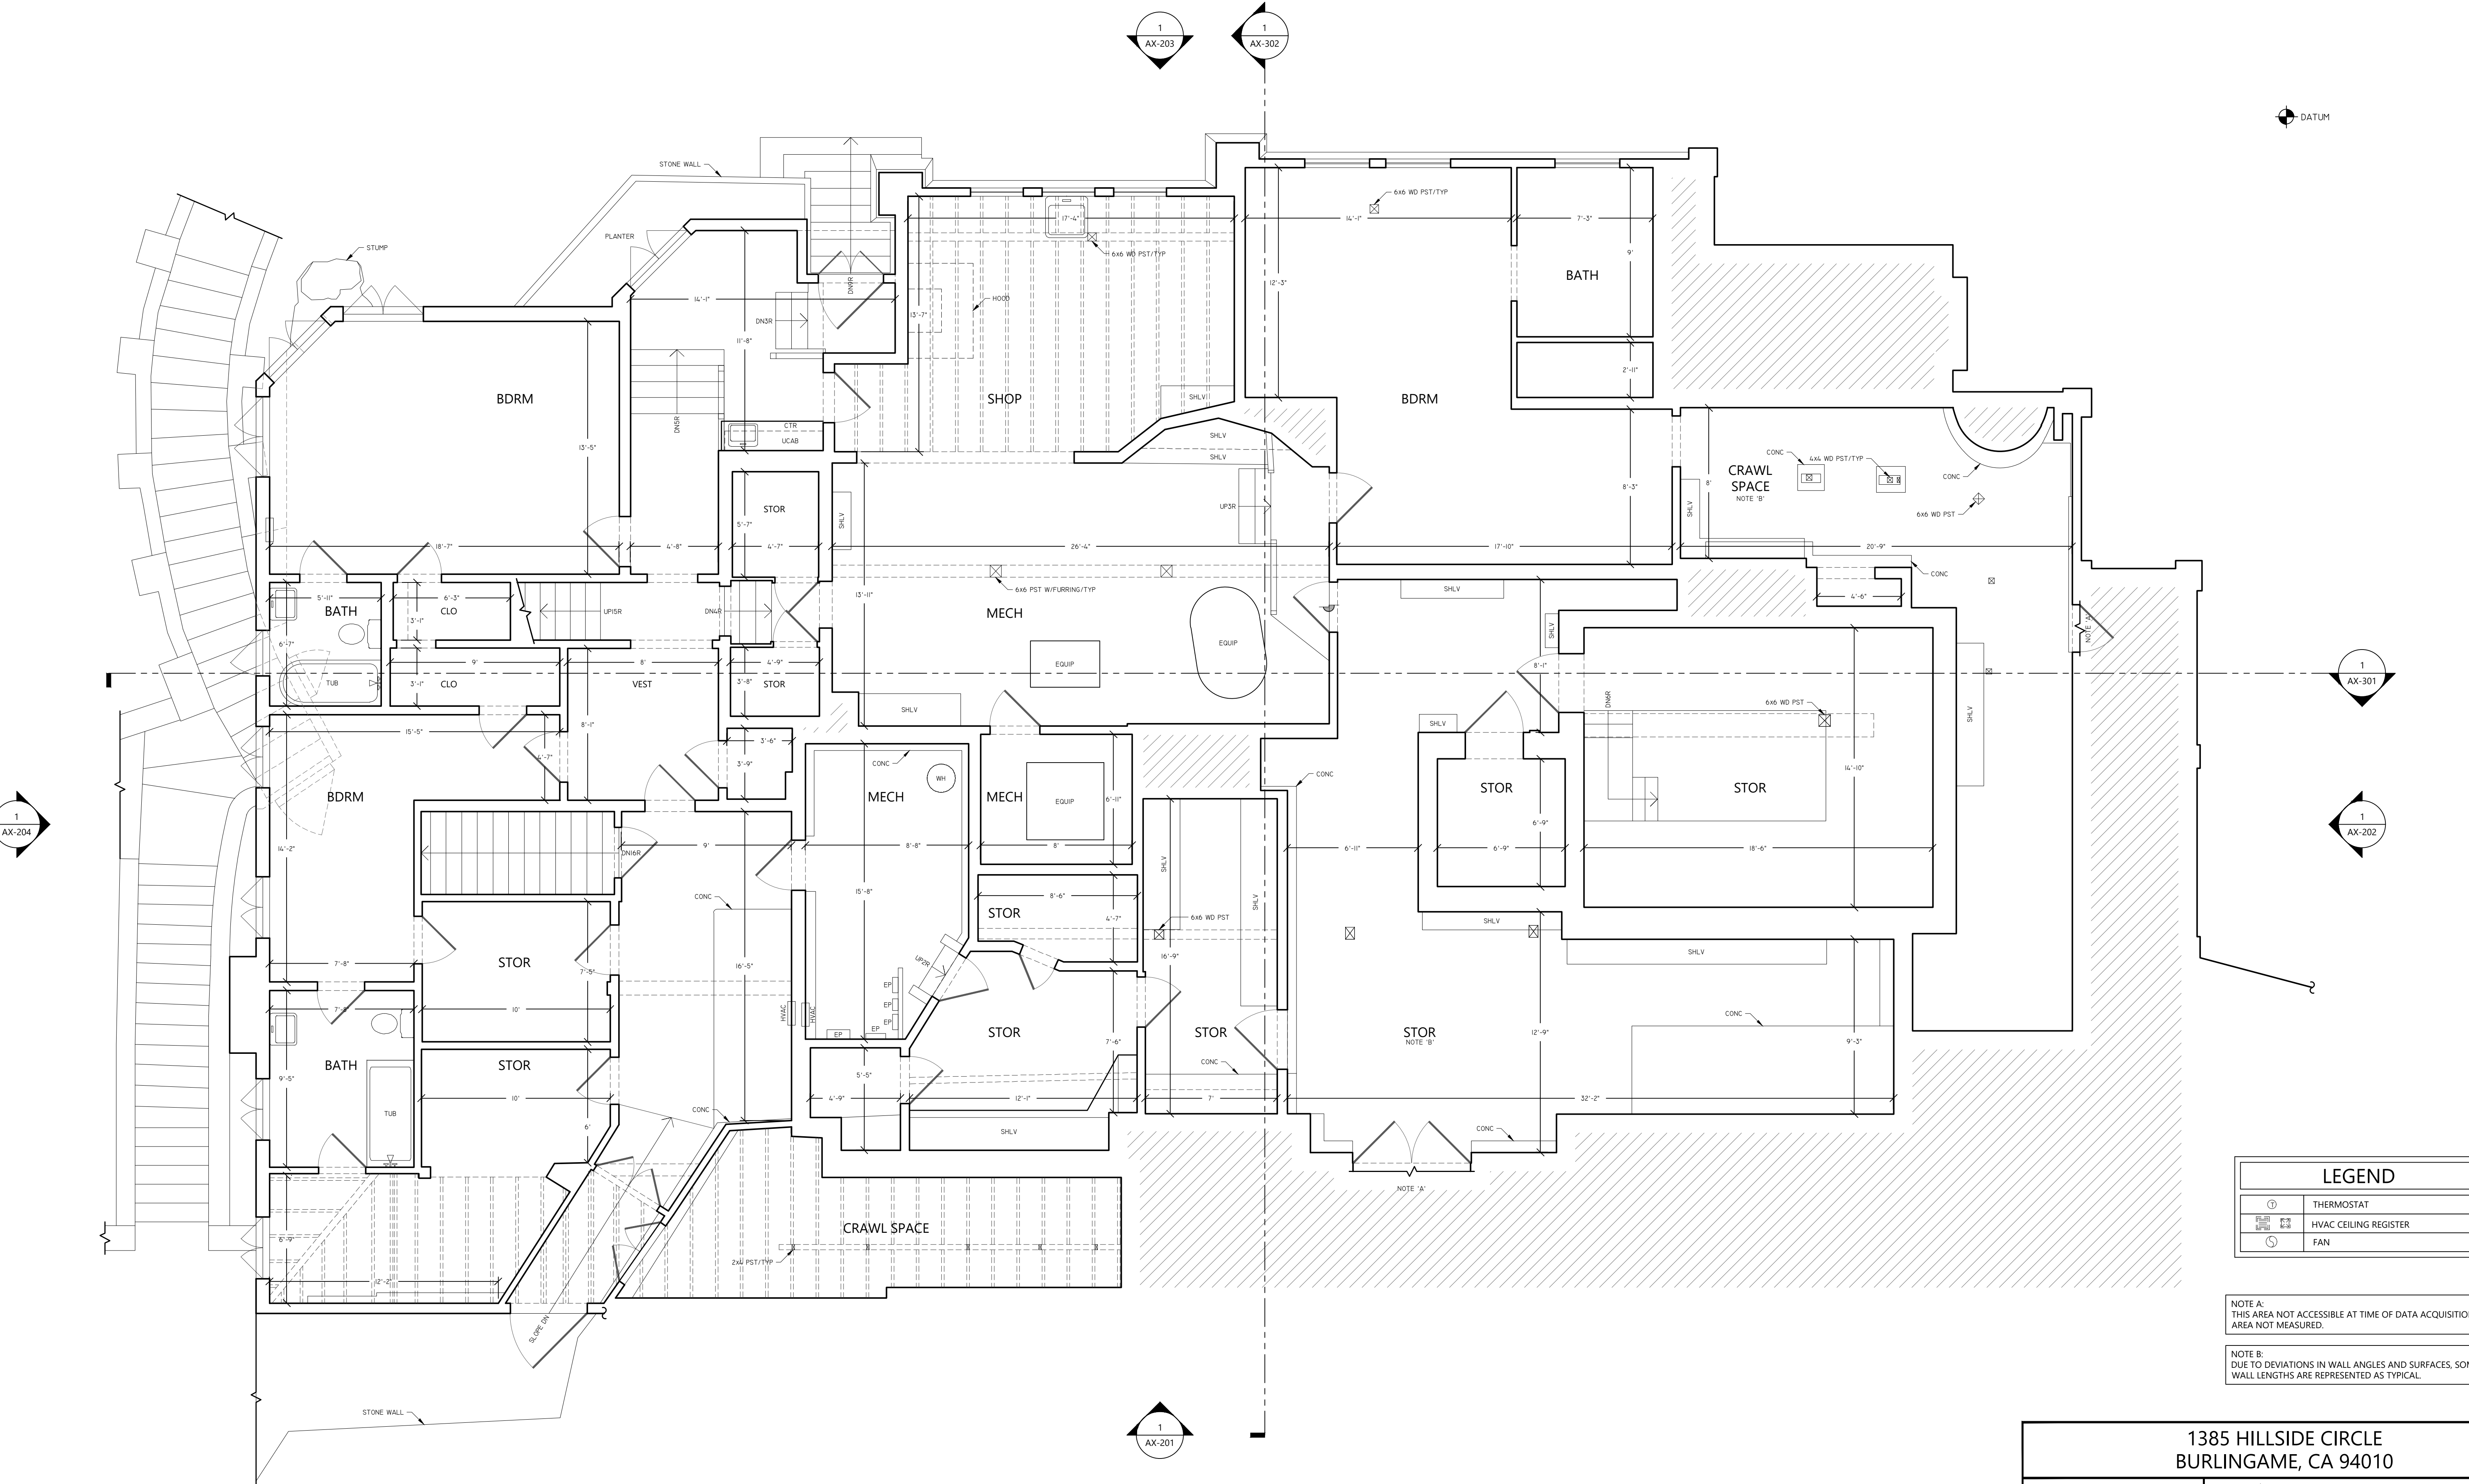

| LEGEND | |
|--------|-----------------------|
| | THERMOSTAT |
| | HVAC CEILING REGISTER |
| | FAN |

NOTE A:
THIS AREA NOT ACCESSIBLE AT TIME OF DATA ACQUISITION.
AREA NOT MEASURED.

NOTE B:
DUE TO DEVIATIONS IN WALL ANGLES AND SURFACES, SOME
WALL LENGTHS ARE REPRESENTED AS TYPICAL.

1 EXISTING BASEMENT LEVEL FLOOR PLAN
4,794 SQFT GROSS MEASURED AREA
553 SQFT MEASURED EXTERIOR SURFACES

1385 HILLSIDE CIRCLE
BURLINGAME, CA 94010

THIS DRAWING IS A RECORD OF REAL PROPERTY THAT IS GENERALLY ACCEPTED TO BE SUITABLE FOR USE IN PLANNING, DESIGN, LEASE, AND GENERAL ASSET MANAGEMENT. IT SHOULD NOT BE USED TO DETERMINE EXACT MEASUREMENTS OF SPACES OR ARTIFACTS FOUND HEREIN FOR ANY PURPOSE. EXTERIOR ELEMENTS HAVE BEEN MEASURED AND QUOTED FOR REFERENCE ONLY. THIS IS NOT A SURVEY.


FOR THE RECORD SINCE 1990
1-800-318-0099 ASBUILTSERVICES.COM

EXISTING FLOOR PLAN

REF: 1385sf_South_SFD
REV: 0
DRAWN BY: CB
AUDITED BY: CB

SHEET SIZE: 24x36
SCALE: 1/4"=1'-0"
FIELD MEASURE:
04/03/2020 - 04/07/2020








AX-102
2 OF 13

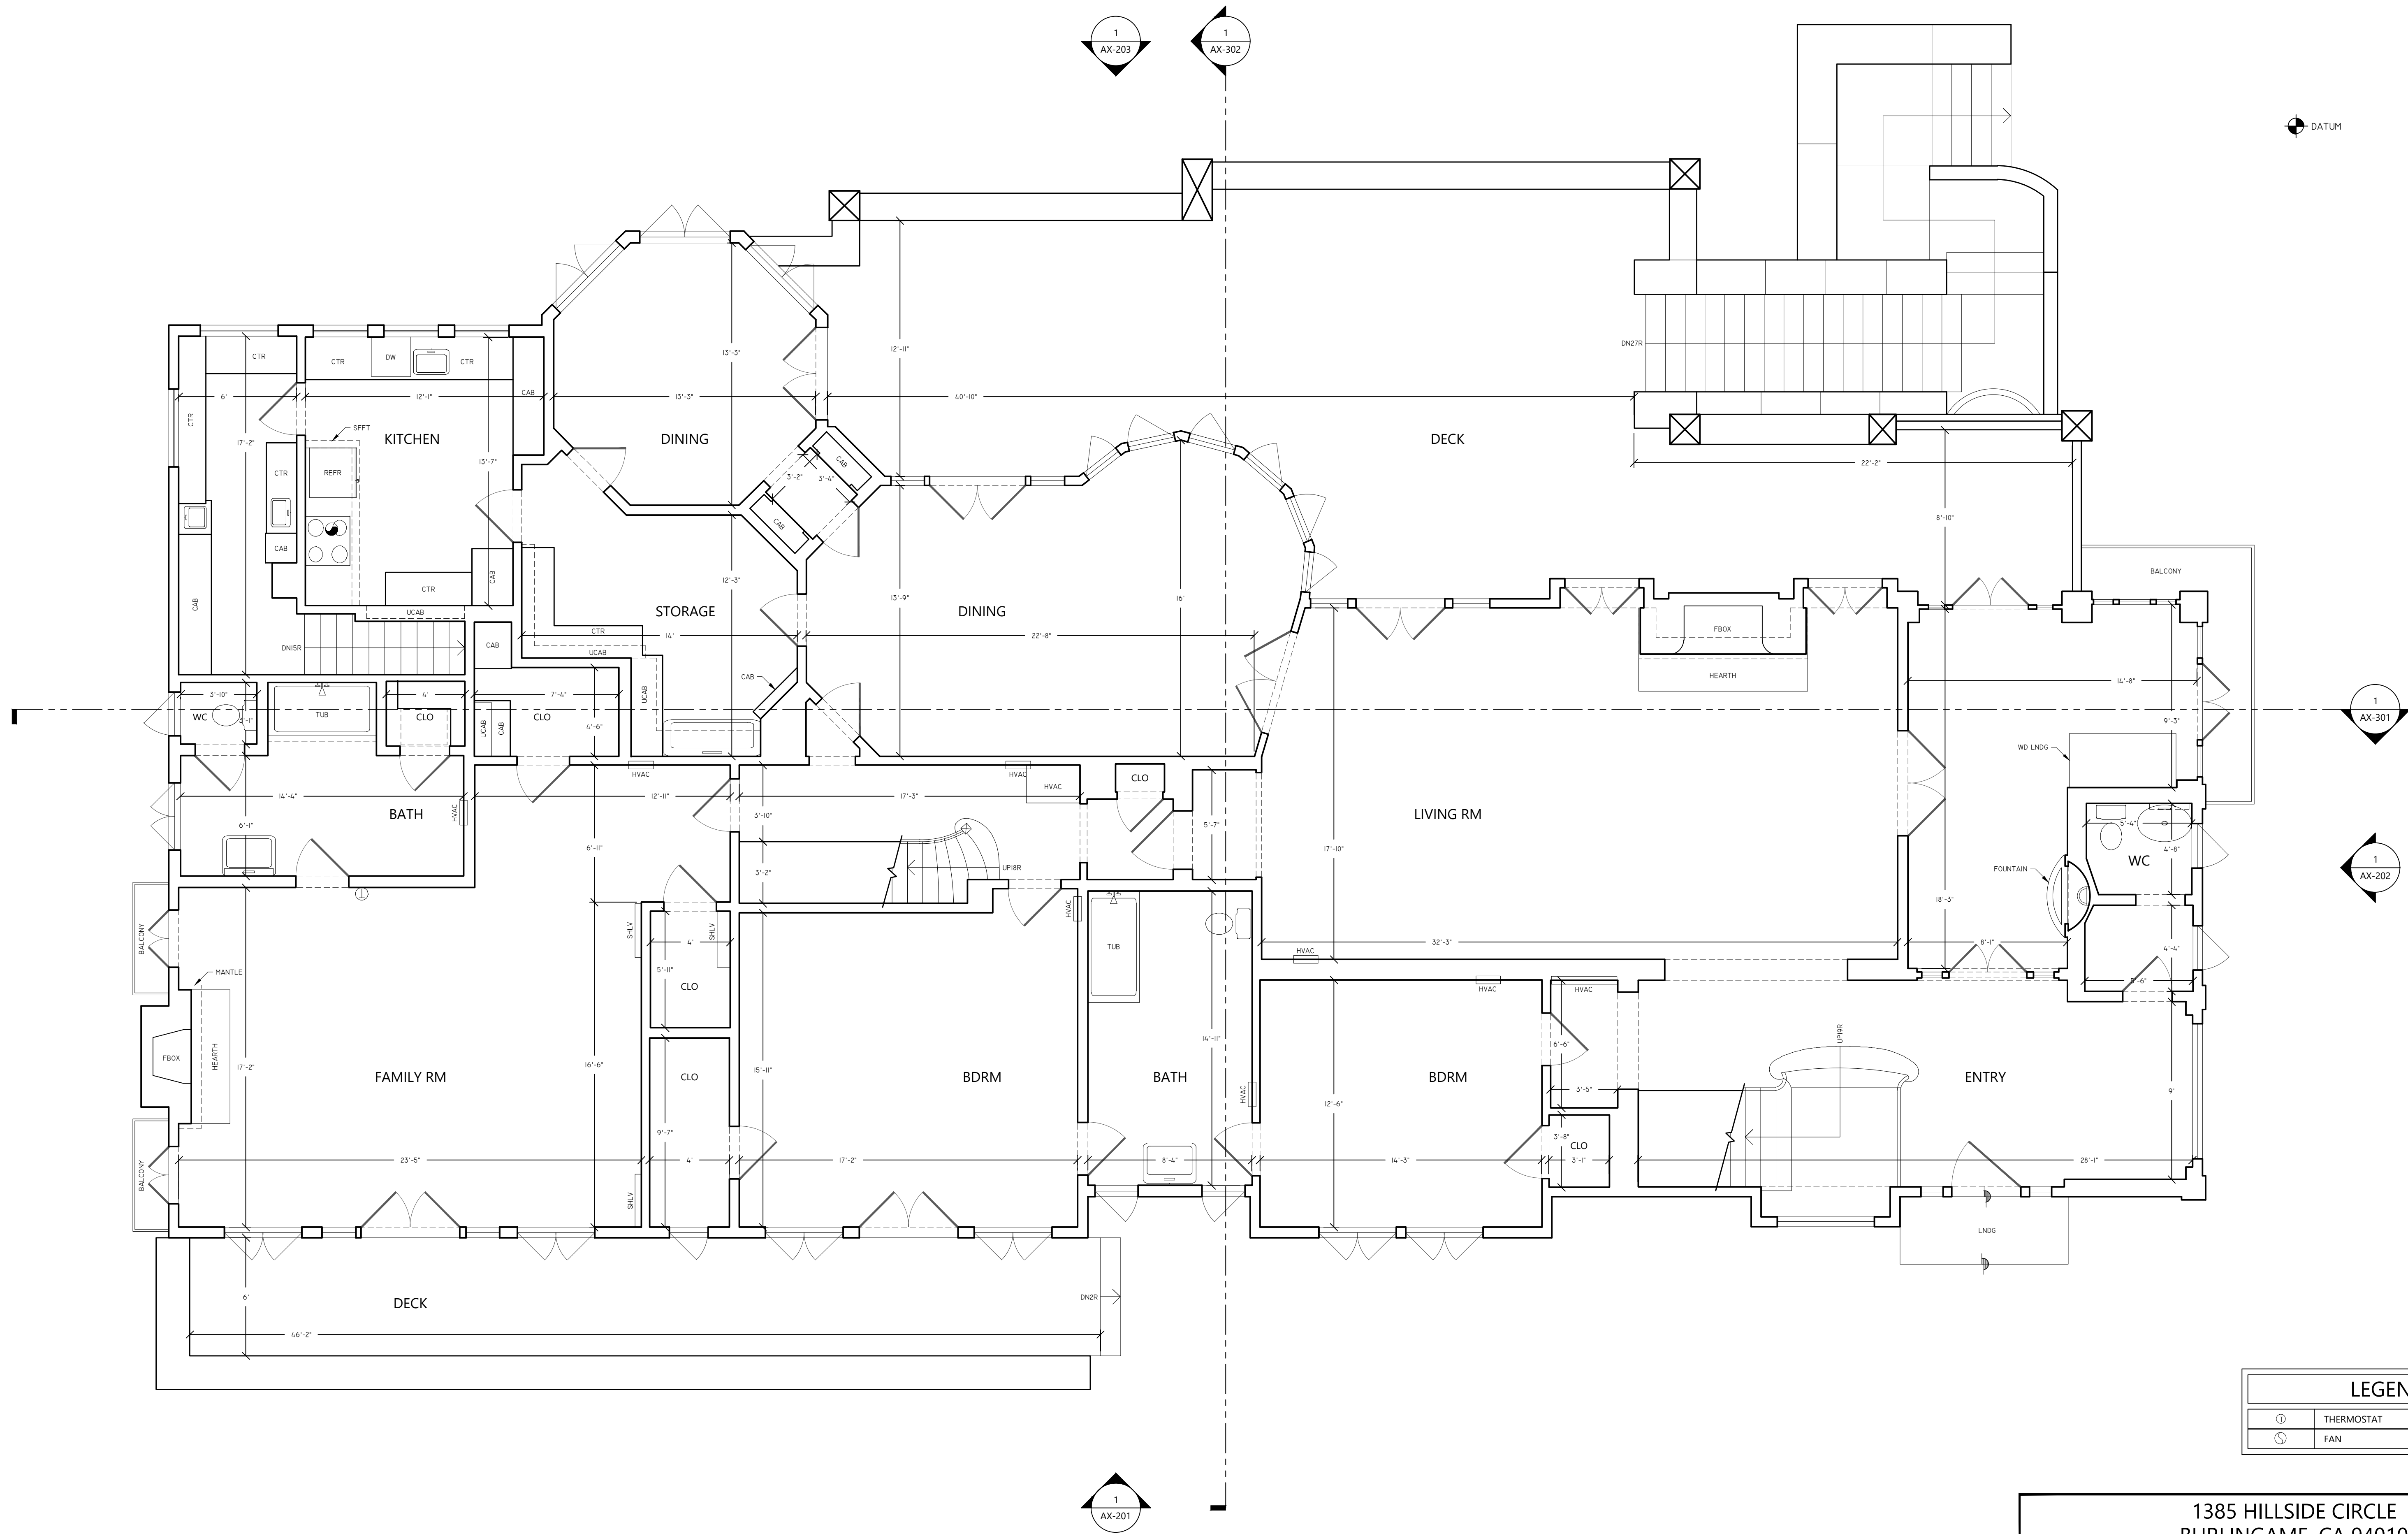

1 EXISTING ENTRY LEVEL FLOOR PLAN
3,961 SQFT GROSS MEASURED AREA
1,711 SQFT MEASURED EXTERIOR SURFACES

| LEGEND | |
|--------|------------|
| | THERMOSTAT |
| | FAN |

| | | |
|--|---|--------------------------|
| 1385 HILLSIDE CIRCLE BURLINGAME, CA 94010 | | |
| <small>THIS DRAWING IS A RECORD OF REAL PROPERTY THAT IS GENERALLY ACCEPTED TO BE SUITABLE FOR USE IN PLANNING, DESIGN, LEASE, AND GENERAL ASSET MANAGEMENT. IT SHOULD NOT BE USED TO DETERMINE EXACT MEASUREMENTS OF SPACES OR ARTIFACTS FOUND HEREIN FOR ANY PURPOSE. EXTERIOR ELEMENTS HAVE BEEN MEASURED AND QUOTED FOR REFERENCE ONLY - THIS IS NOT A SURVEY.</small> | | |
|  ASBUILT SERVICES FOR THE RECORD SINCE 1990 1-800-318-0099 ASBUILTSERVICES.COM | | |
| EXISTING FLOOR PLAN | | |
| REF: 1385sf_South_SFD REV: 0 DRAWN BY: CB AUDITED BY: CB | SHEET SIZE: 24x36 SCALE: 1/4"=1'-0" FIELD MEASURE: 04/03/2020 - 04/07/2020 | AX-103 3 OF 13 |

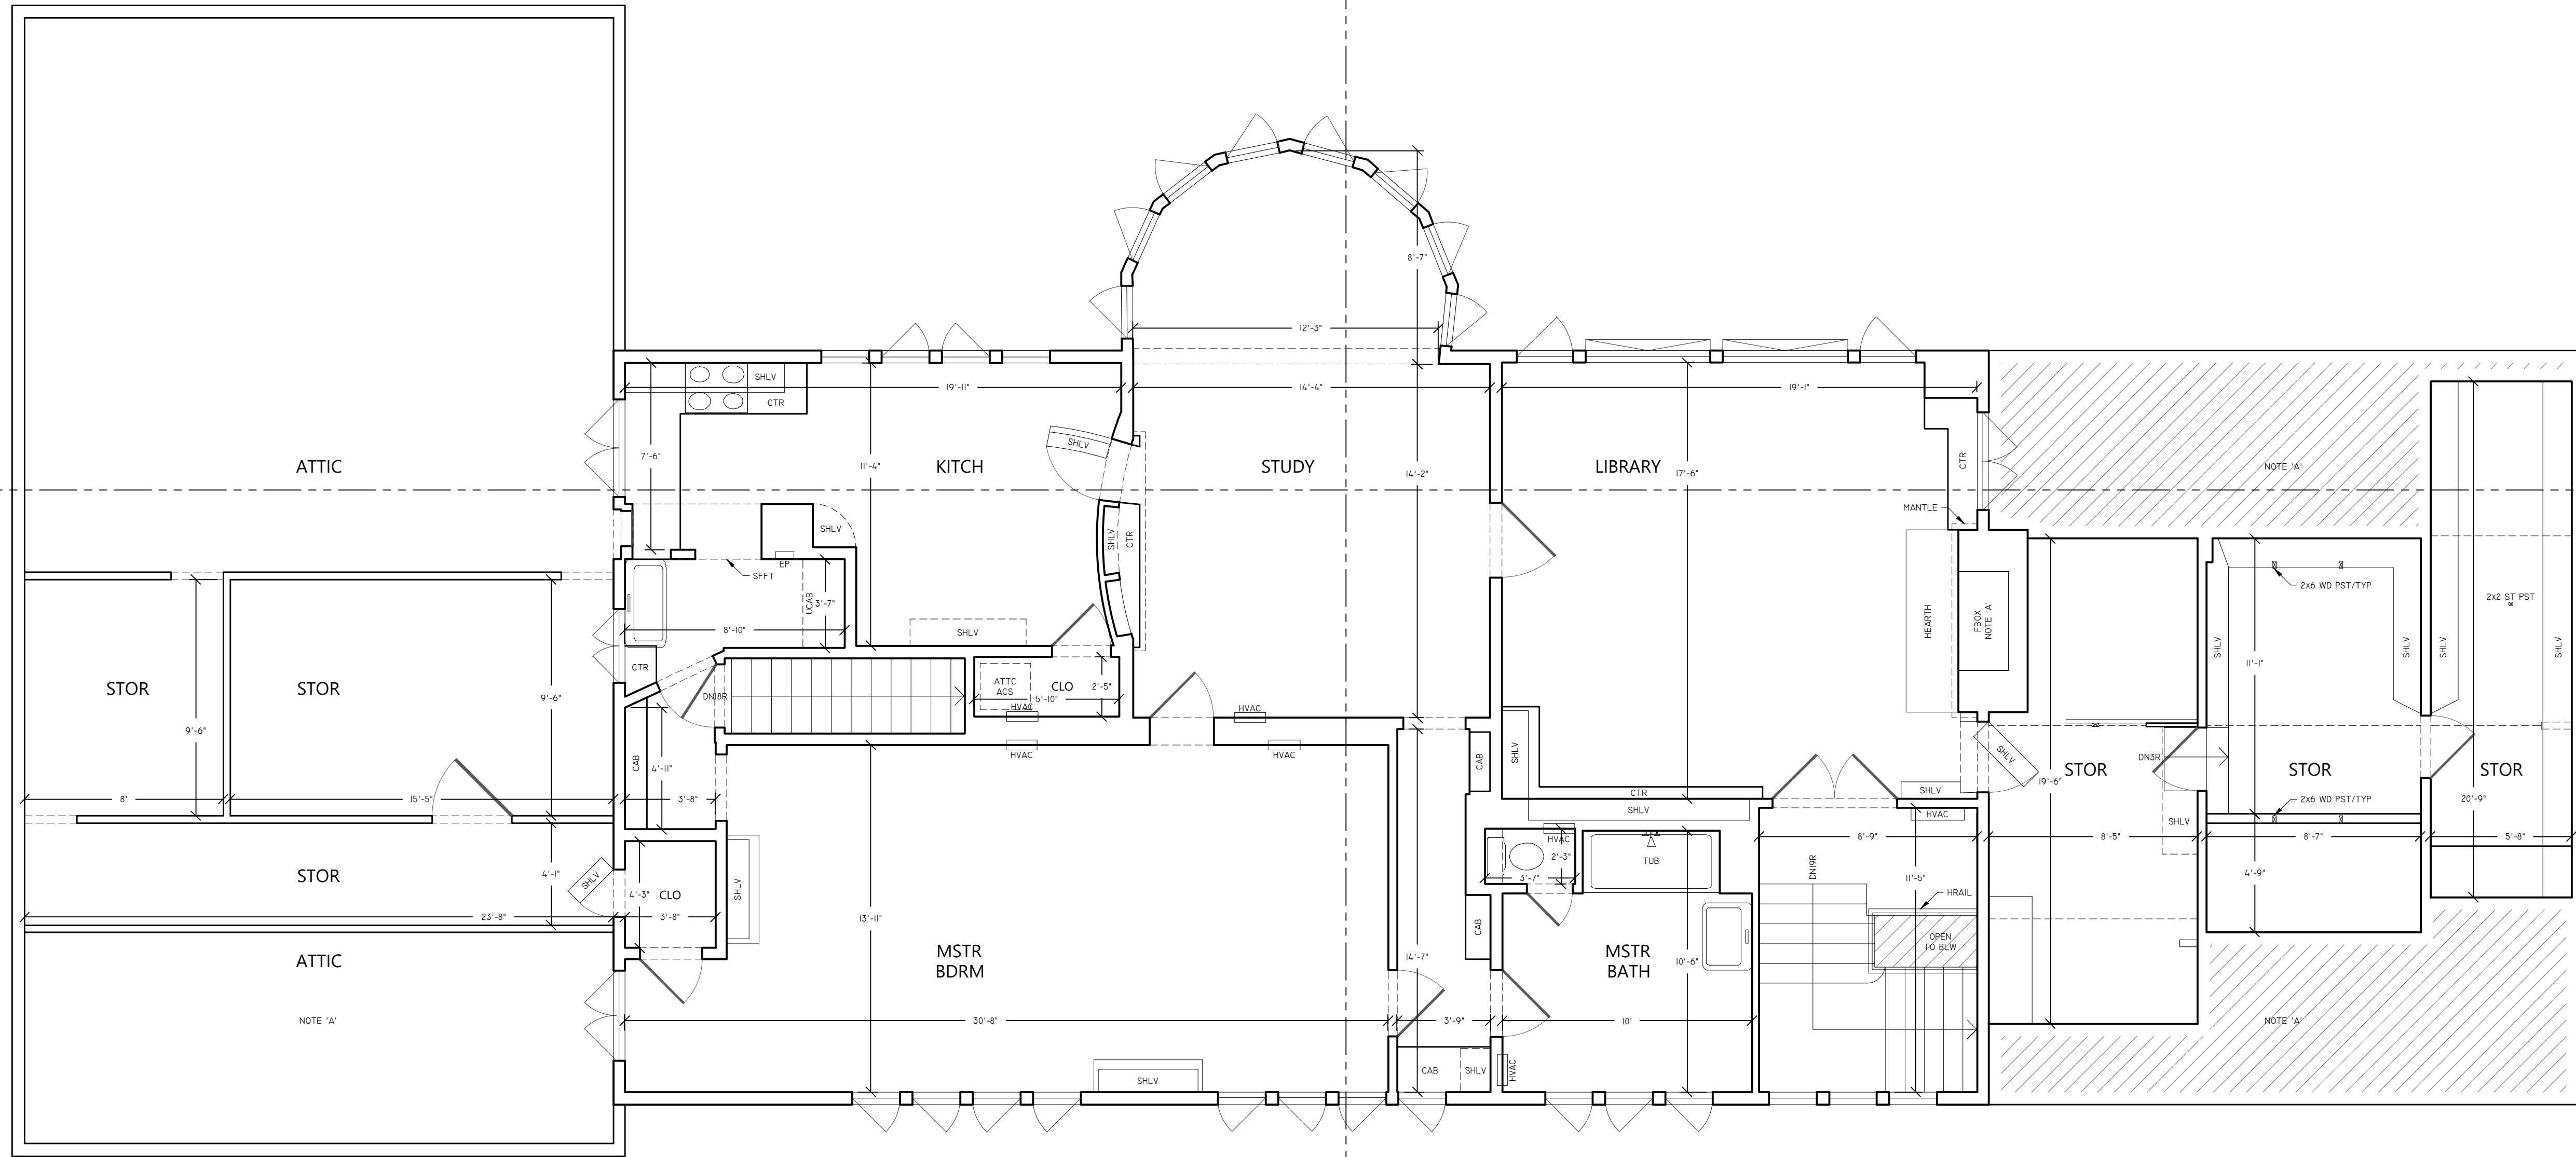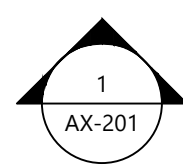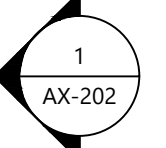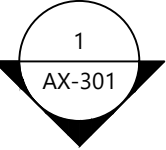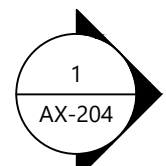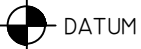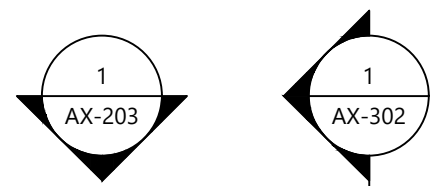

| LEGEND | |
|--------|------------|
| Ⓜ | THERMOSTAT |
| Ⓢ | FAN |

NOTE A:
THIS AREA NOT ACCESSIBLE AT TIME OF DATA ACQUISITION.
AREA NOT MEASURED.

1 EXISTING SECOND LEVEL FLOOR PLAN
2,548 SQFT GROSS MEASURED AREA

1385 HILLSIDE CIRCLE
BURLINGAME, CA 94010

THIS DRAWING IS A RECORD OF REAL PROPERTY THAT IS GENERALLY ACCEPTED TO BE SUITABLE FOR USE IN PLANNING, DESIGN, LEASE, AND GENERAL ASSET MANAGEMENT. IT SHOULD NOT BE USED TO DETERMINE EXACT MEASUREMENTS OF SPACES OR ARTIFACTS FOUND HEREIN FOR ANY PURPOSE. EXTERIOR ELEMENTS HAVE BEEN MEASURED AND DRAFTED FOR REFERENCE ONLY. THIS IS NOT A SURVEY.


**ASBUILT
SERVICES**
FOR THE RECORD SINCE 1990
1-800-318-0099 ASBUILTSERVICES.COM

EXISTING FLOOR PLAN


REF: 1385sf_South_SF
REV: 0
DRAWN BY: CB
AUDITED BY: CB

SHEET SIZE: 24x36
SCALE: 1/4"=1'-0"
FIELD MEASURE:
04/03/2020 - 04/07/2020


AX-104
4 OF 13

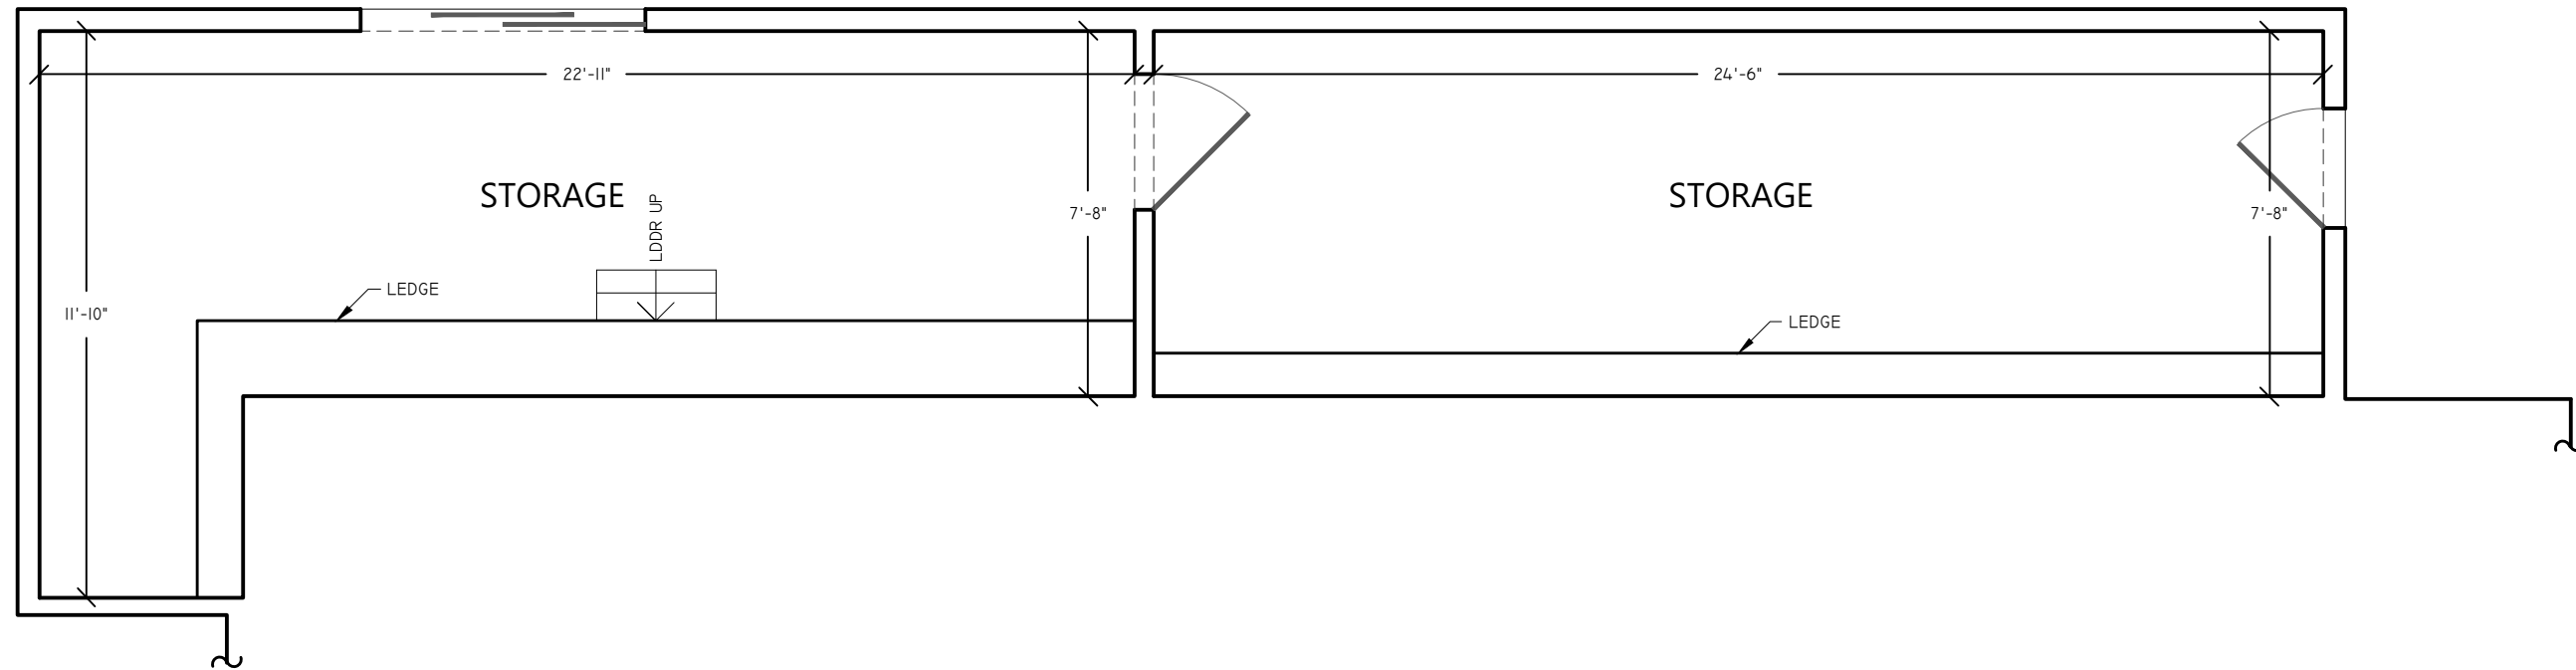

2 EXISTING GARAGE -1 LOWER LEVEL FLOOR PLAN
416 SQFT GROSS MEASURED AREA

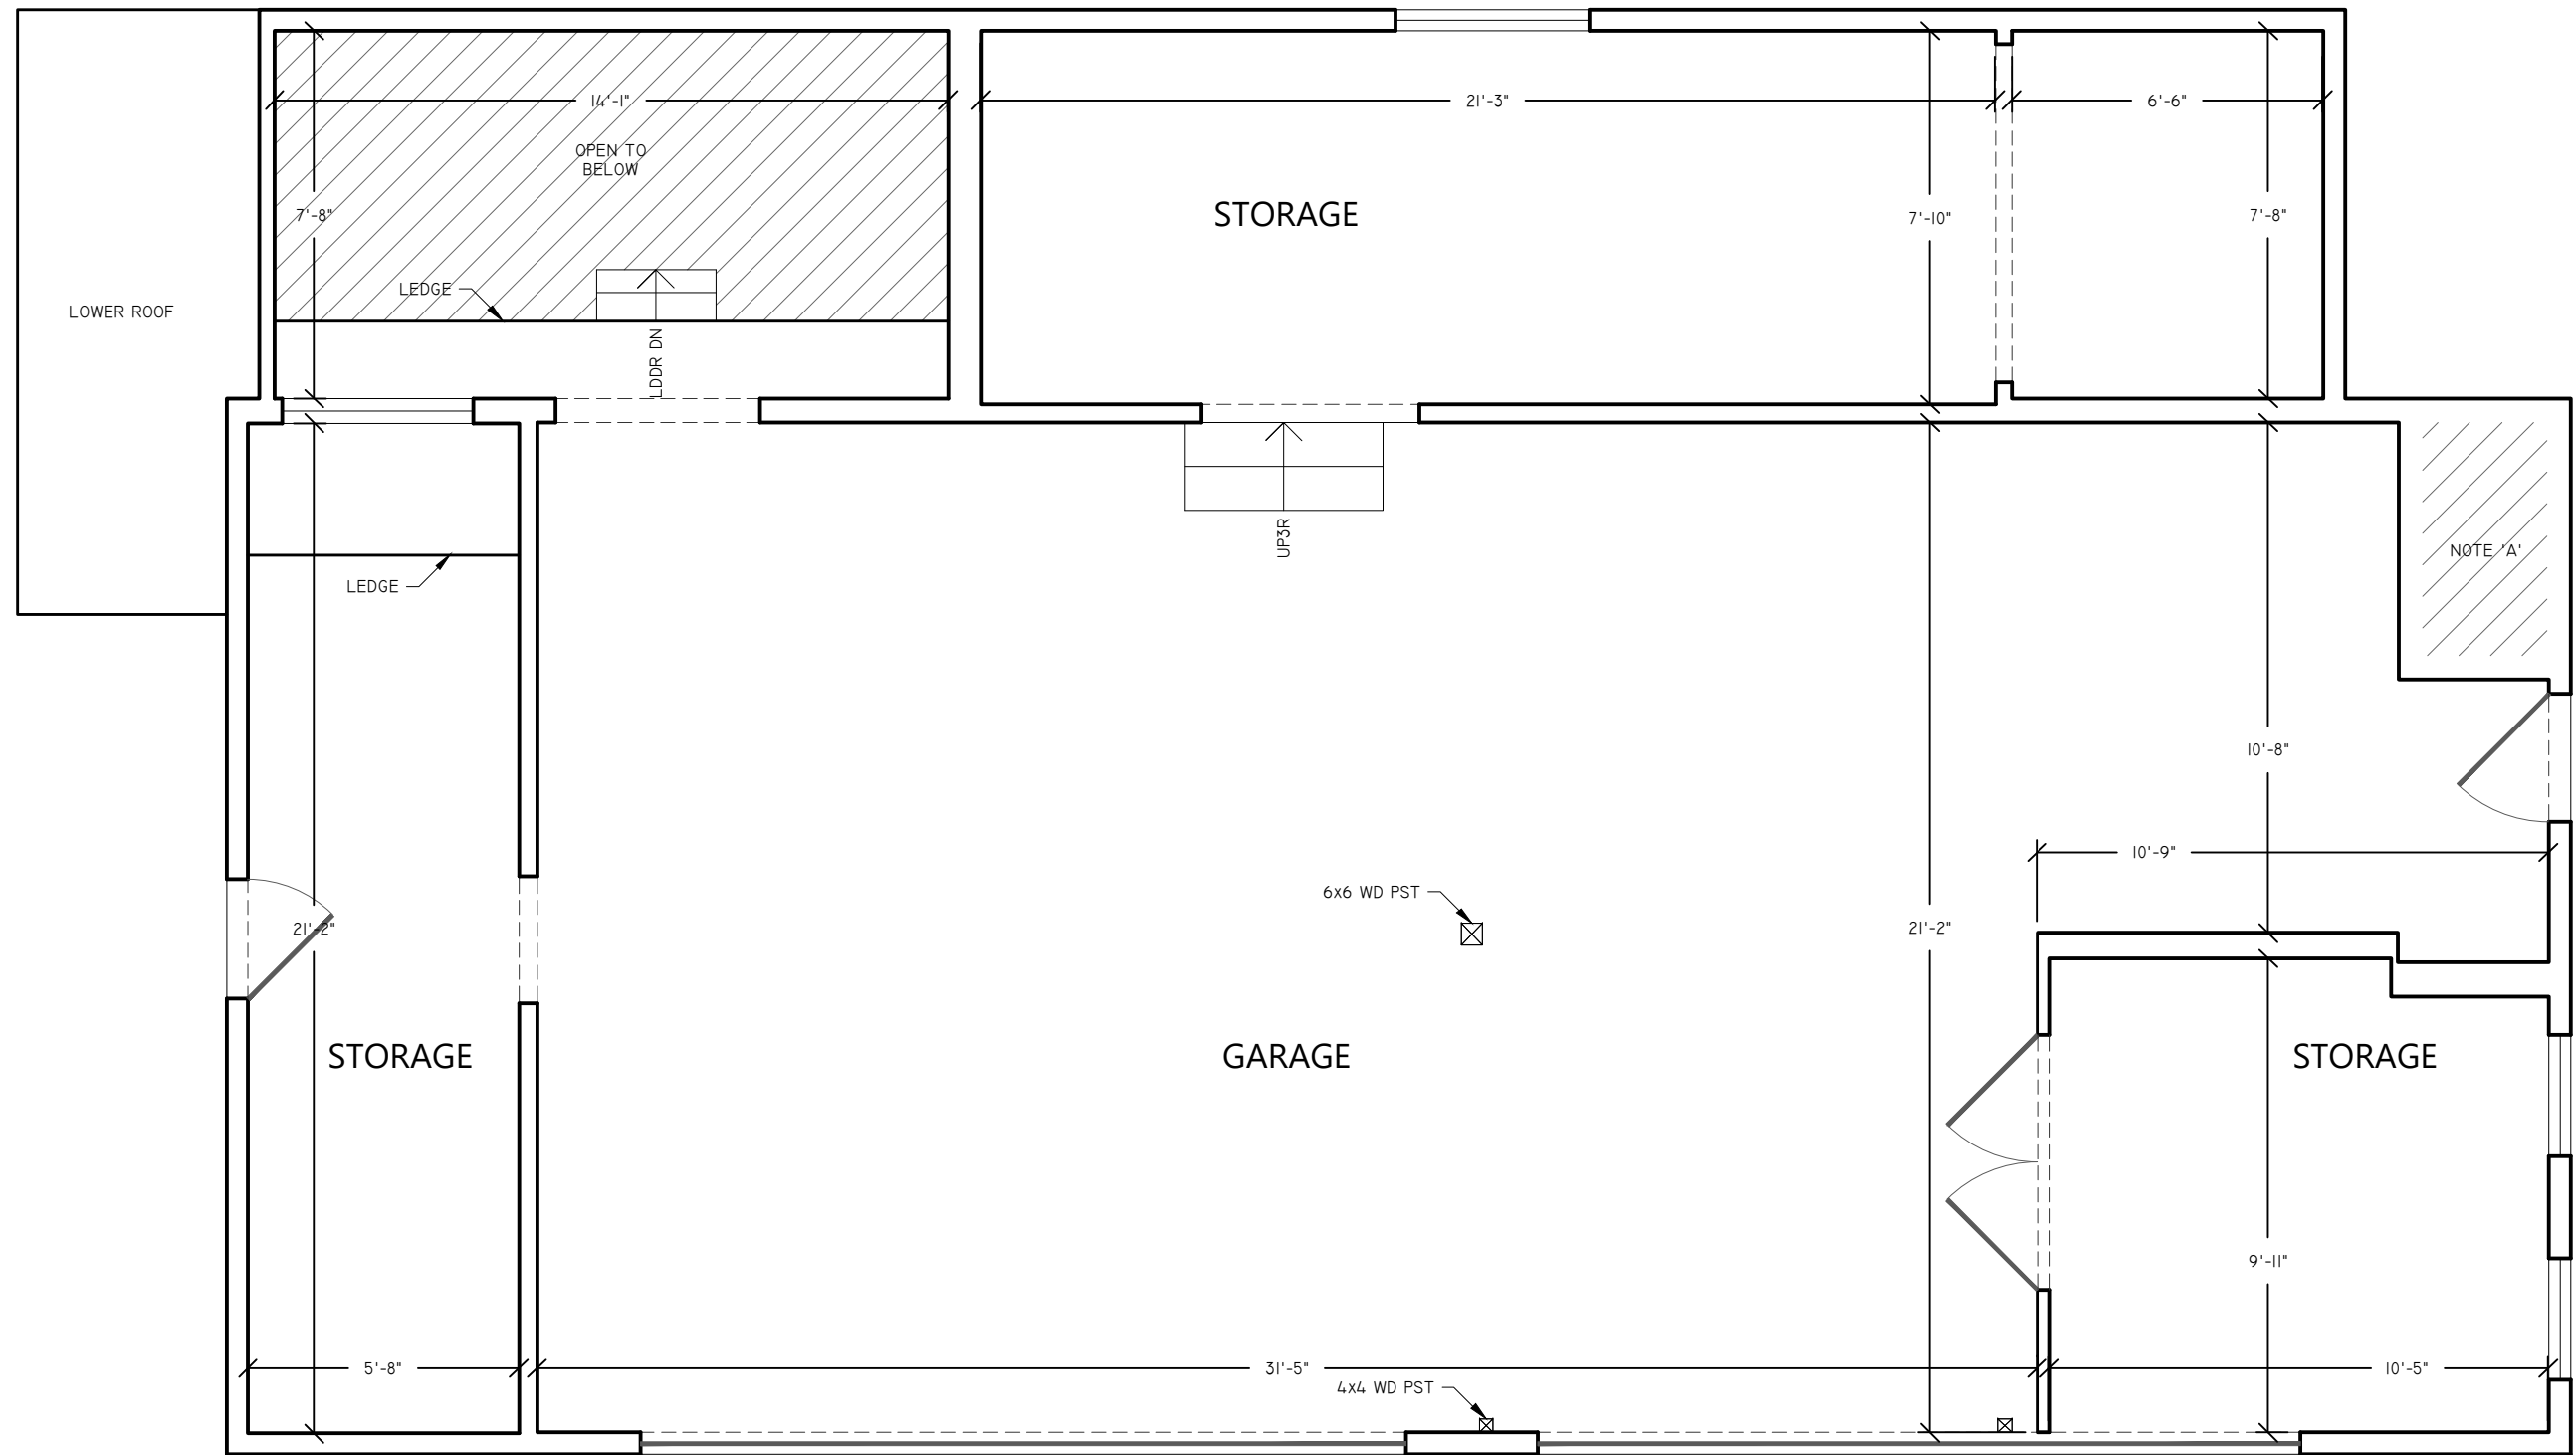

1 EXISTING GARAGE - 1 ENTRY LEVEL FLOOR PLAN
1,440 SQFT GROSS MEASURED AREA

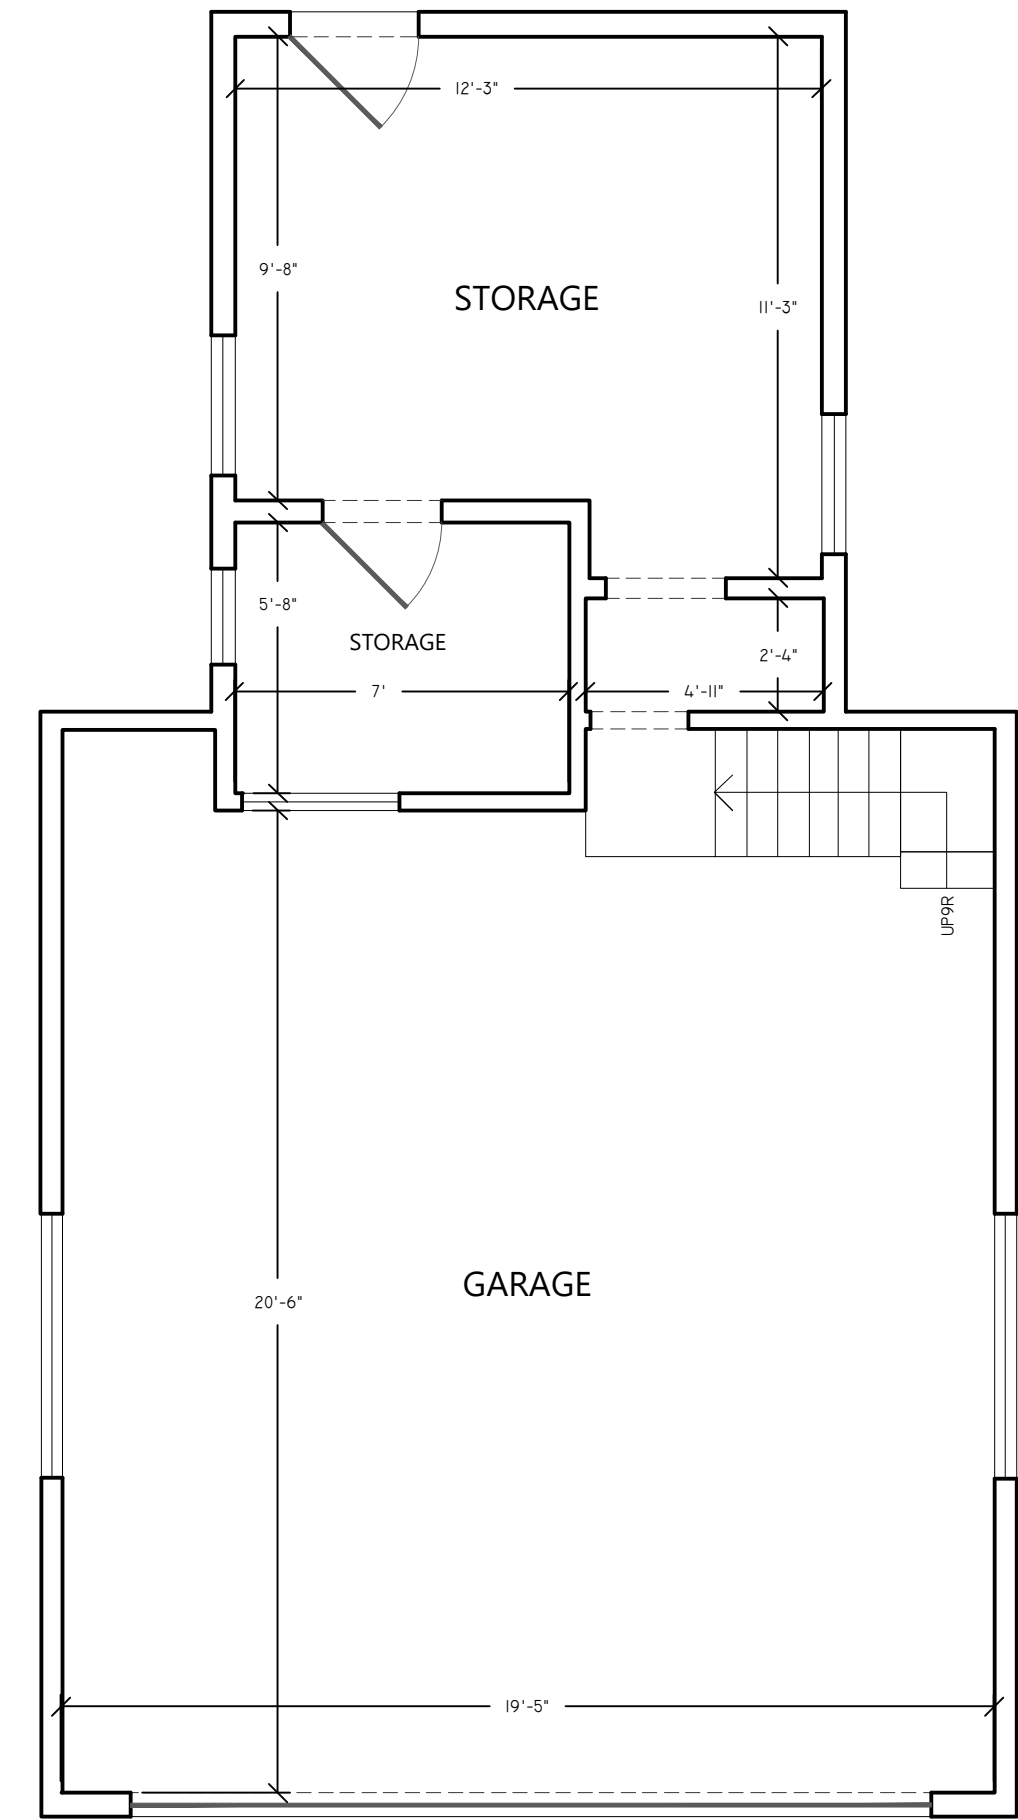


3 EXISTING GARAGE - 2 FLOOR PLAN
661 SQFT GROSS MEASURED AREA

NOTE A:
THIS AREA NOT ACCESSIBLE AT TIME OF DATA ACQUISITION.
AREA NOT MEASURED.

THESE ARE BASIC FLOOR PLANS. NO INTERIOR ELEMENTS SHOWN,
UNLESS NOTED OTHERWISE.

1385 HILLSIDE CIRCLE
BURLINGAME, CA 94010

THIS DRAWING IS A RECORD OF REAL PROPERTY THAT
IS GENERALLY ACCEPTED TO BE SUITABLE FOR USE IN
PLANNING, DESIGN, LEASE, AND GENERAL ASSET
MANAGEMENT. IT SHOULD NOT BE USED TO
DETERMINE EXACT MEASUREMENTS OF SPACES OR
ARTIFACTS FOUND HEREIN FOR ANY PURPOSE.
EXTERIOR ELEMENTS HAVE BEEN MEASURED AND
QUOTED FOR REFERENCE ONLY. THIS IS NOT A
SURVEY.

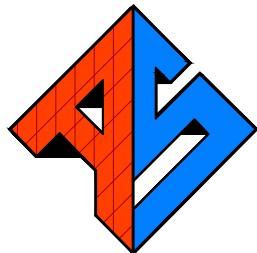

**ASBUILT
SERVICES**
FOR THE RECORD SINCE 1990
1-800-318-0099 ASBUILTSERVICES.COM

EXISTING GARAGE FLOOR PLANS

REF: 1385sf_South_SFD
REV: 0
DRAWN BY: CB
AUDITED BY: CB

SHEET SIZE: 24x36
SCALE: 1/4"=1'-0"
FIELD MEASURE:
04/03/2020 - 04/07/2020

AX-105
5 OF 13



NOTE A:
THIS ELEMENT NOT MEASURED, ILLUSTRATORS RENDERING.

1 EXISTING WEST ELEVATION

1385 HILLSIDE CIRCLE
BURLINGAME, CA 94010

THIS DRAWING IS A RECORD OF REAL PROPERTY THAT IS GENERALLY ACCEPTED TO BE SUITABLE FOR USE IN PLANNING, DESIGN, LEASE, AND GENERAL ASSET MANAGEMENT. IT SHOULD NOT BE USED TO DETERMINE EXACT MEASUREMENTS OF SPACES OR ARTIFACTS FOUND HEREIN FOR ANY PURPOSE. EXTERIOR ELEMENTS HAVE BEEN MEASURED AND DRAFTED FOR REFERENCE ONLY. THIS IS NOT A SURVEY.




1-800-318-0099 ASBUILTSERVICES.COM

EXISTING EXTERIOR ELEVATION

REF: 1385sf_South_SFD
REV: 0
DRAWN BY: CB
AUDITED BY: CB

SHEET SIZE: 24x36
SCALE: 1/4"=1'-0"
FIELD MEASURE:
04/03/2020 - 04/07/2020

AX-202
7 OF 13

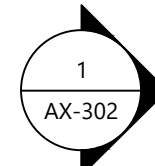

1 EXISTING SOUTH ELEVATION

NOTE A:
THIS ELEMENT NOT MEASURED, ILLUSTRATORS RENDERING.

1385 HILLSIDE CIRCLE
BURLINGAME, CA 94010

THIS DRAWING IS A RECORD OF REAL PROPERTY THAT IS GENERALLY ACCEPTED TO BE SUITABLE FOR USE IN PLANNING, DESIGN, LEASE, AND GENERAL ASSET MANAGEMENT. IT SHOULD NOT BE USED TO DETERMINE EXACT MEASUREMENTS OF SPACES OR ARTIFACTS FOUND HEREIN FOR ANY PURPOSE. EXTERIOR ELEMENTS HAVE BEEN MEASURED AND QUANTIFIED FOR REFERENCE ONLY - THIS IS NOT A SURVEY.





EXISTING EXTERIOR ELEVATION

REF: 1385sf_South_SF
REV: 0
DRAWN BY: CB
AUDITED BY: CB

SHEET SIZE: 24x36
SCALE: 1/4"=1'-0"
FIELD MEASURE:
04/03/2020 - 04/07/2020

AX-203
8 OF 13

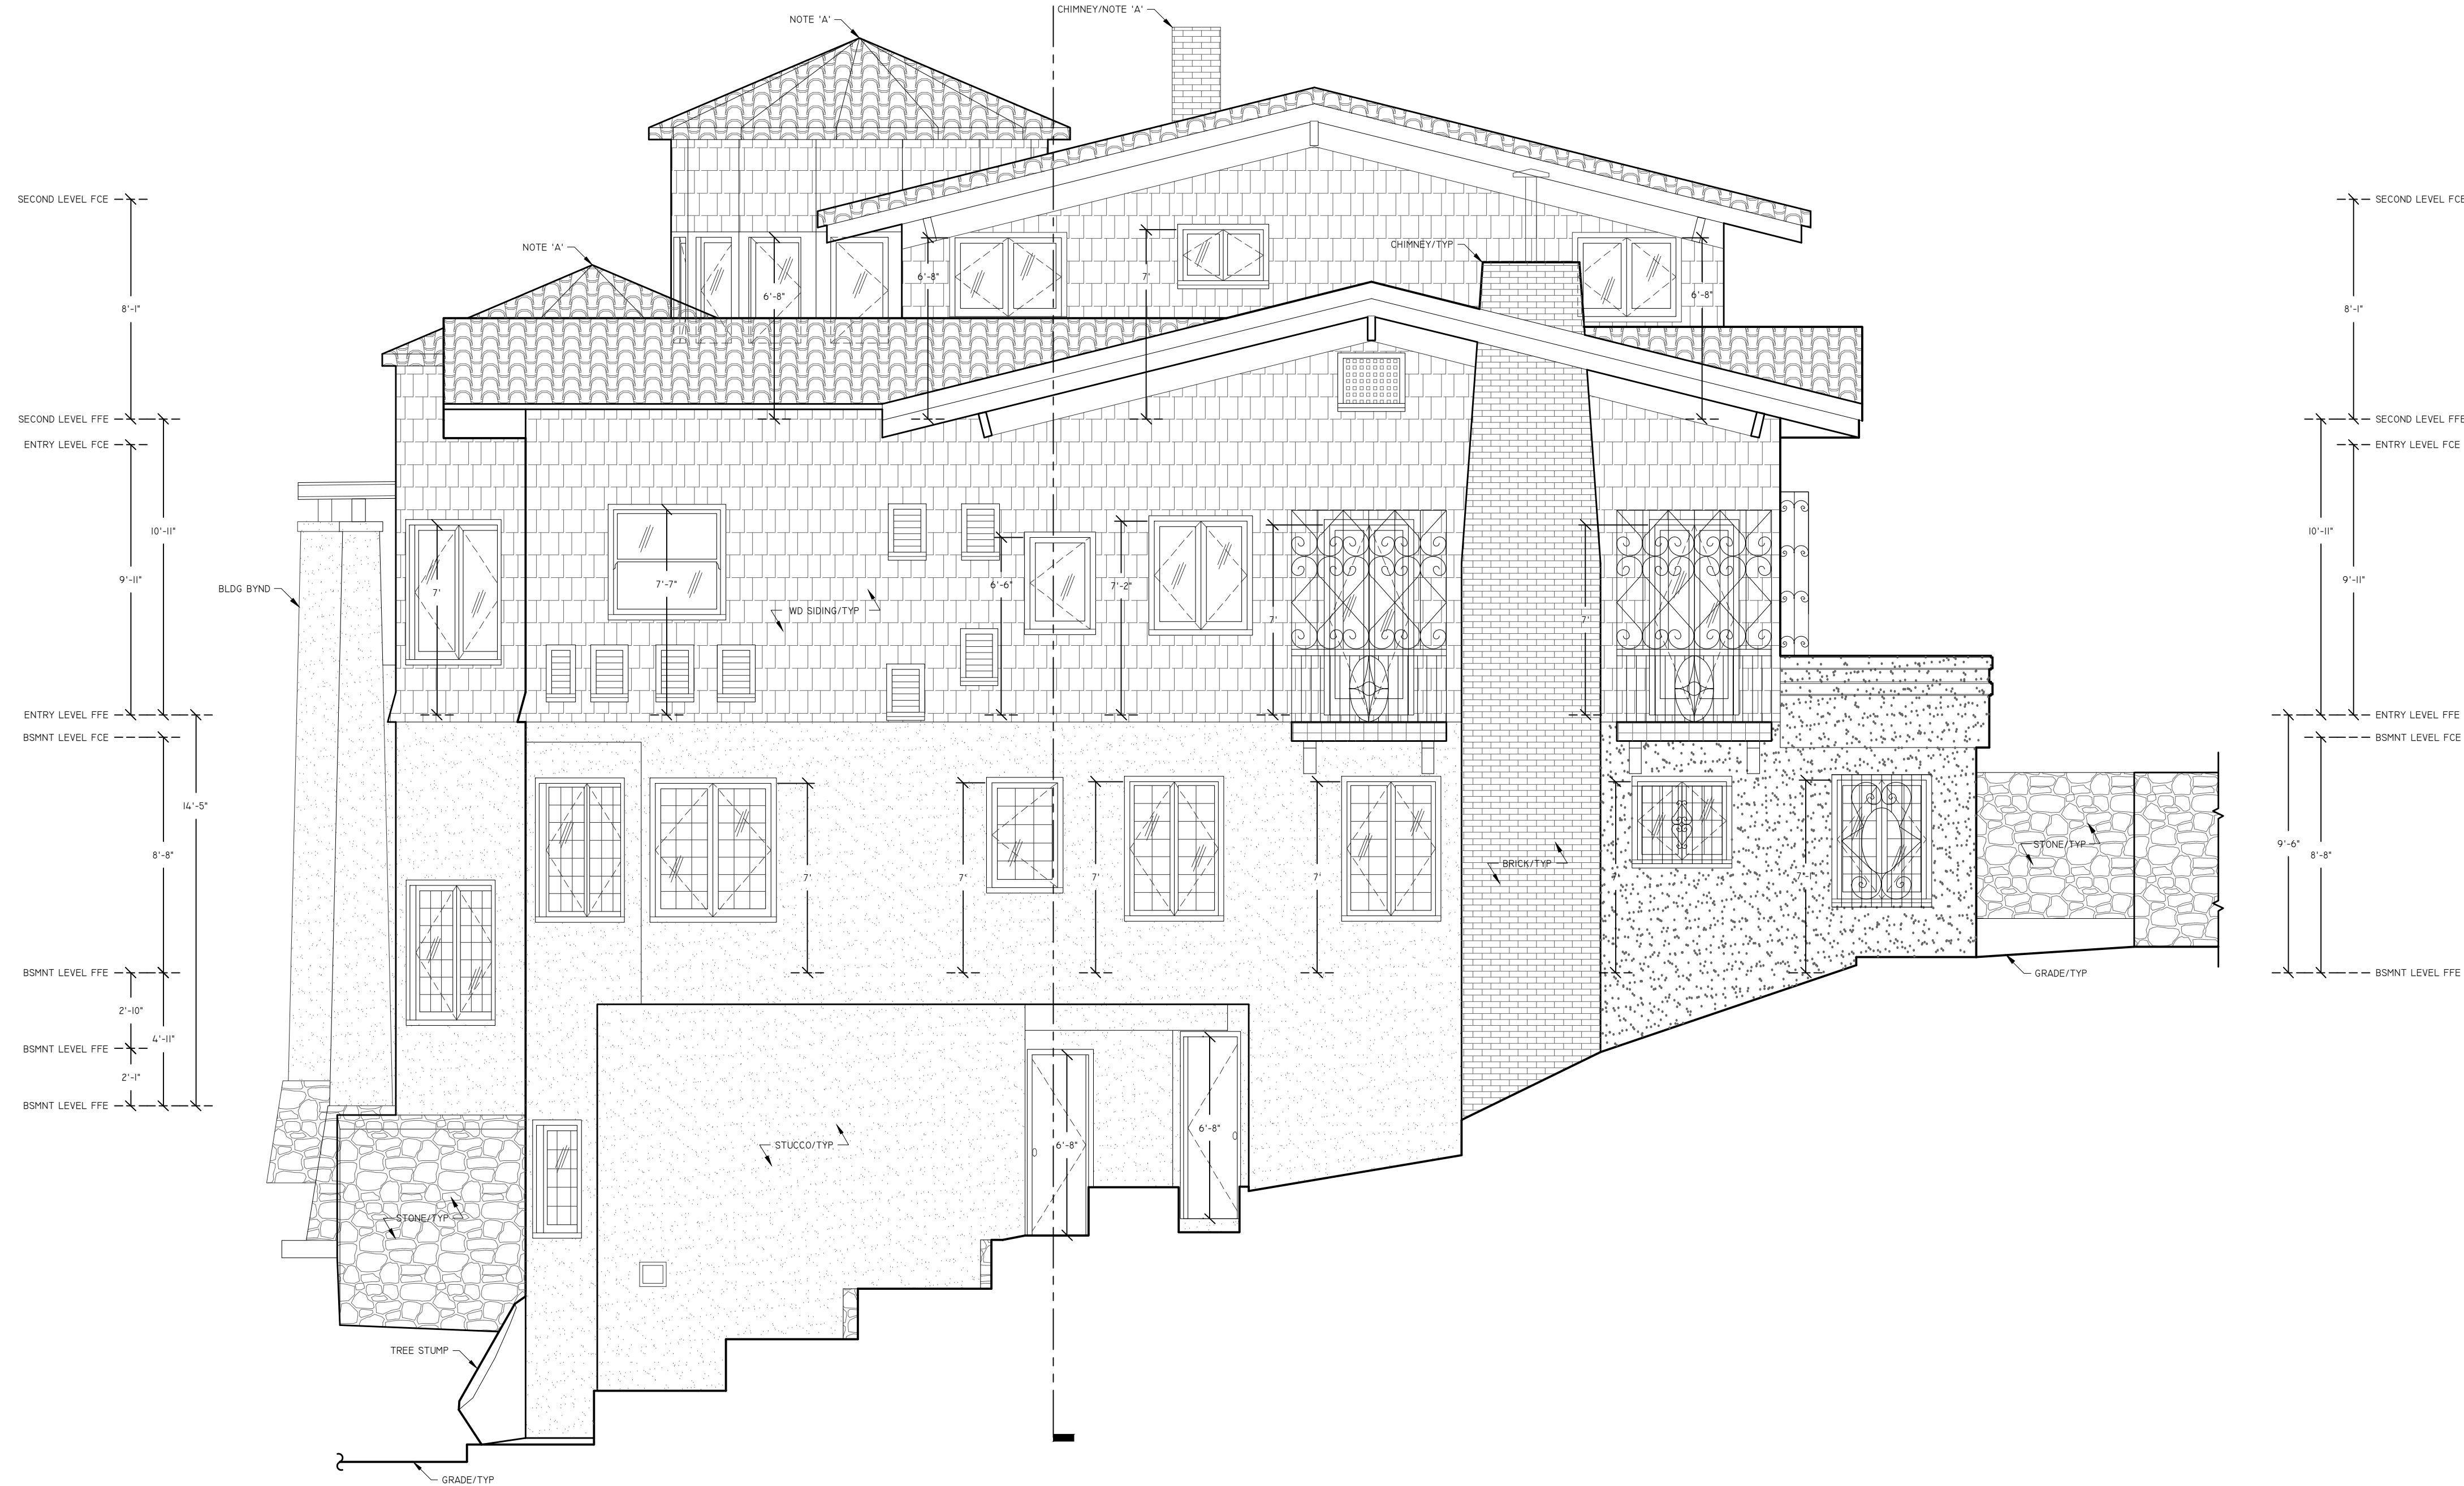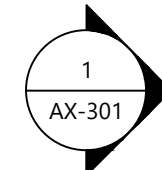

1 EXISTING EAST ELEVATION

NOTE A:
THIS ELEMENT NOT MEASURED, ILLUSTRATORS RENDERING.

1385 HILLSIDE CIRCLE
BURLINGAME, CA 94010

THIS DRAWING IS A RECORD OF REAL PROPERTY THAT IS GENERALLY ACCEPTED TO BE SUITABLE FOR USE IN PLANNING, DESIGN, LEASE, AND GENERAL ASSET MANAGEMENT. IT SHOULD NOT BE USED TO DETERMINE EXACT MEASUREMENTS OF SPACES OR ARTIFACTS FOUND HEREIN FOR ANY PURPOSE. EXTERIOR ELEMENTS HAVE BEEN MEASURED AND DRAFTED FOR REFERENCE ONLY. THIS IS NOT A SURVEY.





EXISTING EXTERIOR ELEVATION

REF: 1385sf_South_SFD
REV: 0
DRAWN BY: CB
AUDITED BY: CB

SHEET SIZE: 24x36
SCALE: 1/4"=1'-0"
FIELD MEASURE:
04/03/2020 - 04/07/2020

AX-204
9 OF 13

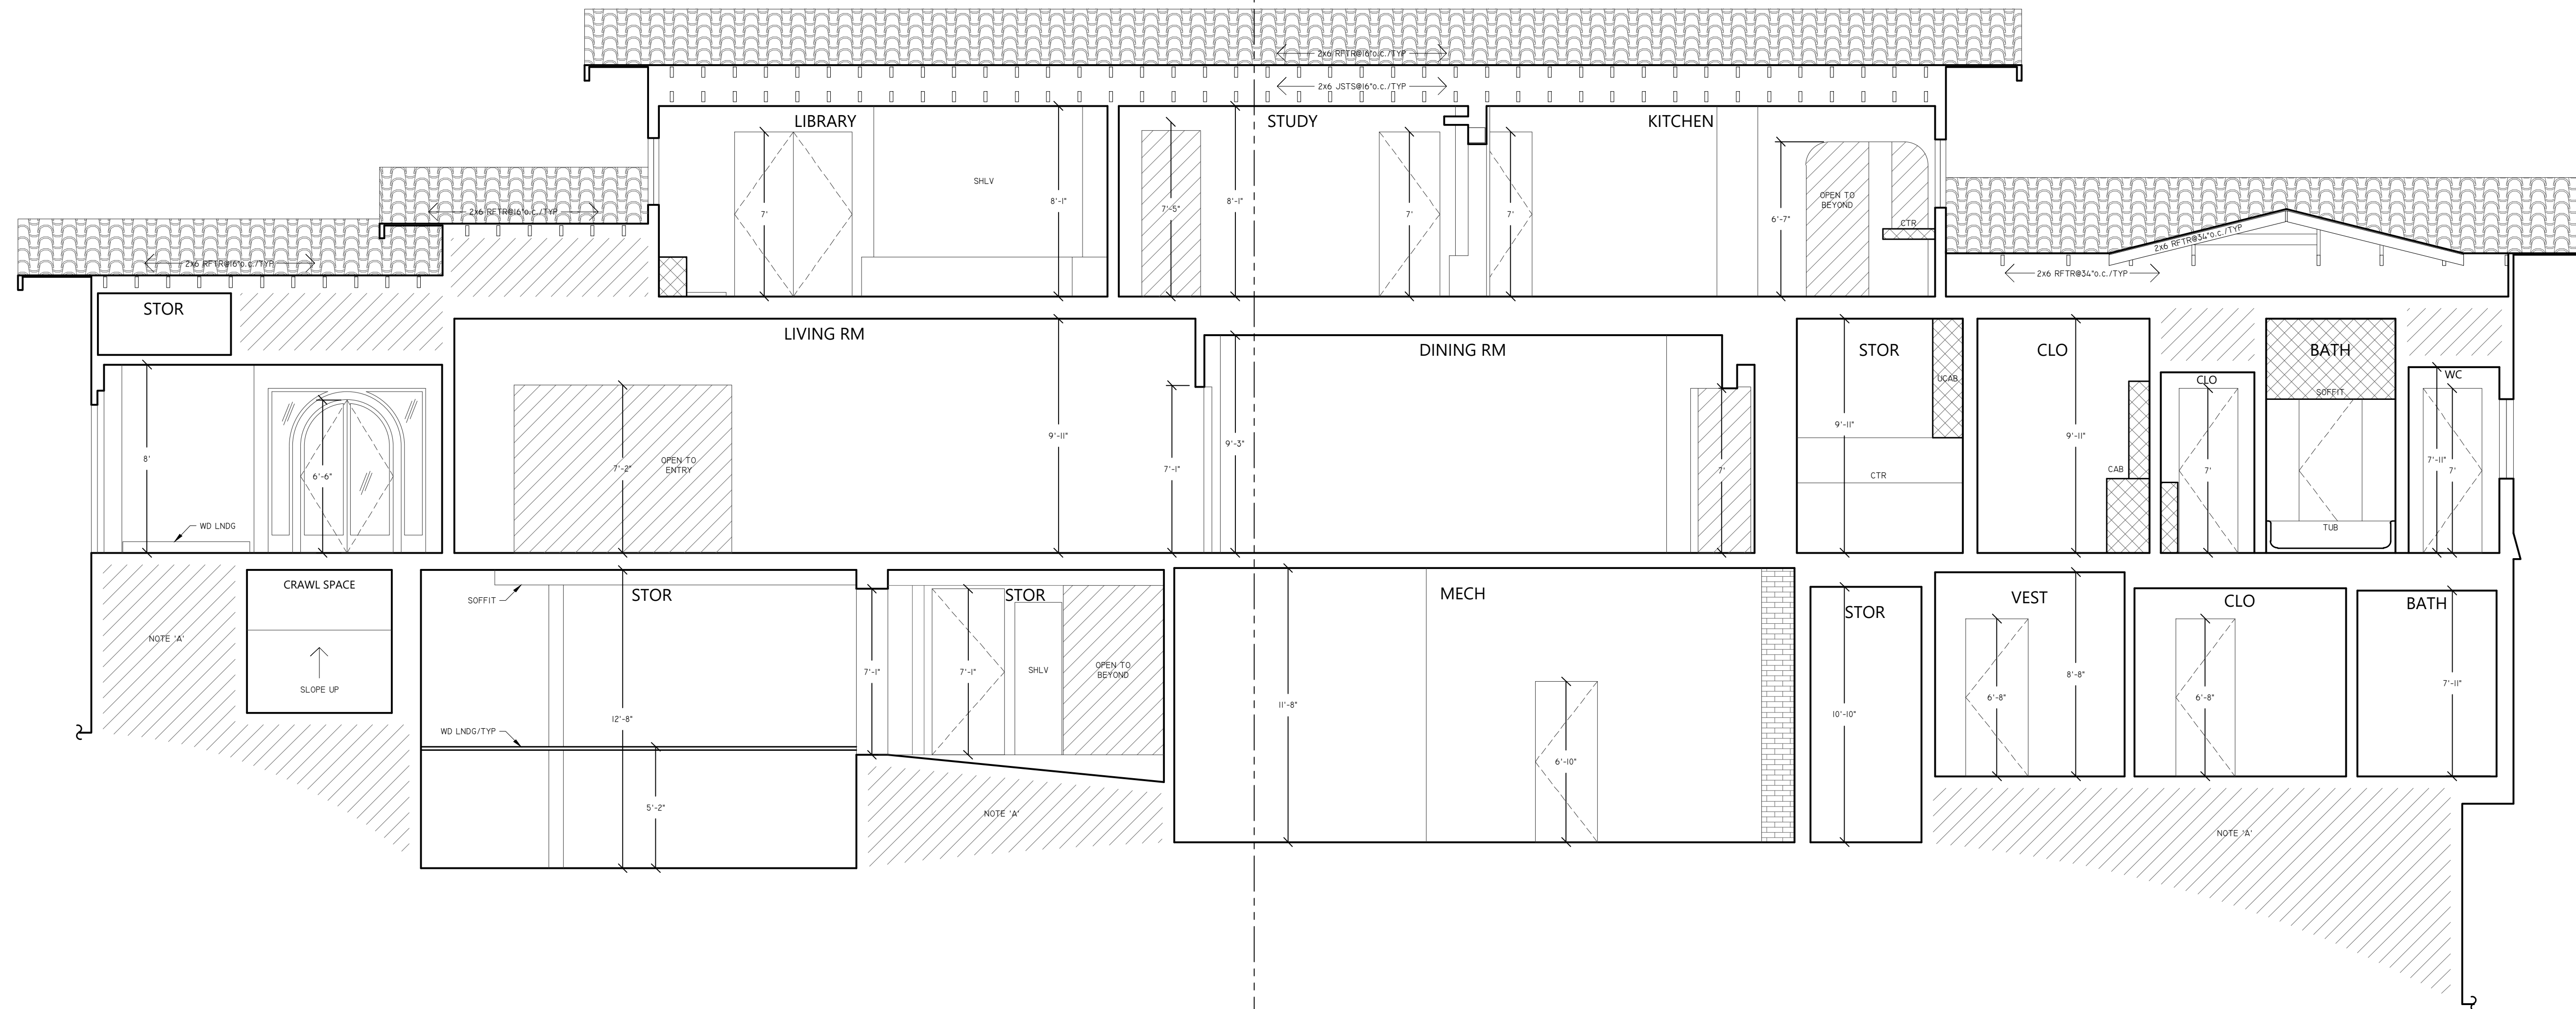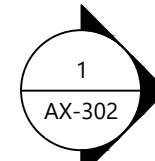

1 EXISTING LONGITUDINAL SECTION

NOTE: CEILING HEIGHT ANNOTATIONS TYPICAL. FOR HEIGHTS AT SPECIFIC LOCATIONS PLEASE VERIFY IN FIELD.

NOTE: DEVIATIONS IN SLAB THICKNESS AND FLOOR/CEILING SLOPES CAUSED BY STRUCTURAL SETTLING NOT SHOWN UNLESS NOTED OTHERWISE.

NOTE A:
THIS AREA NOT ACCESSIBLE AT TIME OF DATA ACQUISITION.
AREA NOT MEASURED.

1385 HILLSIDE CIRCLE
BURLINGAME, CA 94010

THIS DRAWING IS A RECORD OF REAL PROPERTY THAT IS GENERALLY ACCEPTED TO BE SUITABLE FOR USE IN PLANNING, DESIGN, LEASE, AND GENERAL ASSET MANAGEMENT. IT SHOULD NOT BE USED TO DETERMINE EXACT MEASUREMENTS OF SPACES OR ARTIFACTS FOUND HEREIN FOR ANY PURPOSE. EXTERIOR ELEMENTS HAVE BEEN MEASURED AND DRAFTED FOR REFERENCE ONLY. THIS IS NOT A SURVEY.



EXISTING BUILDING SECTION

REF: 1385sf_South_SFD
REV: 0
DRAWN BY: CB
AUDITED BY: CB

SHEET SIZE: 24x36
SCALE: 1/4" = 1'-0"
FIELD MEASURE:
04/03/2020 - 04/07/2020

AX-301
10 OF 13



1 EXISTING CROSS SECTION

NOTE: CEILING HEIGHT ANNOTATIONS TYPICAL. FOR HEIGHTS AT SPECIFIC LOCATIONS PLEASE VERIFY IN FIELD.

NOTE: DEVIATIONS IN SLAB THICKNESS AND FLOOR/CEILING SLOPES CAUSED BY STRUCTURAL SETTLING NOT SHOWN UNLESS NOTED OTHERWISE.

NOTE A:
THIS AREA NOT ACCESSIBLE AT TIME OF DATA ACQUISITION.
AREA NOT MEASURED.

1385 HILLSIDE CIRCLE
BURLINGAME, CA 94010

THIS DRAWING IS A RECORD OF REAL PROPERTY THAT IS GENERALLY ACCEPTED TO BE SUITABLE FOR USE IN PLANNING, DESIGN, LEASE, AND GENERAL ASSET MANAGEMENT. IT SHOULD NOT BE USED TO DETERMINE EXACT MEASUREMENTS OF SPACES OR ARTIFACTS FOUND HEREIN FOR ANY PURPOSE. EXTERIOR ELEMENTS HAVE BEEN MEASURED AND QUOTED FOR REFERENCE ONLY. THIS IS NOT A SURVEY.



EXISTING BUILDING SECTION

REF: 1385sf_South_SFD
REV: 0
DRAWN BY: CB
AUDITED BY: CB

SHEET SIZE: 24x36
SCALE: 1/4"=1'-0"
FIELD MEASURE:
04/03/2020 - 04/07/2020

AX-302
11 OF 13